


21

20

18.6

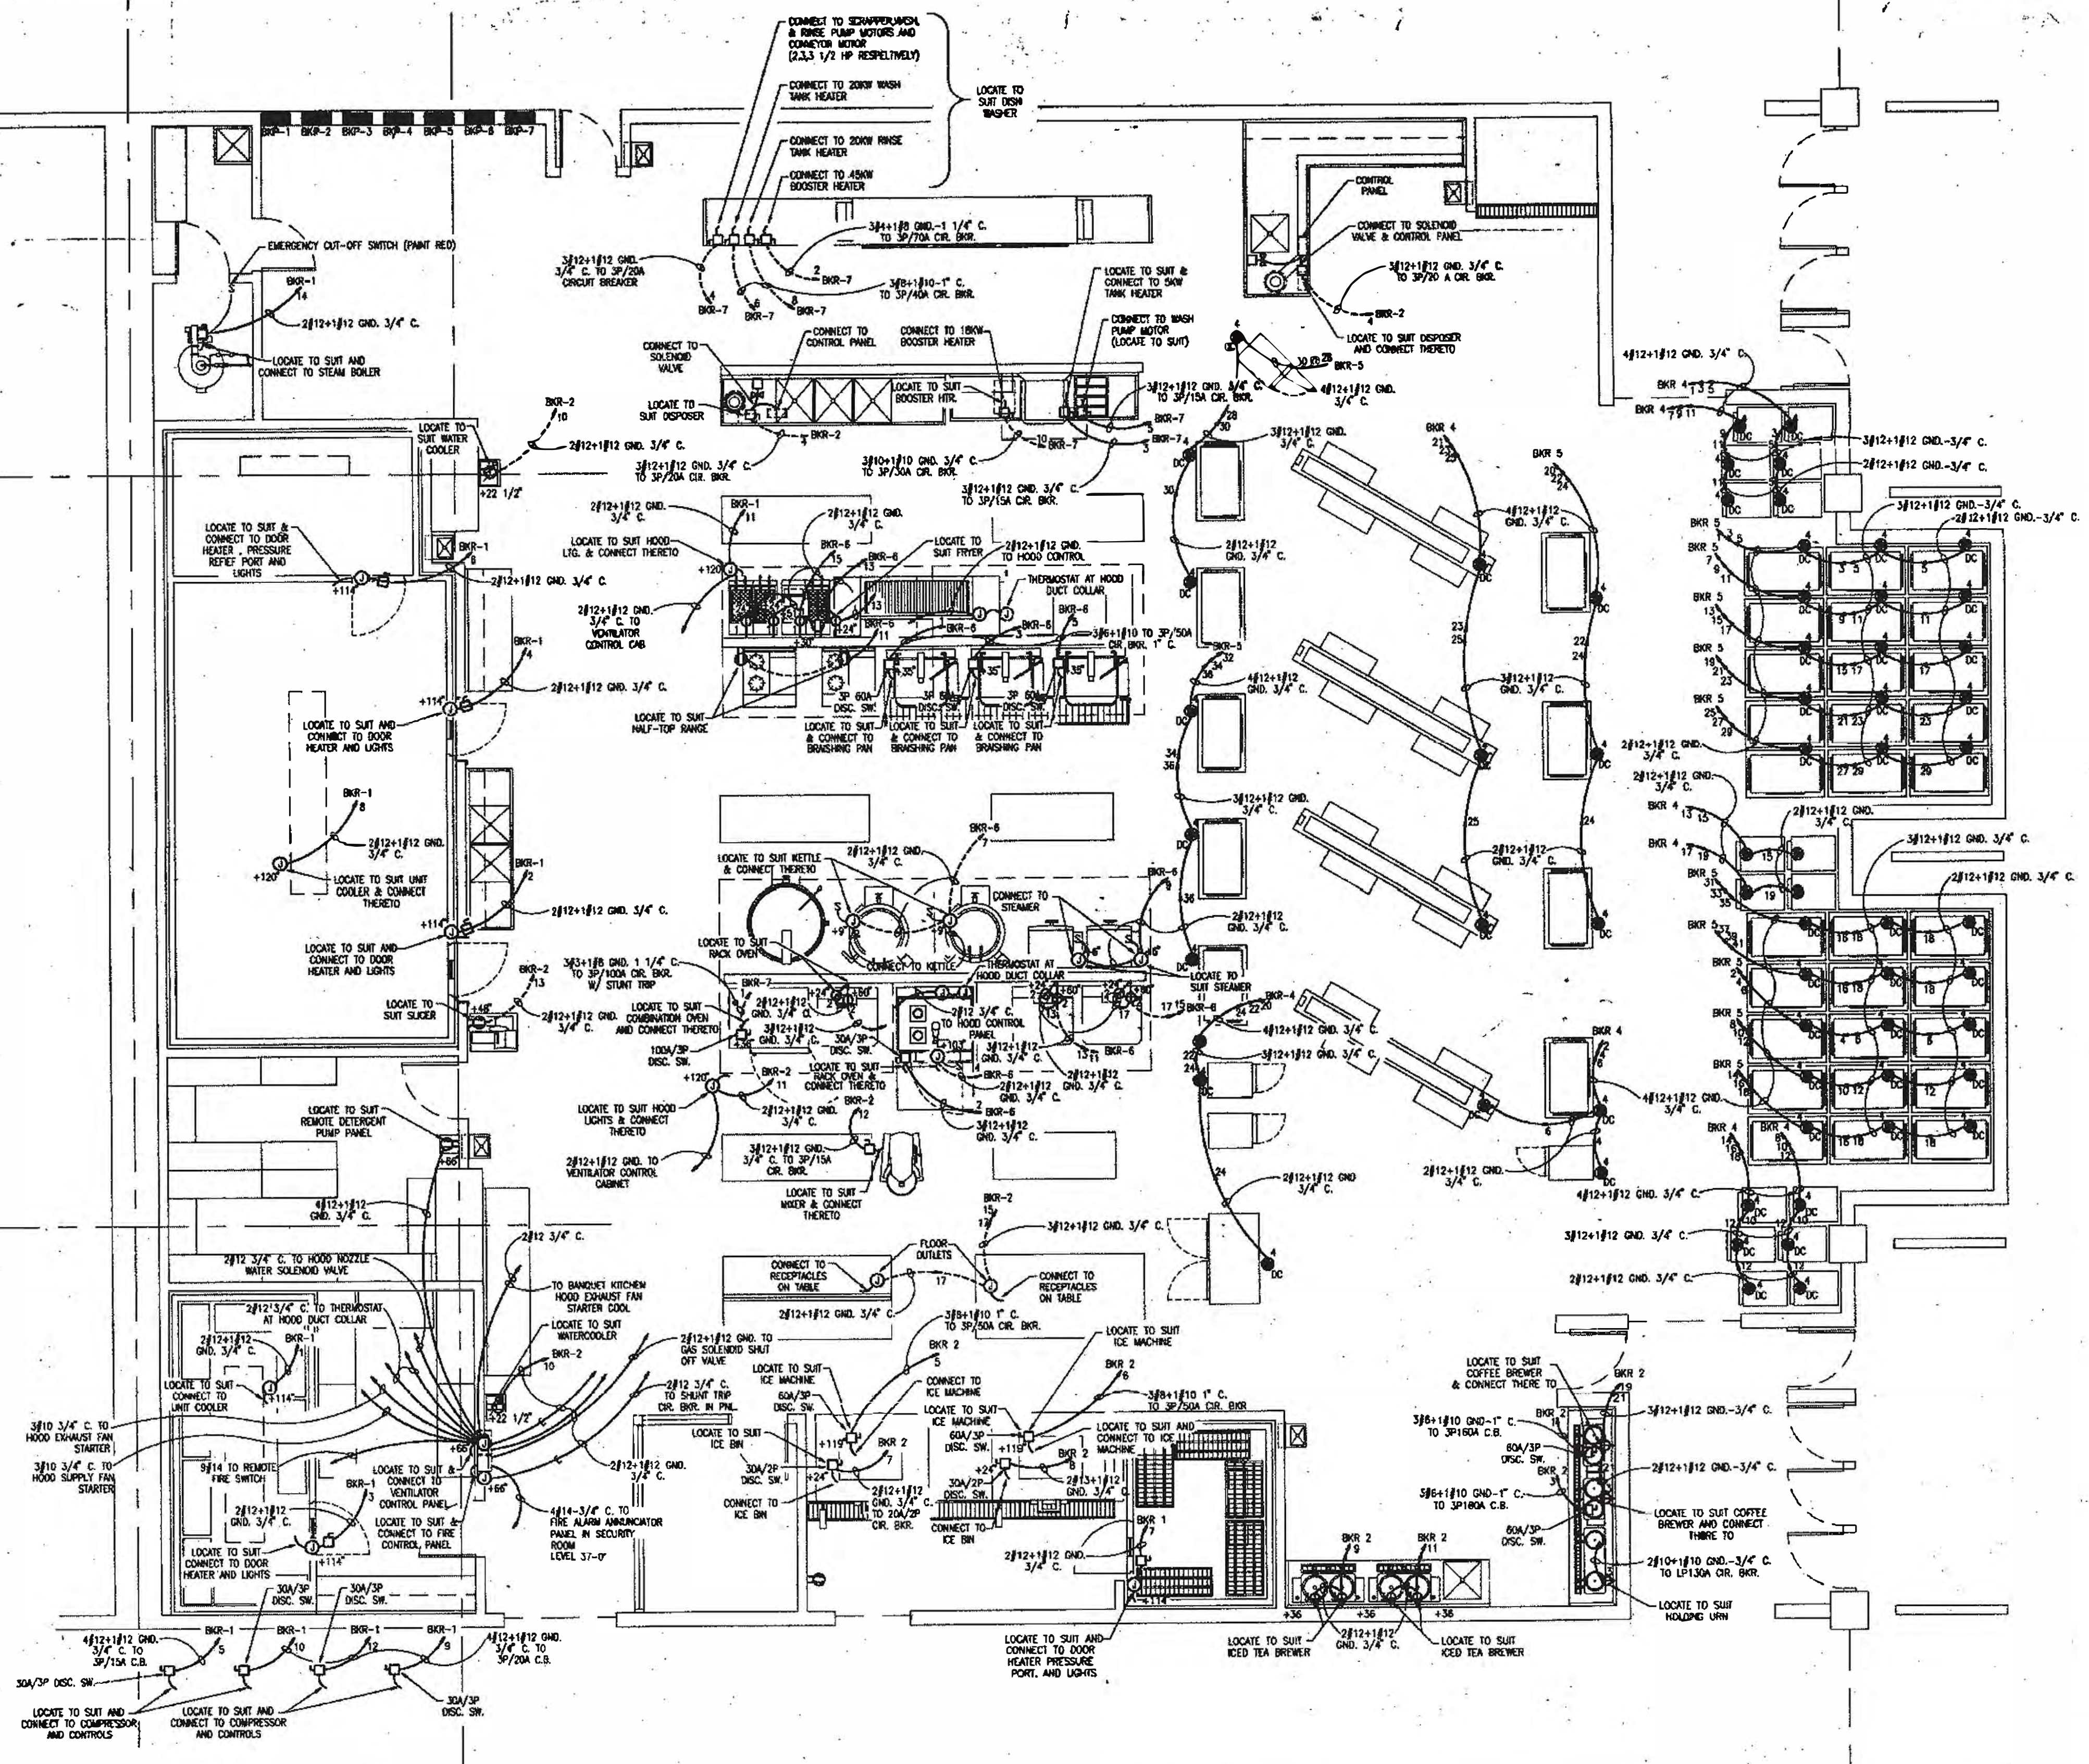

PHILADELPHIA CONVENTION CENTER PENNSYLVANIA

ASSOCIATE ARCHITECT
VITETTA GROUP
 ASSOCIATED ARCHITECTS
 KELLY MAJELLO ARCHITECTS & PLANNERS, INC.
 LIVINGSTON ROSENWINKEL P.C. ARCHITECTS & PLANNERS
 CONSULTING ARCHITECTS
 PENNELL & WILTBERGER INC.
 PHILADELPHIA DESIGN COLLABORATIVE

CONSULTING ENGINEERS


NO.	REVISIONS

All dimensions shall be verified by contractor and architect prior to any discrepancies before proceeding with construction.

GERALD T. HYAMS
 Registered Professional Engineer
 State of Pennsylvania
 License No. 000154

DRAWING TITLE
BANQUET KITCHEN
 EL. 89


SCALE: AS SHOWN
 PROJECT NO. DRAWING NO. 1358A 1358.00
 DATE: 11/15/93
 DESIGNED BY: [Signature]
 CHECKED BY: [Signature]

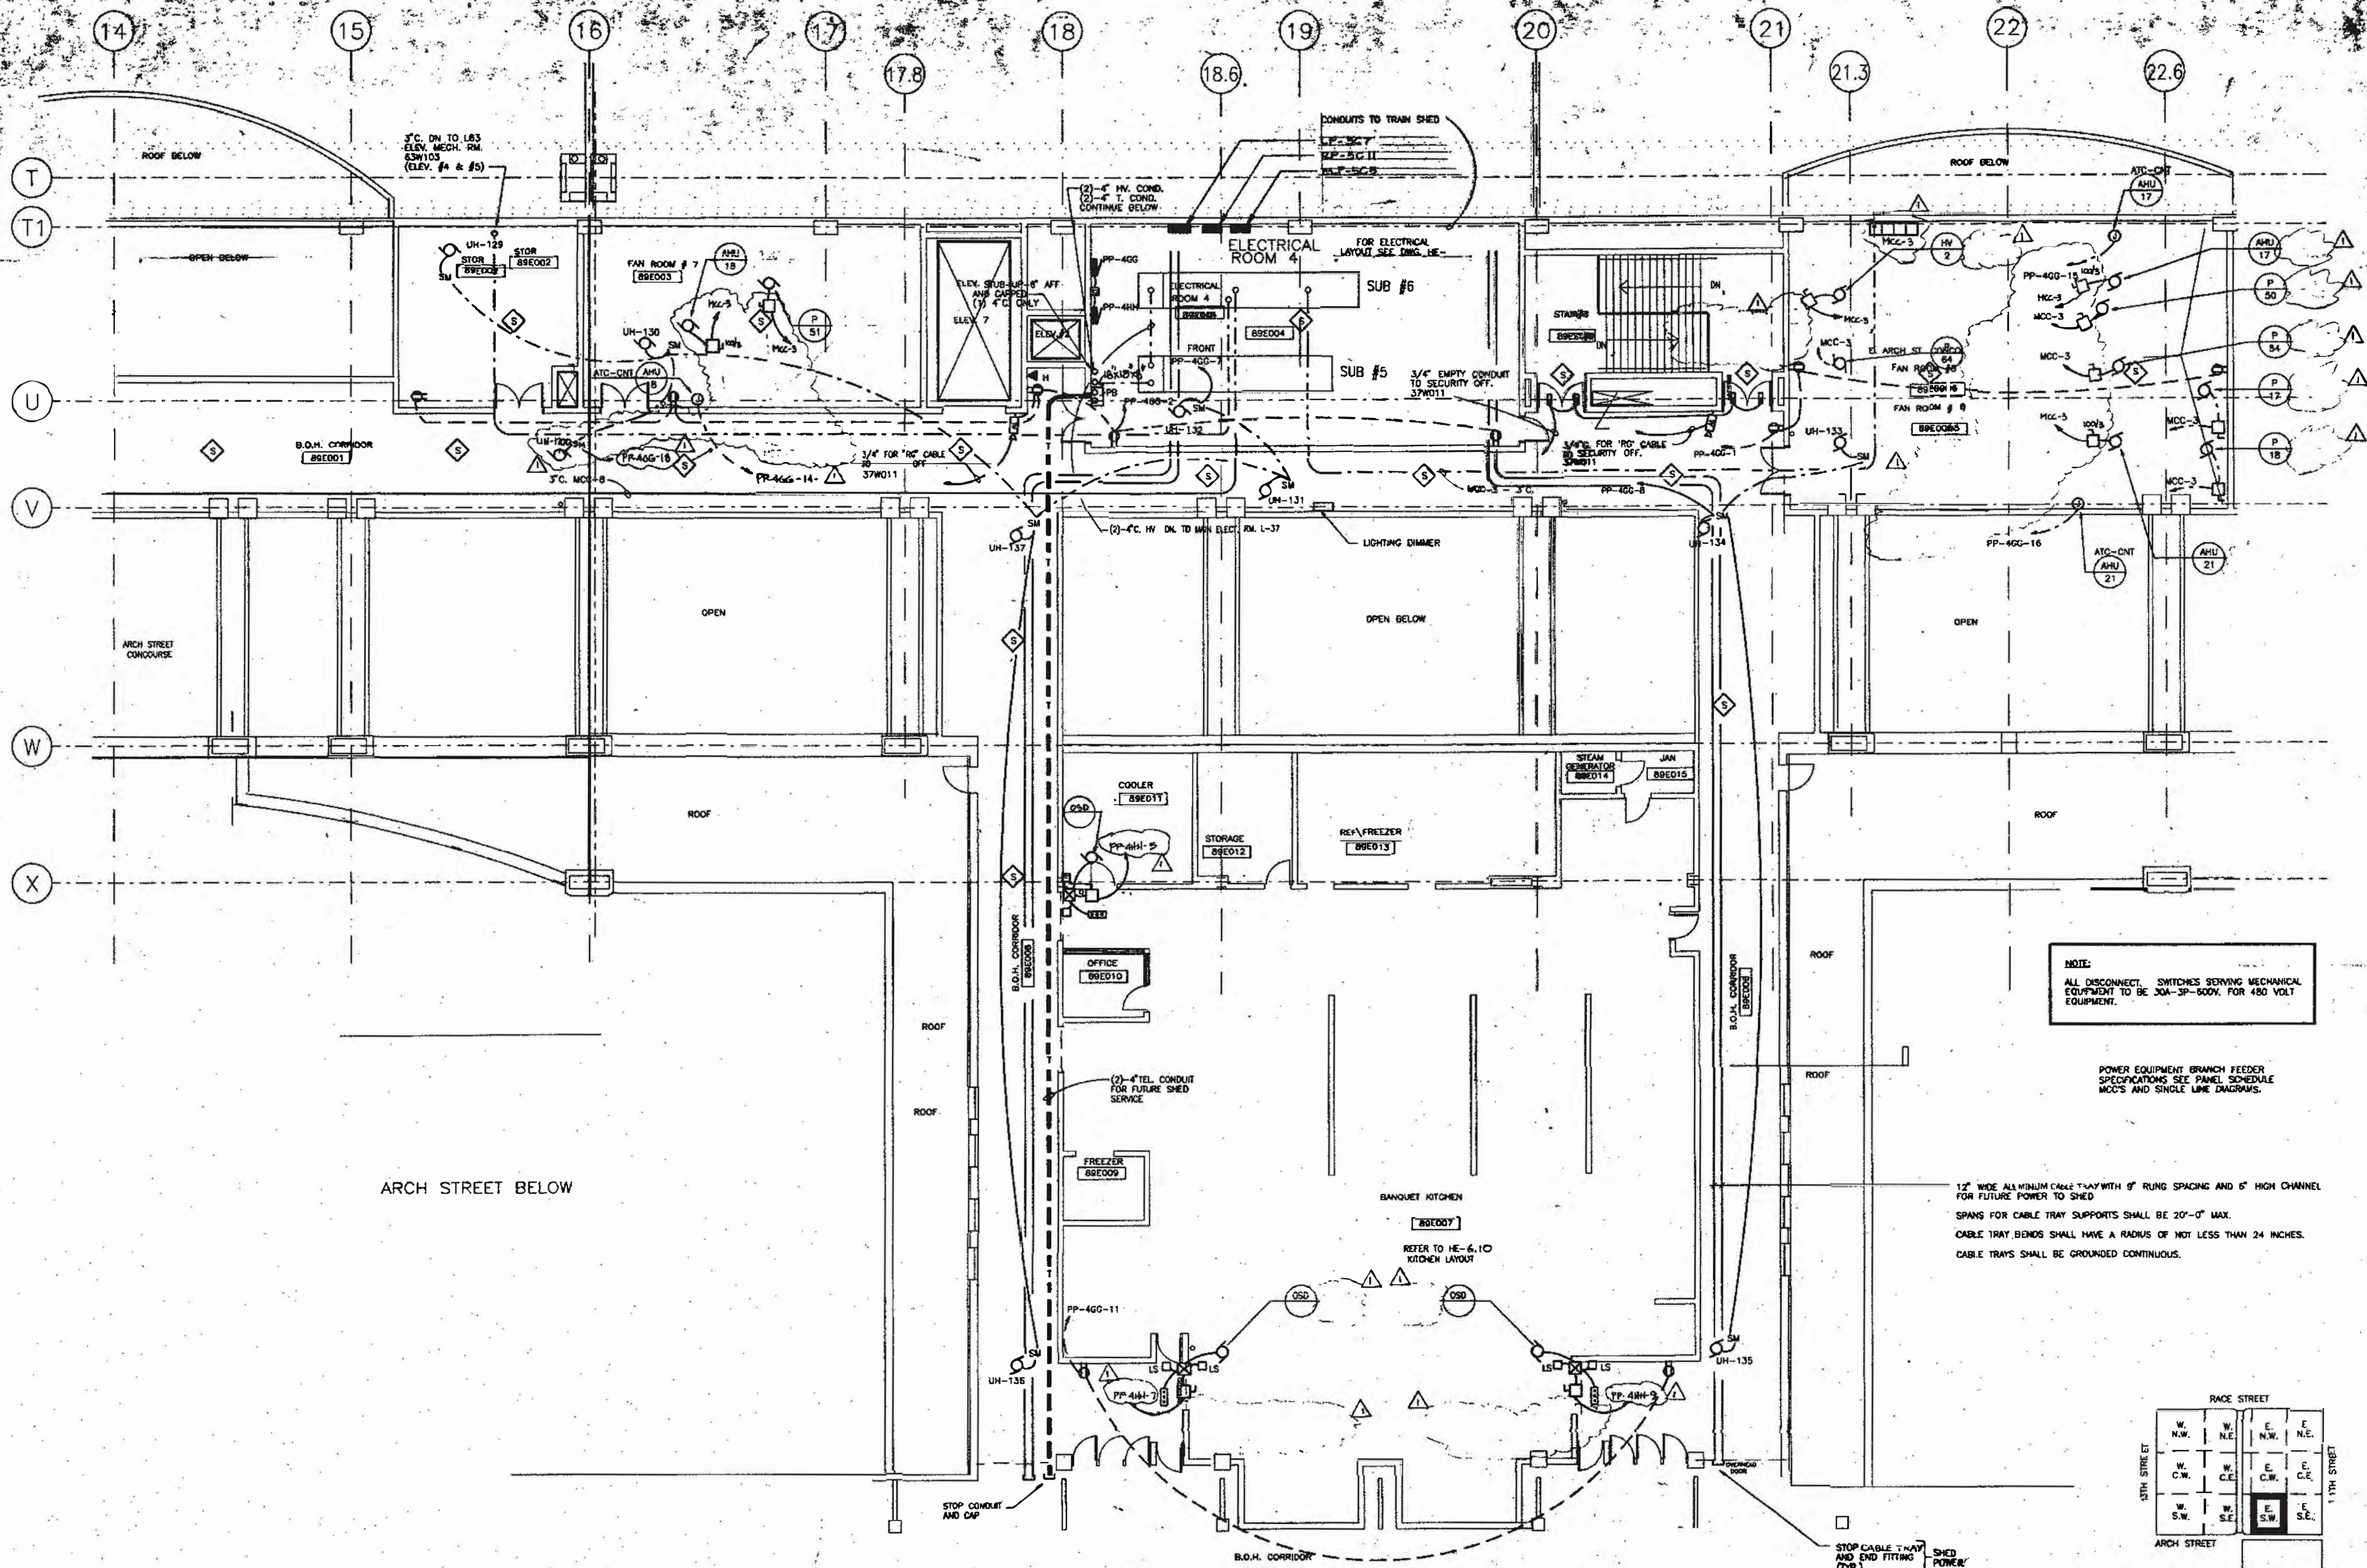

NOTE:
 ALL DISCONNECT SWITCHES SERVING MECHANICAL EQUIPMENT TO BE 30A-3P-500V FOR 480 VOLT EQUIPMENT.

POWER EQUIPMENT BRANCH FEEDER SPECIFICATIONS SEE PANEL SCHEDULE MCC'S AND SINGLE LINE DIAGRAMS.

1/2" WIDE ALUMINUM CABLE TRAY WITH 6" RUNG SPACING AND 6" HIGH CHANNEL FOR FUTURE POWER TO SHED.
 SPANS FOR CABLE TRAY SUPPORTS SHALL BE 20'-0" MAX.
 CABLE TRAY BENDS SHALL HAVE A RADIUS OF NOT LESS THAN 24 INCHES.
 CABLE TRAYS SHALL BE GROUNDED CONTINUOUS.

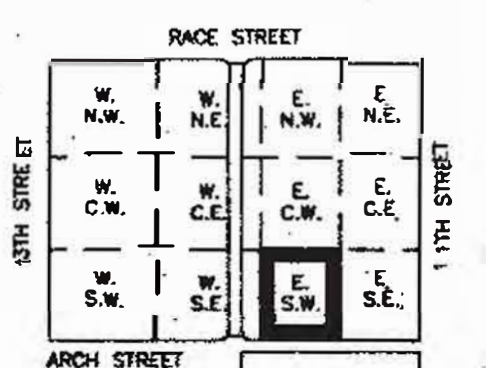

KEY PLAN


ASSOCIATED ARCHITECTS
VITETTA GROUP
 ASSOCIATED ARCHITECTS
KELLY/MAIBLO
 ARCHITECTS & PLANNERS, INC.
LIVINGSTON/ROSENWINKE
 P.C.
 ARCHITECTS & PLANNERS
 CONSULTING ARCHITECTS
PENNEL & WILBERGER
 INC
PHILADELPHIA DESIGN COLLABORATIVE

CONSULTING ENGINEERS

REVISIONS


1. APPROVED 10/21/10

All dimensions shall be verified by contractor and architect prior to construction. Discrepancies shall be resolved prior to construction.

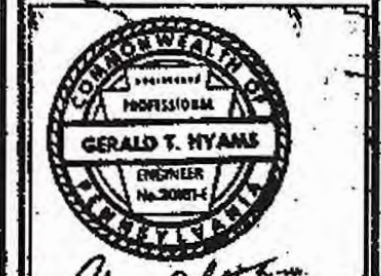

DRAWING TITLE
POWER PLAN BALLROOM LEVEL
 89

PENNSYLVANIA CONVENTION CENTER PHILADELPHIA, PENNSYLVANIA

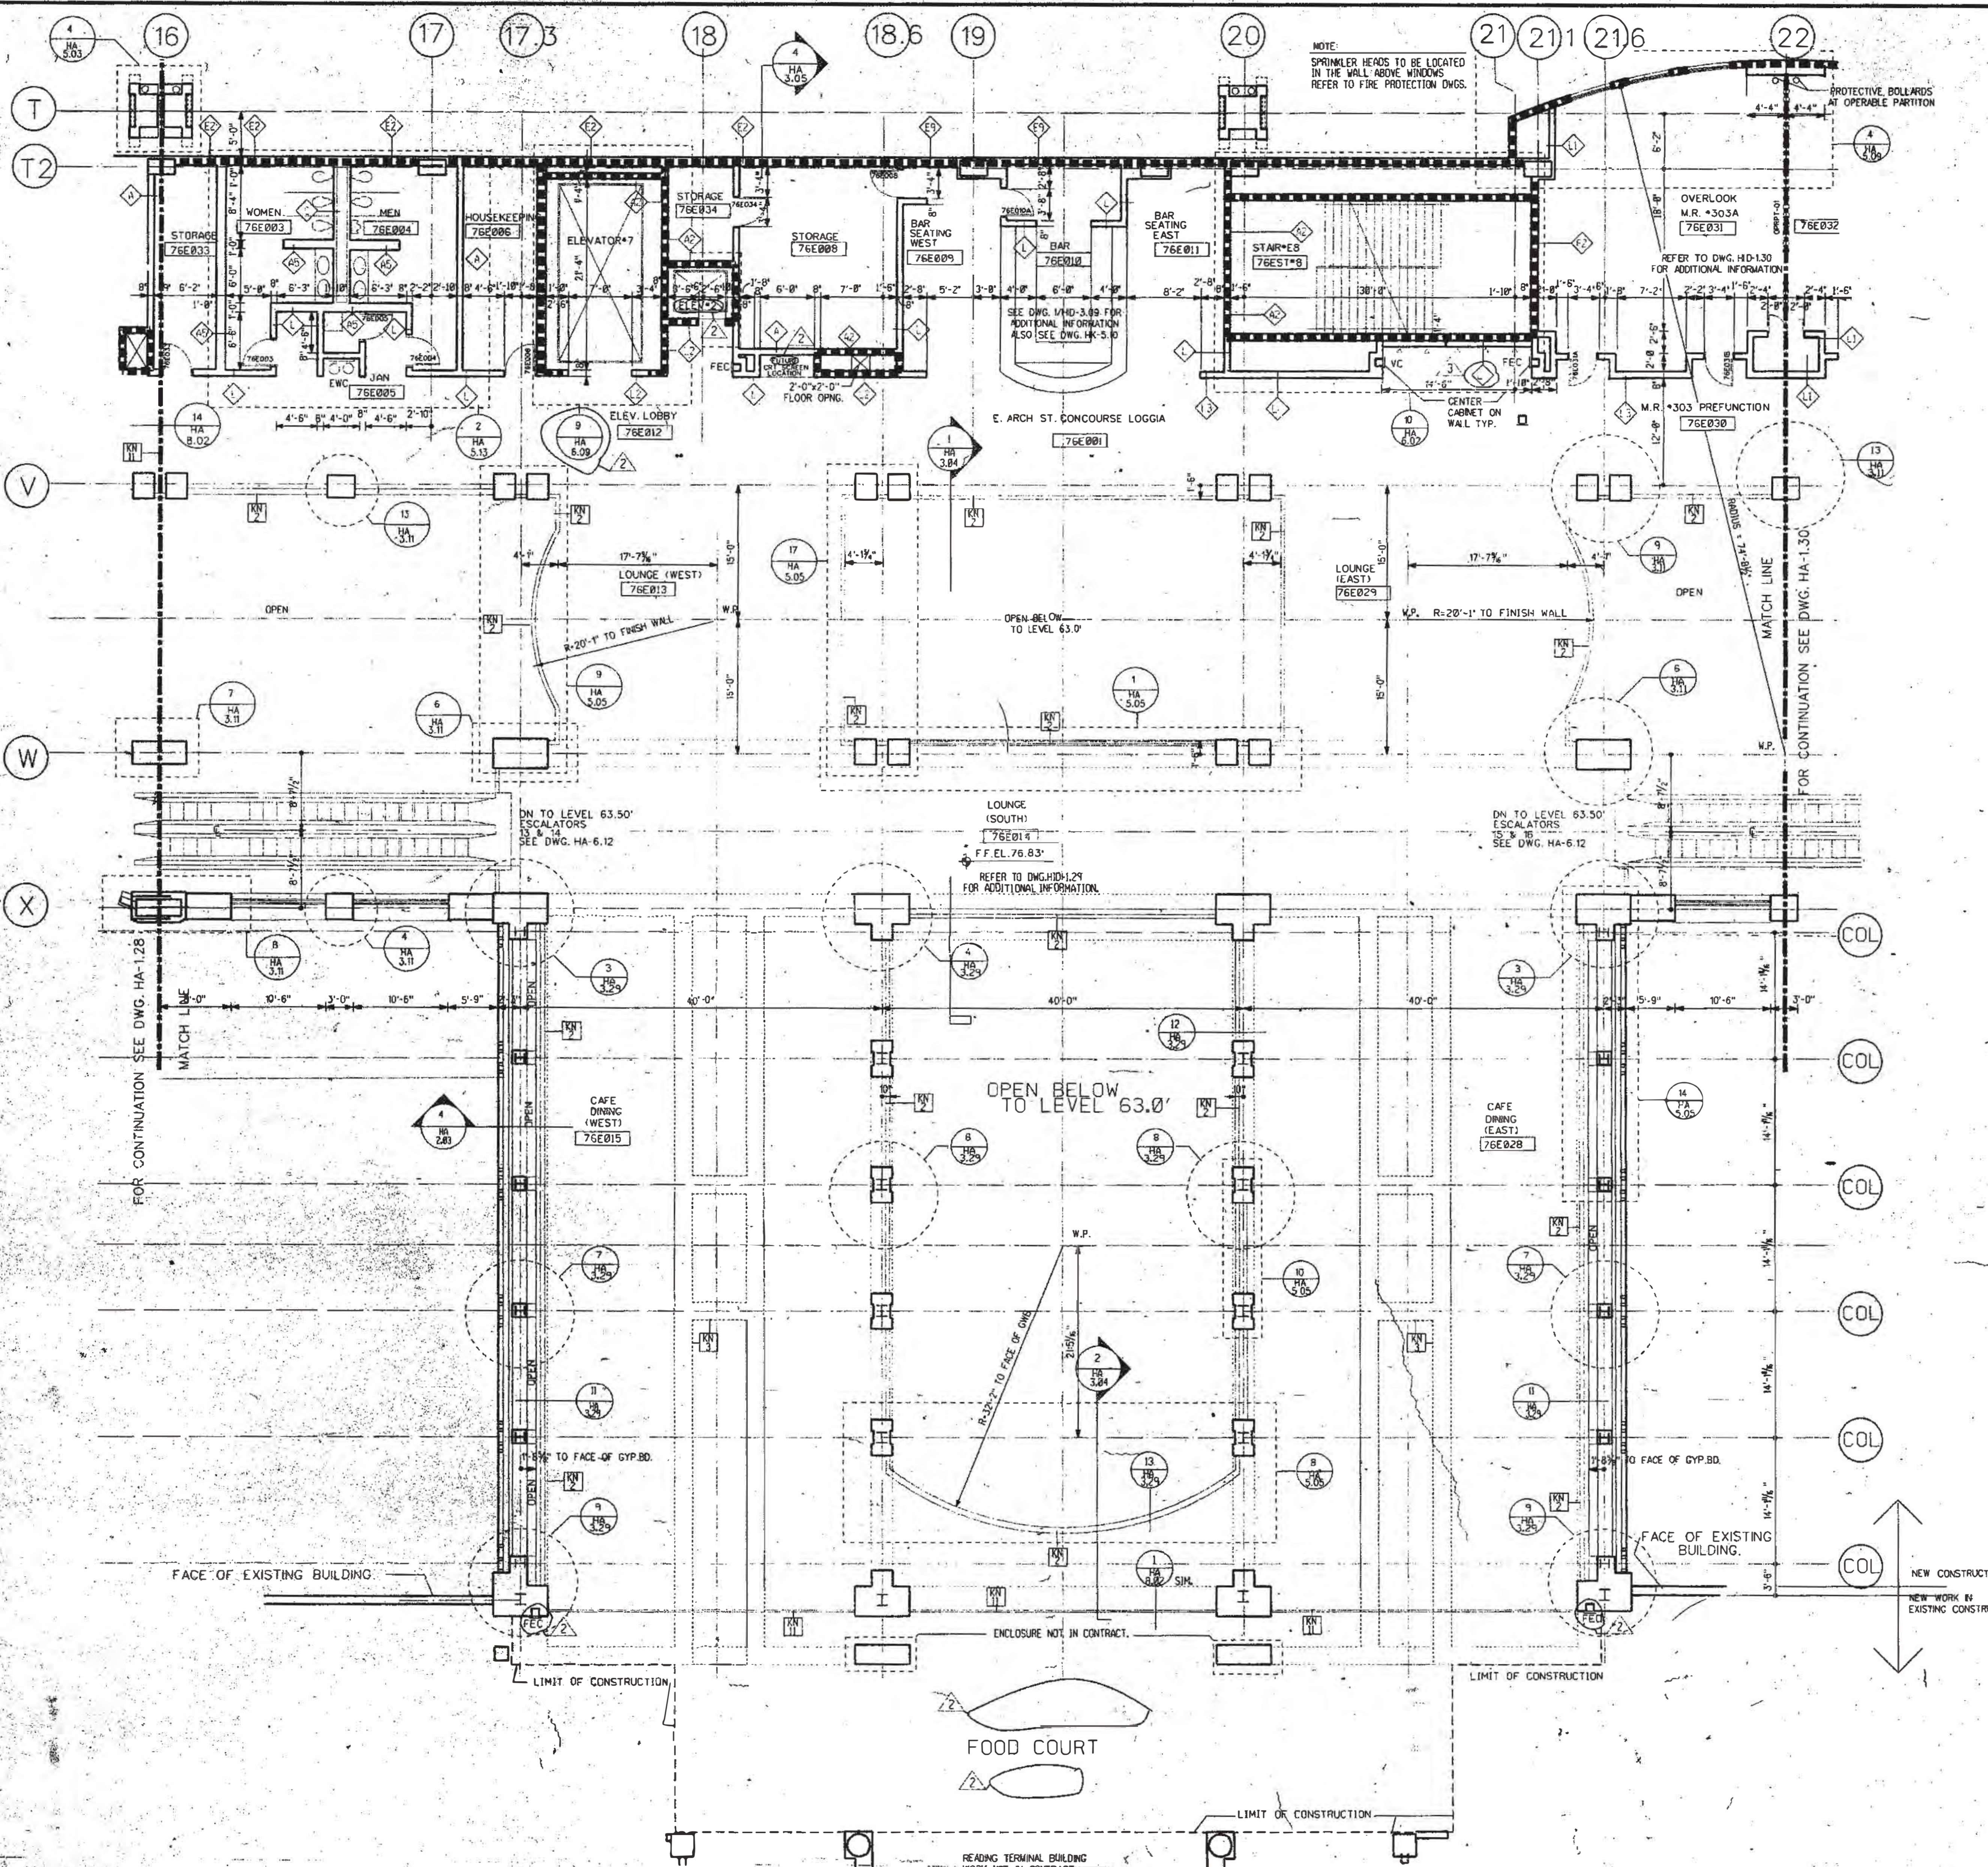


GENERAL FLOOR PLAN NOTES:

1. ALL DIMENSIONS GIVEN ARE NOMINAL AND ARE TAKEN TO THE FACE OF CMU CONSTRUCTION WHERE PARTITIONS ARE CMU OR BACKED UP BY CMU. DIMENSIONS AT METAL FRAME G.W.B. PARTITIONS ARE GIVEN TO FINISH FACE.
2. FOR PARTITION TYPES REFER TO DWG. HA-8.01. WHERE A PARTITION TYPE IS NOT INDICATED ON THESE DRAWINGS THE PARTITION TYPE IS THE SAME AS THE PREVIOUS MARKED SIMILAR CONDITION.
3. WALLS INDICATED TO BE RATED CONSTRUCTION SHALL BE CONTINUOUS TO EXTERIOR WALL AND UNDERSE OF DECK OR SLAB.
4. FOR ADDITIONAL INFO REGARDING FOOD SERVICE AREAS REFER TO FOOD SERVICE DWG. SERIES "HK".
5. FOR MILLWORK & CASEWORK REFER TO INTERIOR DESIGN DRAWINGS, SERIES "HD".
6. FOR FLOORING PATTERNS & MATERIALS REFER TO INTERIOR DESIGN DRAWINGS, SERIES "HD". (NOTE: EXTENT OF STONE FLOORING REQUIRING DEPRESSSED CONCRETE SLAB IS INDICATED ON HD DRAWINGS ONLY.)
7. FOR EXTENT AND TYPE OF APPLIED FINISHES REFER TO ROOM FINISH SCHEDULE IN SPEC SECTION 09001.
8. FOR EXTENT OF SIDEWALKS, CURBS & MISC. SITE WORK SEE CIVIL ENGINEERING DWGS ("HX-" SERIES & ARCHITECTURAL DWGS. HA-"S" SERIES).
9. ALL WOOD WINDOWS & MILLWORK ARE INDICATED ON INTERIOR DESIGN DWGS. (IND. DWGS.)
10. EXPANSION JOINT COVERS ARE REQUIRED AT ALL INTERIOR WALL & FLOOR CONDITIONS WHERE EXPANSION JOINTS OCCUR THROUGH THE STRUCTURE. WHEN NOT INDICATED ON THE PLANS OR SHOWN IN CONDITIONS WHEN SHOWN ARE TO MATCH ADJACENT JOINT COVER SHALL BE AS INDICATED ON SCHEDULE ON DWG. HA-6.02.

- KEY NOTES**
- [Symbol] REMOVABLE HANDRAIL
 - [Symbol] HANDRAIL
 - [Symbol] ORNAMENTAL HANDRAIL (REFER TO DWG. HA-5.05)
 - [Symbol] SOFFIT ABOVE
 - [Symbol] STL. BOLLARD
 - [Symbol] EDGE OF SLAB
 - [Symbol] 1" DEPRESSSED SLAB FOR PEDMAT.
 - [Symbol] 0" DEPRESSSED SLAB FOR VEST.MAT.
 - [Symbol] 2" DEPRESSSED SLAB FOR TILE FLOORING
 - [Symbol] 8" DEPRESSSED SLAB FOR WALK IN REF./FREZ.
 - [Symbol] OPERABLE PARTITION FOR CEILING TRACING
 - [Symbol] EXTENT OF OPERABLE PARTITION ABOVE CEILING SEE REFLECTED CEILING PLAN
 - [Symbol] 2" EXPANSION JOINT (TYPICAL)
 - [Symbol] TRENCH DRAIN
 - [Symbol] COUNTER WT. TOWER FOR SECTIONAL DOOR
 - [Symbol] 6" CONC. CURB
 - [Symbol] GUARD RAIL
 - [Symbol] CONCRETE WALK
 - [Symbol] CAST IN PLACE CONCRETE STEPS WITH PAINTED STL. HANDRAIL
 - [Symbol] CONTROL JOINT (TYPICAL)
 - [Symbol] PAINTED STRIPES @ EACH TRUCK DOCK
 - [Symbol] PROTECTIVE BOLLARDS AT OPERABLE PARTITIONS
 - [Symbol] CONC. FILLED METAL PAN STAIRS WITH PTD. METAL HANDRAIL

LEGEND

[Symbol]	MATCH LINE
[Symbol]	COLUMN CENTER LINE
[Symbol]	PROPERTY LINE
[Symbol]	1HR FIRE RATED WALL
[Symbol]	2HR FIRE RATED WALL
[Symbol]	3HR FIRE RATED WALL
[Symbol]	PARTITION TYPE
[Symbol]	KEY NOTES
[Symbol]	DOOR NUMBER
[Symbol]	ROOM NUMBER
[Symbol]	PLAN DETAIL
[Symbol]	SECTION DETAIL
[Symbol]	DIMENSION CENTER LINE OF COLUMN TO FACE CMU
[Symbol]	INT. H.M. BORROWED LIGHTS REF. WOOD BORROWED LIGHTS SEE HD DWGS.
[Symbol]	T.C. TOP OF CURB

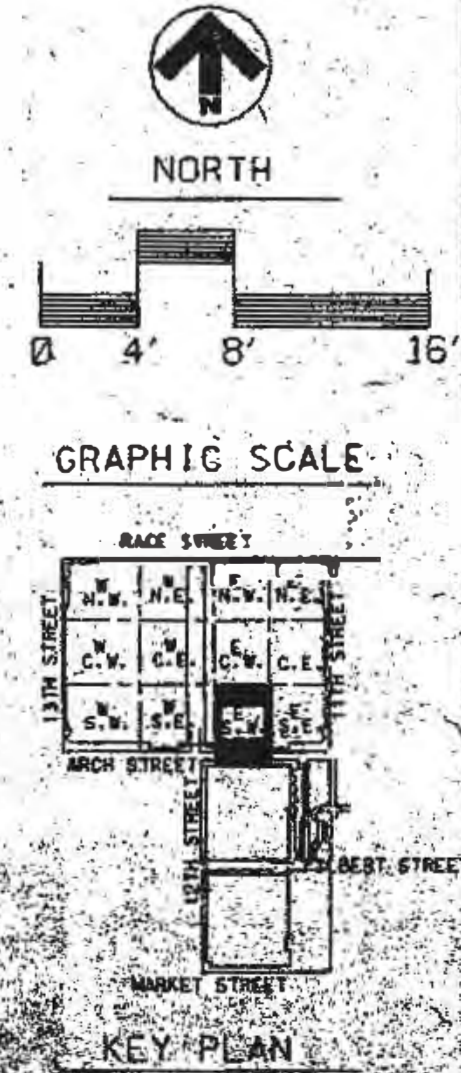

THOMPSON
VENTULETT
STAINBACK
&
ASSOCIATES, INC.
ARCHITECTS

VITETTA
GROUP
ASSOCIATED ARCHITECTS

KELLY/
MAIELLO
ARCHITECTS &
PLANNERS, INC.

LIVINGSTON/
ROSENWINKEL,
P.C.
ARCHITECTS &
PLANNERS
CONSULTING ARCHITECTS

REVISIONS

[Symbol]	ADD NO. 3	10-16-90
[Symbol]	ADD NO. 4	11-06-90
[Symbol]	ADD NO. 5	11-18-90


All dimensions shall be verified by contractor and architect notified of any discrepancies before proceeding with construction.

RECEIVED
FEB. 8 1991
HARDY/KEATING/KENNERD



DRAWING TITLE
OVERLOOK
AND
BRIDGE LEVEL
EL. 76'

RECORD SET
BLOCK "E" S.W.

PROJECT NO.
155A
9803.00
HA
1.29
ISSUE DATE
10-4-90

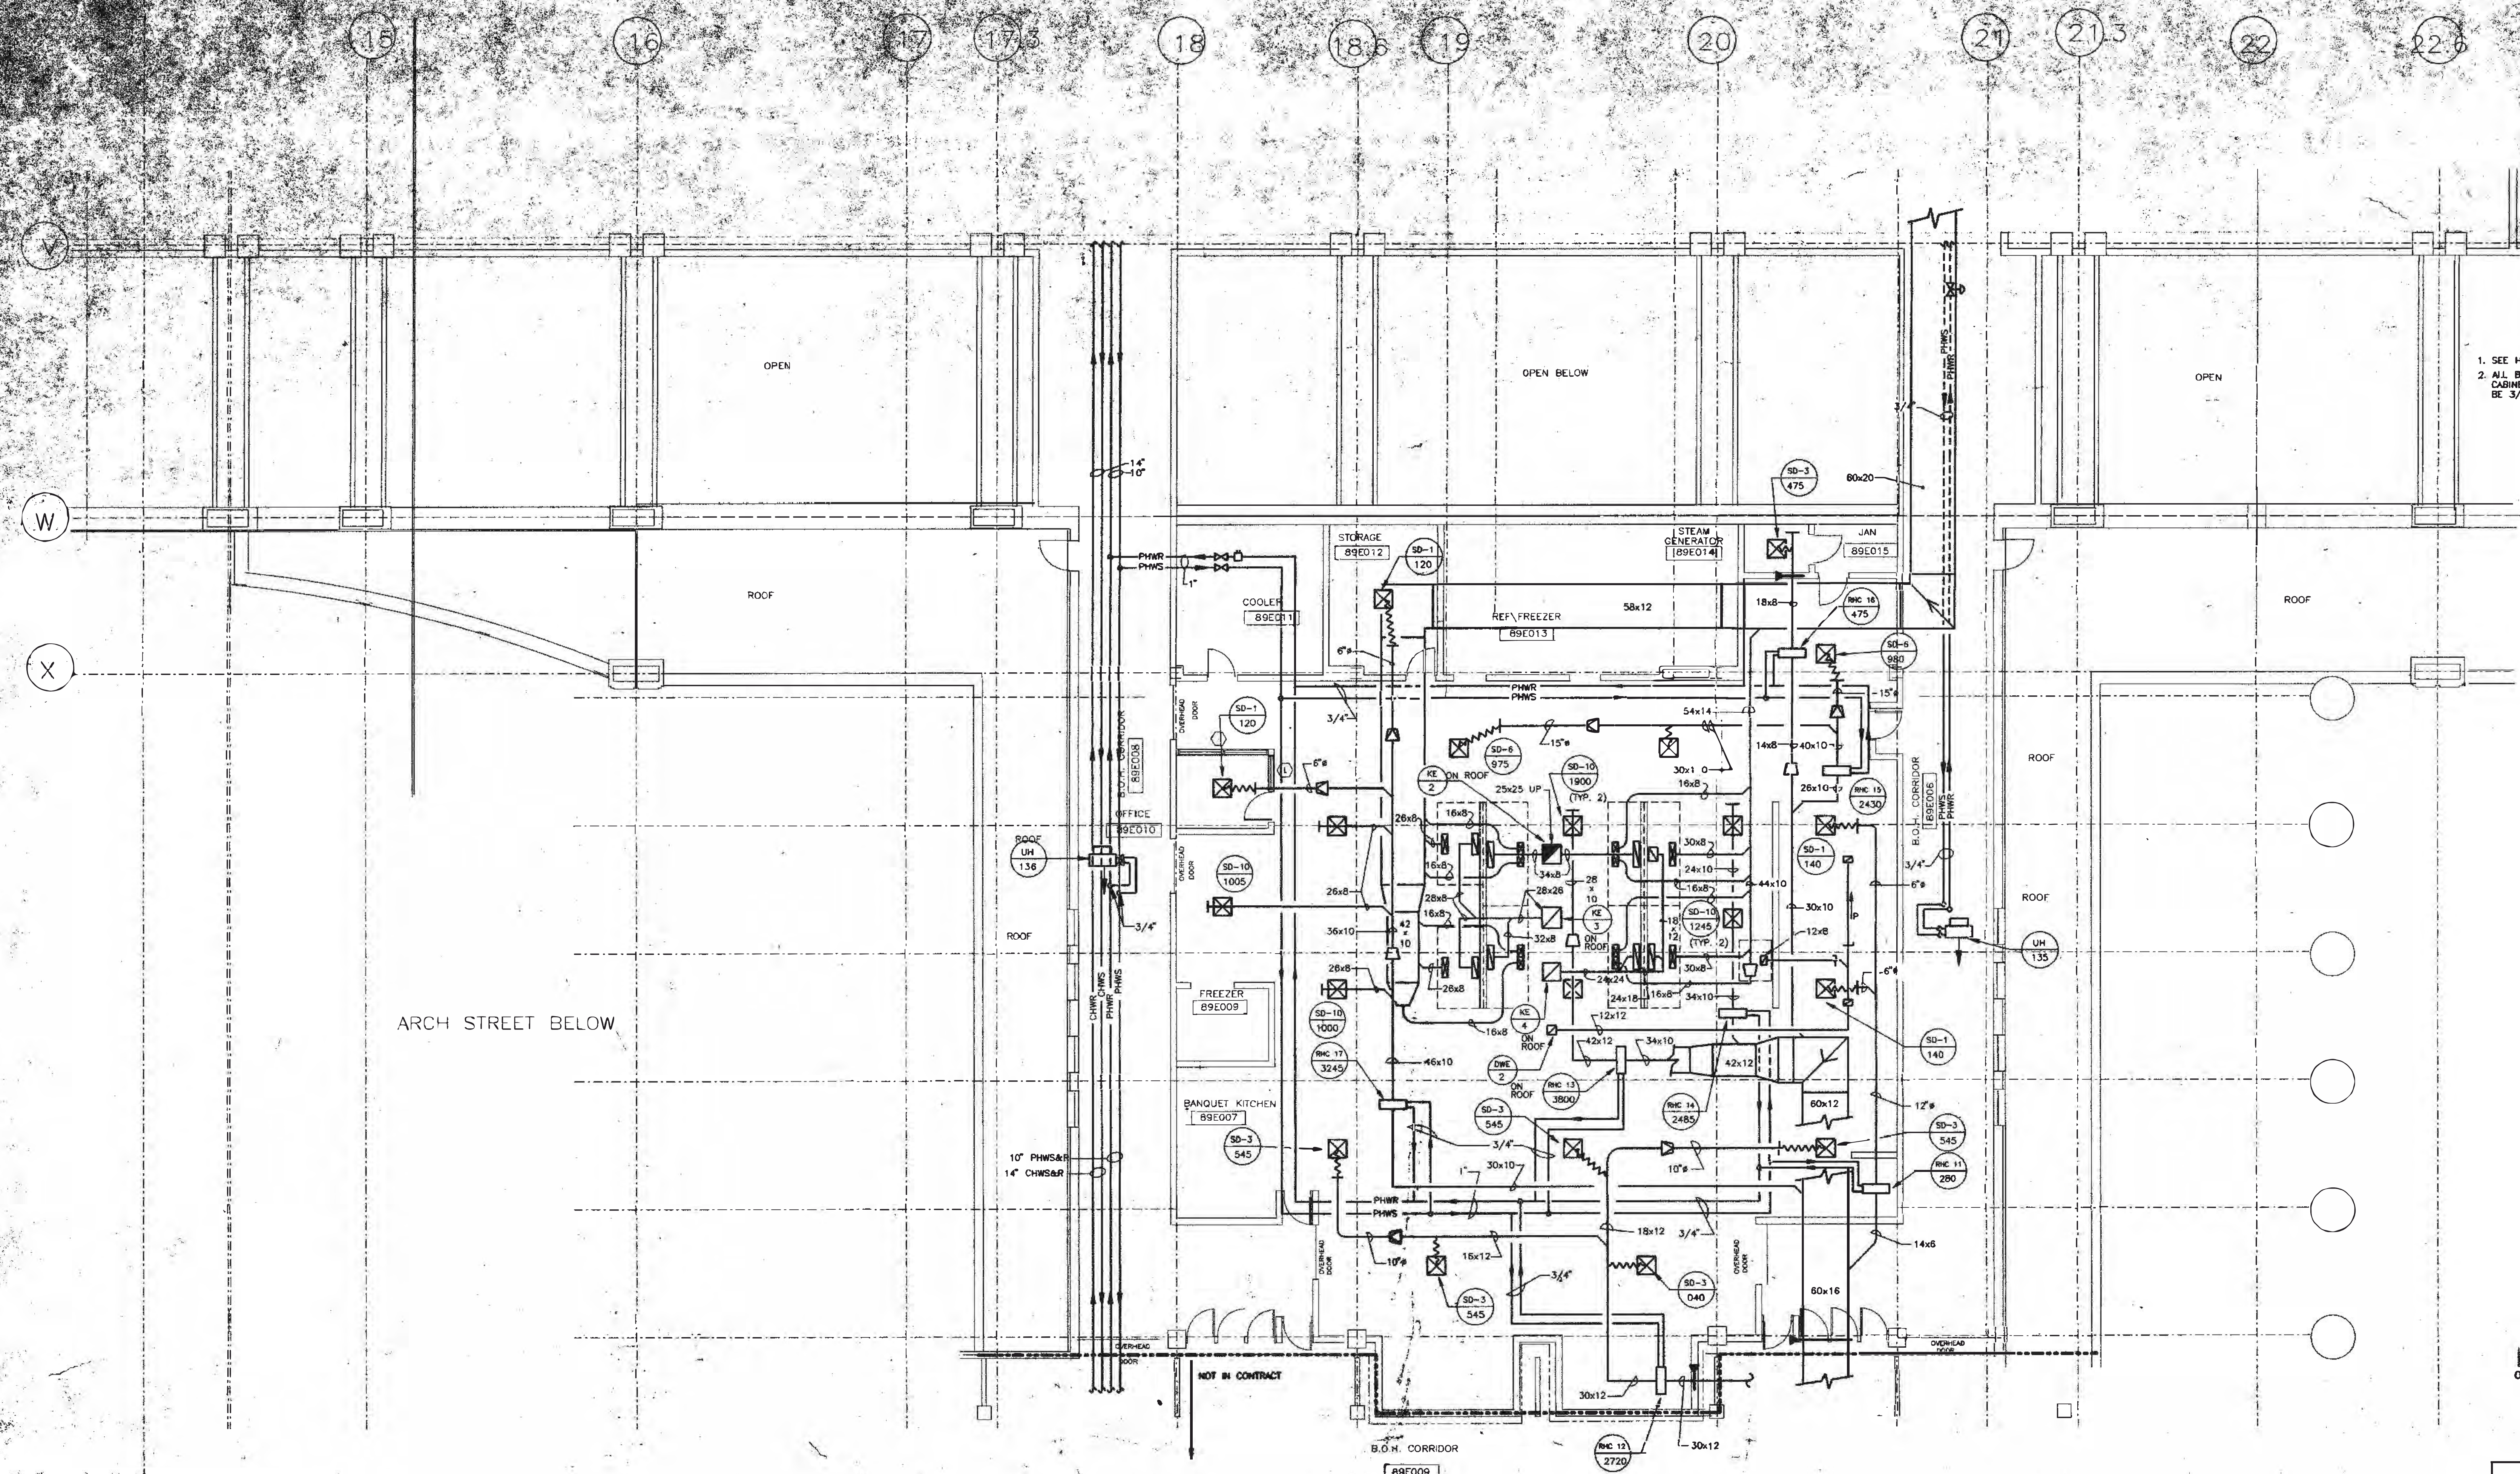

GENERAL NOTES
 1. SEE HHV-1.01 GENERAL NOTES.
 2. ALL BRANCH PIPING RUNGOTS TO UNIT HEADERS, CABINET UNIT HEADERS AND HEATING COILS SHALL BE 3/4" PIPE SIZE, UNLESS OTHERWISE NOTED.

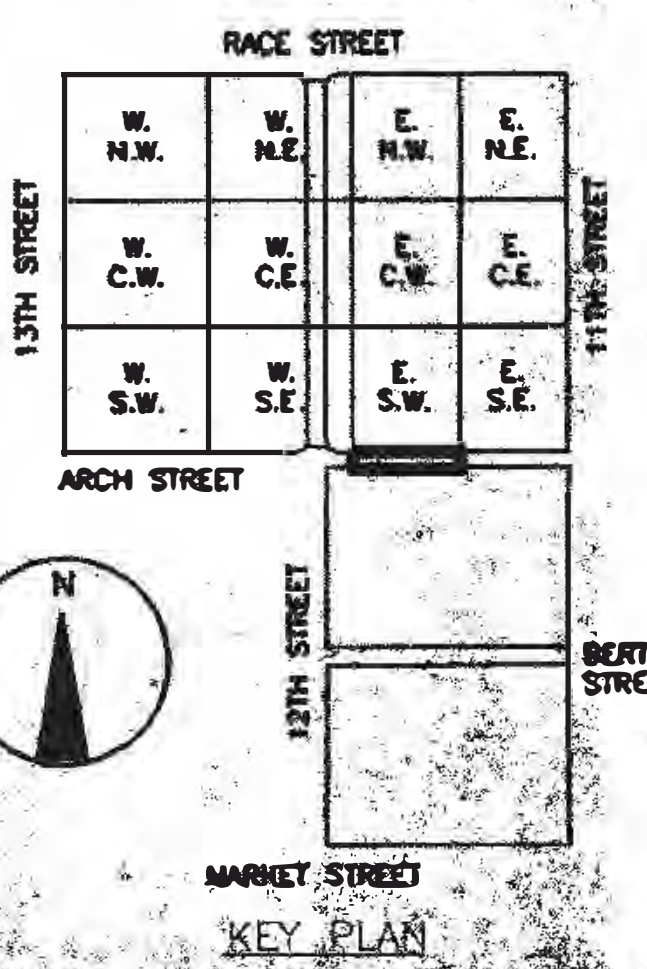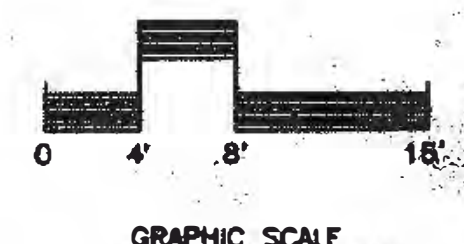

PHILADELPHIA, PENNSYLVANIA
 KELLY MAILED ARCHITECTS PLANNERS, INC.
 LIVINGSTON ROSENWALD P.C. ARCHITECTS PLANNERS CONSULTING ARCHITECTS
 PENNELL WILTBERGER INC.
 PHILADELPHIA DESIGN COLLABORATIVE

CONSULTING ENGINEERS
 REVISIONS


All dimensions shall be verified by contractor and architect notified of any discrepancies before proceeding with construction.



DRAWING TITLE:
 FLOOR PLAN
 BALLROOM
 LEVEL 89
 BLOCK KITCHEN


PROJECT NO. 10664
 DRAWING NO. 89E009
 DATE: 11/15/90
 HHV 2.38

PENNSYLVANIA CONVENTION CENTER

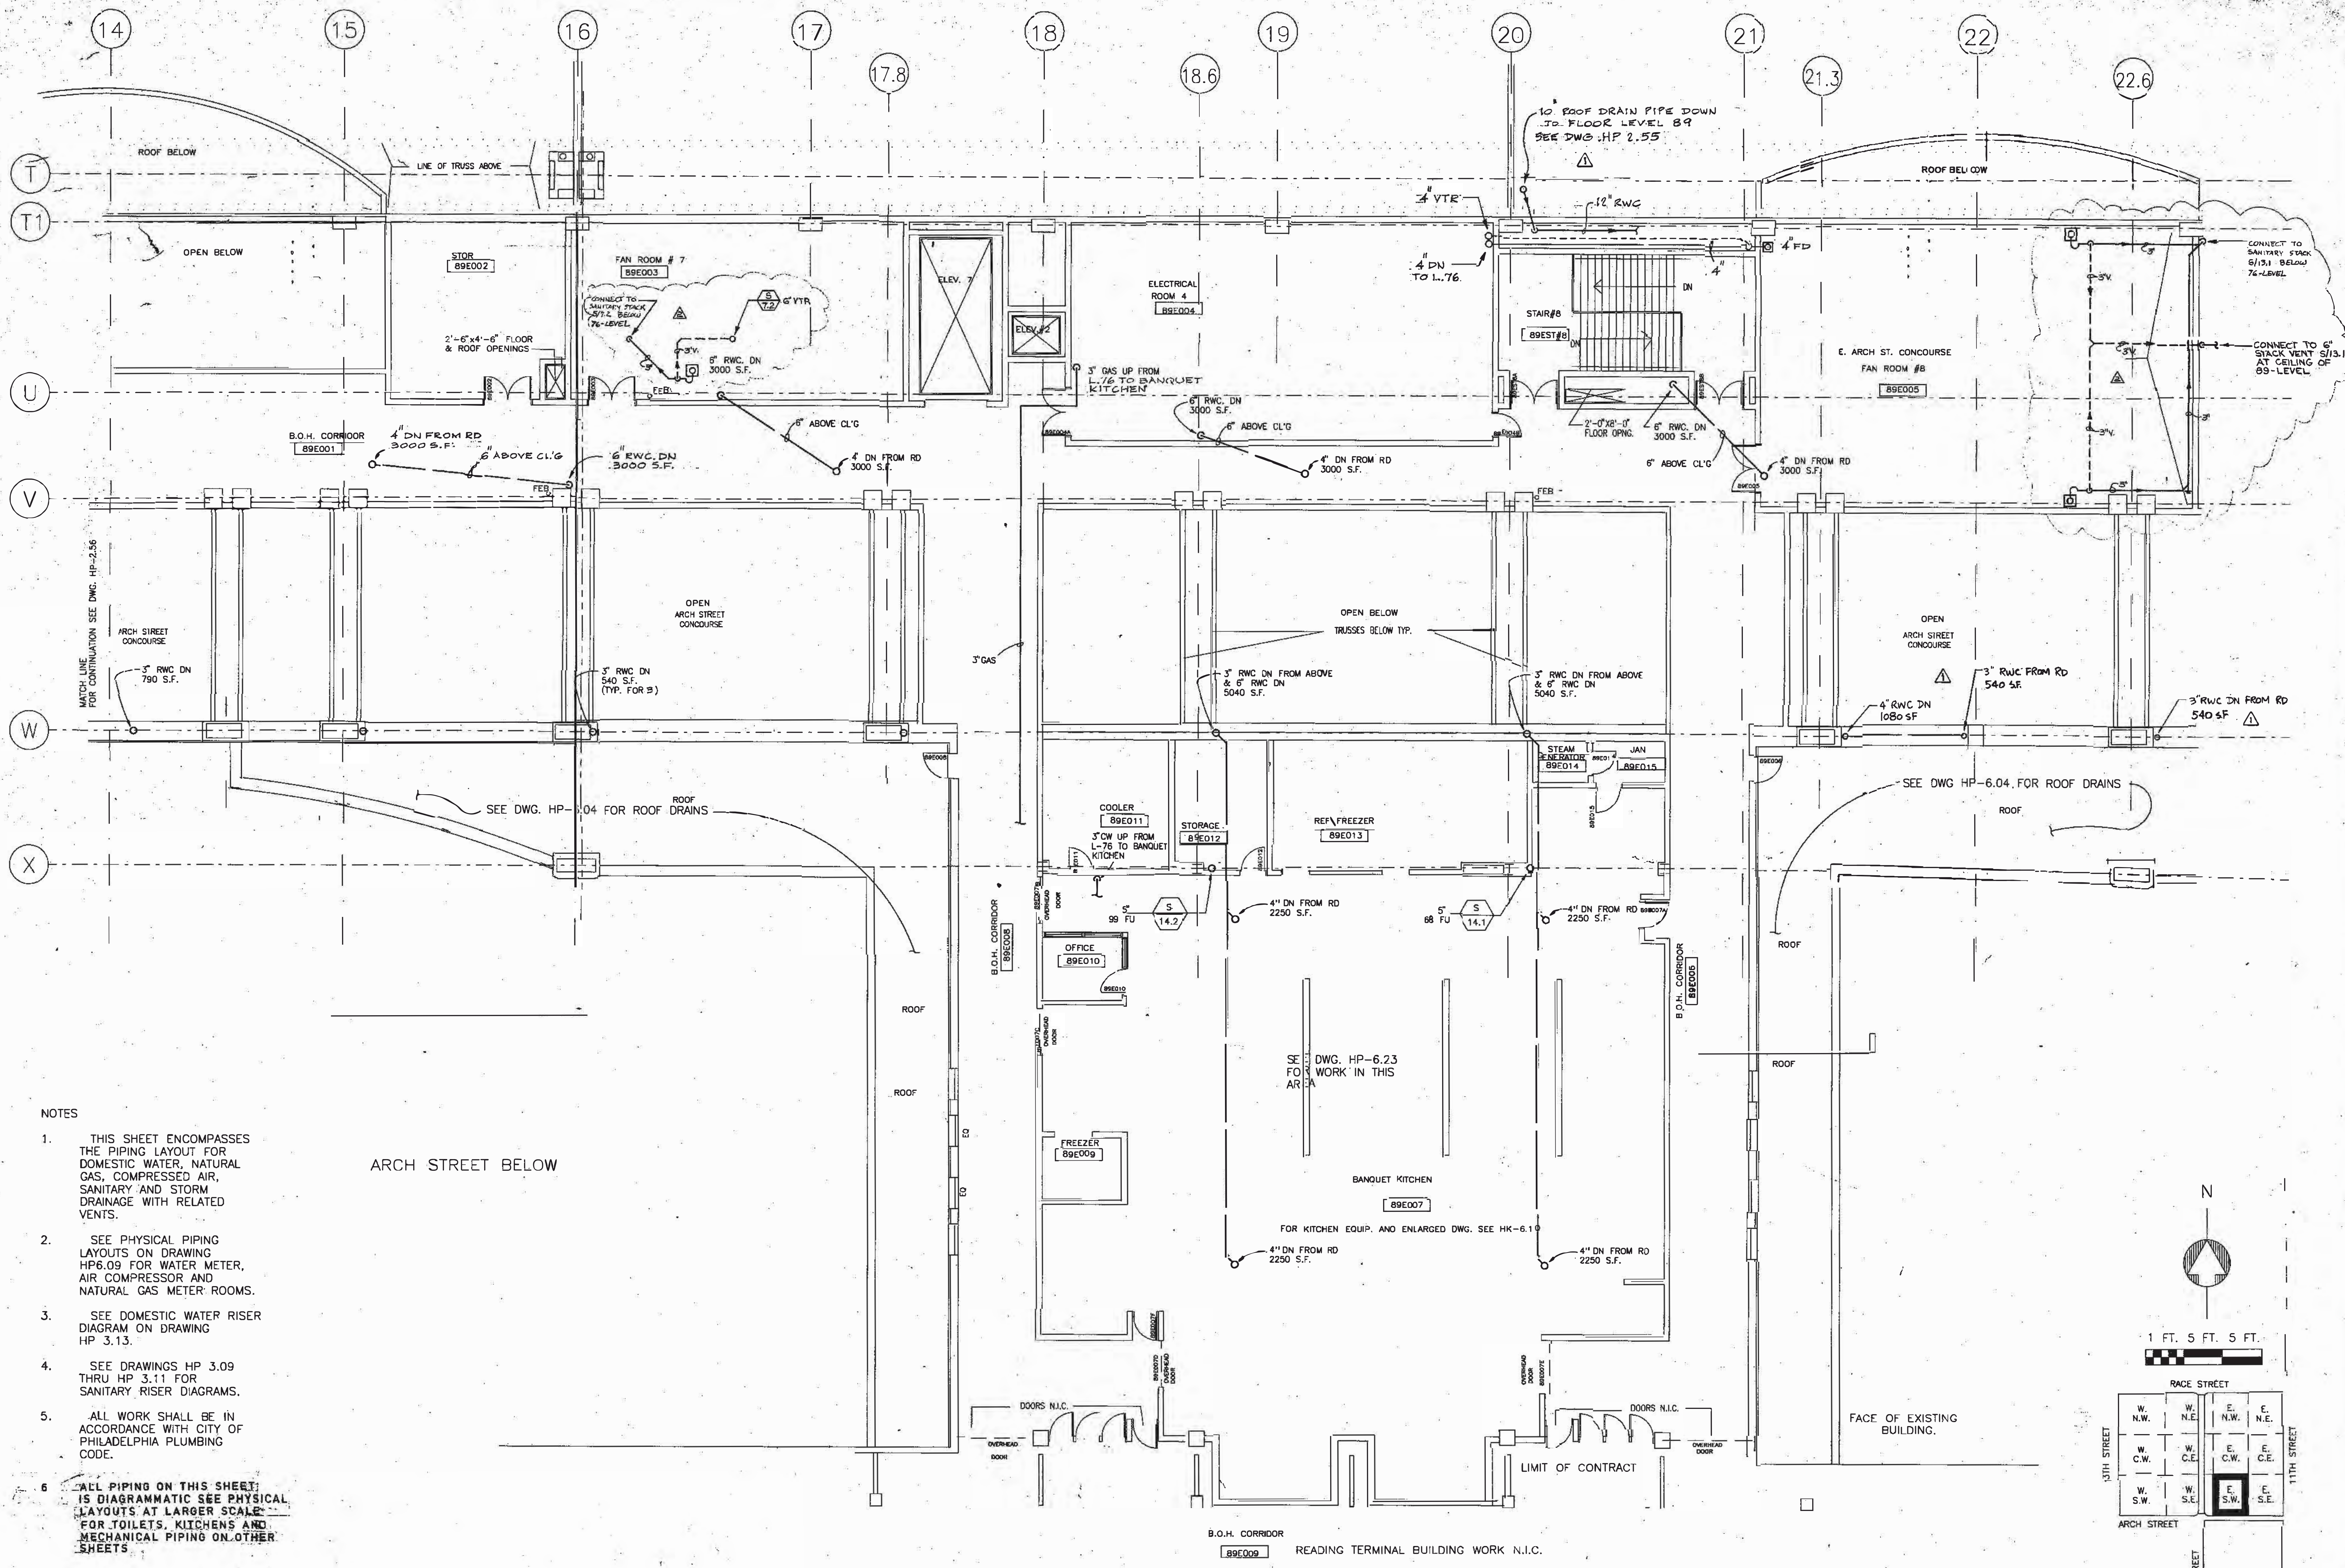

- NOTES
1. THIS SHEET ENCOMPASSES THE PIPING LAYOUT FOR DOMESTIC WATER, NATURAL GAS, COMPRESSED AIR, SANITARY AND STORM DRAINAGE WITH RELATED VENTS.
 2. SEE PHYSICAL PIPING LAYOUTS ON DRAWING HP-6.09 FOR WATER METER, AIR COMPRESSOR AND NATURAL GAS METER ROOMS.
 3. SEE DOMESTIC WATER RISER DIAGRAM ON DRAWING HP 3.13.
 4. SEE DRAWINGS HP 3.09 THRU HP 3.11 FOR SANITARY RISER DIAGRAMS.
 5. ALL WORK SHALL BE IN ACCORDANCE WITH CITY OF PHILADELPHIA PLUMBING CODE.
 6. ALL PIPING ON THIS SHEET IS DIAGNOSTIC. SEE PHYSICAL LAYOUTS AT LARGER SCALE FOR TOILETS, KITCHENS AND MECHANICAL PIPING ON OTHER SHEETS.

ARCH STREET BELOW

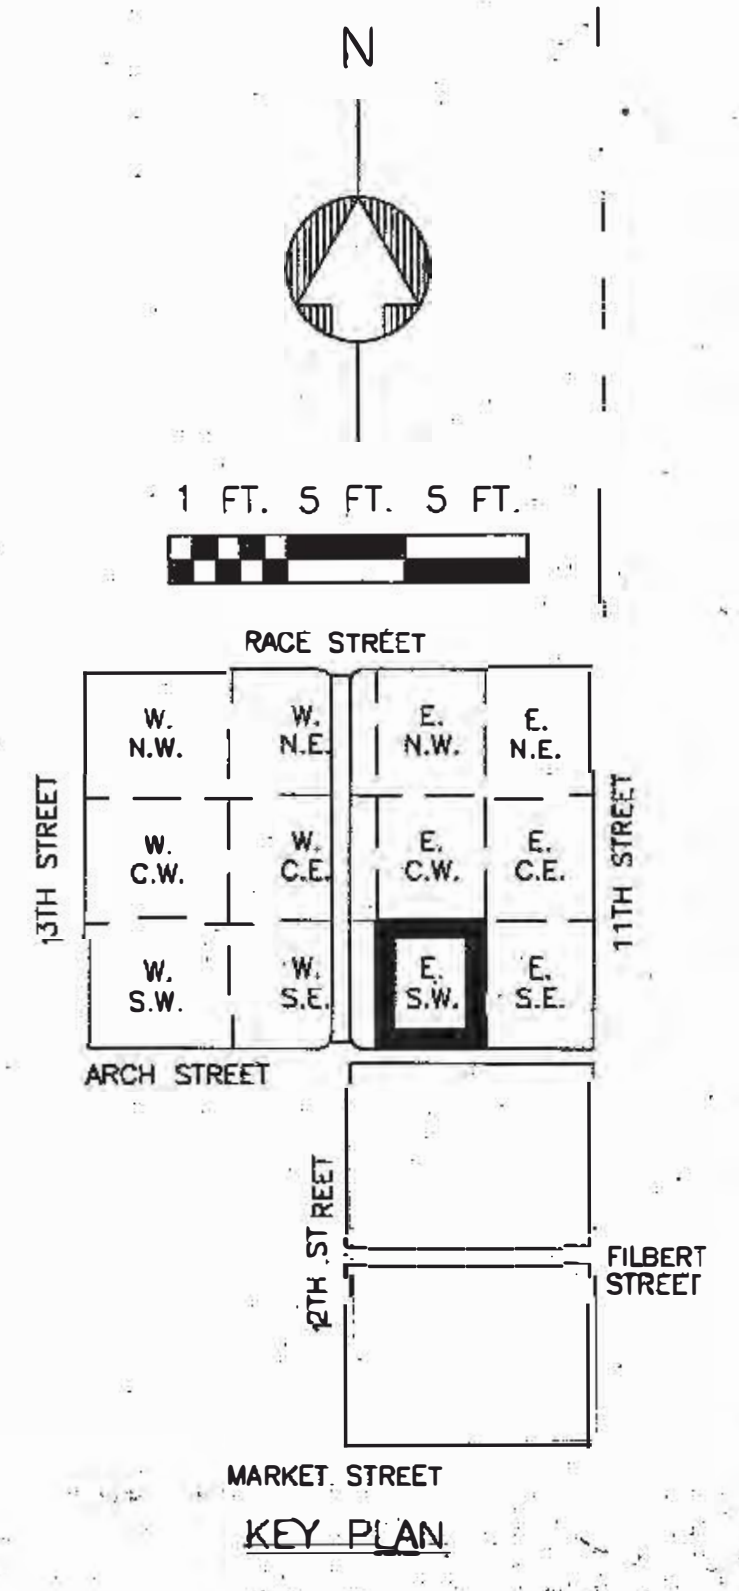

SEE DWG. HP-6.04 FOR ROOF DRAINS

B.O.H. CORRIDOR 89E009 READING TERMINAL BUILDING WORK N.I.C.

THOMPSON VENTULETT STAINBACK & ASSOCIATES, INC. ARCHITECTS

VITETTA GROUP ASSOCIATED ARCHITECTS

KELLY/MAIELLO ARCHITECTS & PLANNERS, INC.

LIVINGSTON/ROSENWINKEL, P.C. ARCHITECTS & PLANNERS CONSULTING ARCHITECTS

PENNELL & WILTBERGER INC.

PHILADELPHIA DESIGN COLLABORATIVE

CONSULTING ENGINEERS

REVISIONS

ATTENDUM NO.2 10/24/90
ATTENDUM NO.4 11/6/90

All dimensions shall be verified by contractor and architect notified of any discrepancies before proceeding with construction.

1 FT. 5 FT. 5 FT.

RACE STREET

W. N.W.	W. N.E.	E. N.W.	E. N.E.
W. C.W.	W. C.E.	E. C.W.	E. C.E.
W. S.W.	W. S.E.	E. S.W.	E. S.E.

9TH STREET

11TH STREET

MARKET STREET

FILBERT STREET

KEY PLAN

PENNSYLVANIA CONVENTION CENTER

PHILADELPHIA, PENNSYLVANIA

DRAWING TITLE
FLOOR PLAN
BALLROOM
LEVEL
89


BLOCK "E" S.W.

PROJECT NO. DRAWING NO.
TVS&A 8803.00

DATE 10-04-90

HP 2/57

NOT FOR CONSTRUCTION

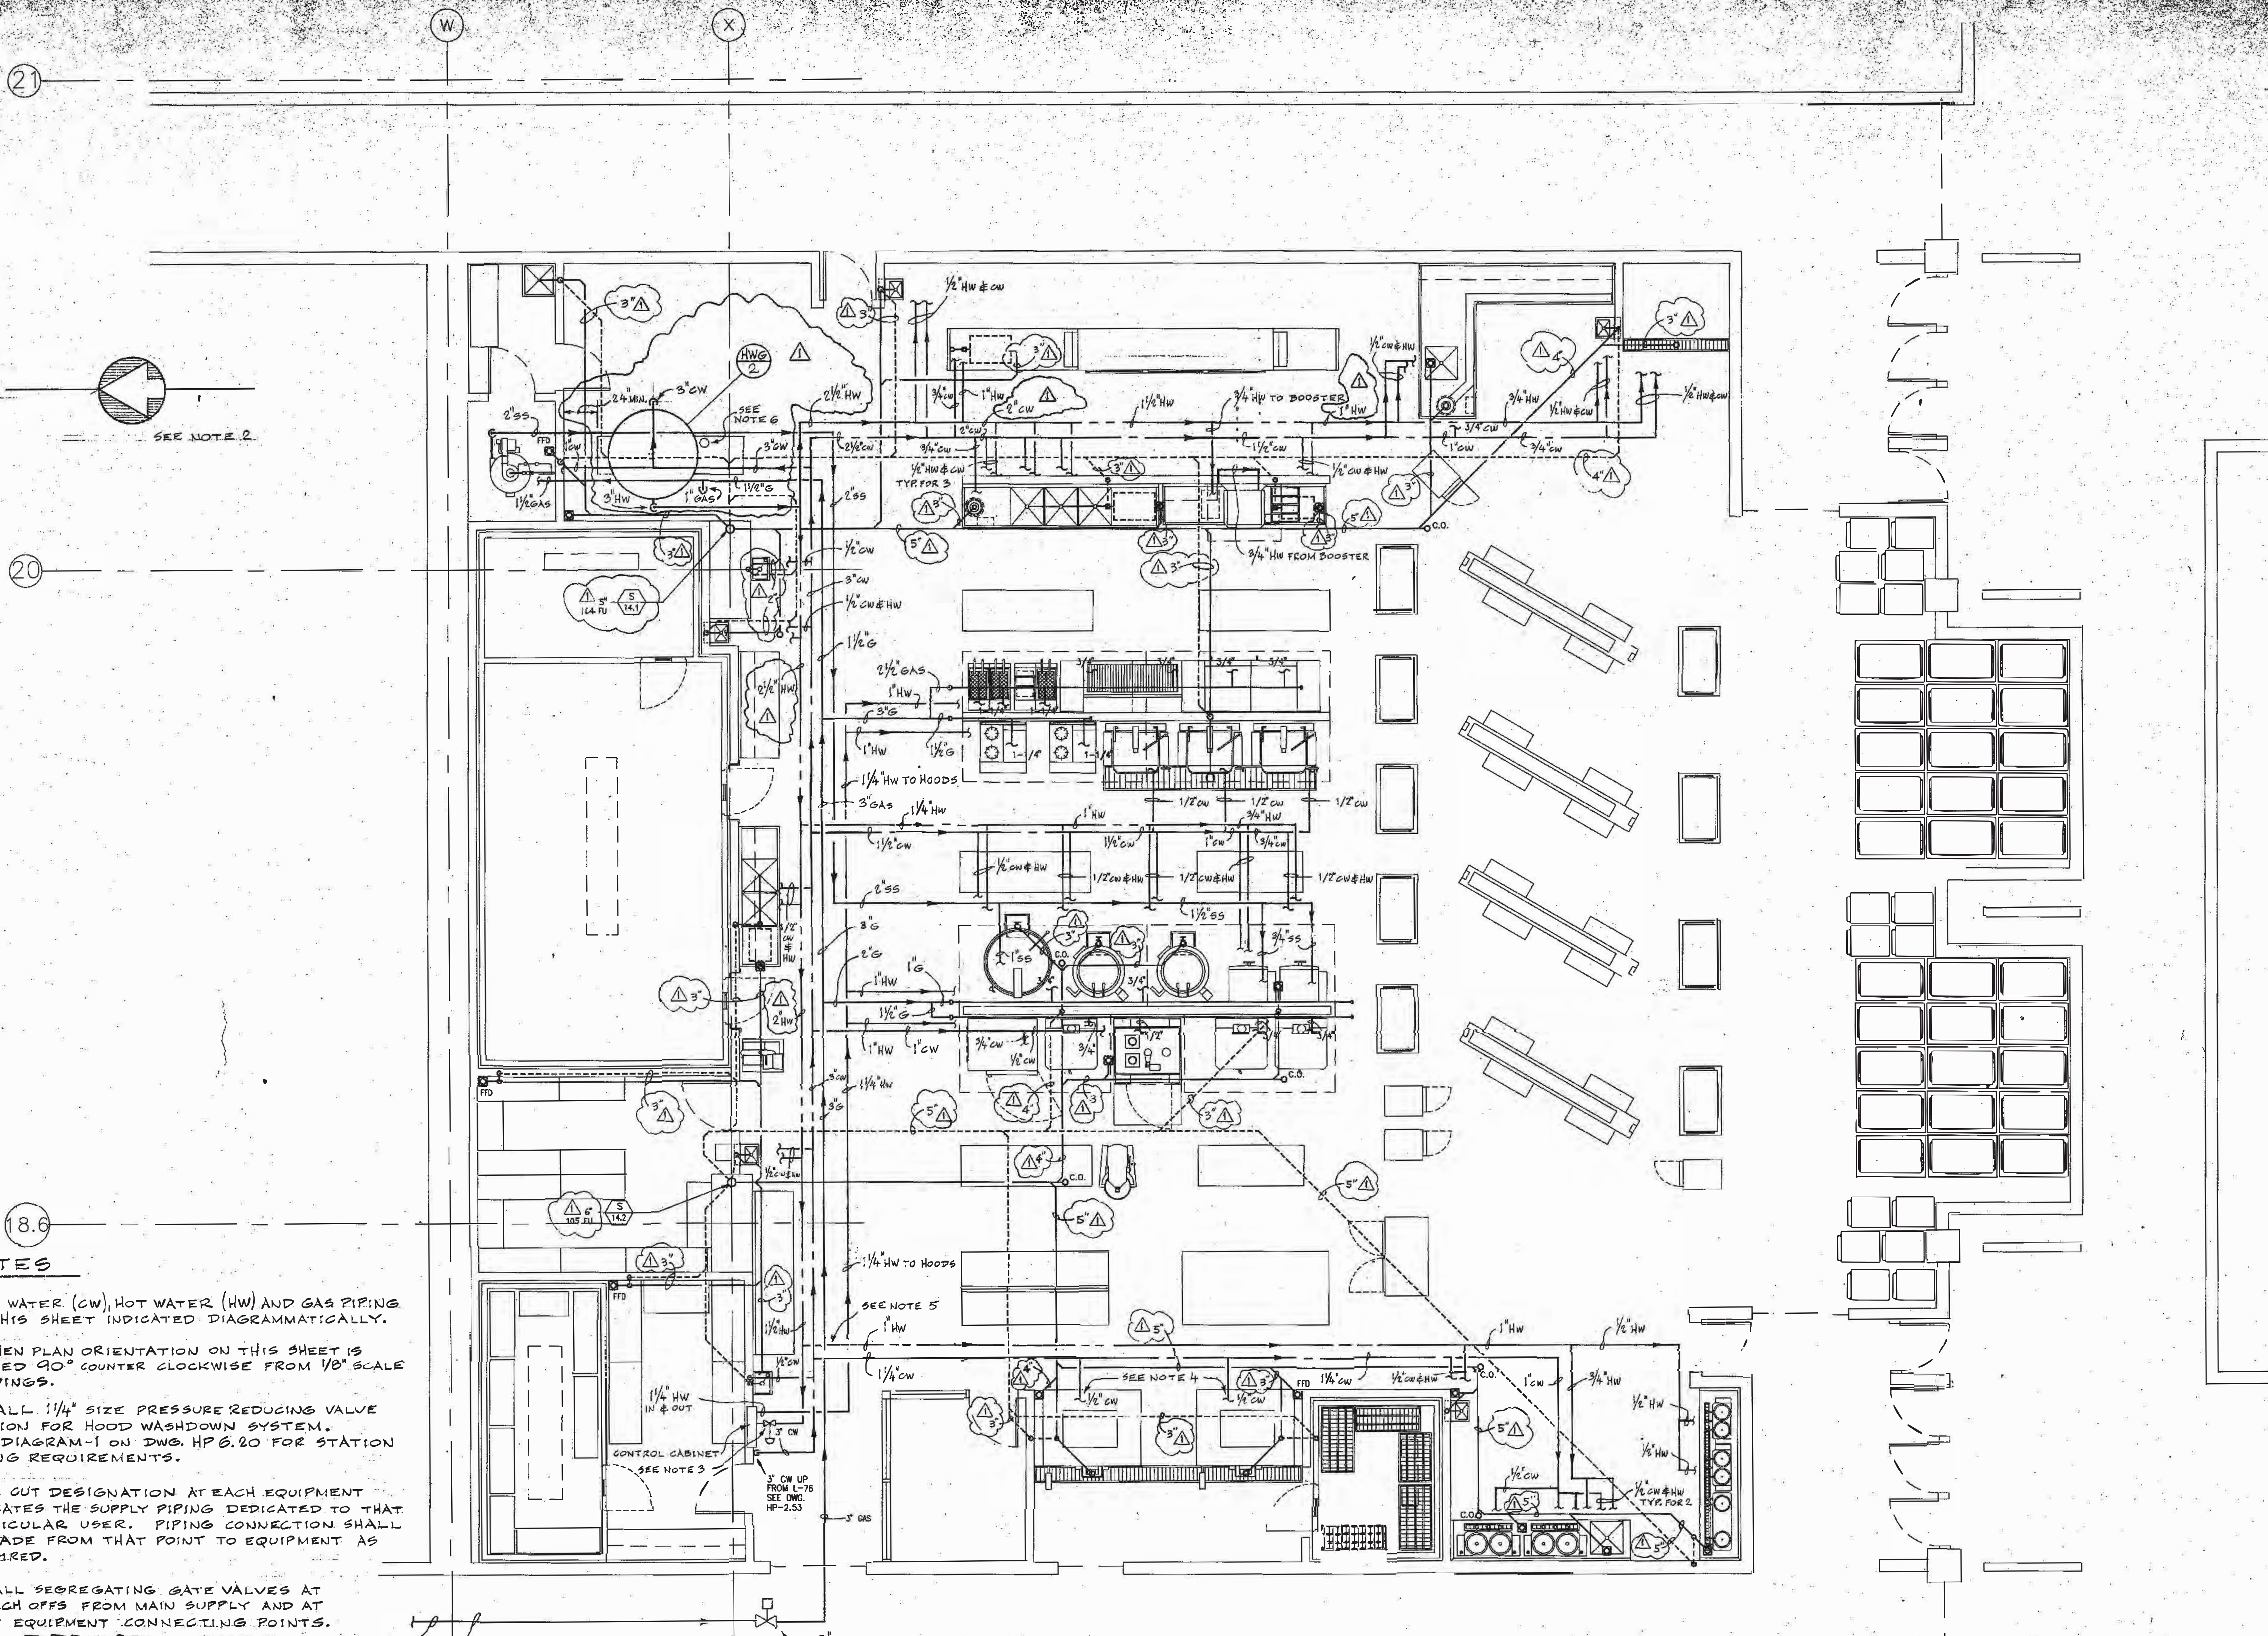


- 8.6
NOTES
- 1. COLD WATER (CW), HOT WATER (HW) AND GAS PIPING ON THIS SHEET INDICATED DIAGRAMMATICALLY.
 - 2. KITCHEN PLAN ORIENTATION ON THIS SHEET IS TURNED 90° COUNTER CLOCKWISE FROM 1/8" SCALE DRAWINGS.
 - 3. INSTALL 1/4" SIZE PRESSURE REDUCING VALVE STATION FOR HOOD WASHDOWN SYSTEM. SEE DIAGRAM-1 ON DWG. HP 6.20 FOR STATION PIPING REQUIREMENTS.
 - 4. PIPE CUT DESIGNATION AT EACH EQUIPMENT INDICATES THE SUPPLY PIPING DEDICATED TO THAT PARTICULAR USER. PIPING CONNECTION SHALL BE MADE FROM THAT POINT TO EQUIPMENT AS REQUIRED.
 - 5. INSTALL SEGREGATING GATE VALVES AT BRANCH OFFS FROM MAIN SUPPLY AND AT EACH EQUIPMENT CONNECTING POINTS.
 - 6. PROVIDE 5" DIA. FLOE GAS DUCT FOR HOT WATER GENERATOR, (TYP. FOR 1) COORDINATE INSTALLATION WITH HVAC TRADE.
 - 7. PIPING CONNECTIONS TO SOLENOID VALVES SHALL BE COORDINATED WITH KITCHEN EQUIPMENT REQUIREMENTS.

SEE DRAWING HP 6.27 FOR CONTINUATION.

EMERGENCY GAS SHUTOFF VALVE LOCATED OUTSIDE OF KITCHEN AREA. COORDINATE WITH ELECTRICAL REQUIREMENTS.

NOTE SEE DETAIL-1 ON DWG. HP 6.19 FOR GREASE INTERCEPTOR AND VENTING AND FAT PIPING.

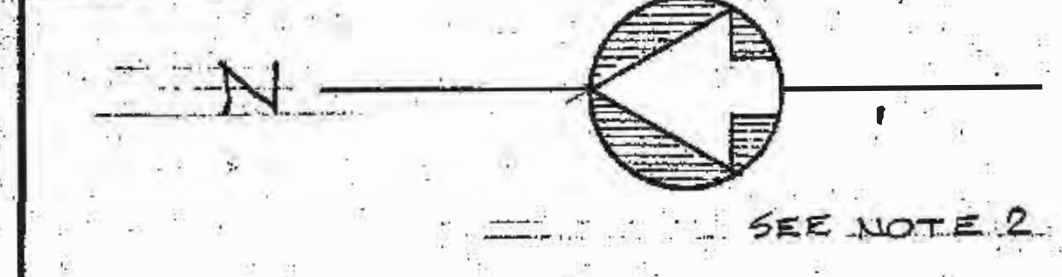

THOMPSON
VENTULETT
STAINBACK
& ASSOCIATES, INC.
ARCHITECTS

VITETTA
GROUP
ASSOCIATED ARCHITECTS

KELLY/
MAIELLO
ARCHITECTS &
PLANNERS, INC.

LIVINGSTON/
ROSENWINKEL,
P.C.
ARCHITECTS &
PLANNERS
CONSULTING ARCHITECTS

PENNELL &
WILTBERGER
INC.

PHILADELPHIA
DESIGN
COLLABORATIVE

CONSULTING ENGINEERS

REVISIONS

ADDITION NO.2 10/24/89


NO.	REVISION

All dimensions shall be verified by contractor and engineer. Notify of any discrepancies before proceeding with construction.




Fahad Force
DRAWING TITLE
BANQUET
KITCHEN
PLUMBING PLAN
89

PROJECT NO. DRAWING NO.
TVS&A
8803.50
PDC
89KIT-P
HP
ISSUE DATE
10-04-89
6.23

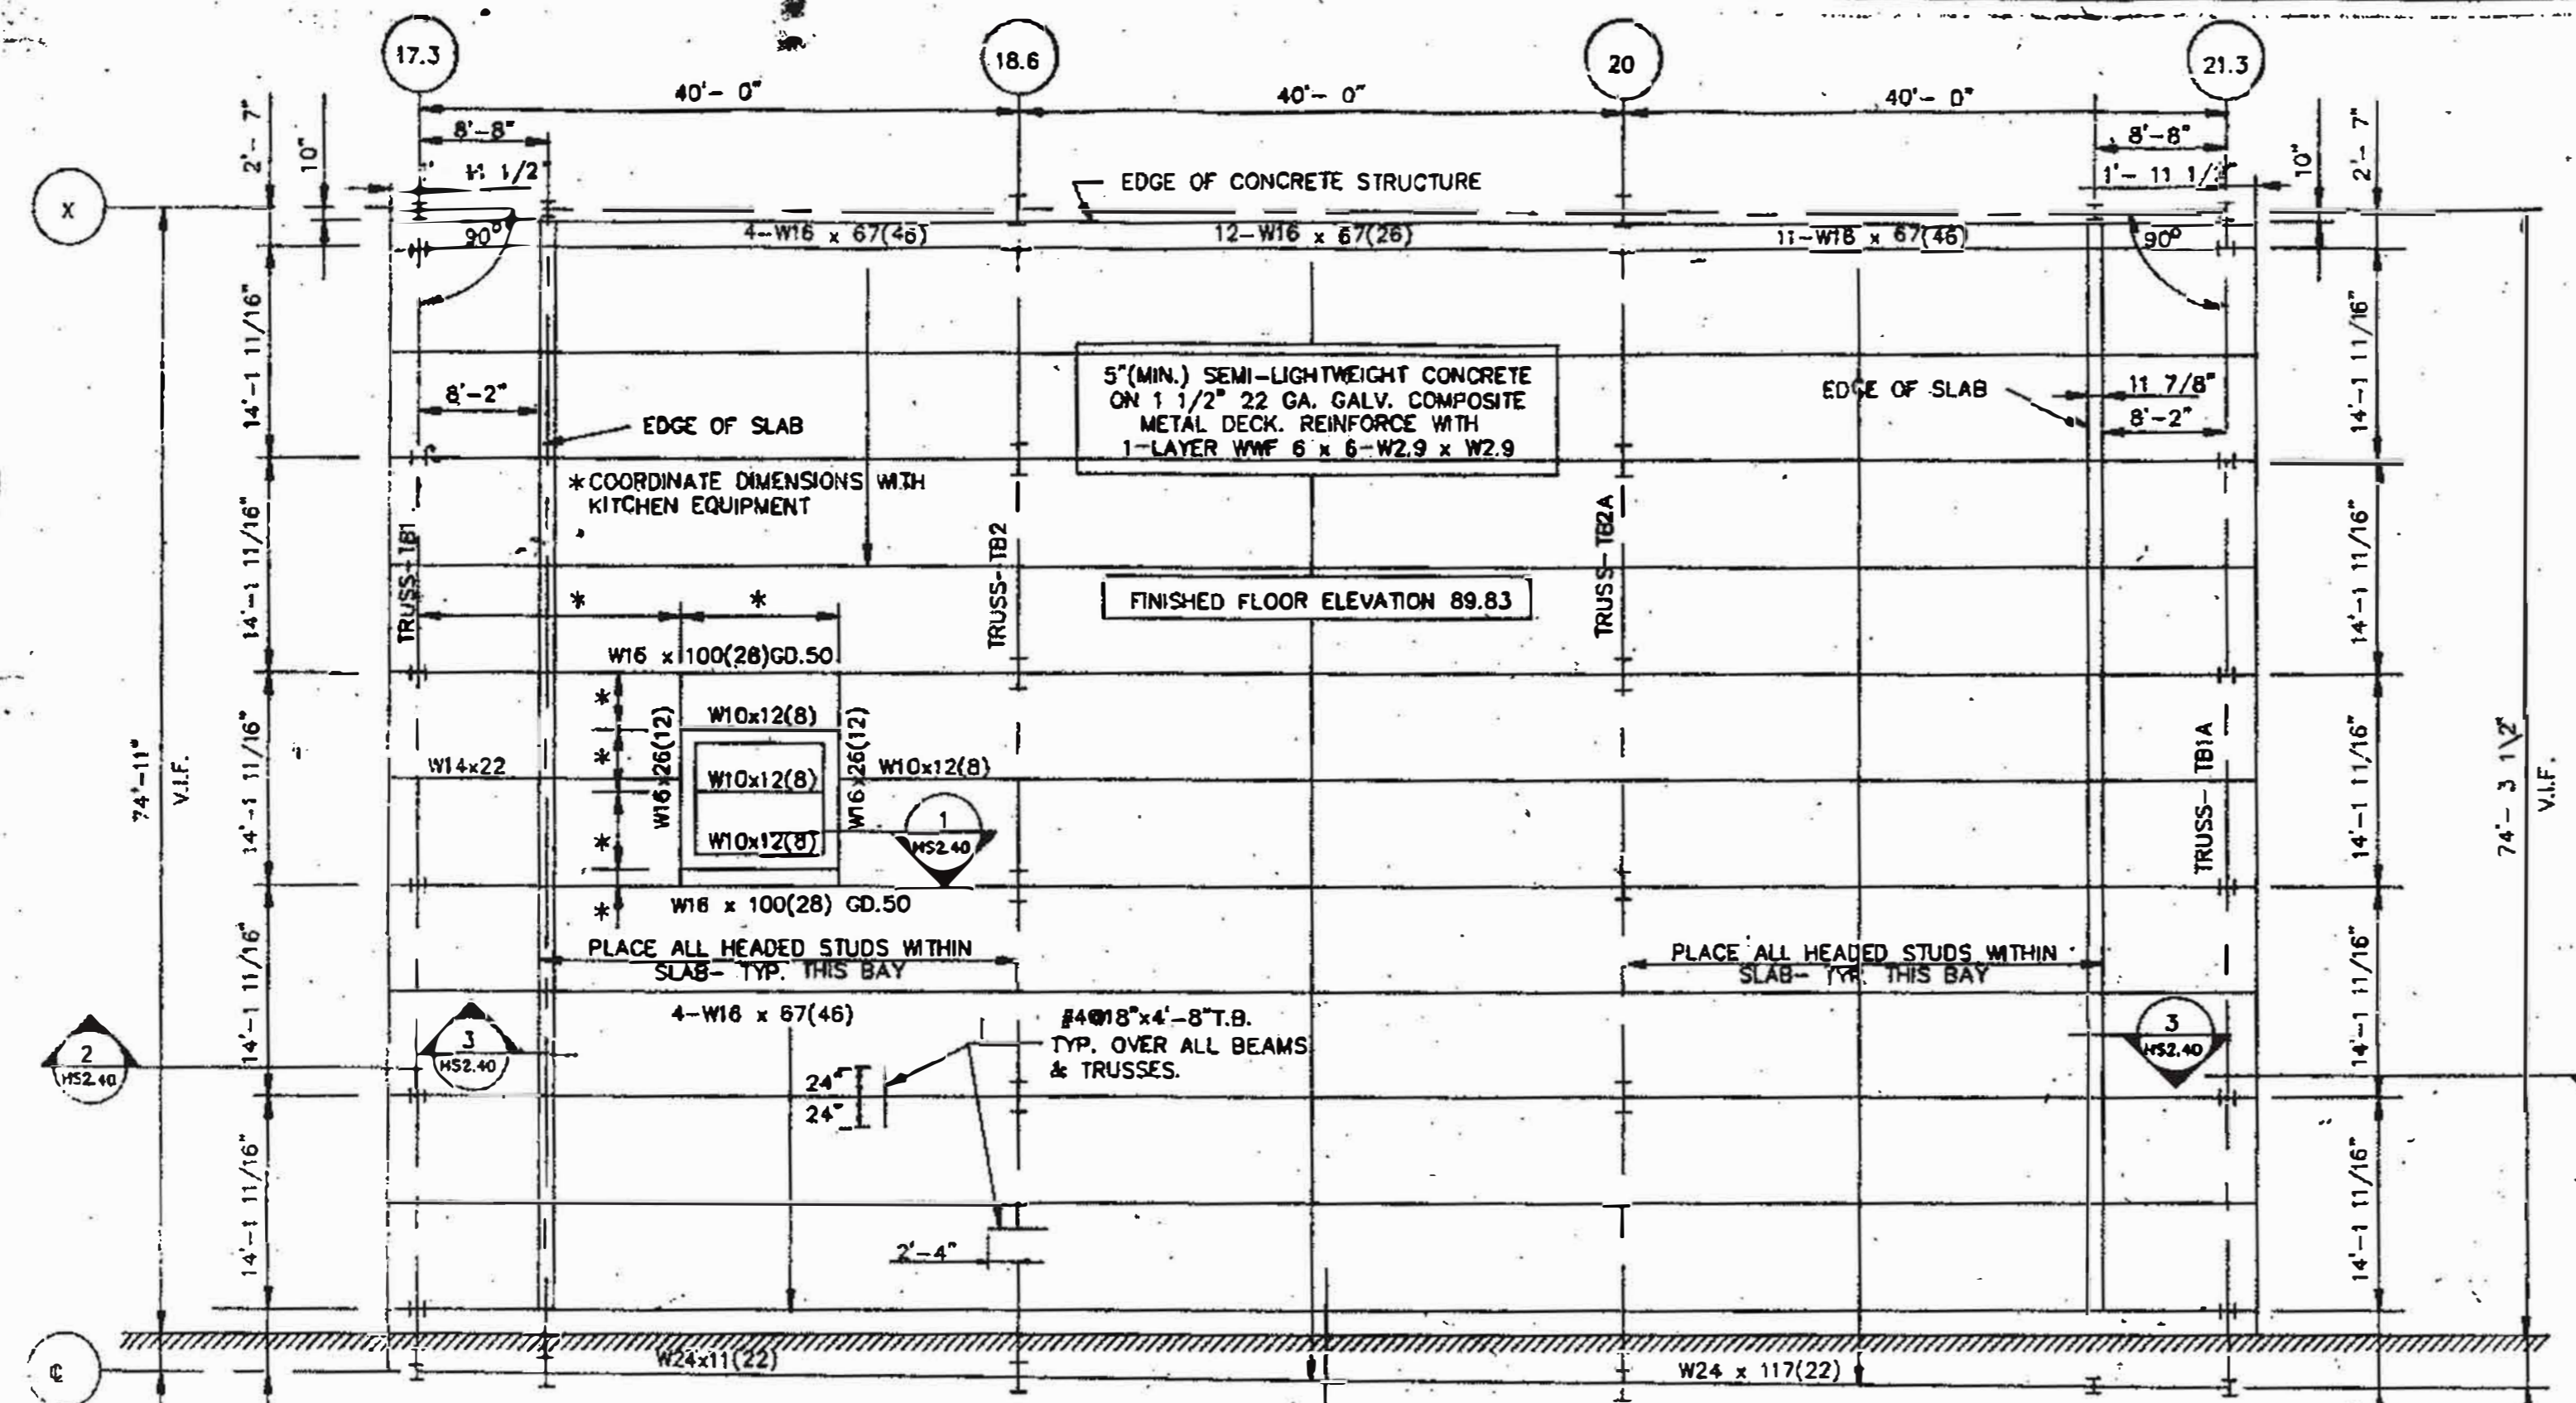


FRAMING PLAN @ LEVEL 89.83
SCALE: 1/8" = 1'-0"

NOTE:
 1. TOP OF STEEL ELEVATION 89.25 U.N.O.
 2. ALL STEEL IS A36 UNLESS NOTED OTHERWISE
 3. (28) INDICATES NUMBER OF 3/4" x 3 1/2" HEADED STUDS. SEE SPECIFICATIONS.
 4. 5" MINIMUM SLAB THICKNESS OCCURS UNDER 2" QUARRY TILE SETTING BED. SEE ARCHITECTURAL PLANS FOR LOCATION. OTHERWISE SLAB IS 7".

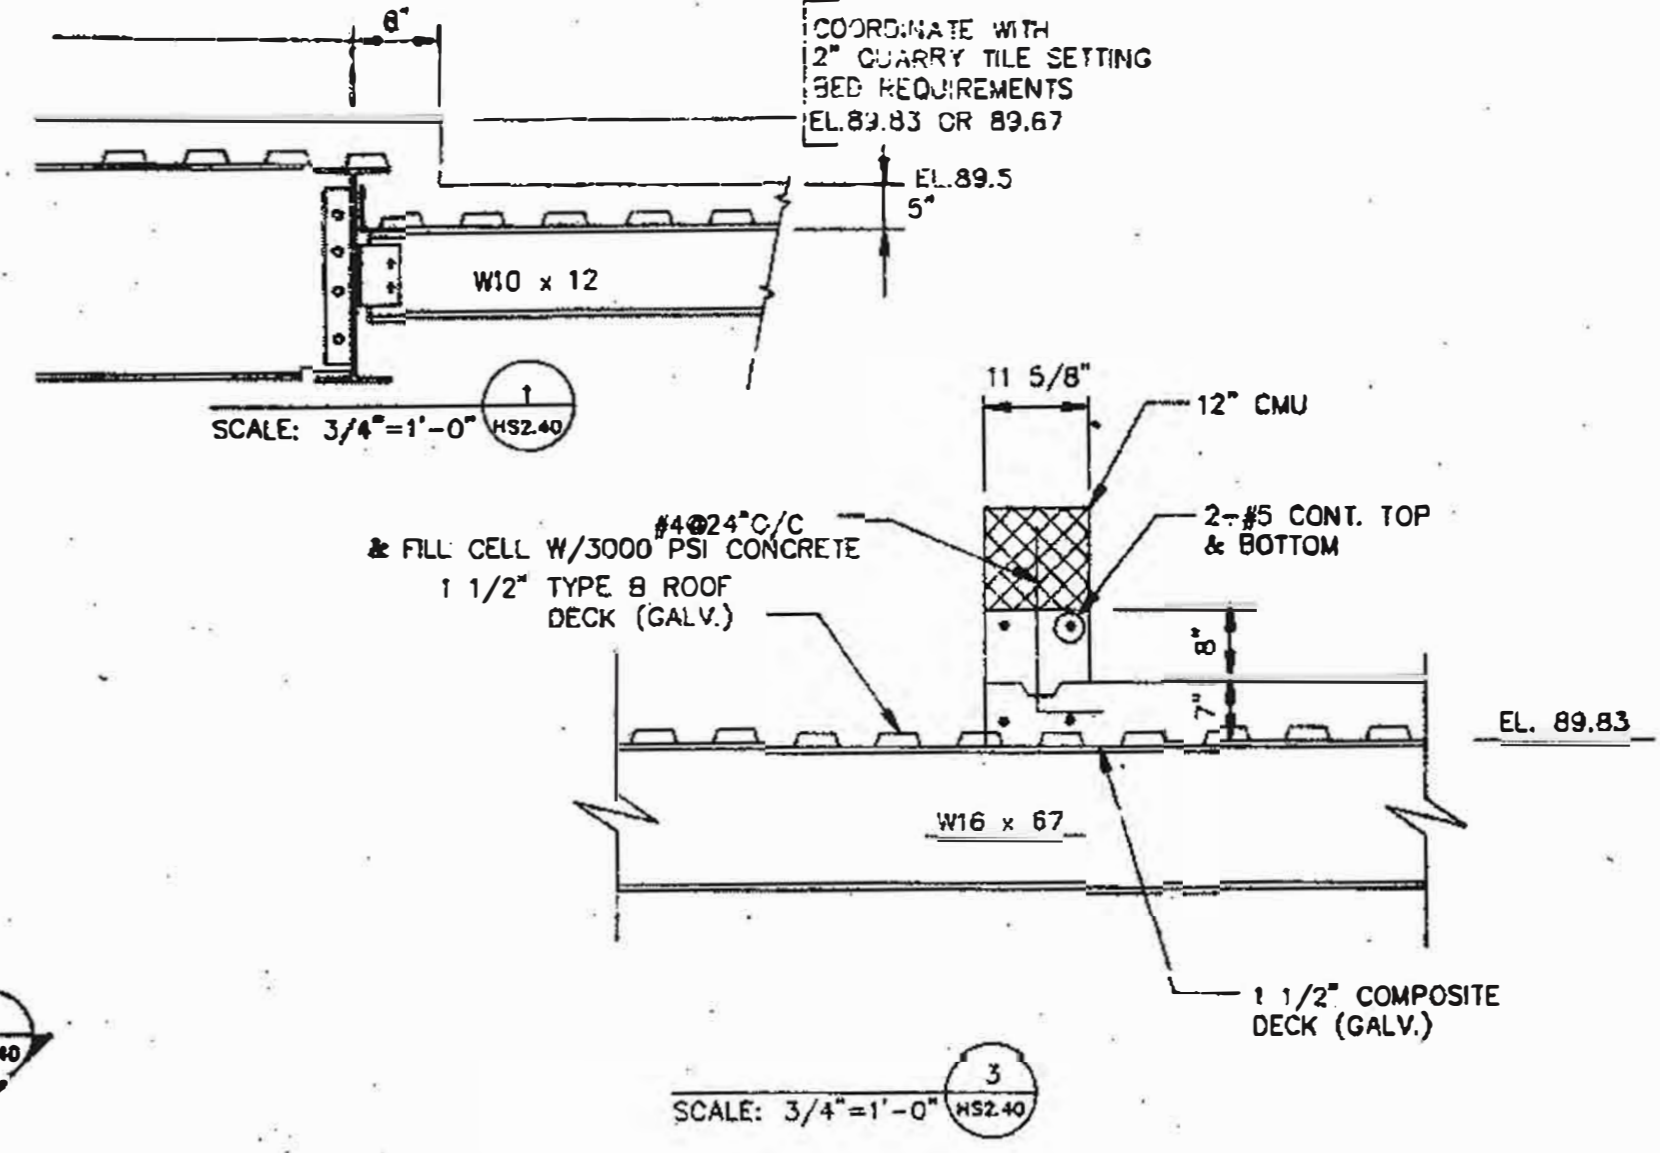


SCALE: 3/4" = 1'-0" H52.40

SCALE: 3/4" = 1'-0" H52.40

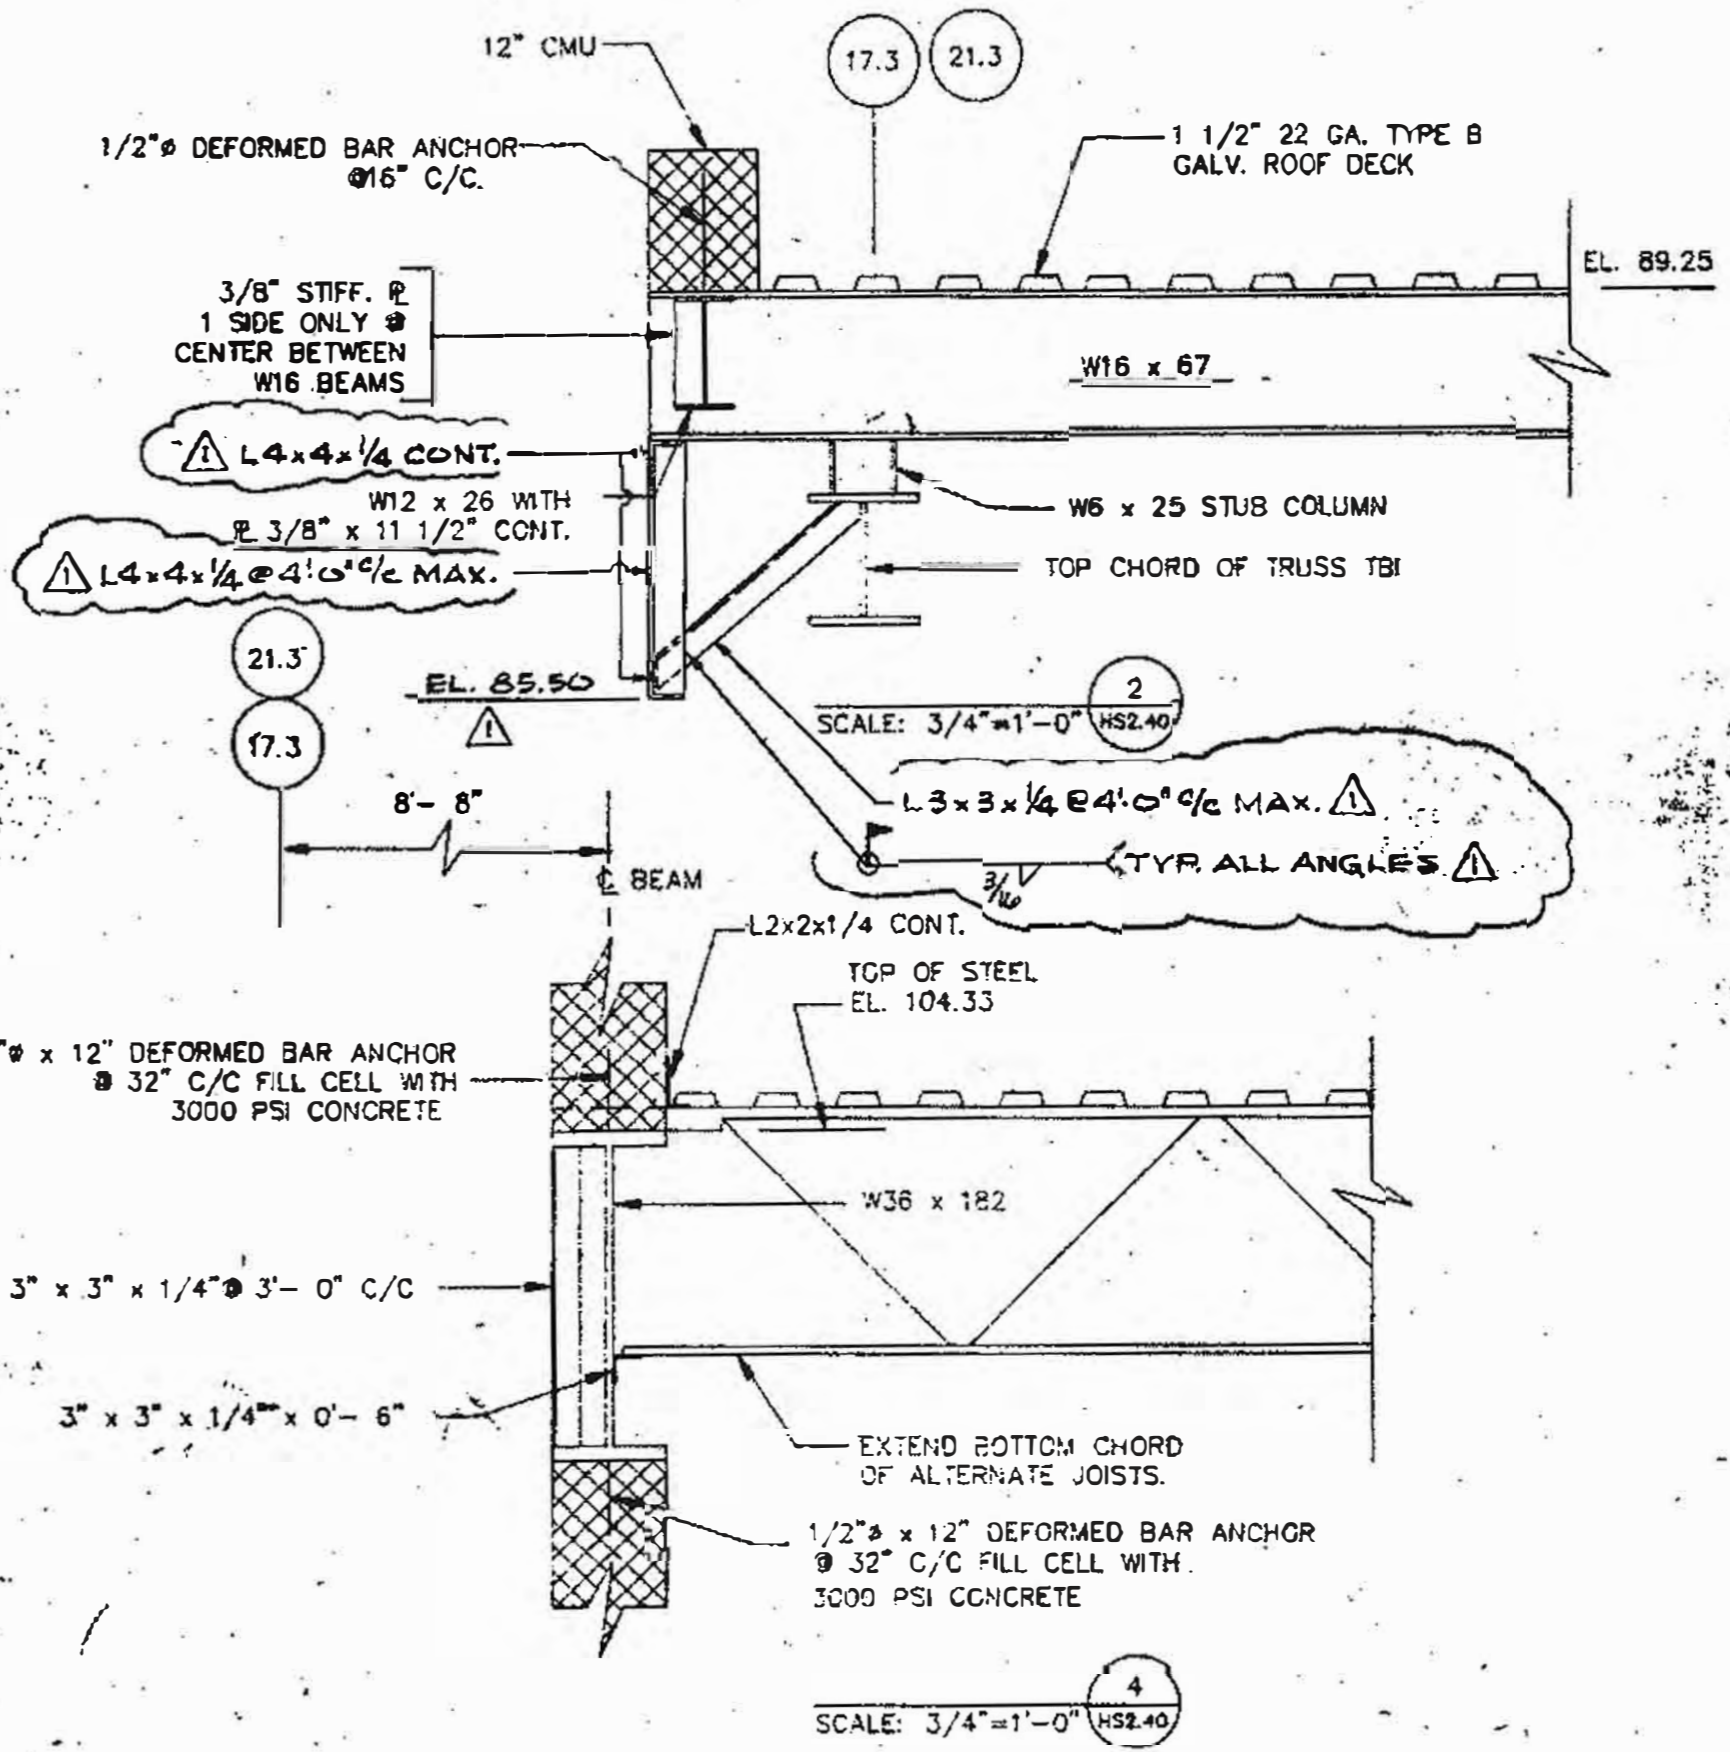

SCALE: 3/4" = 1'-0" H52.40


SCALE: 3/4" = 1'-0" H52.40

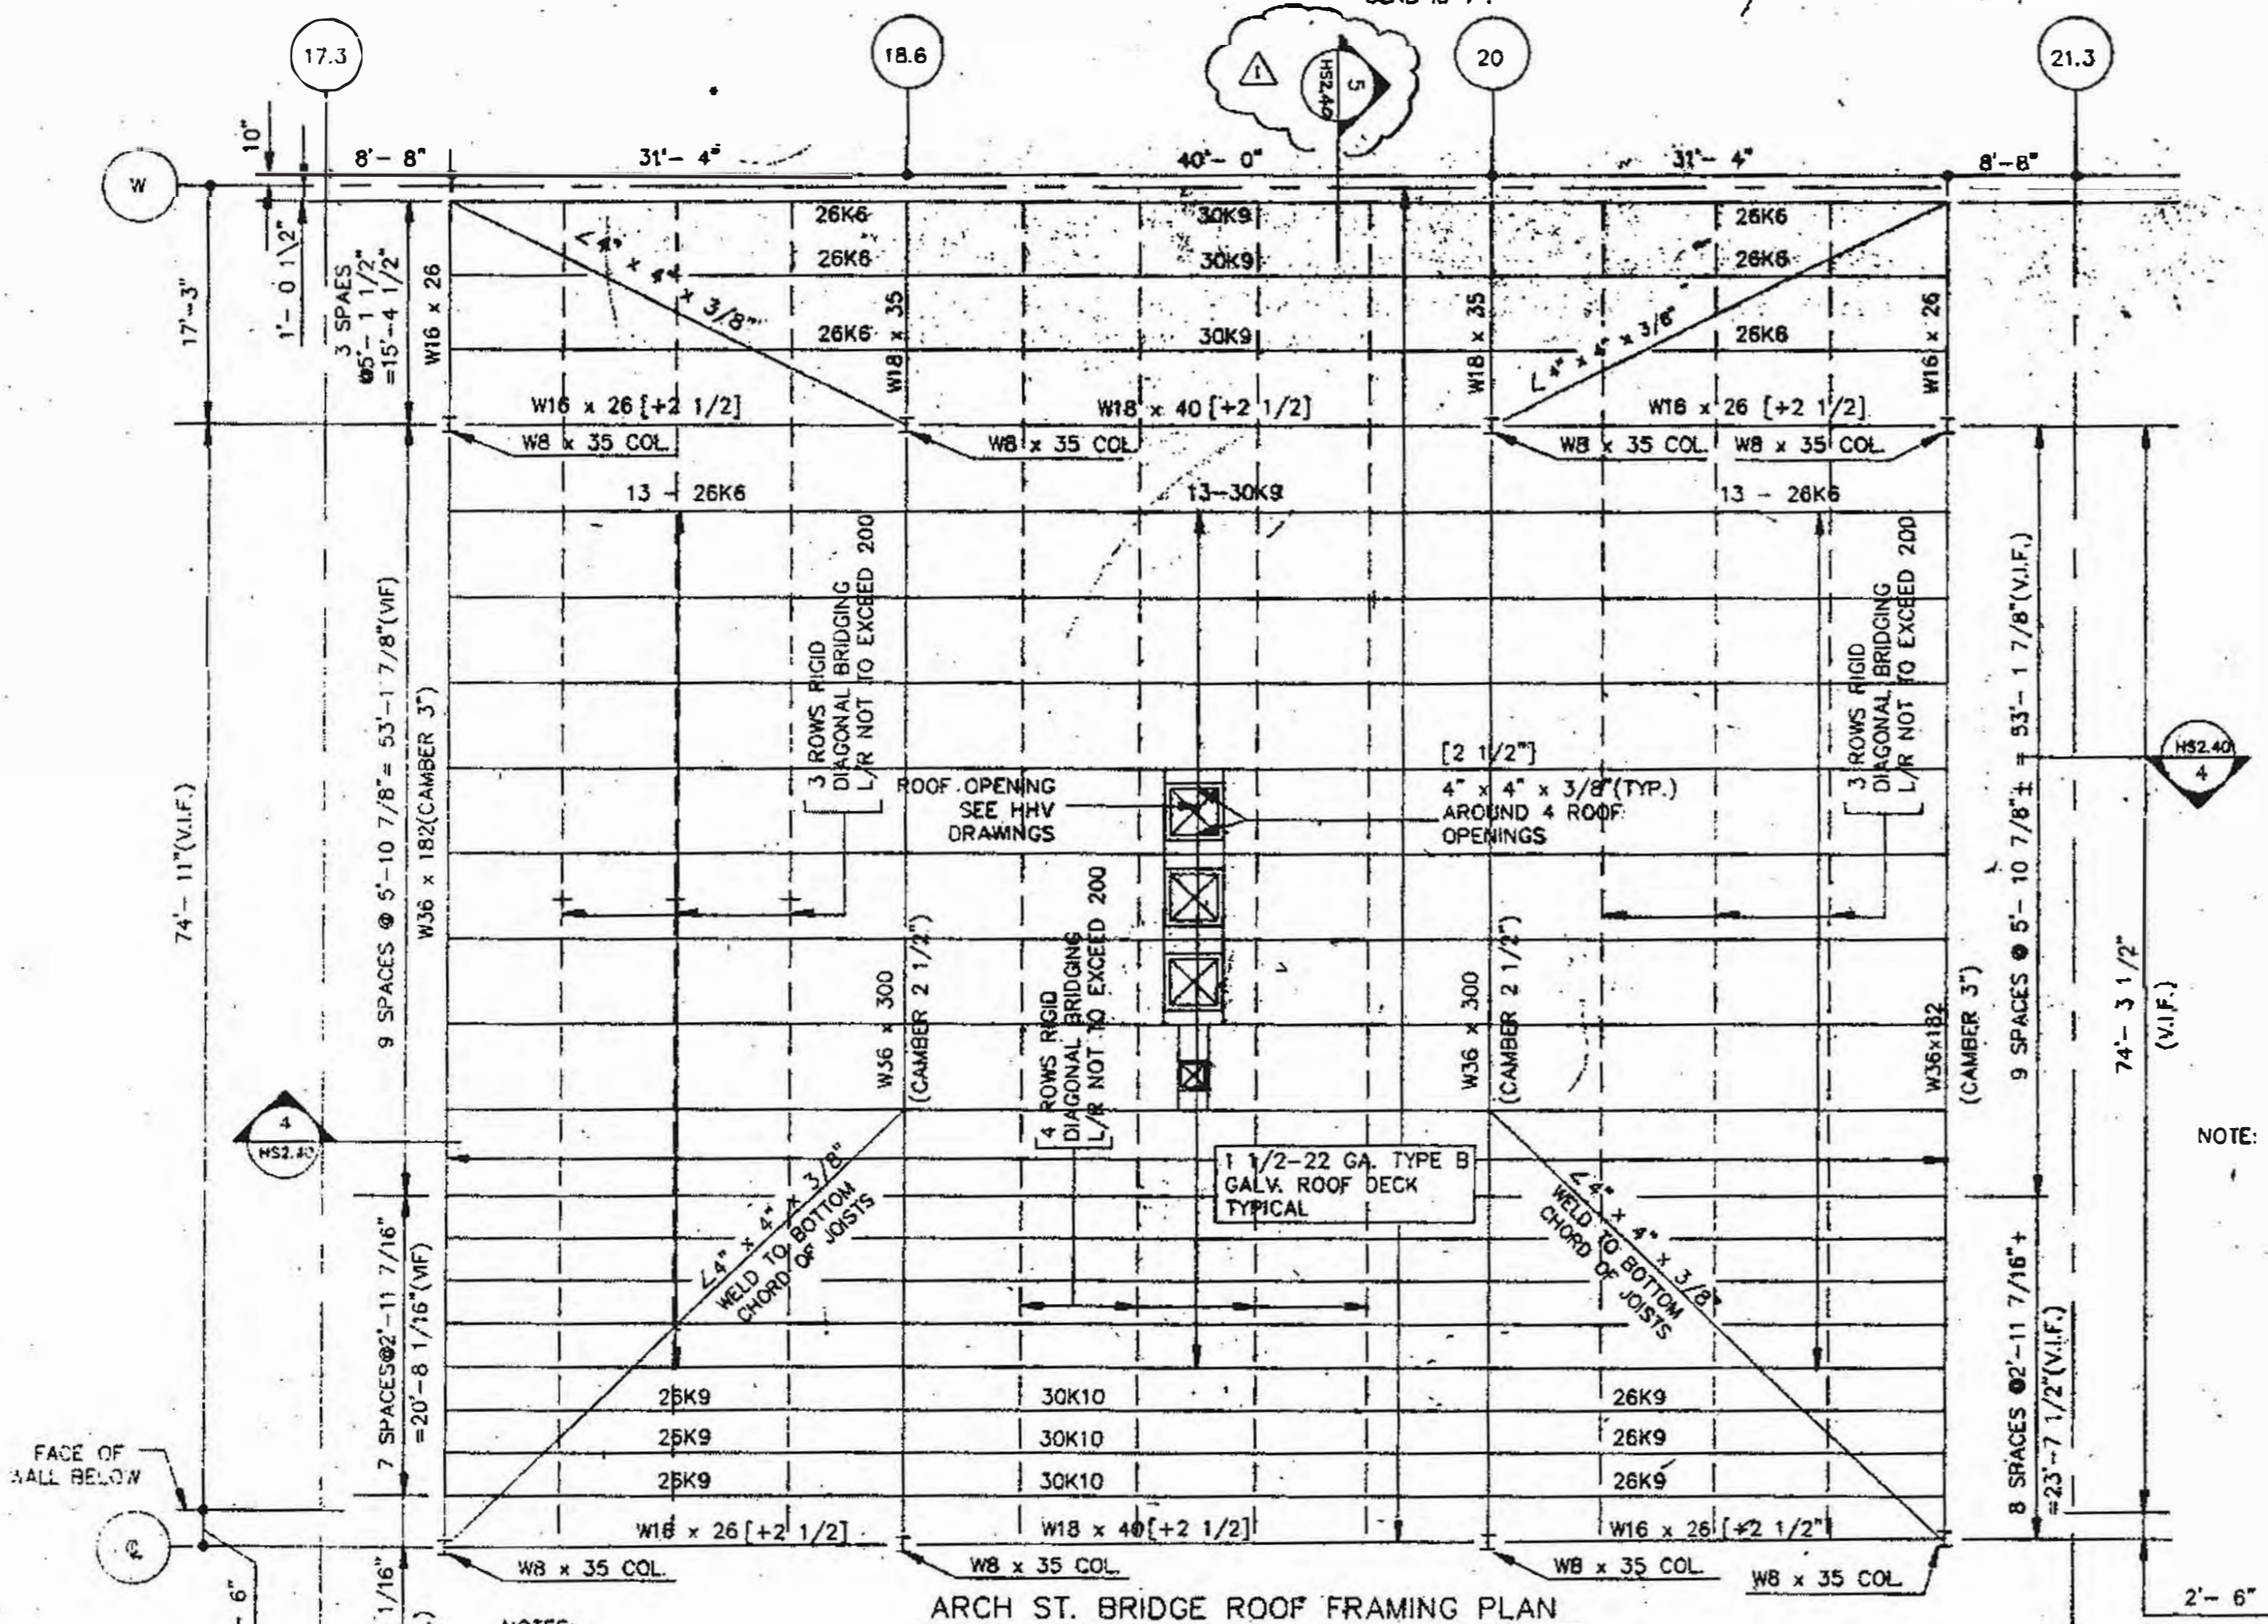

ARCH ST. BRIDGE ROOF FRAMING PLAN
SCALE: 1/8" = 1'-0"

NOTES:
 1. ALL WF BEAMS ARE A36
 2. TOP OF STEEL ELEV. 104.33 U.N.O.
 3. (+2 1/2) INDICATES DEVIATION IN INCHES FROM TYP. T.O.S. ELEV.

NOTE: SEE DRAWING HS4.17 FOR METAL ROOF DECK ATTACHMENT PATTERN.

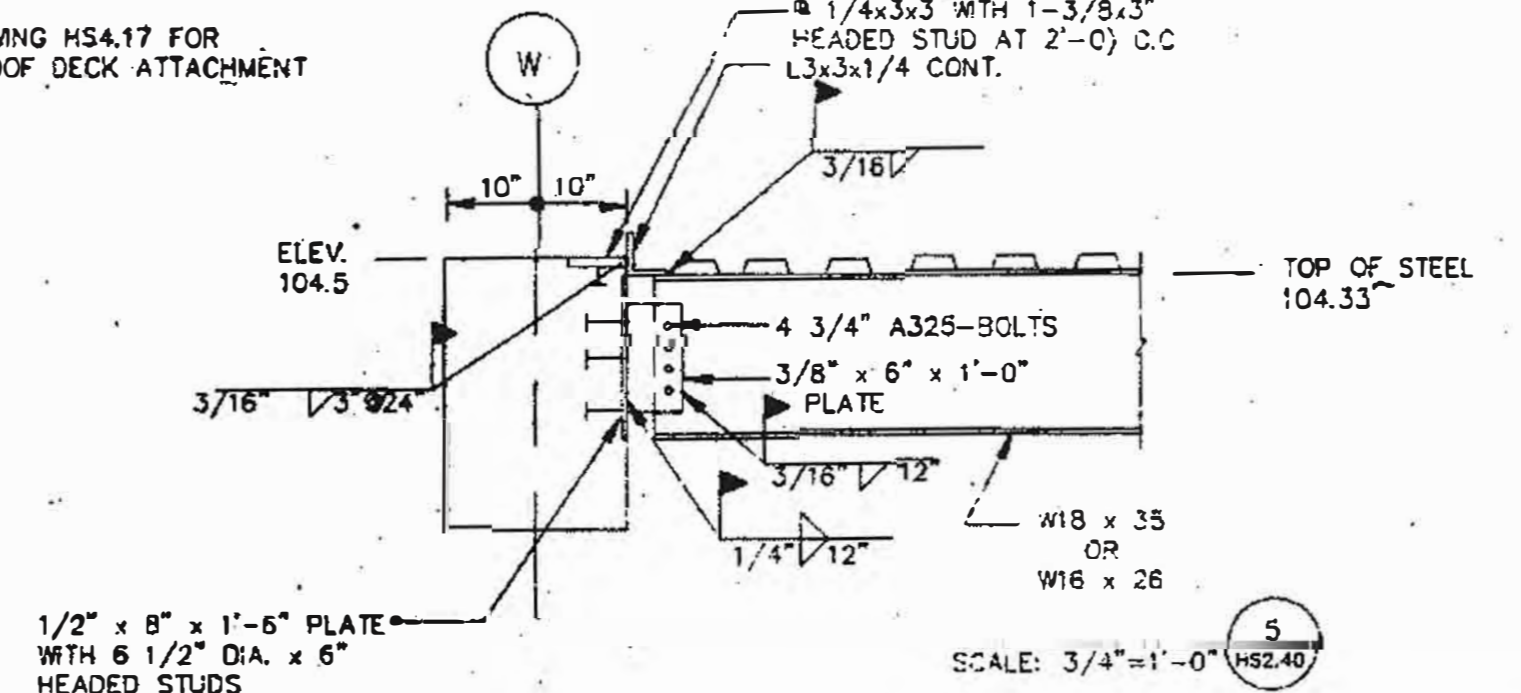

SCALE: 3/4" = 1'-0" H52.40

THOMPSON VENTULETT STANBACK & ASSOCIATES, INC. ARCHITECTS
 VITETTA GROUP ASSOCIATED ARCHITECTS
 KELLY/MAIELLO ARCHITECTS & PLANNERS, INC.
 LIVINGSTON/ROSENWINKEL, P.C. ARCHITECTS & PLANNERS CONSULTING ARCHITECTS
 BRYAN/CHILTON JOINT VENTURE

REVISIONS
 ADD #4 6 NOV 90


All dimensions shall be verified by contractor and architect method of any discrepancies before proceeding with construction.



DRAWING TITLE
 FRAMING PLAN ARCH ST BRIDGE LEVEL 89 & ROOF

PROJECT NO. DRAWING NO.
 TV5584/90
 DATE 7/16/90
 3150
 HS 240
 4 OCT 90

PENNSYLVANIA CONVENTION CENTER PHILADELPHIA, PENNSYLVANIA

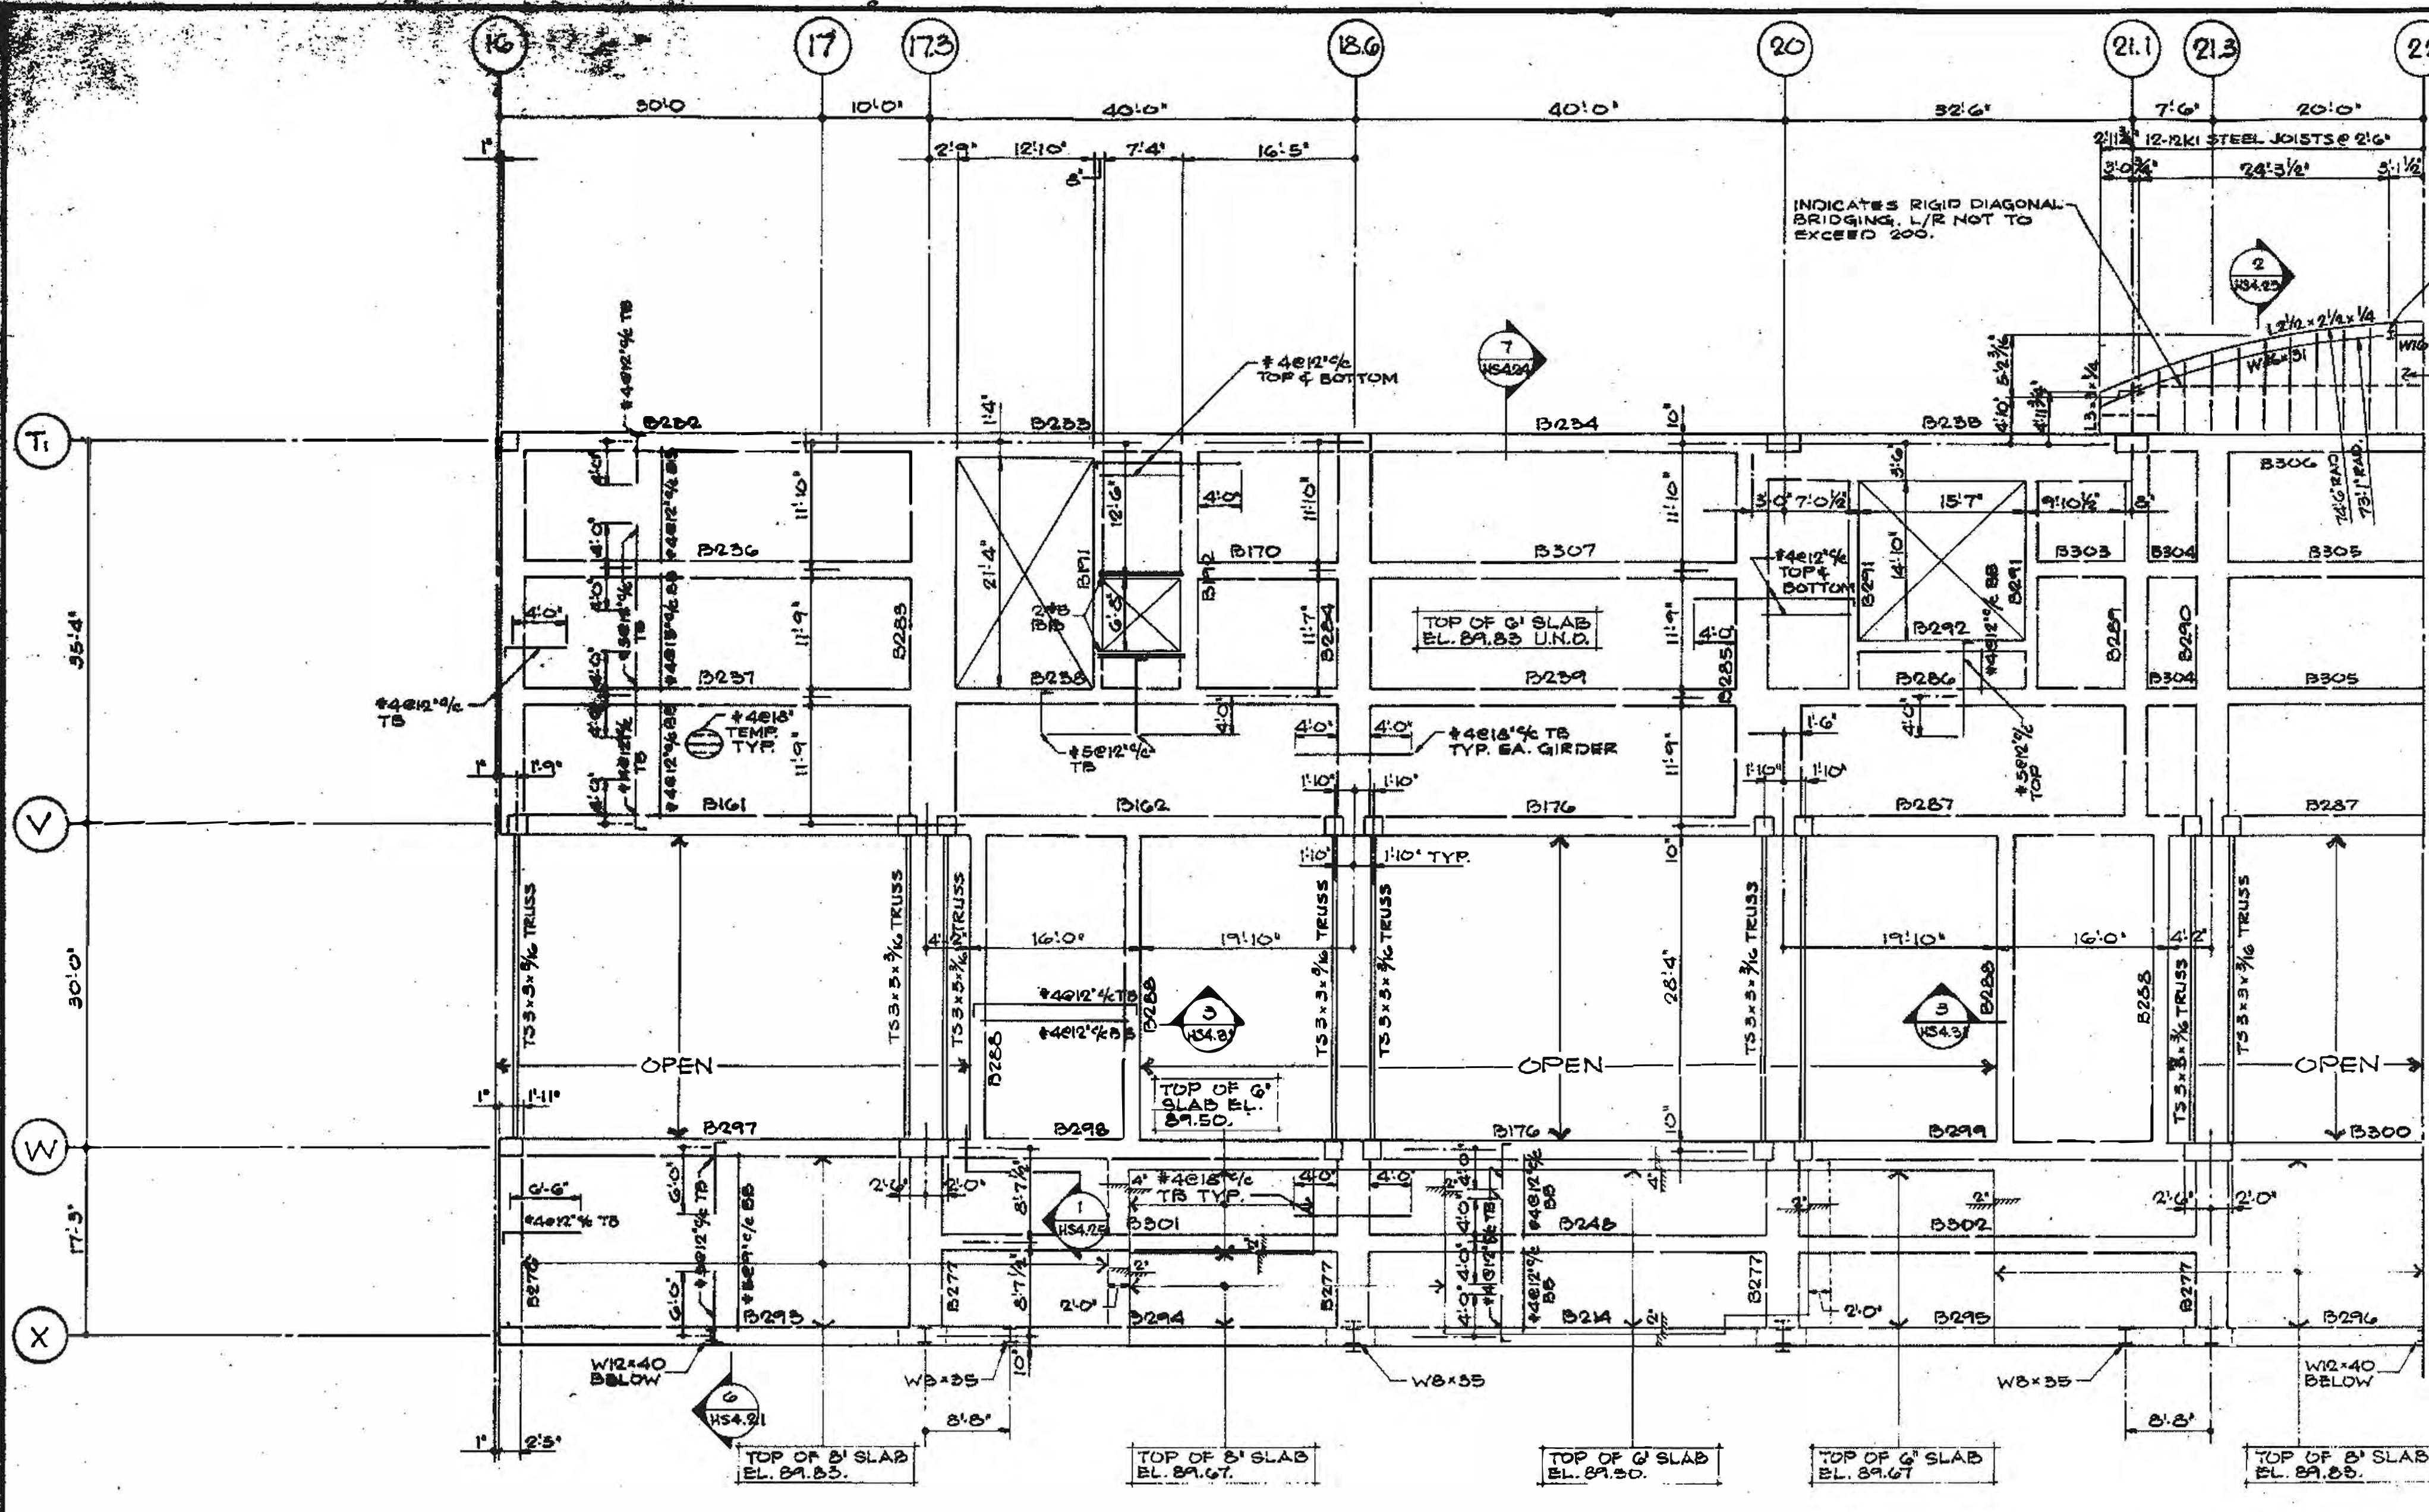


2 1/2" CONCRETE SLAB REINFORCE WITH WWF #4 @ 12" ON CENTER ON 1/4" METAL DECK 26GA GALV. TOP OF SLAB EL. 89.50

CONCRETE BEAM MARKS & SIZE ON THIS DRAWING

B161	18x30	B287	20x30
B162	18x30	B288	18x30
B170	18x30	B289	20x30
B176	20x30	B290	30x36
B191	20x30	B291	12x15
B192	18x30	B292	12x15
B214	20x30/30	B293	20x48
B232	20x30	B294	20x34/32
B233	20x42	B295	20x32/34
B234	20x30	B296	20x48
B235	20x30	B297	20x48
B236	18x30	B298	20x48
B237	18x30	B299	20x48
B238	16x30	B300	20x48
B239	18x30	B301	18x24/30/32
B248	18x32	B302	18x30/32/34
B253	51x30	B303	18x30
B254	30x30	B304	18x30
B255	72x30	B305	18x30
B256	18x30	B306	30x36
B276	29x30	B307	18x30
B277	30x32/30/34		

INDICATES SLAB DEPRESSION, COORDINATE WITH KITCHEN EQUIPMENT SUPPLIER.

CARRER ALL BEAMS AND SLABS 1/8" PER 10'-0" OF SPAN FOR ALL CONCRETE FRAMING FROM COLUMN LINE 1 TO X.

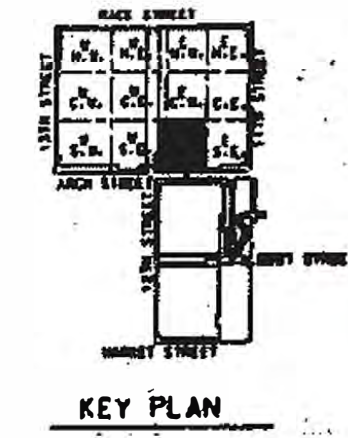

PENNSYLVANIA CONVENTION CENTER PHILADELPHIA, PENNSYLVANIA

THOMPSON VENTULETT STANBACK & ASSOCIATES, INC. ARCHITECTS

VITETTA GROUP ASSOCIATED ARCHITECTS

KELLY/MAIELLO ARCHITECTS & PLANNERS, INC. LIVINGSTON/ROSENWINKEL P.C. ARCHITECTS & PLANNERS CONSULTING ARCHITECTS

DATE


REVISIONS

All dimensions shall be verified by contractor and architect notified of any discrepancies before proceeding with construction.



DRAWING TITLE
FRAMING PLAN
BALLROOM
LEVEL 05
BLOCK 10-500

PROJECT NO. DRAWING NO.
TVS5A 2001.00
DATE
04 OCT 96

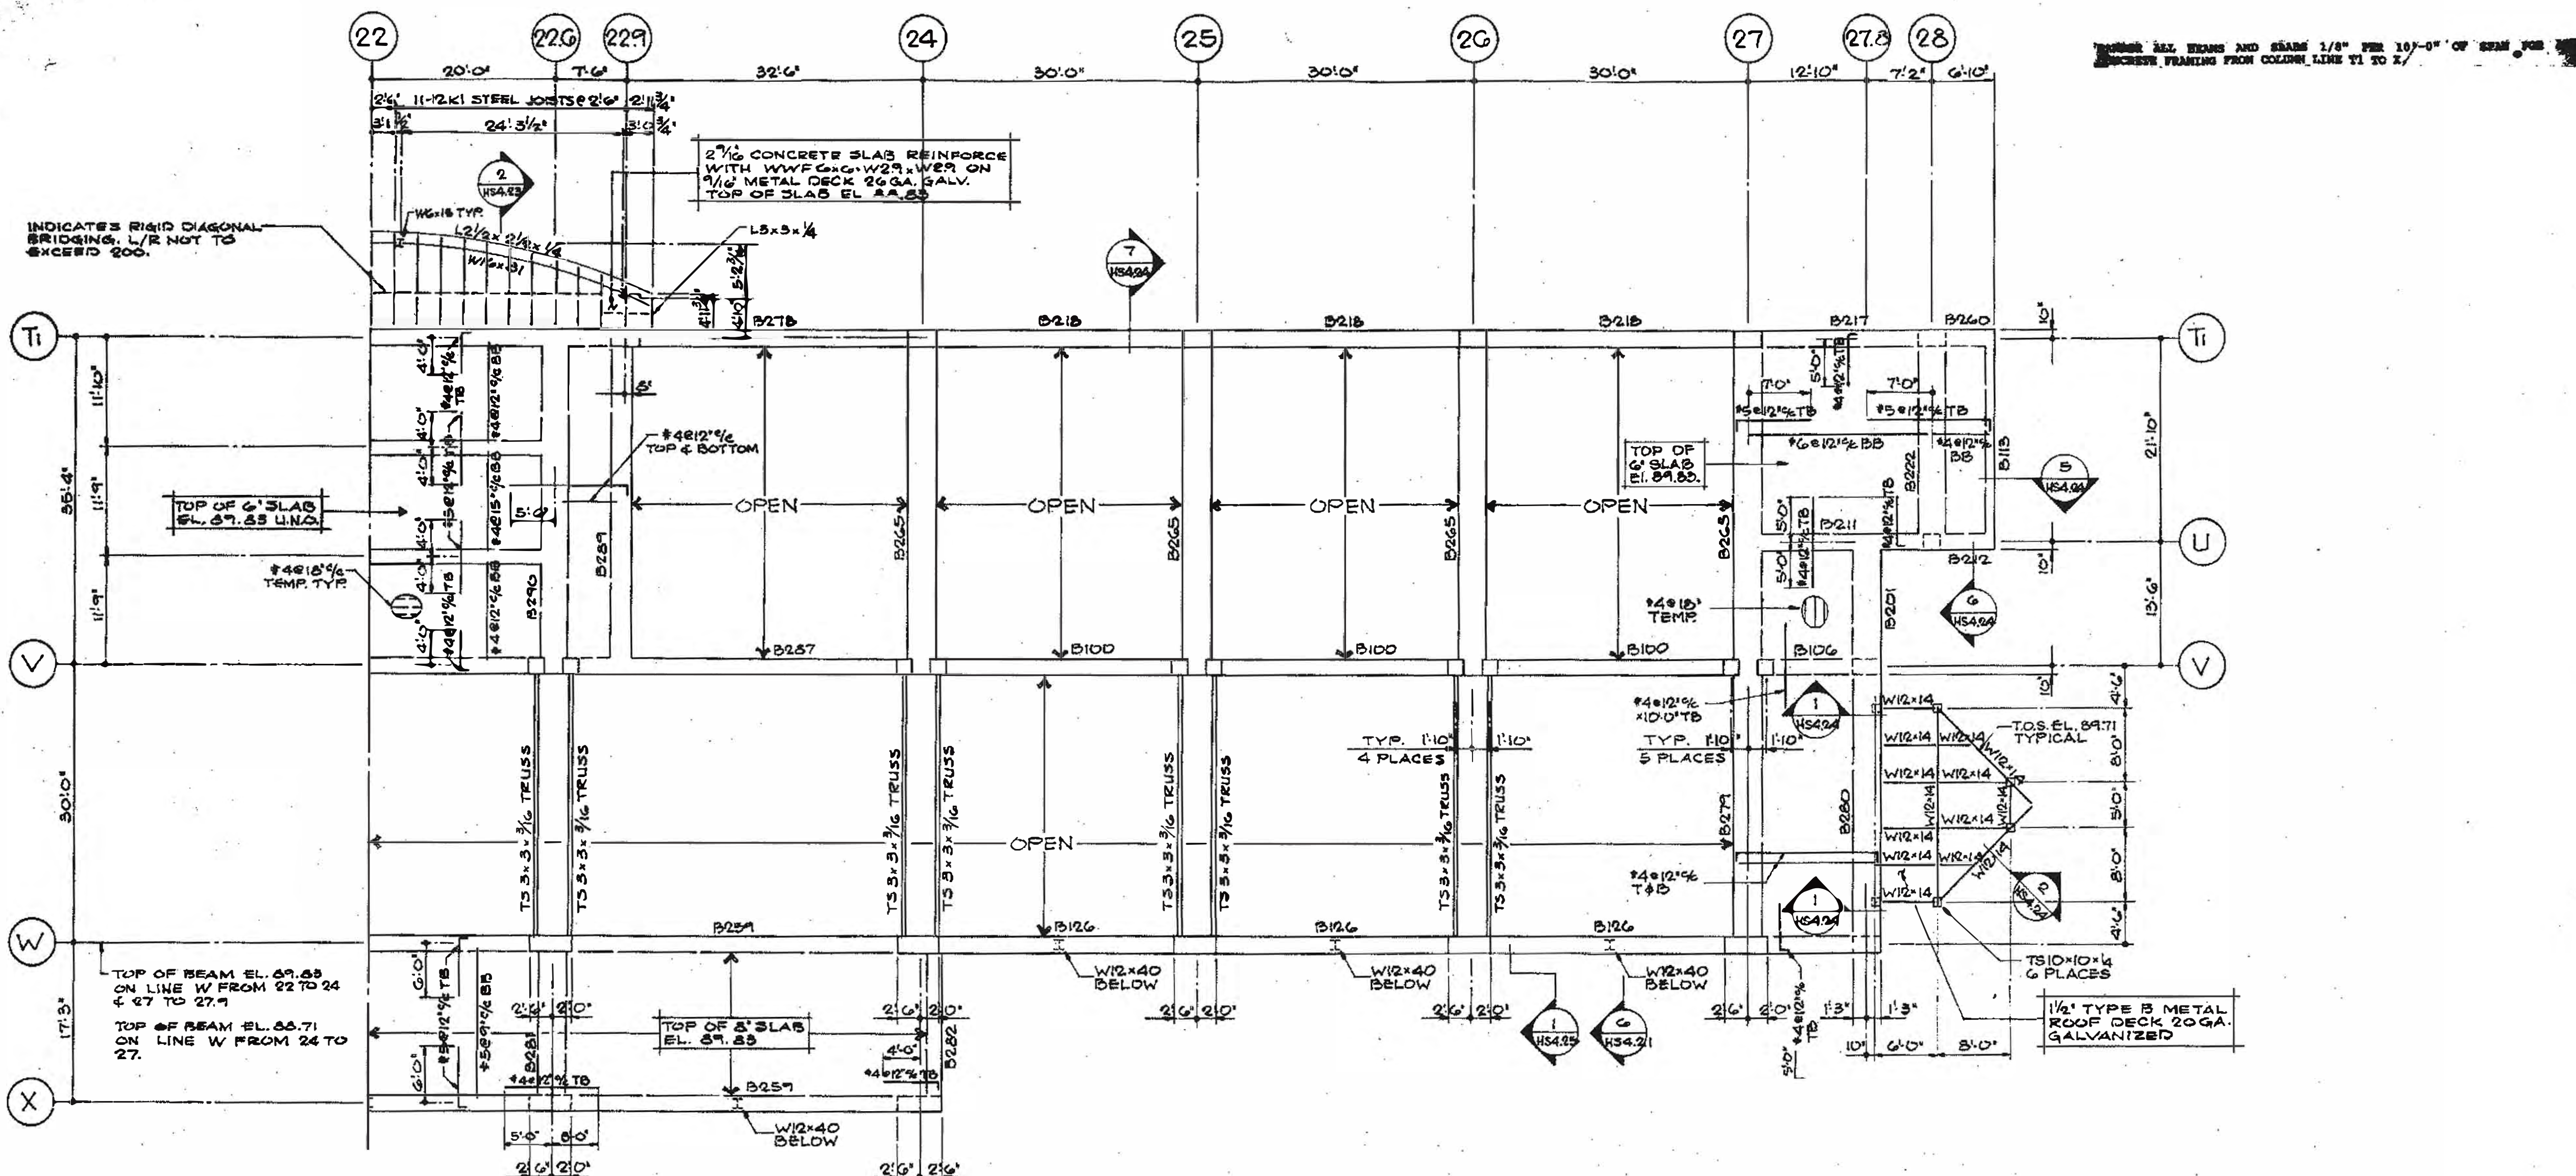

NUMBER ALL BEAMS AND BEAMS 1/4\"/>

INDICATES RIGID DIAGONAL BRIDGING. L/R NOT TO EXCEED 200.

2 3/4\"/>

TYP. NO. 4 PLACES

TYP. NO. 5 PLACES

T.O.S. EL. 89.71 TYPICAL

1 1/2\"/>

CONC. BEAM MARKS & SIZE ON THIS DRAWING

B100	20 x 30	B222	18 x 30
B109	20 x 30	B259	20 x 48
B113	12 x 30	B260	20 x 30
B126	20 x 30	B265	36 x 30
B201	30 x 30	B276	20 x 30
B211	20 x 30	B279	36 x 30
B212	18 x 30	B280	30 x 30
B217	20 x 30	B281	36 x 30
B218	20 x 30	B282	20 x 48
		B287	20 x 30
		B289	26 x 30
		B290	36 x 36


THOMPSON
VENTULETT
STANBACK
&
ASSOCIATES, INC.
ARCHITECTS

VITETTA
GROUP
ASSOCIATED ARCHITECTS

KELLY/
MAIELLO
ARCHITECTS &
PLANNERS, INC.
LIVINGSTON/
ROSENWINKEL
P.C.
ARCHITECTS &
CONSULTING ARCHITECTS

REVISIONS

All dimensions shall be verified by contractor and architect notified of any discrepancies before proceeding with construction.

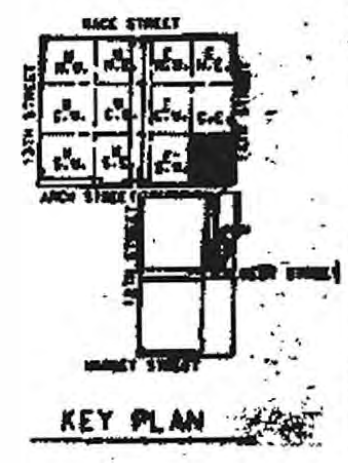

DRAWING TITLE
**FRAMING PLAN
BALLROOM
LEVEL 89
BLOCK # 22**

PROJECT NO. **TV56A**
DRAWING NO. **8901.00**
DATE **24 OCT 89**

PENNSYLVANIA CONVENTION CENTER PHILADELPHIA PENNSYLVANIA