# **ADDENDUM #1**

FOF

### BID - AV for Overlook Boardroom

5/9/2023

### **Clarifications:**

- 1) We revised the drawings to include some multi-mode cabling and connectors to each of the TFP connector plates. We also added two (qty 2) 5-inch, empty conduits with pull lines. Please see attachments for the changes.
- 2) Bids may be emailed to Lisa Dobbertin (<a href="ldobbertin@paconvention.com">ldobbertin@paconvention.com</a>) and Steve Shepper (<a href="sshepper@paconvention.com">sshepper@paconvention.com</a>) in lieu of dropping off hard copies. Please make sure you get an email in reply acknowledging receipt of your bid before 4PM of bid day from Lisa or Steve. Our system often sends emails with attachments to our spam folder. We will also have a Bid box set up at 12<sup>th</sup> and Arch entrance (East side, across from Reading Terminal Market) if you would like to drop off a hard copy. Bid results will be emailed out to all those that submitted bids after 4PM of bid day.
- 3) We had some questions regarding missing specifications. Please make sure when you download the project documents, you are downloading the full document. The page numbers for each document of the project are listed in the bid paperwork and on the project site. Make sure the page numbers match up to what is listed.

## **Questions:**

- 1) Is the intent to award all to one GC? Example, is it possible that we could be awarded the boardroom but then another contractor is awarded the restrooms or the CM part? Answer: The intent is not to award all to one GC. The CM contractor will be different than those awarded for the restroom work or boardroom work. It is possible for the GC for the restrooms and GC for the boardroom to be the same, if their bid numbers are the lowest for both bids, but that's not the intent.
- 2) In the Diversity Exhibits we need to state if we were able to reach a commitment? And if so there needs to be a letter of intent. I just wanted to clarify your definition of commitment. Because then we also are unsure of how to provide a letter of intent at just the bid stage when we are unaware if we were even awarded the project. Answer: The commitment and letter of intent should be based on IF you are awarded the project. In the letter of intent you should state, for example, "If awarded the Overlook Restroom Renovations at the PA Convention Center, we commit XX (specify exact amount) to your company."

### **Attachments:**

- 1) Updated AV Drawings: (7pages) Includes six (qty 6) updated AV drawings plus one (qty 1) new drawing (AV4.03)
- 2) Addendum to Spec Section 267610: (1 page) for Rough-In Requirements for AV

### SECTION 267610 AV ROUGH IN REQUIREMENTS AV BULLETIN 1

### 1.10. SCOPE OF WORK

Add the following:

N. Provide two 5" Empty conduit systems as shown on the AV Bulletin 1 drawings.

Provide nylon bushings at both ends of the conduit path.

Provide all conduit, hangers, supports and related appurtenances in compliance with current building electrical standards.

Provide nylon pull lines within each conduit.

END OF SECTION 26 76 10 AV BULLETIN 1





# Pennsylvania Convention Center OVERLOOK CONFERENCE ROOM AV SYSTEMS

			AL	JDIO VIDEO SYSTEMS
	05-08-2023AV Bulletin 1	0-10-2022 Bid Set		DRAWING INDEX May 08, 2023
	ő	<u> </u>	Sheet	Description
			AV-0.01	AV System Drawing List And Miscellaneous Legends
$\dashv$	•	•	AV-0.02	AV System Device Legends
	•	•	AV-1.01	AV System Device Locations In Plan
		•	AV-1.02	AV System Sample Furniture Plans
		•	AV-2.01	AV System Device Locations In Rcp
		•	AV-3.01	AV System Credenza Details
	•	•	AV-4.01	AV System Plate & Panel Details Part 1
	•	•	AV-4.02	AV System Plate & Panel Details Part 2
	•		AV-4.03	AV System Plate & Panel Details Part 2
		•	AV-5.01	AV System Audio Single Line Diagram Part 1
			AV-5.02	AV System Audio Single Line Diagram Part 2
		•	AV-5.03	AV System Audio Single Line Diagram Part 3
		•	AV-5.04	AV System Audio Single Line Diagram Part 4
		•	AV-6.01	AV System Video Single Line Diagram
		•	AV-7.01	AV System Network & Control Single Line Diagram Part 1
		•	AV-7.02	AV System Network & Control Single Line Diagram Part 2
		•	AV-8.01	AV Systems AC Power Single Line Diagram
	•		AV-9.01	AV Systems Rack Elevation Diagram

AV Sýstèm Côver Sheet

AV-0.01 Scale: Not to Scale

AV-0.01

	WIRE & CABLE LEGEND									
	SYMBOL	DESCRIPTION	MANUFACTURER & MODEL#							
	A1	Audio Cable Single Shielded Pair #22 AWG, Plenum Rated	West Penn 25291							
	CAT6	Category 6 Cable, Plenum Rated	West Penn 254246							
	CC	Camera Control Cable, Plenum Rated	West Penn 25359B							
	DTP	XTP/DTP 24 Shielded Twisted Pair Cable, Plenum Rated	Extron XTP DTP 24P/1000							
	FO6	6 Strand TeraSPEED® Distribution Cable, Plenum Rated	Commscope P-006-DZ-8W-FSUYL							
	FO12	12 Strand TeraSPEED® Distribution Cable, Plenum Rated	Commscope P-012-DZ-8W-FSUYL							
	HD3	3' Select High Speed HDMI Cable, In-Wall Rated	C2G 50625							
	IC2	(1) Shielded Pair #20 AWG, (1) Unshielded Pair #20 AWG, Plenum Rated	West Penn 25359B							
	OM3	12 Strand OM3 armored Fibre Optic cable, Plenum	Belden FISD012A9							
<b>~~</b>	~~~\$14~~~	Speaker Cable Twisted Pair #14 awg, Plenum Rated	West Penr 25226B							
	S16	Speaker Cable Twisted Pair #16 awg, Plenum Rated	West Penn 25225B							
	SDI	RG6 Digital Video Cable, Plenum Rated	West Penn 256350							
	USB6	6.6' USB 3.0 A/B Cable	C2G 54174							
	MM06	6 Strand Multimode OM3 Armored Fiber Optic Cable	Belden, Commscope or equivalent							

B Cable Legend
AV-0.01 Scale: Not to Scale

	CONNECTOR LEGEND						
SYMBOL	DESCRIPTION						
BNC	BNC Connector						
CS#	Captive Screw Termination (# denotes quantity of terminations)						
F	F Connector						
DVI-D	DVI Digital Connector, Male						
DVI-I	DVI Interface Connector, Male						
DB9M	9 Pin DB Connector, Male						
DB9F	9 Pin DB Connector, Female						
HDMI	HDMI Connector, Male						
HD15	15 Pin HD Connector, Male						
PD	Punch Down Termination						
SLDR	Solder Termination						
LC	LC Type Fiber Optic Termination						
sc	SC Type Fiber Optic Termination						
ST	ST Type Fiber Optic Termination						
XLRF	XLR Connector, Female						
XLRM	XLR Connector, Male						
NL4	Speakon Connector, Male						
RJ45	RJ45 Connector, Male						

C Connector Legend
AV-0.01 Scale: Not to Scale

	1	08/18/2022	Review/Comment	TWK
	2	10/10/2022	Released for Bid	TWK
	3	05/08/2023	AV Bulletin 1	TWK
_				

Designed By:	KMK
Drawn By:	TK
Reviewed By:	TK
Date Drawn:	08/18/2022
Scale:	As Noted



Project Location:
12th & Arch Philadelphia, PA

Project:

OVERLOOK CONFERENCE ROOM

Drawing Title:

**AV System Cover Sheet** 

Drawing Number:

AV-0.01

			Audio \ Devi	Video System ice Legend					
DEVICE ID	DEVICE NAME REF  AV Equipment Rack	Manufacturer: Middle Atlantic Model: WRK-44-27 (qty 2) Back-Box Type: Back-Box Height: Back-Box Dims: Device Weight: Approx 650 LBs	Description: AV Equipment Rack Location: IDF 100F Heat-Load: approx. 16000 BTU Note 1: Note 2: Note 3:	SCOPE NOTES  EC = Electrical Contractor		Type Plenum	Size Plenum	ONDUIT & CABLE FILL REQUIREME  Cable Fill Details  Qty (2) CAT6  Die Six Strand Single Mode Fiber	Destination  Fire Alarm Panel  Mute Ckt Contact by EC  Main Hall MDF (Behind Hall F)
CAM	Camera	Manufacturer: Crestron 1 Beyond Model: IV-CAM PTZ Back-Box Type: Recessed Back-Box Height: At Ceiling Back-Box Dims: Device Weight: Approx 12llbs	Description: PTZ Camera w/Tracking Location: As Shown In Plan Heat-Load: none Note 1: Provide Ceiling Mount Kit Note 2: Note 3:	Conduit & Back-Box By: EC Device Furnished By: AVC Device Installed By: AVC Cable Furnished By: AVC Cable Installed By: AVC Electrical Power By: none	1	Plenum Cable F	Plenum Cab	le Qty(2) CAT6	AVR-1
CRE1	Credenza Type 1	Manufacturer: By Millwork Contractor Model: Back-Box Type: See associated TFP Device Back-Box Height: See associated TFP Device Back-Box Dims: See associated TFP Device Device Weight: Approx 150lbs	Description: Millwork Credenza Location: As Shown In Plan Heat-Load: none Note 1: Note 2: Note 3:	Conduit & Back-Box By: See associated TFP Device Device Furnished By: See associated TFP Device Device Installed By: See associated TFP Device Cable Furnished By: See associated TFP Device Cable Installed By: See associated TFP Device Electrical Power By: See associated TFP Device					
CRE2	Credenza Type 2	Manufacturer: By Millwork Contractor Model: Back-Box Type: See associated TFP Device Back-Box Height: See associated TFP Device Back-Box Dims: See associated TFP Device Device Weight: Approx 150lbs Manufacturer: ATS PRO	Description: Millwork Credenza Location: As Shown In Plan Heat-Load: none Note 1: Note 2: Note 3: Description: 98" 4K LED Display	Conduit & Back-Box By: See associated TFP Device Device Furnished By: See associated TFP Device Device Installed By: See associated TFP Device Cable Furnished By: See associated TFP Device Cable Installed By: See associated TFP Device Electrical Power By: See associated TFP Device Conduit & Back-Box By:					
DIS98	98" Display	Model: Taylorleds WS Series 1.2mm Back-Box Type: No Back Box Back-Box Height: See Elevation Detail Back-Box Dims: 2 Gang Device Weight: TBD	Location: As shown in plan Heat-Load: Note 1: Custom Mounting Frame & Roll-About Cart Note 2: Refer to TFP plates for cable infrasrtructure Note 3:	Device Furnished By: Device Installed By: Cable Furnished By: Cable Installed By: Electrical Power By:					
PT8	Poke Thru 8"	Manufacturer: Legrand Model: eVOLUTION sERIES 8" Back-Box Type: Recessed Back-Box Height: Floor Back-Box Dims: 8" Diameter Device Weight: Approx 8 lbs	Description: 8" Poke Thru Location: As Shown In Plan Heat-Load: none Note 1: Qty (2) Duplex with Dual USB Charging Port Note 2: Qty (1) # Gang AV Plate Note 3:	Conduit & Back-Box By: EC Device Furnished By: EC Device Installed By: EC Cable Furnished By: AVC Cable Installed By: AVC Electrical Power By: EC		EMT Stub to Ceiling B EMT Stub to Ceiling B		Qty (4) A1 Qty (4) CAT6	AVR-1 AVR-1
TFP-1	A Tech Facility Plate -1	Manufacturer: RCI Model: KMK-597-AV-4.01-B Back-Box Type: See Note 1 at Right Back-Box Height: Refer to Sheet AV4.00 Back-Box Dims: 12" high x 18" wide x 6" Device Weight: Approx 10 lbs	Description: Tech Facility Plate i/o Location: As shown in plan Heat-Load: Note 1: Surface Box Mounted within CS-3x2 Credenza Note 2: Box CANNOT be installed until credenza is available. Note 3:	Conduit & Back-Box By: EC Device Furnished By: AVC Device Installed By: AVC Cable Furnished By: AVC Cable Installed By: AVC Electrical Power By: EC	2	EMT EMT EMT	1-1/4" 1-1/4" 1-1/4"	Qty(12) A1 Qty(12) CAT6 Qty (1) FO6, Qty (1) MM6	AVR1 AVR1 AVR1
TFP-2	B AV4.01 Tech Facility Plate -2	Manufacturer: RCI Model: KMK-597-AV-4.01-B Back-Box Type: See Note 1 at Right Back-Box Height: Refer to Sheet AV4.00 Back-Box Dims: 12" high x 18" wide x 6" Device Weight: Approx 10 lbs	Description: Tech Facility Plate i/o Location: As shown in plan Heat-Load: Note 1: Surface Box Mounted within CS-3x2 Credenza Note 2: Box CANNOT be installed until credenza is available. Note 3:	Conduit & Back-Box By: EC Device Furnished By: AVC Device Installed By: AVC Cable Furnished By: AVC Cable Installed By: AVC Electrical Power By: EC	2	EMT EMT EMT	1-1/4" 1-1/4" 1-1/4"	Qty(12) A1 Qty (12) CAJ6 Qty (1) FO6, Qty (1) MM6	AVR1 AVR1 AVR1
TFP-3	C AV4.01 Tech Facility Plate -3	Manufacturer: RCI Model: KMK-597-AV-4.01-C Back-Box Type: See Note 1 at Right Back-Box Height: Refer to Sheet AV4.00 Back-Box Dims: 12" high x 18" wide x 6" Device Weight: Approx 10 lbs	Description: Tech Facility Plate i/o Location: As shown in plan Heat-Load: Note 1: Surface Box Mounted within CS-3x2 Credenza Note 2: Box CANNOT be installed until credenza is available. Note 3:	Conduit & Back-Box By: Device Furnished By: AVC Device Installed By: AVC Cable Furnished By: AVC Cable Installed By: AVC Electrical Power By: EC		EMT EMT EMT	1-1/4" 1-1/4" 1-1/4"	Qty(12) A1 Qty(12) CAT6 Qty (1) FO6, Qty (1) MM6	AVR1 AVR1 AVR1
TFP-4	D AV4.01 Tech Facility Plate -4	Manufacturer: RCI Model: KMK-597-AV-4.01-D Back-Box Type: See Note 1 at Right Back-Box Height: Refer to Sheet AV4.00 Back-Box Dims: 12" high x 18" wide x 6" Device Weight: Approx 10 lbs	Description: Tech Facility Plate i/o Location: As shown in plan Heat-Load: Note 1: Surface Box Mounted within CS-3x2 Credenza Note 2: Box CANNOT be installed until credenza is available. Note 3:	Conduit & Back-Box By: EC Device Furnished By: AVC Device Installed By: AVC Cable Furnished By: AVC Cable Installed By: AVC Electrical Power By: EC	2	EMT EMT EMT	1-1/4" 1-1/4" 1-1/4"	Qty(12) A1 Qty(12) CAT6 Qty (1) FO6, Qty (1) MM6	AVR1 AVR1 AVR1
TFP-5	E AV4.01 Tech Facility Plate -5	Manufacturer: RCI Model: KMK-597-AV-4.01-E Back-Box Type: See Note 1 at Right Back-Box Height: Refer to Sheet AV4.00 Back-Box Dims: 12" high x 18" wide x 6" Device Weight: Approx 10 lbs	Description: Tech Facility Plate i/o Location: As shown in plan Heat-Load: Note 1: Surface Box Mounted within CS-3x2 Credenza Note 2: Box CANNOT be installed until credenza is available.	Conduit & Back-Box By: EC Device Furnished By: AVC Device Installed By: AVC Cable Furnished By: AVC Cable Installed By: AVC Electrical Power By: EC		EMT EMT EMT	1-1/4" 1-1/4" 1-1/4"	Qty(12) A1 Qty(12) CAT6 Qty (1) FO6, Qty (1) MM6	AVR1 AVR1 AVR1
TFP-6	F AV4.01 Tech Facility Plate -6	Manufacturer: RCI Model: KMK-597-AV-4.01-F Back-Box Type: See Note 1 at Right Back-Box Height: Refer to Sheet AV4.00 Back-Box Dims: 12" high x 18" wide x 6" Device Weight: Approx 10 lbs	Note 3:  Description: Tech Facility Plate i/o Location: As shown in plan Heat-Load: Note 1: Surface Box Mounted within CS-3x2 Credenza Note 2: Box CANNOT be installed until credenza is available. Note 3:	Conduit & Back-Box By: EC  Device Furnished By: AVC  Device Installed By: AVC  Cable Furnished By: AVC  Cable Installed By: AVC  Electrical Power By: EC	1 2 3	EMT EMT EMT	1-1/4" 1-1/4" 1-1/4"	Qty(12) A1 Qty(12) CA76 Qty (1) FO6, Qty (1) MM6	AVR1 AVR1 AVR1
TP-11	Touch Panel 11"	Manufacturer: QSC  Model: TSC-116w-G2  Back-Box Type: Flush  Back-Box Height: Switch Height  Back-Box Dims: 2 Gang	Description: 11" Touch Panel Wall Mounted Location: As shown in plan Heat-Load: Note 1: Note 2:	Conduit & Back-Box By: <i>EC</i> Device Furnished By: <i>AVC</i> Device Installed By: <i>AVC</i> Cable Furnished By: <i>AVC</i> Cable Installed By: <i>AVC</i>	1	EMT Stub to Ceiling	1"	Qty(1) CAT6	AVR1
E5C	Empty 5" Conduit	Device Weight: Approx 8 lbs  Manufacturer: Building Standard  Model: 5" Conduit with Nylon Bushing  Back-Box Type: No Back Box  Back-Box Height: Within Credenza  Back-Box Dims: 5" Diameter  Device Weight:	Note 3:  Description: 5" Empty Conuit w/Pull Line Location: As shown in plan Heat-Load: Note 1: Note 2: Note 3:	Electrical Power By: None  Conduit & Back-Box By: EC Device Furnished By: EC Device Installed By: EC Cable Furnished By: Cable Installed By: Electrical Power By:	1	EMT	5"	Nylon Pull String	AVR1

Kr	ИK
	TECHNOLOGY INFRASTRUCTURE Design Since 1971
KMK Technologies LLC www.KMKINC.com An NV:	Glassboro, New Jersey Telephone: 215-990-3187 5 Company

Rev#:	Date:	Description:	Ву:
1	08/18/2022	Review/Comment	TWK
2	10/10/2022	Released for Bid	TWK
3	05/08/2023	AV Bulletin 1	TWK

Designed By:	KMK
Drawn By:	ТК
Reviewed By:	TK
Date Drawn:	08/18/2022
Scale:	As Noted



Project Location: 12th & Arch Philadelphia, PA

Project:

OVERLOOK CONFERENCE ROOM

Drawing Title:

AV System Device Legend


Drawing Number:


AV-0.02


				Audio V Devid	deo System ce Legend					
DEVI	CE DEVICE	DEVICE NAME	DEVICE	DETAILS & SPECIFICATIONS	SCOPE NOTES  EC = Electrical Contractor CDI = Churchill Downs International			,	DUIT & CABLE FILL REQUIREME	
l ID	REF				EC = Electrical Contractor CDI = Churchill Downs International AVC = Audio Video Contractor LVC = Low Voltage Contractor	Raceway #	Туре	Size	Cable Fill Details	Destination
			Manufacturer: <i>JBL</i>	Description: Two Way Coaxial 12" Ceiling Speaker	Conduit & Back-Box By: EC	1	Planum Cable	C	ty(1) S14 per speaker, refer to single line diagrams for home rur	information AVR1
			Model: Control 322C	Location: As shown in plan	Device Furnished By: AVC					
S12		Speaker Type 12	Back-Box Type: Recessed	Heat-Load:	Device Installed By: AVC					
			Back-Box Height: Ceiling	Note 1: Zone speakers as shown in plan	Cable Furnished By: AVC					
			Back-Box Dims: 23.1" X 18.2"	Note 2: JBL MTC-300BB12 Back Box, JBL MTC 300SG12 Grille	Cable Installed By: AVC					
			Device Weight: 22 lbs	Note 3:	Electrical Power By: EC					
			Manufacturer: JBL	Description: Subwoofer	Conduit & Back-Box By: EC	1	Planum Cable	C	ty(1) S14 per speaker, refer to single line diagrams for home rur	n information AVR1
		Subwoofer Type 1	Model: 2206H	Location: As shown in plan	Conduit & Back-Box By: <i>EC</i> Device Furnished By: <i>AVC</i>					
SUB	1 (		Back-Box Type: Recessed	Heat-Load:	Device Installed By: AVC					
			Back-Box Height: Ceiling	Note 1: Zone Sub Woofers as shown in plan	Cable Furnished By: AVC					
			Back-Box Dims: 23.1" X 18.2"	Note 2: JBL MTC-300BB12 Back Box, JBL MTC 300SG12 Grille	Cable Installed By: AVC					
			Device Weight: 15 lb	Note 3:	Electrical Power By: EC					
			Manufacturer: Shure	Description: Digital Steering Array Microphone	Conduit & Back-Box Bv: FC	1	Planum Cable	(	Qty(1) CAT6	AVR1
			Model: <i>MXA920</i>	Location: As shown in plan	Conduit & Back-Box By: <i>EC</i> Device Furnished By: <i>AVC</i>				- · ·	
MIC		Array Microphone	Back-Box Type: Recessed	Heat-Load:	Device Installed By: AVC					
			Back-Box Height: Ceiling	Note 1:	Cable Furnished By: AVC					
			Back-Box Dims:	Note 2:	Cable Installed By: AVC					
	<del>-</del>		Device Weight: TBD	Note 3:	Electrical Power By: EC					

AV Systems
Device Legends Florr Plan

AV-0.02 Scale: Not to Scale

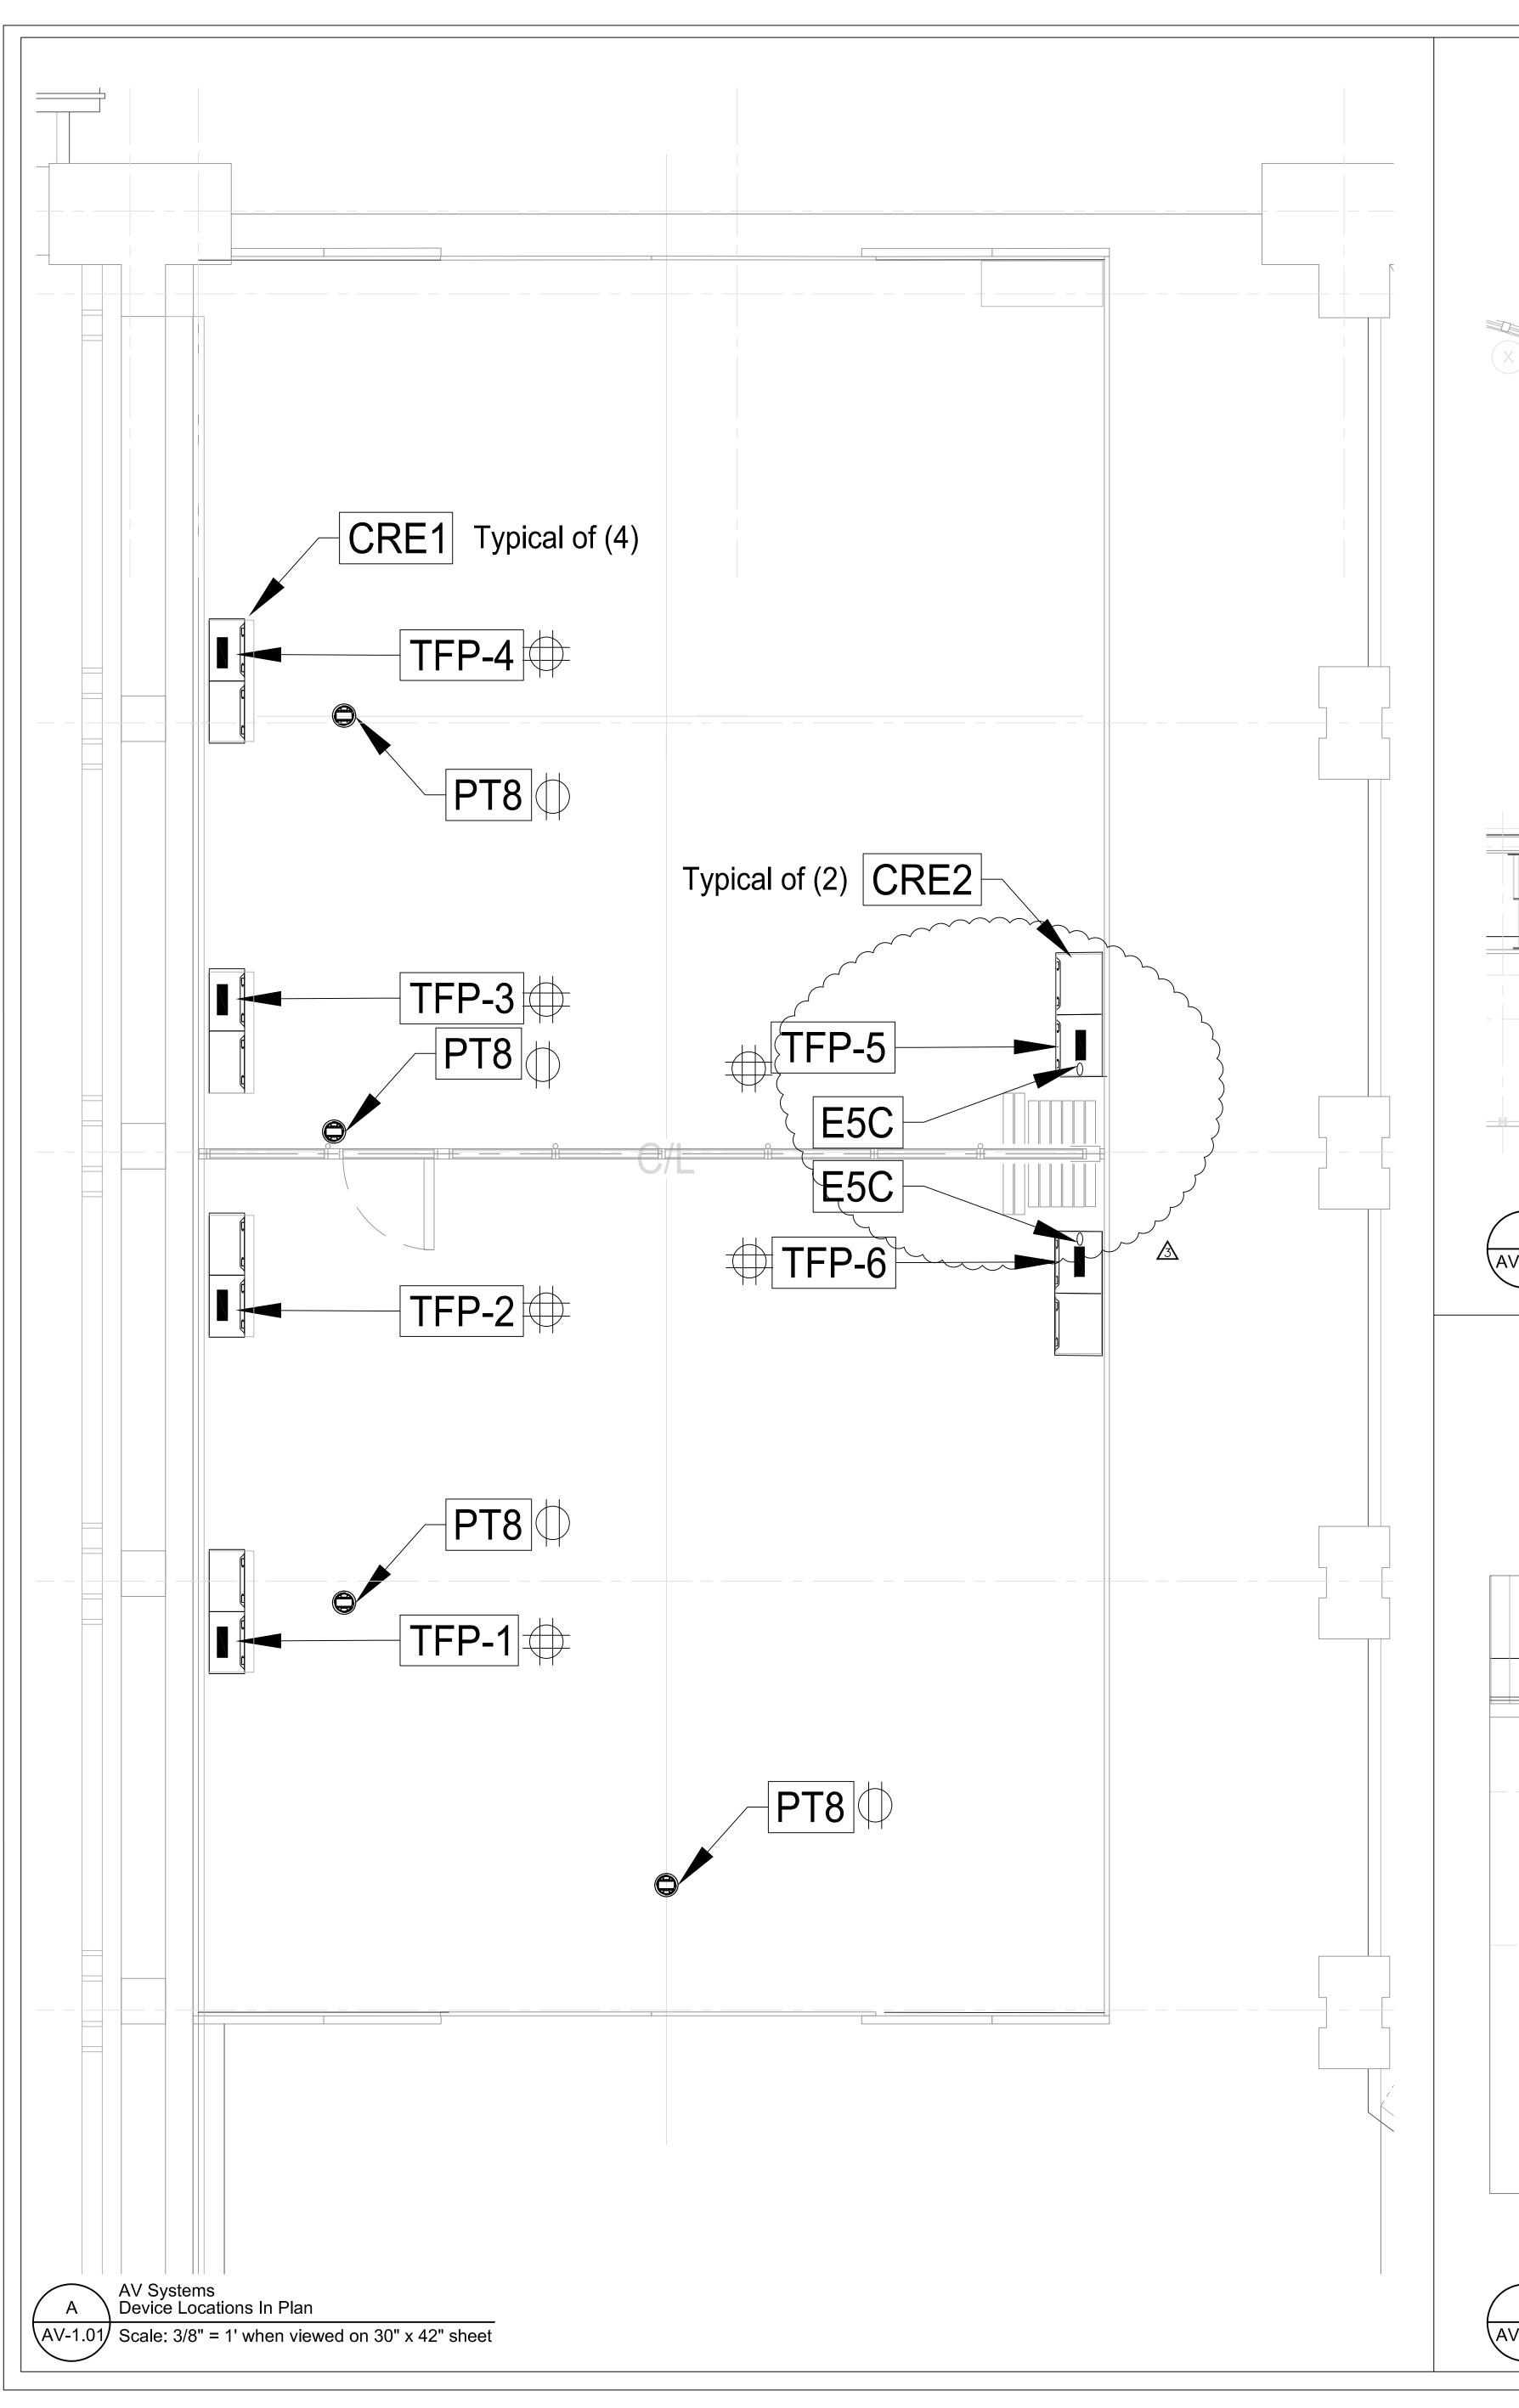


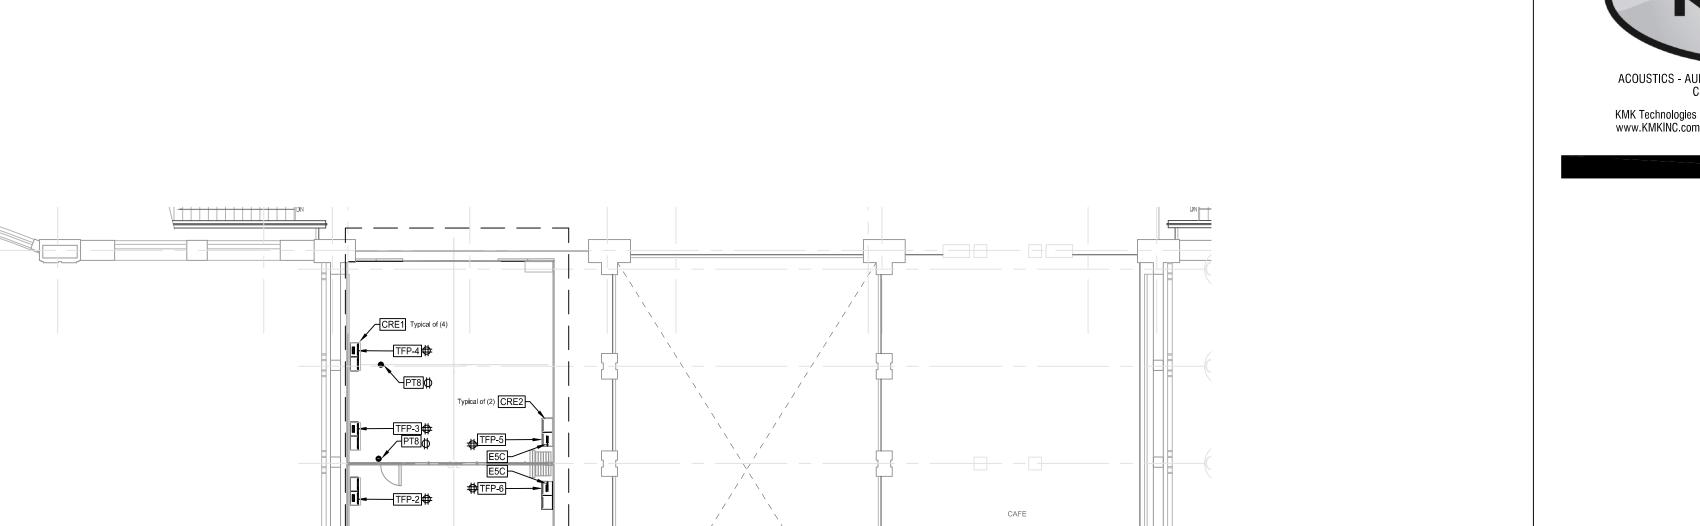

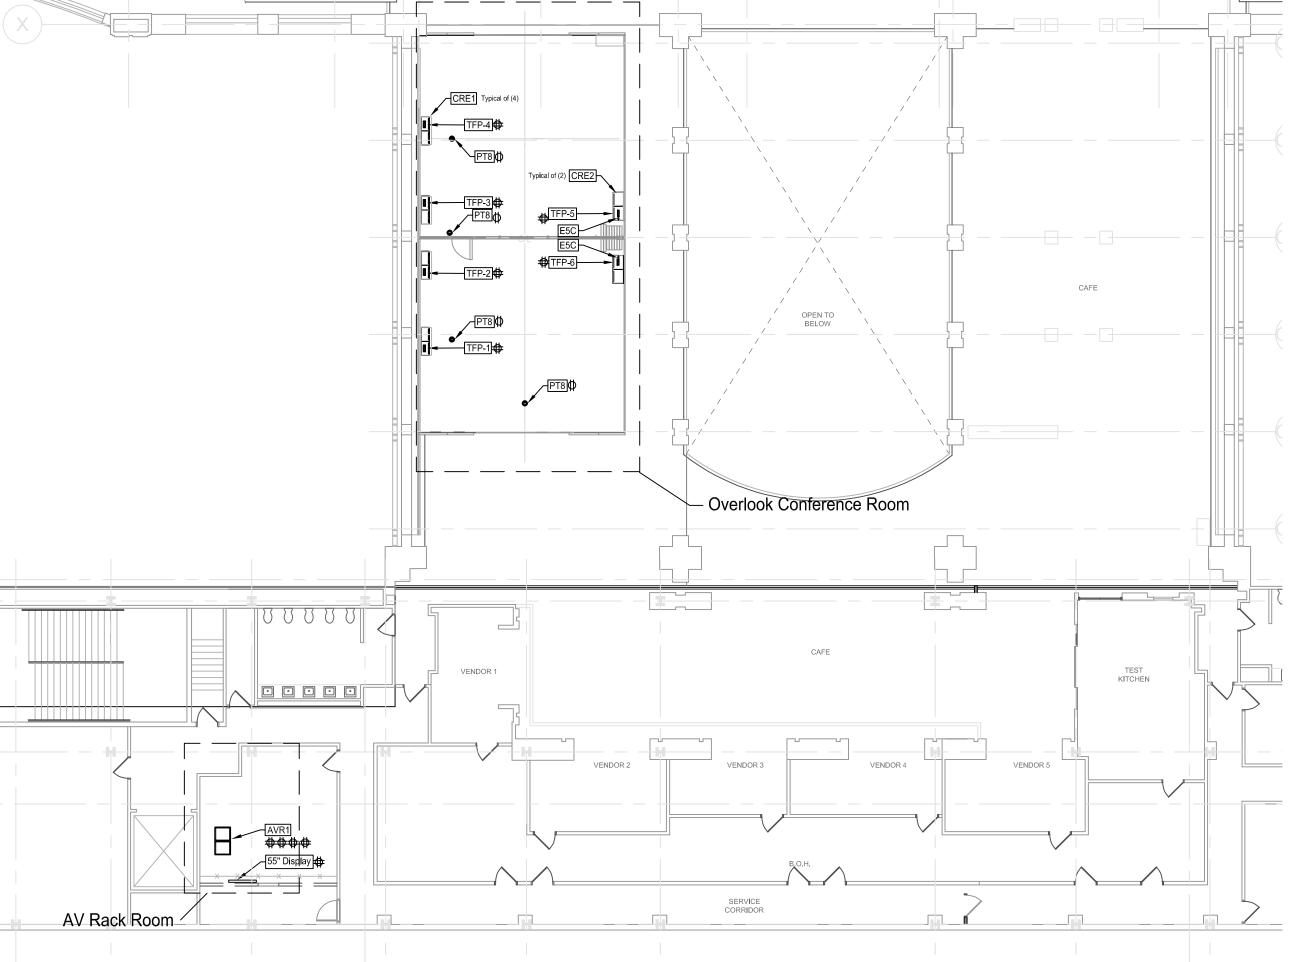

Overall Plan

AV-1.01 Scale: Not To Scale

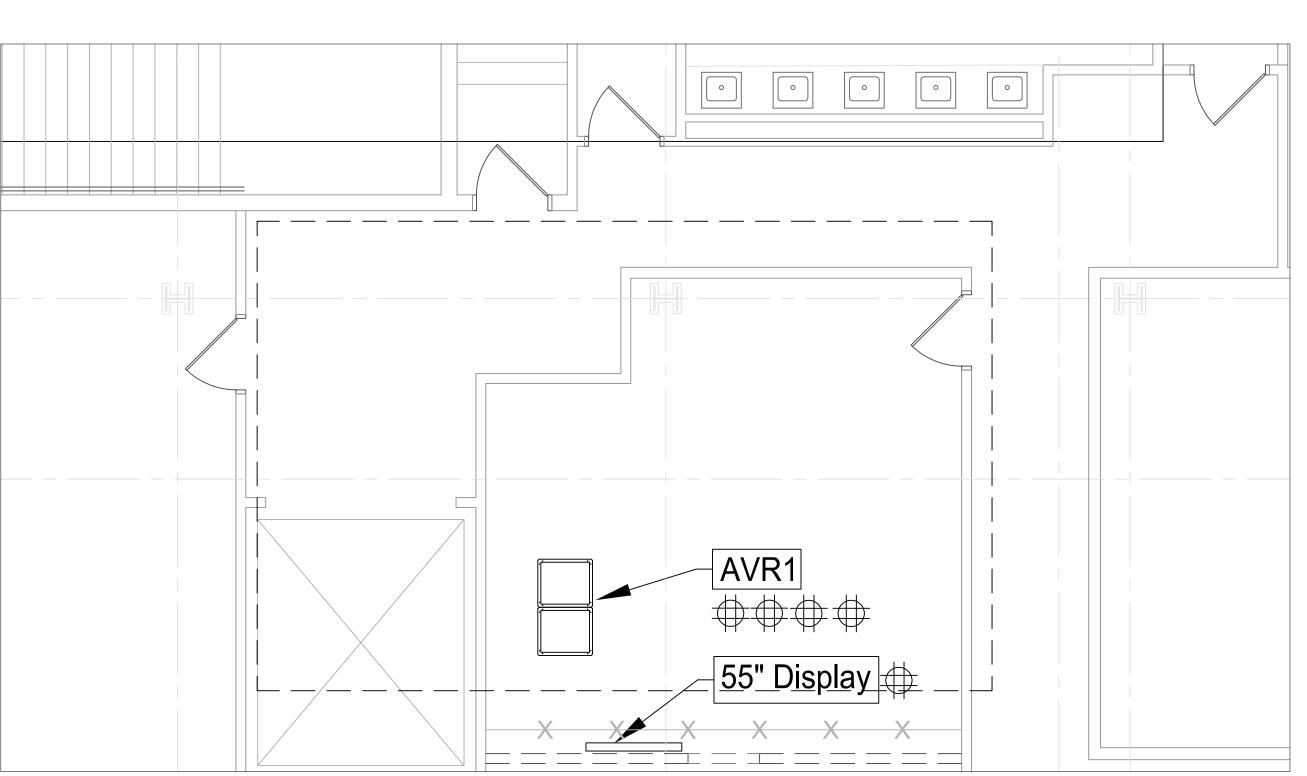

Conference Mode - Open Office Plan
Locations in Plan Drawings

AV-1.01 Scale: 1/4" = 1' when viewed on 30" x 42" sheet



Rev#:	Date:	Description:	Ву:
1	08/18/2022	Review/Comment	TWK
2	10/10/2022	Released for Bid	TWK
3	05/08/2023	AV Bulletin 1	TWK

Pennsylvania
Convention Center
PHILADELPHIA

Designed By: KMK

Reviewed By: TK

Date Drawn: 08/18/2022

Drawn By:

Scale:

Project Location:
12th & Arch Philadelphia, PA

Project:


OVERLOOK CONFERENCE ROOM


Drawing Title:


AV System Device Locations In Plan


Drawing Number:

AV-1.01

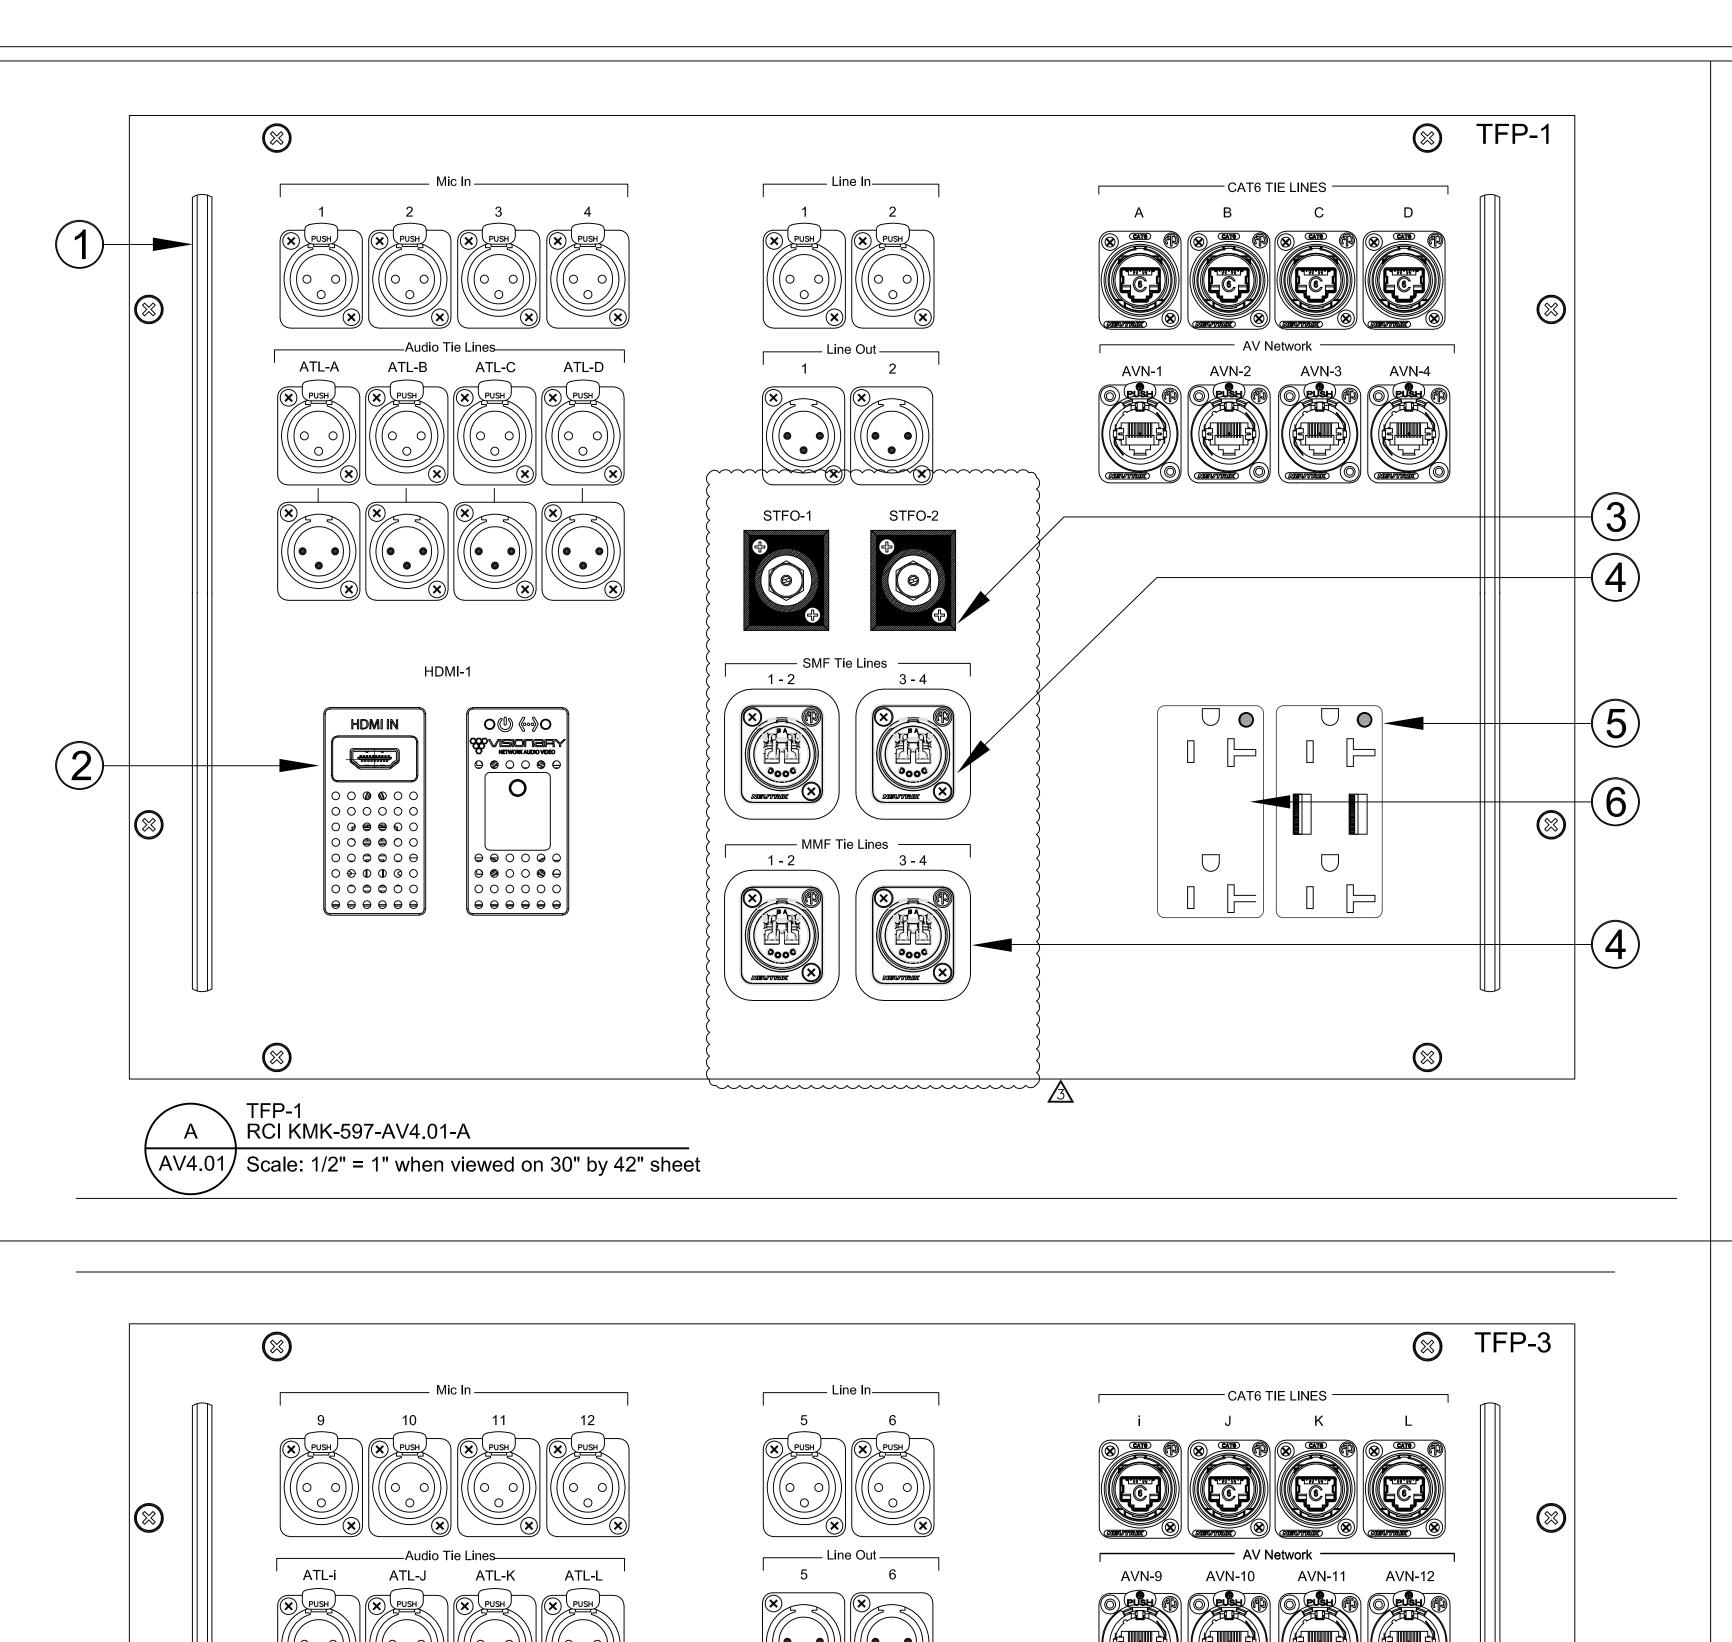

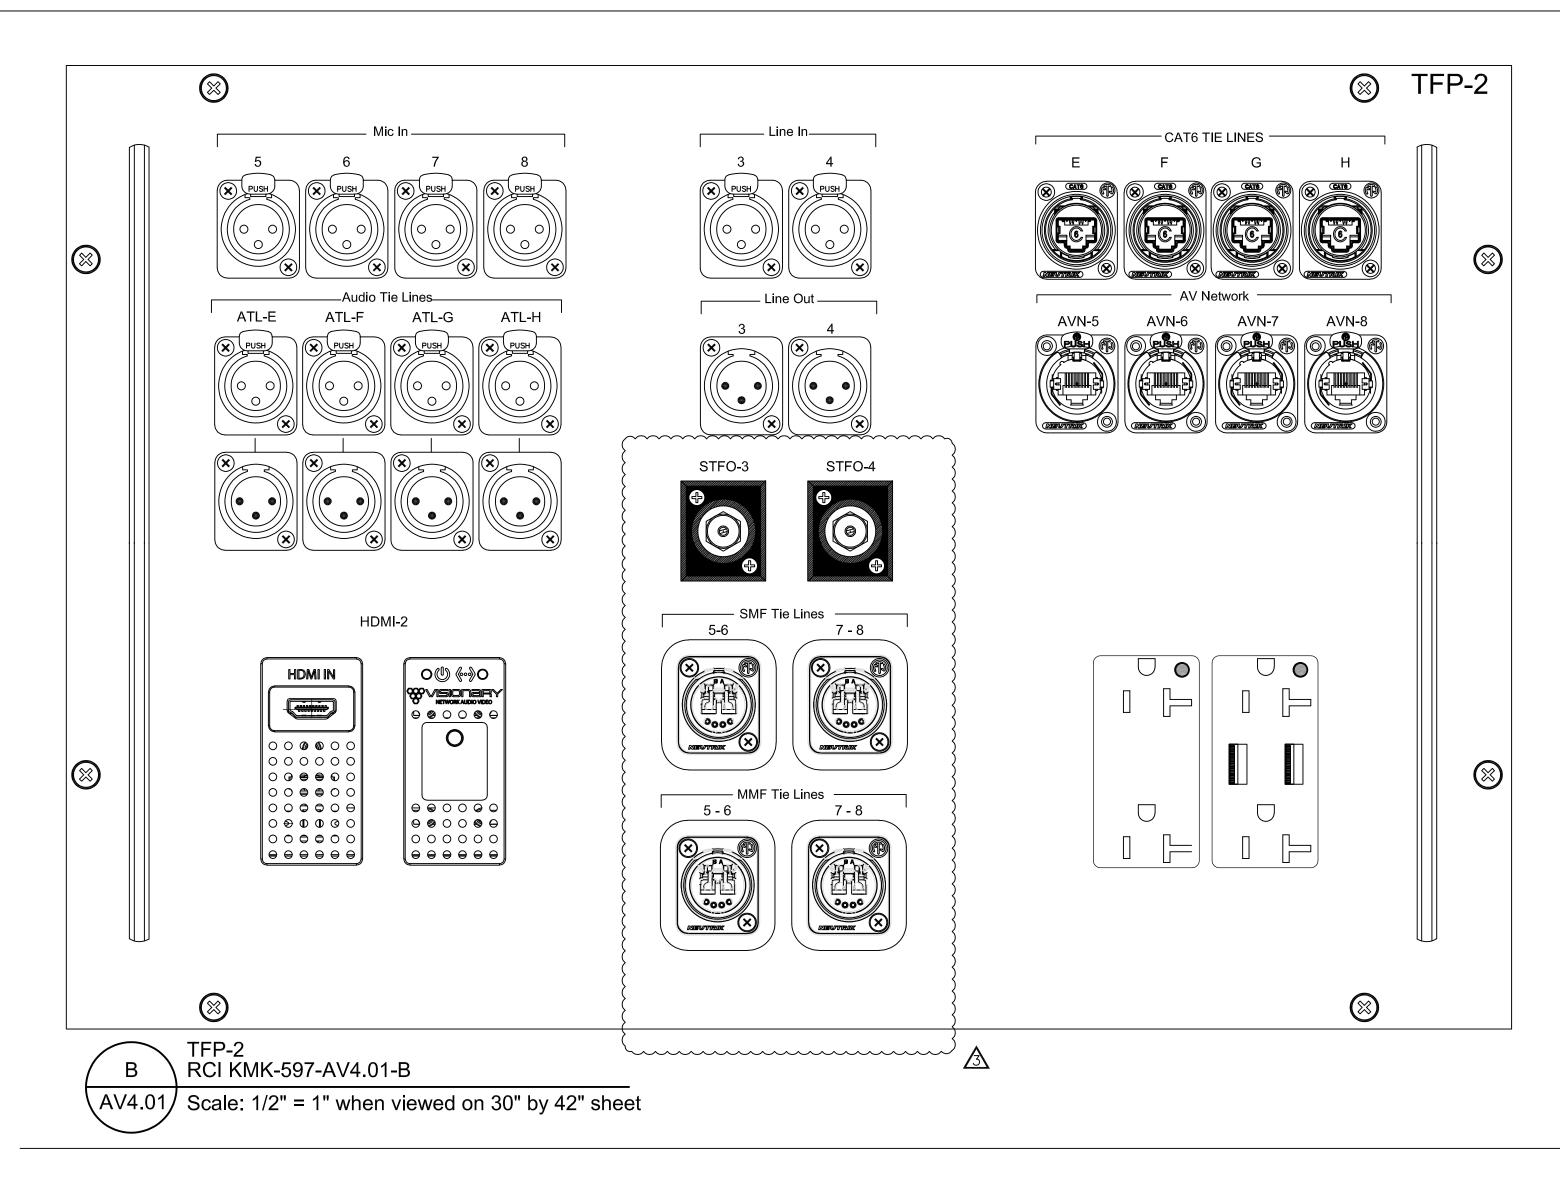

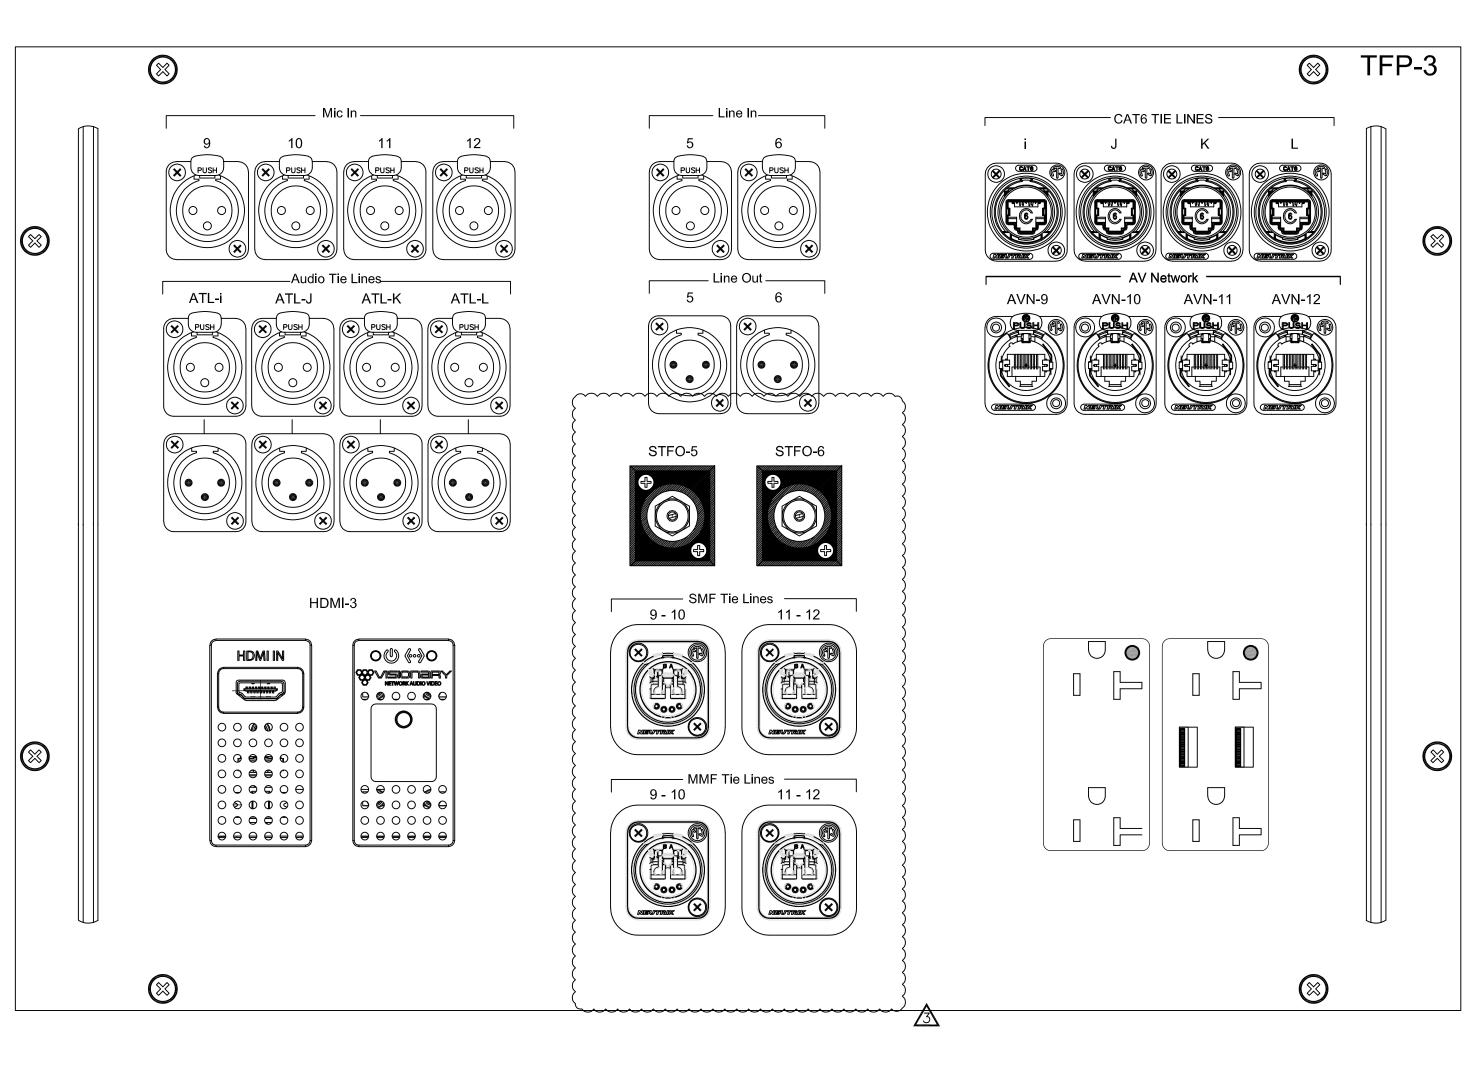

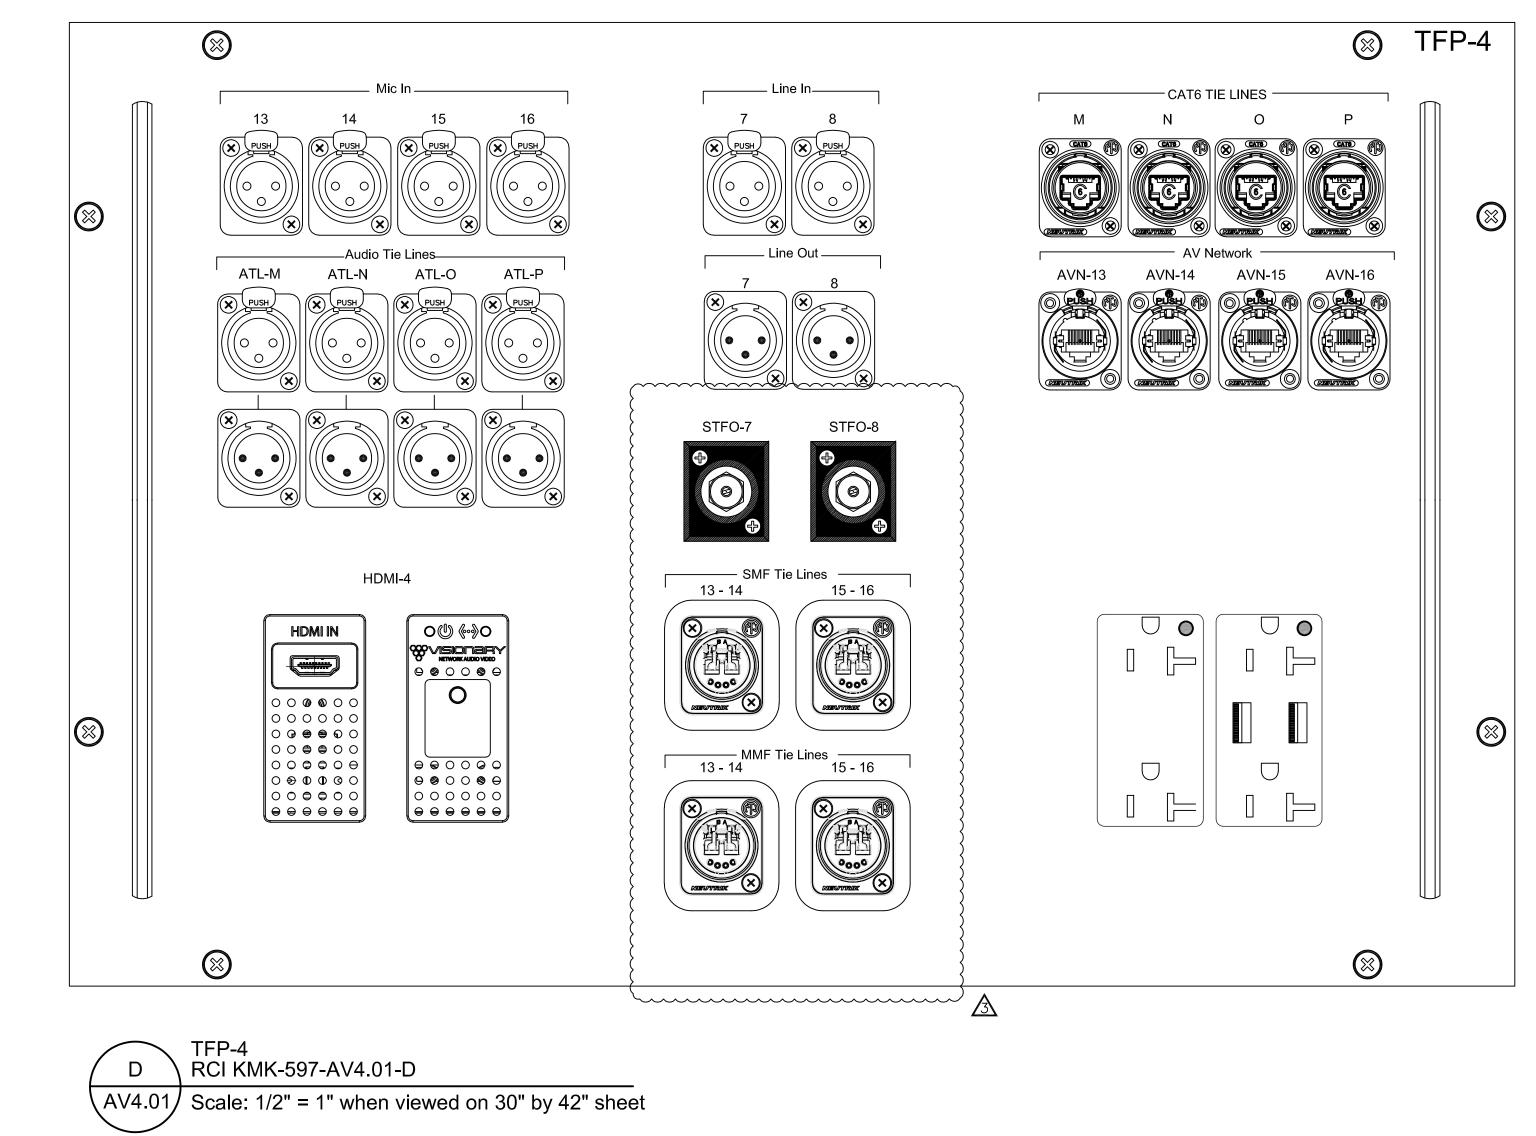



	Rev#:	Date:	Description:	Ву:
	1	08/18/2022	Review/Comment	TWK
	2	10/10/2022	Released for Bid	TWK
	3	05/08/2023	AV Bulletin 1	TWK

Reviewed By:	TK
Date Drawn:	08/18/2022
Scale:	As Noted

Designed By:

Drawn By:



Project Location:
12th & Arch Philadelphia, PA

Project:

OVERLOOK CONFERENCE ROOM

Drawing Title:


AV Plates & Panel Details -Part 1

Drawing Number:

AV4.01





- 3/8" Diameter Black Lacing Bar with 1.25" Standoff
- Visonary Solutions H.264 Duet Encoder
- Senco or equivalent ST Fiber Optic Connector with Cover
- Neutrik Opticon Duplex LC Connector
- 5 Hubbel USB8300A5BK 20A/125V Duplex Receptacle w/USB and LED indicator
- 6 Hubbel 2182BKL Hospital Grade 20A/125V Receptacle with LED indicator
- 7 Panel finish: Black brushed aluminum with engraved & filled white lettering as shown.
- 8 Notes 1 thru 7 above apply to all panels shown on this sheet.

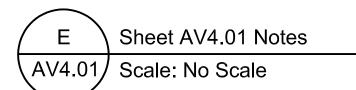



TFP-3 RCI KMK-597-AV4.01-C


AV4.01 | Scale: 1/2" = 1" when viewed on 30" by 42" sheet

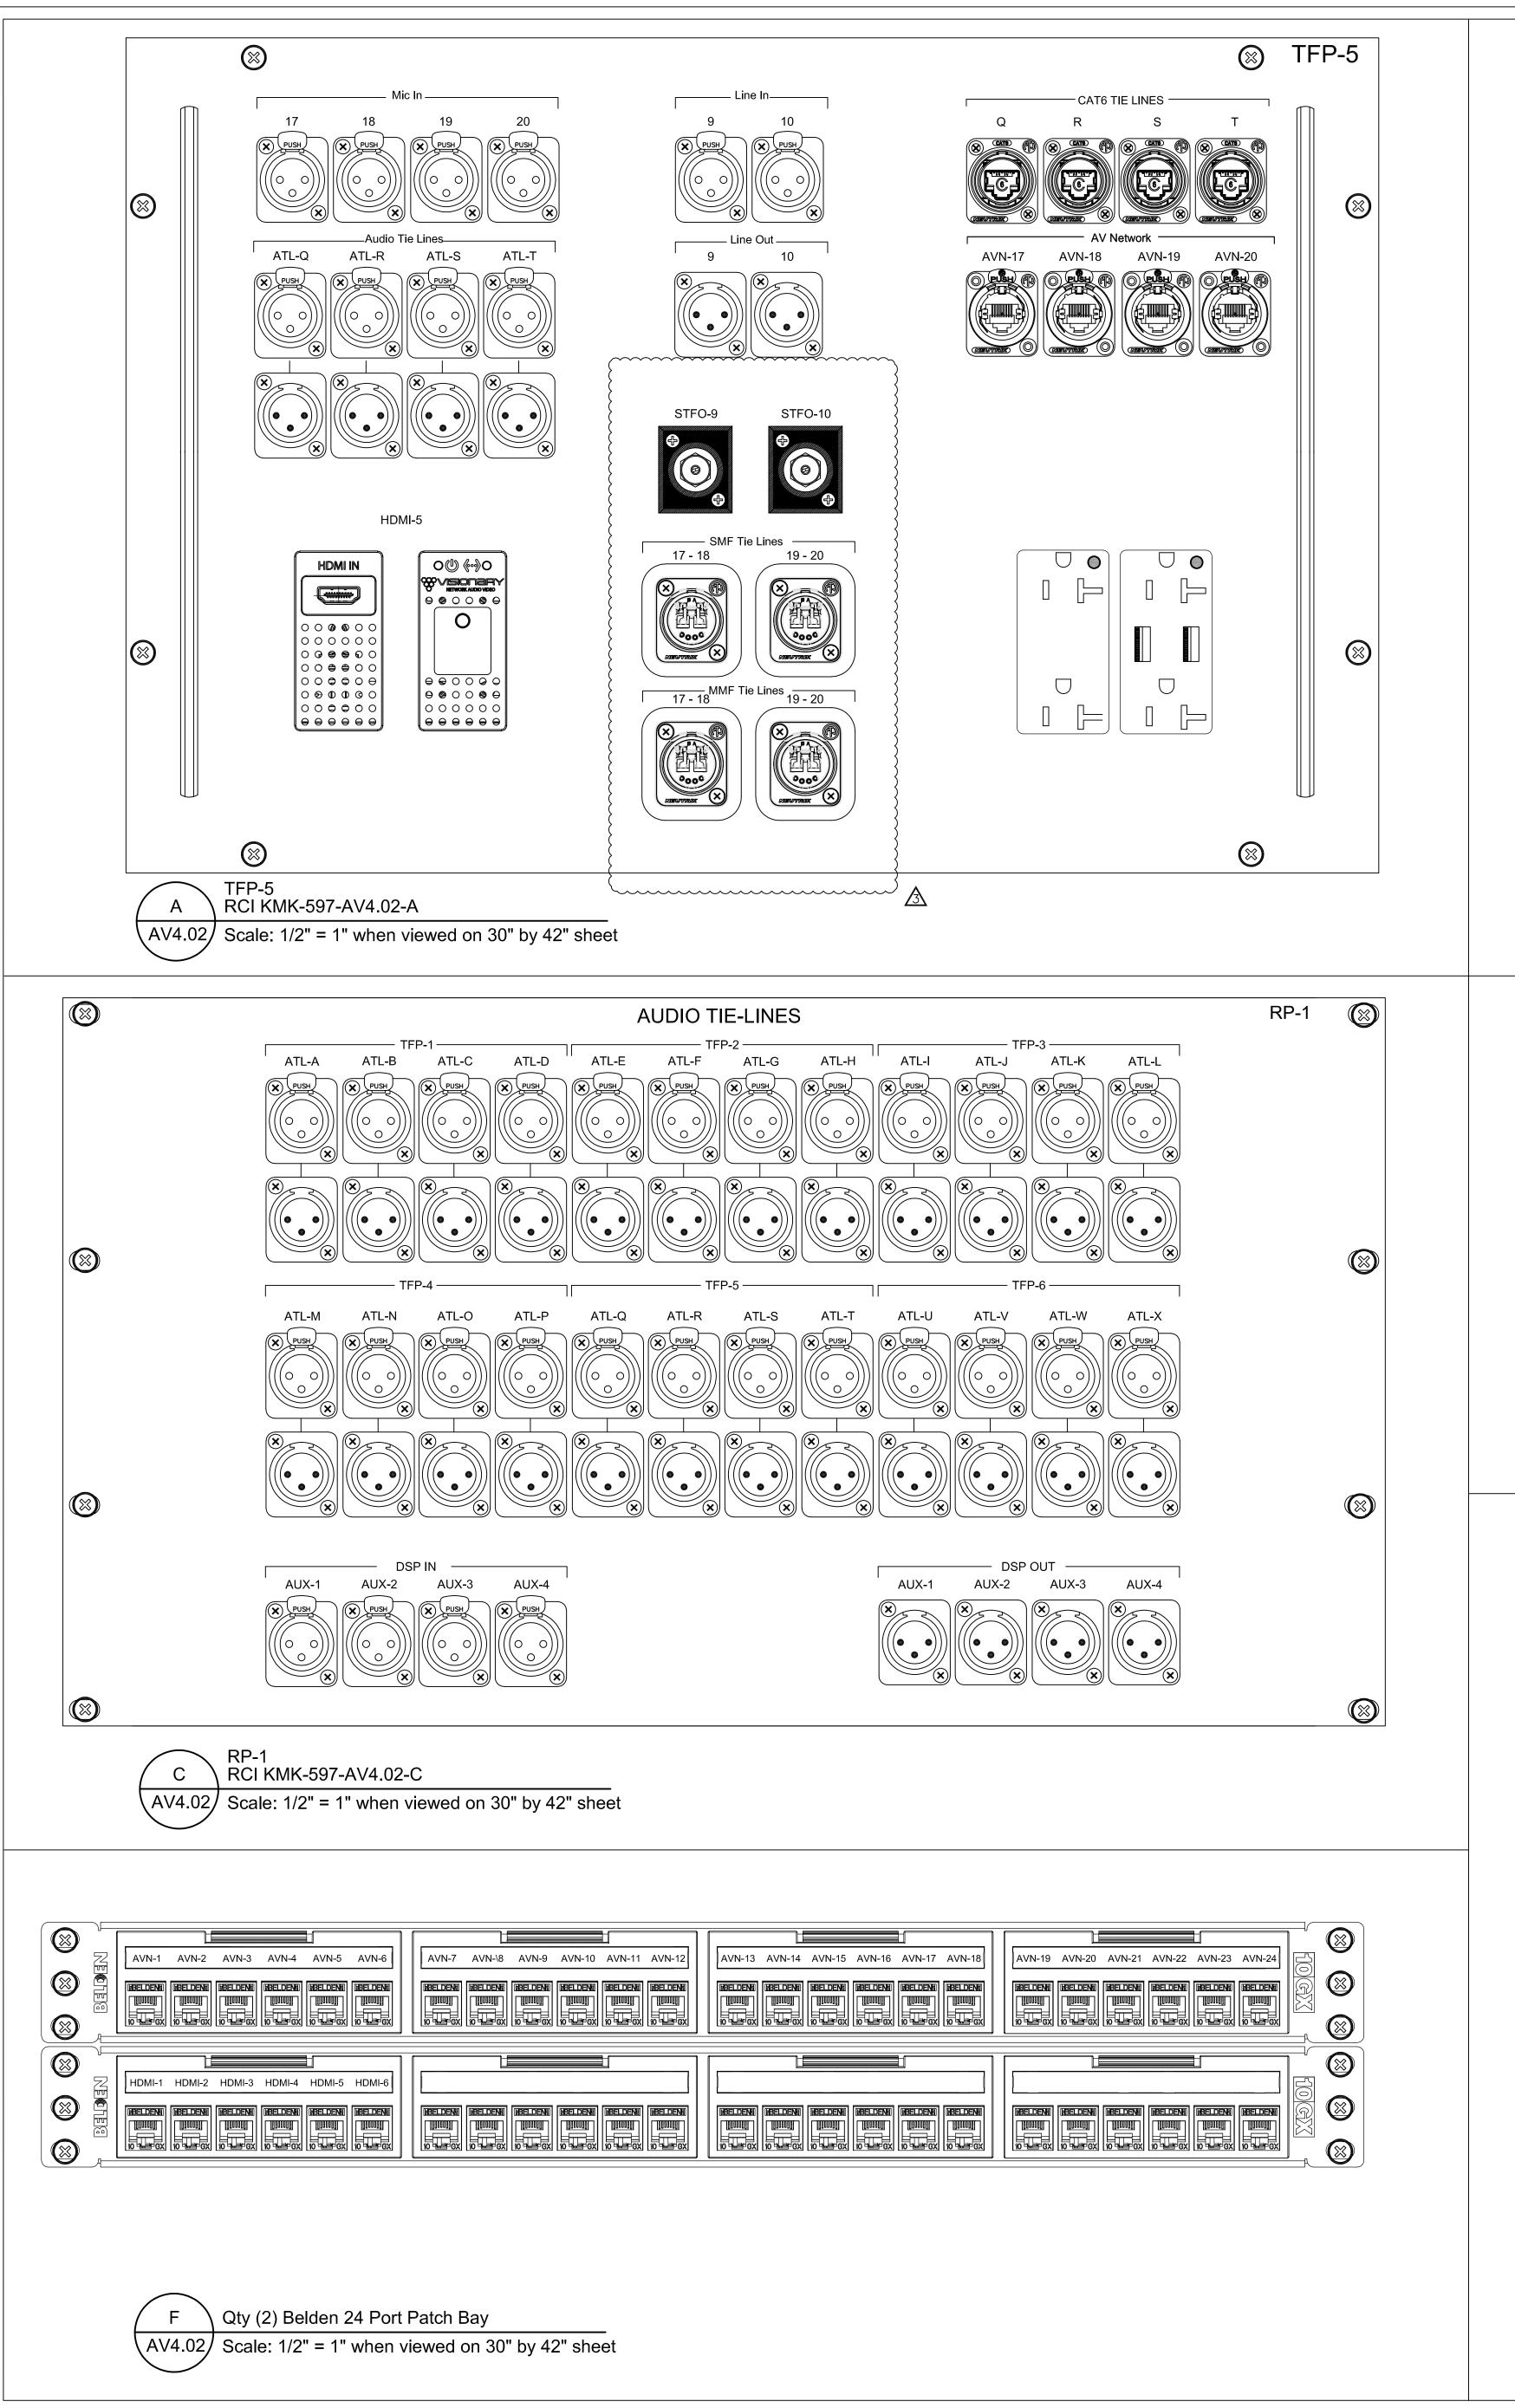

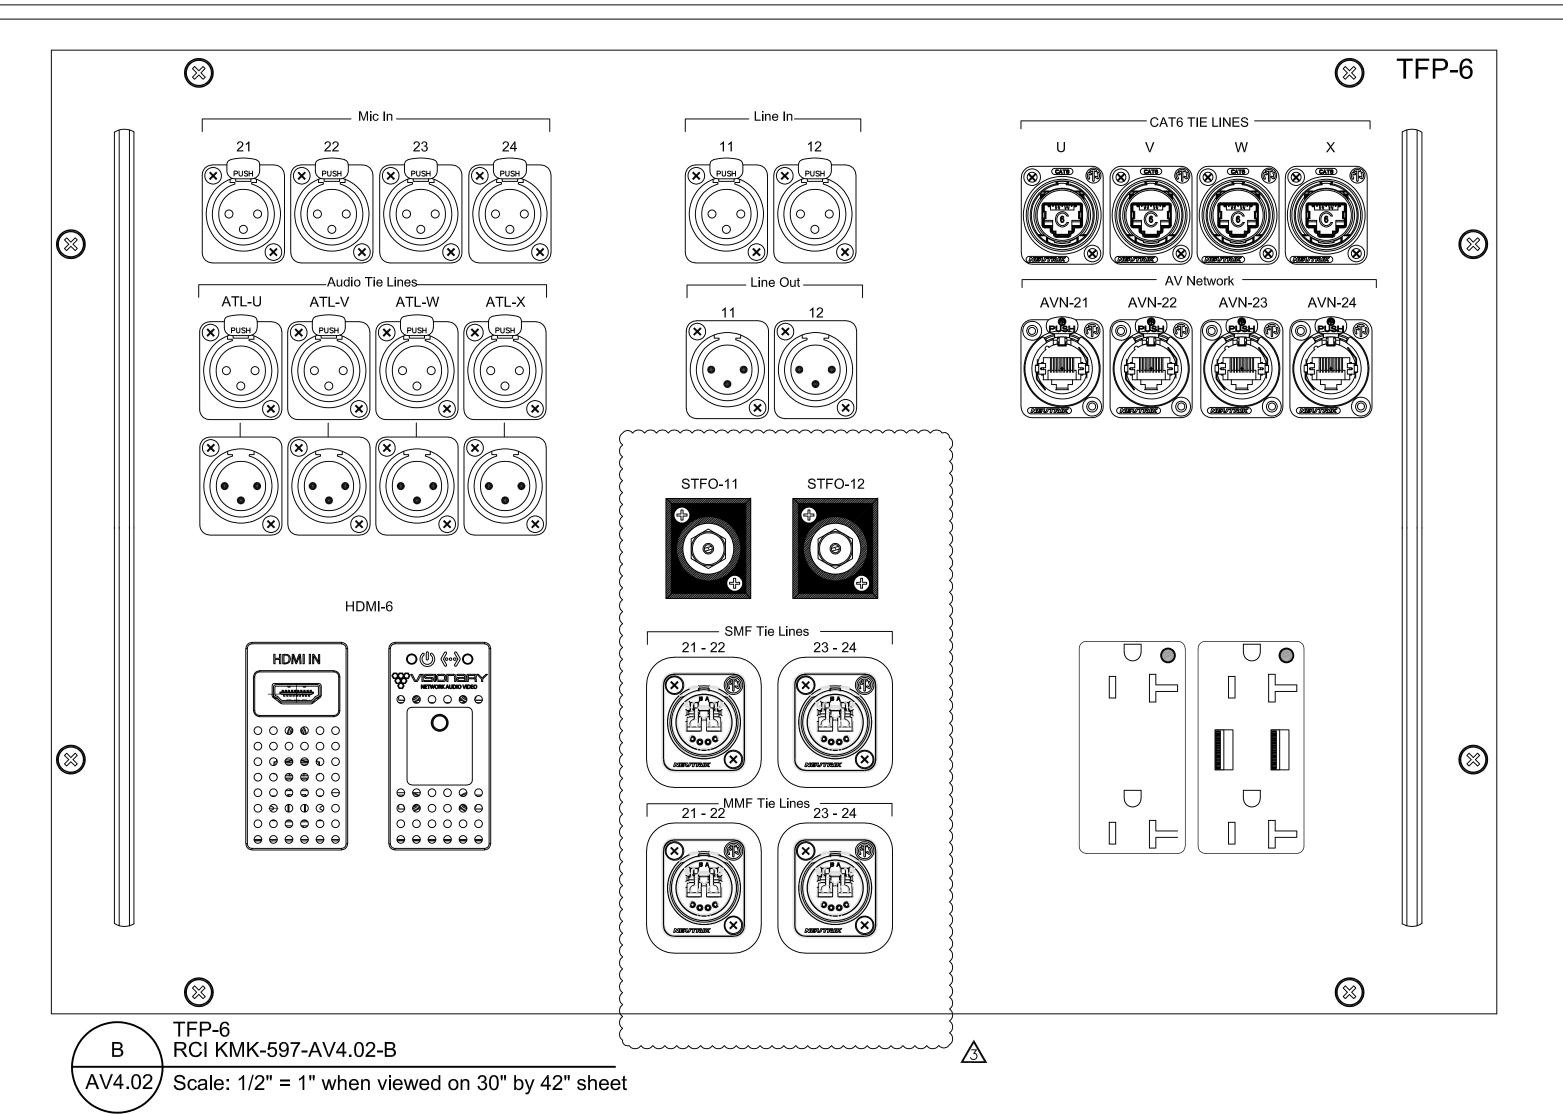

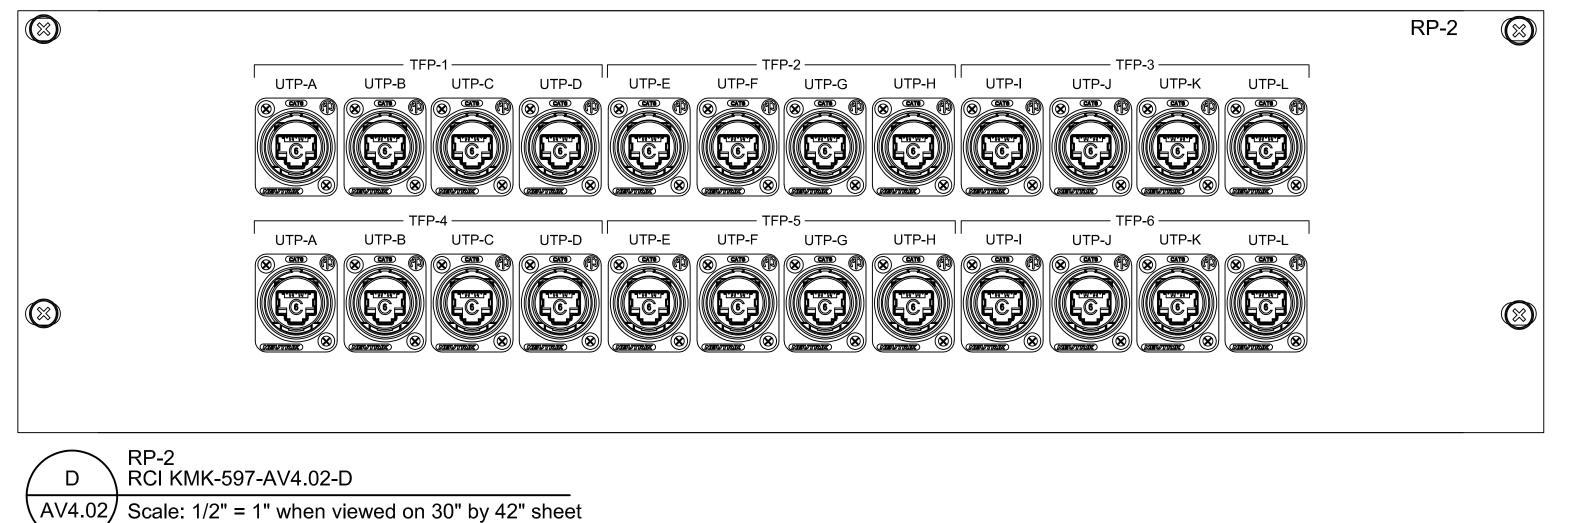

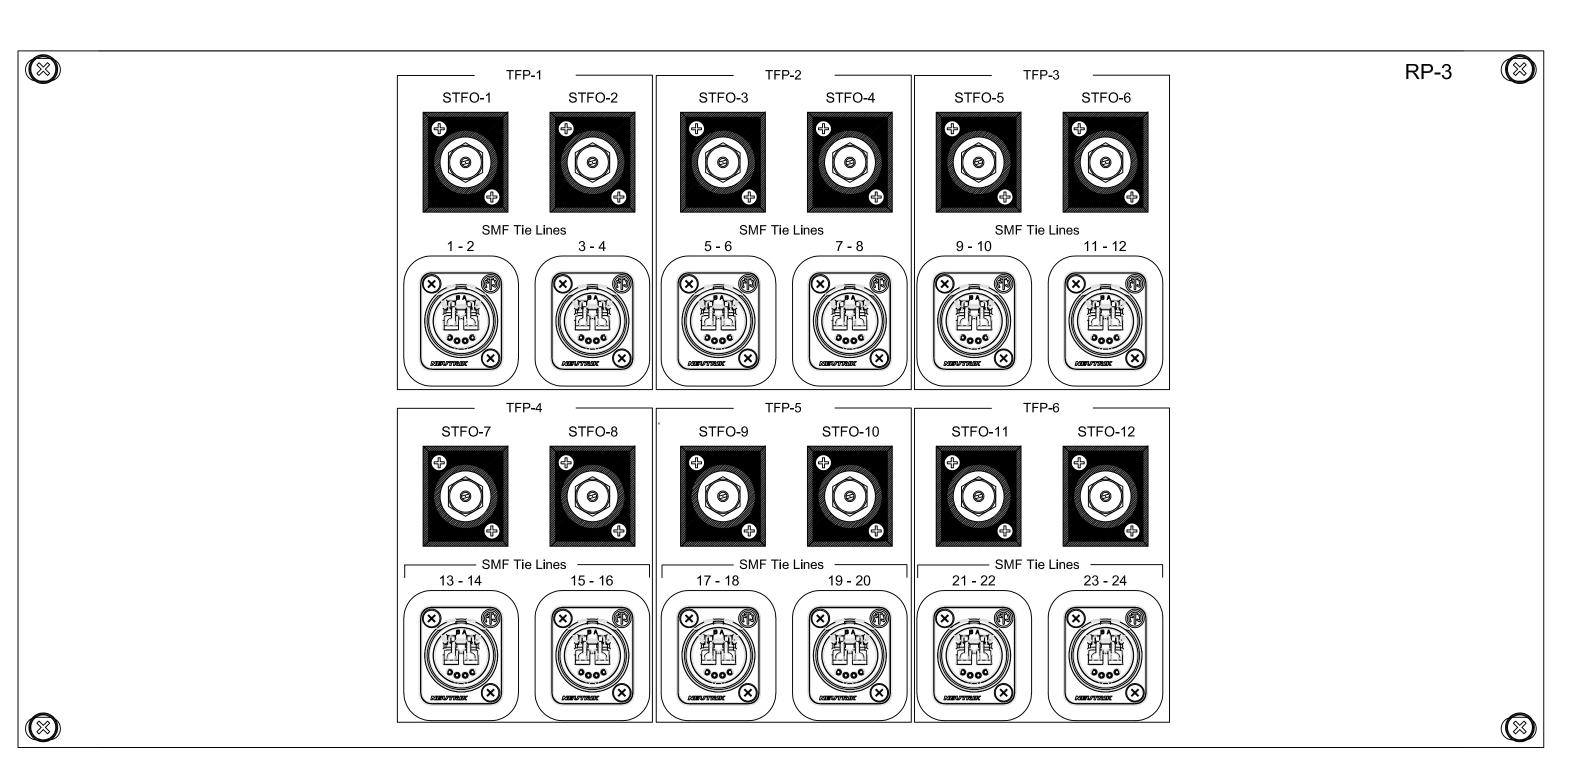

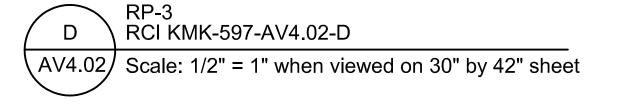



Rev#:	Date:	Description:	Ву:
1	08/18/2022	Review/Comment	TW
2	10/10/2022	Released for Bid	TW
3	05/08/2023	AV Bulletin 1	TW
			<del> </del>
			<u> </u>
			_

Designed By:	KMK
Drawn By:	ТК
Reviewed By:	ТК
Date Drawn:	08/18/2022
Scale:	As Noted



Project Location:
12th & Arch Philadelphia, PA

Project:

OVERLOOK CONFERENCE ROOM

Drawing Title:

AV Plates & Panel Details -

Drawing Number:

AV4.02



Rev#:	Date:	Description:	Ву
3 (	5/08/2023	AV Bulletin 1	TWK
		<u> </u>	+
			+
			+

Designed By: KMK

Drawn By: TK

Reviewed By: TK

Date Drawn: 08/18/2022

Scale: As Noted



Project Location:
12th & Arch Philadelphia, PA

Project:


OVERLOOK CONFERENCE ROOM


Drawing Title:


AV Plates & Panel Details -Part 3

Drawing Number:


AV4.03

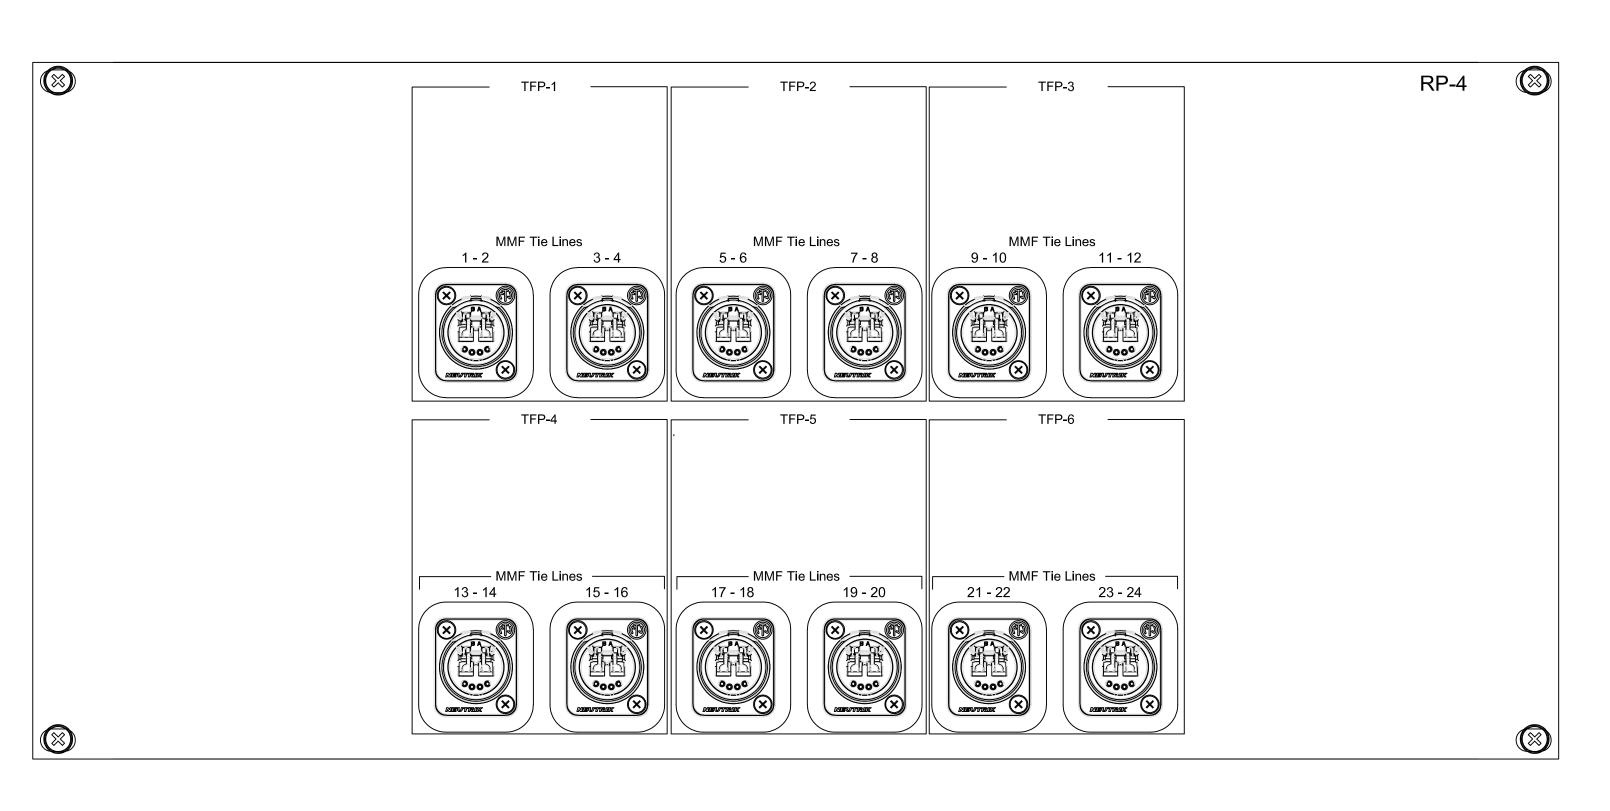

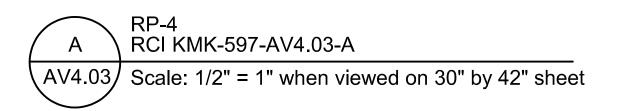

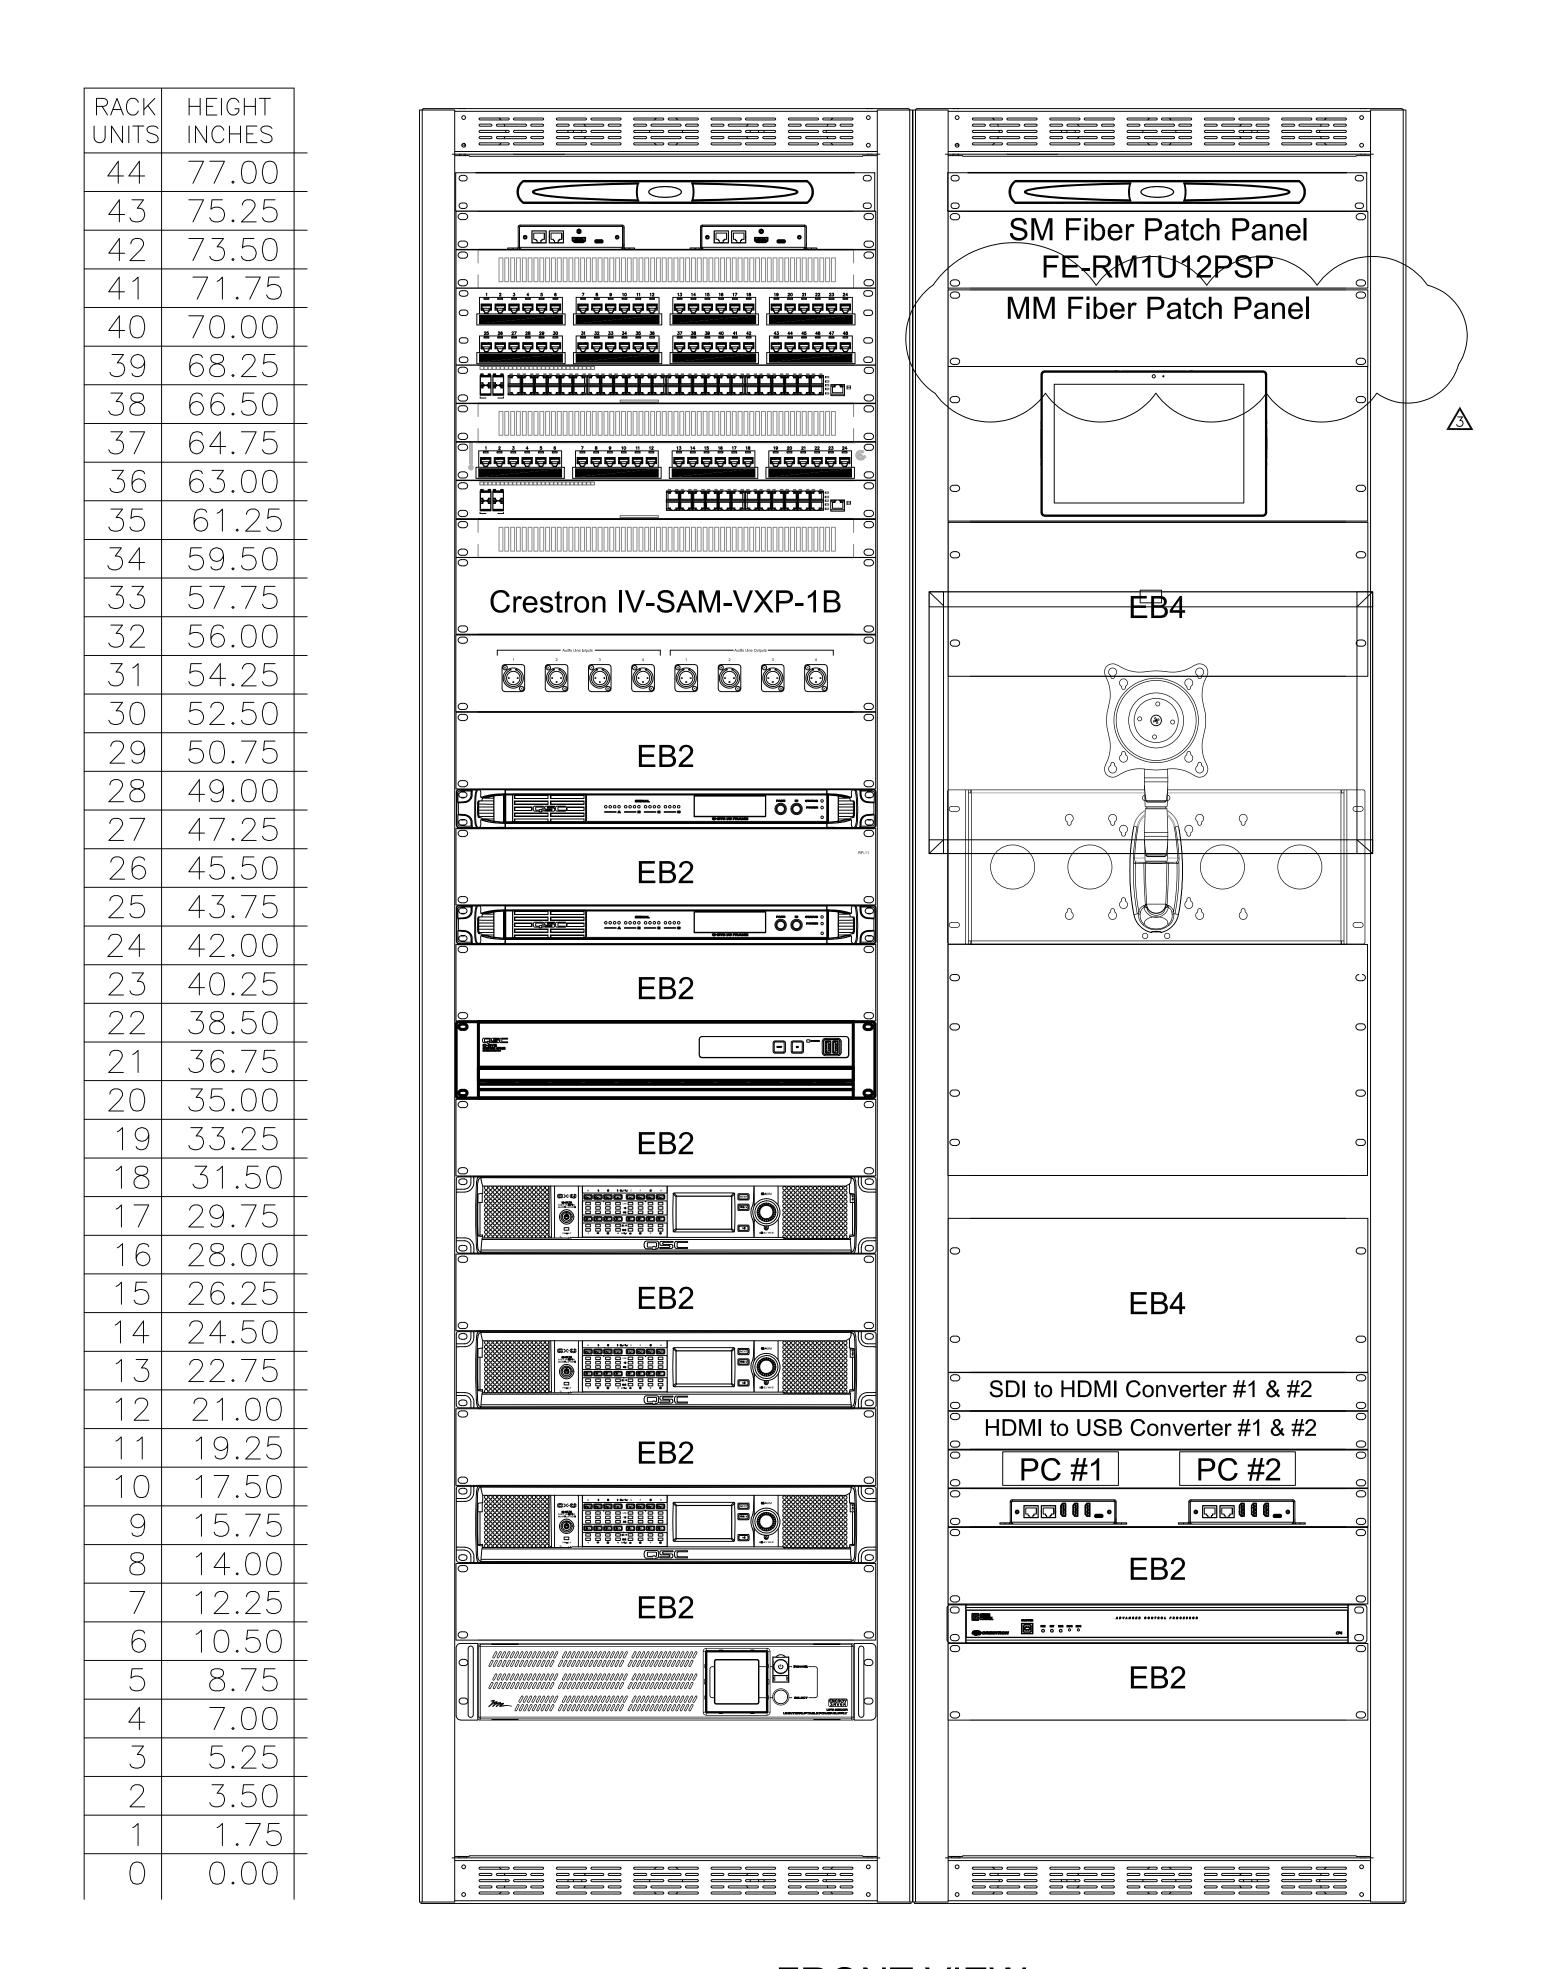

FRONT VIEW

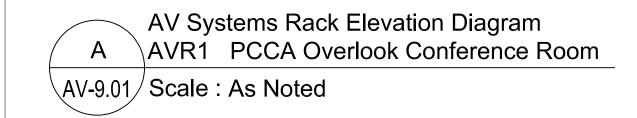



Rev#:	Date:	Description:	Ву:
1	08/18/2022	Review/Comment	TWK
2	10/10/2022	Released for Bid	TWK
3	05/08/2023	AV Bulletin 1	TWK
			1
			1
			+
			+
			<u> </u>
			<u> </u>
			1

Pennsylvania Convention Center PHILADELPHIA
---------------------------------------------

Designed By: KMK

Reviewed By: TK

Date Drawn: 08/18/2022

Drawn By:

Scale:

Project Location:
12th & Arch Philadelphia, PA

Project:

OVERLOOK CONFERENCE ROOM

Drawing Title:

AV System Rack Elevation Diagram - Part 1

Drawing Number:

AV9.01