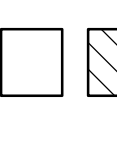



LEGEND	
	EXISTING CONSTRUCTION
	PROPOSED NEW CONSTRUCTION

VITETTA
 ARCHITECTURAL ENGINEERING PLANNING INTERIOR DESIGN
 PHILADELPHIA NAVAL BUSINESS CENTER
 740 S. BROAD ST. PHILADELPHIA PA 19112
 P: 215.566.1400 F: 215.566.1400

Kelly/Manolio Inc.
 ARCHITECT & PLANNER
 1420 WALNUT STREET, 15TH FLOOR
 PHILADELPHIA, PA 19102
 P: 215.566.1400 F: 215.566.1400


THOMPSON
 ASSOCIATES, INC.
 2200 BROADWAY TOWER 1110
 ATLANTA, GEORGIA 30309-1591
 404-888-6000 FAX 404-888-8700

PROJECT & ASSOCIATION
 ARE REGISTERED ARCHITECTS
 ARE REGISTERED ENGINEERS
 ARE REGISTERED PROFESSIONAL PLANNERS
 ARE REGISTERED INTERIOR DESIGNERS
 BRANNOON/VITETTA

SEAL

SEAL

EXPANSION AND RENOVATION
 TO THE
PENNSYLVANIA CONVENTION CENTER
 1101 ARCH STREET • PHILADELPHIA, PENNSYLVANIA 19107

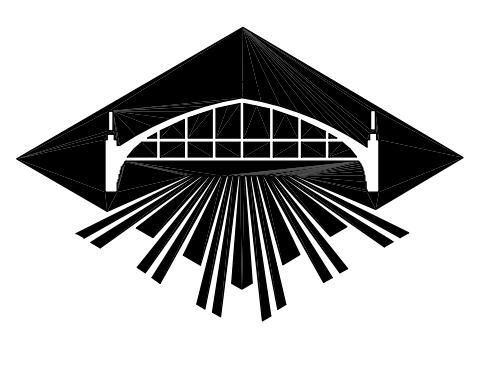


PENNSYLVANIA CONVENTION CENTER AUTHORITY
 ONE PENNSYLVANIA CONVENTION CENTER PLACE
 1101 ARCH STREET
 PHILADELPHIA, PENNSYLVANIA 19107

RECORD SET

NO.	REVISIONS	DATE
1	RECORD SET CONTACTS 1 AND 2	05/02/11

ENTIRE BUILDING PLAN

G-004

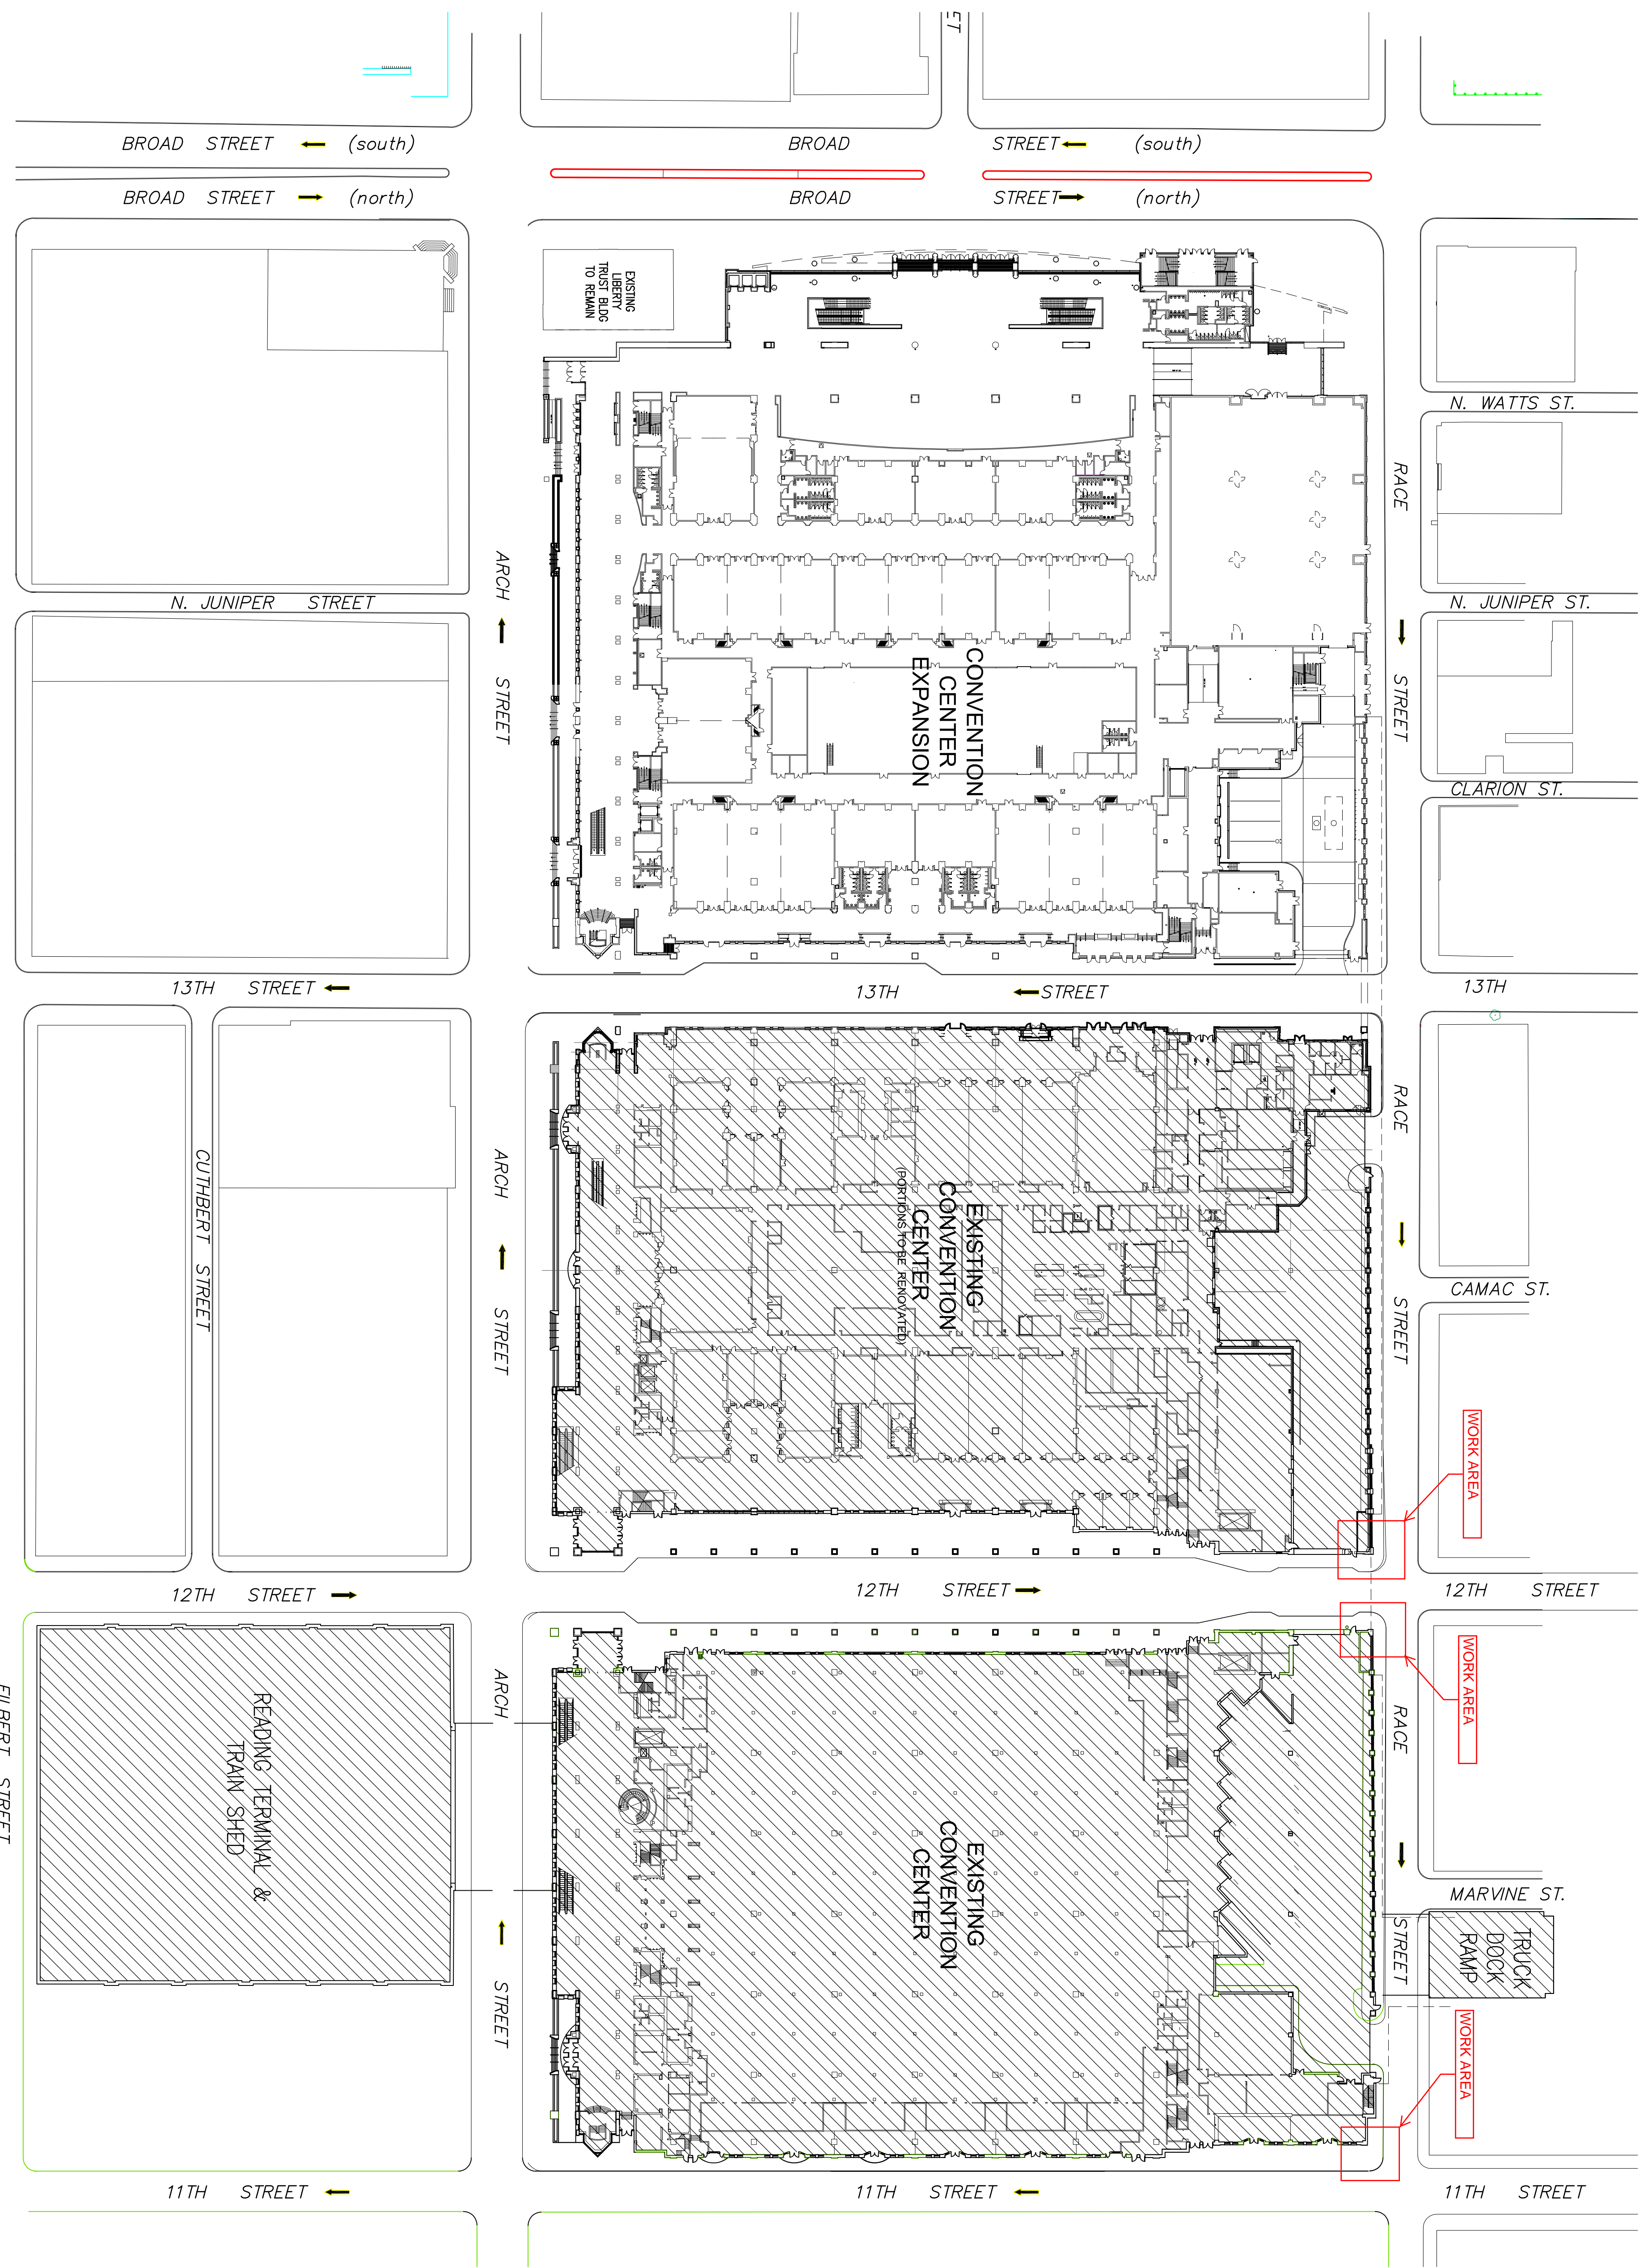

DS ENTIRE BUILDING PLAN
 SCALE: 1/8" = 1'-0"

A 0 1 2 3 4 5 6 7 8 9 10 11 12 13 14 15 16 17 18 19 20