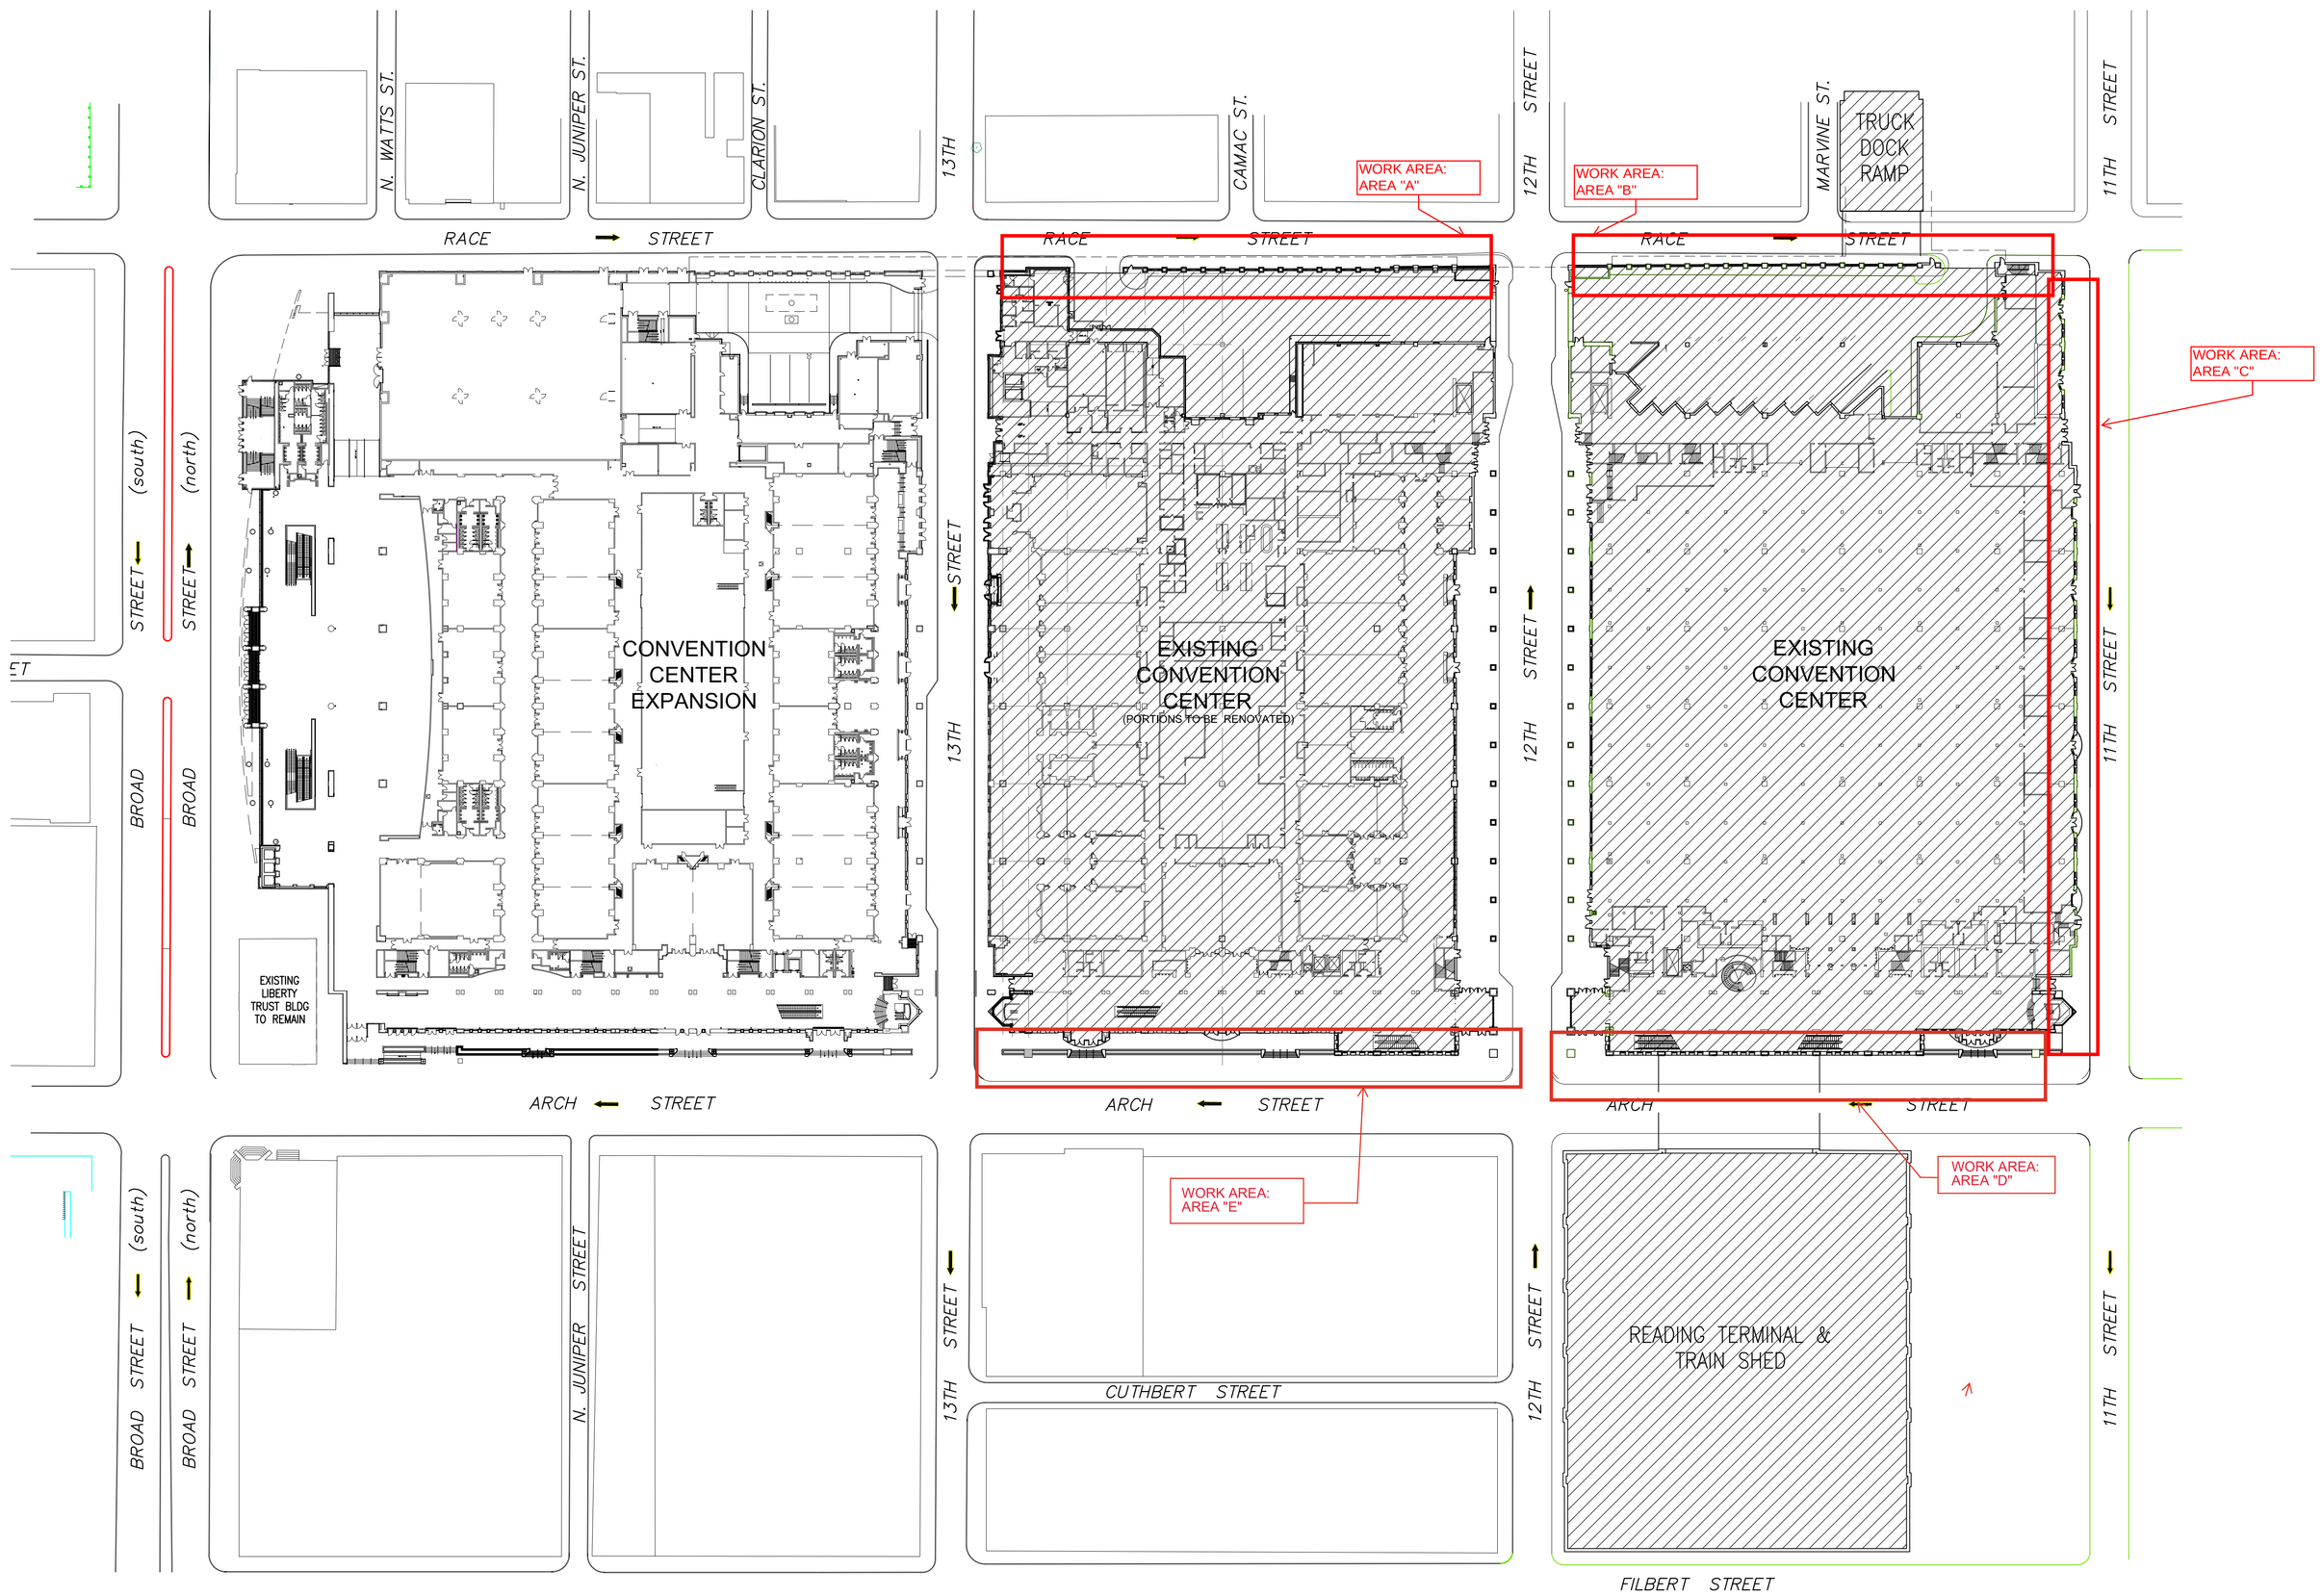

D5 / G-004 ENTIRE BUILDING PLAN
SCALE : 1/64" = 1'-0"

LEGEND

	EXISTING CONSTRUCTION
	PROPOSED NEW CONSTRUCTION

VITETTA
ARCHITECTURE ENGINEERING PLANNING INTERIOR DESIGN
PHILADELPHIA NAVAL BUSINESS CENTER
4747 S. BROAD ST. PHILADELPHIA PA 19112
T 215.218.4747 F 215.218.4740

Kelly/Maiello Inc.
Architects & Planners
1420 WALNUT STREET, 15TH FLOOR
PHILADELPHIA PA 19102-4015
215-546-0800 FAX: 215-546-1420

tvs
THOMPSON, VENTULETT, STAINBACK & ASSOCIATES, INC.
2700 PROMENADE TWO
1230 PEACHTREE STREET N.E.
ATLANTA, GEORGIA 30309-3591
404-888-6600 FAX: 404-888-6700

PROJECT # 9303.04.00
ALL DIMENSIONS MUST BE VERIFIED BY CONTRACTOR AND THE ARCHITECT NOTIFIED OF ANY DISCREPANCIES BEFORE PROCEEDING WITH THE CONSTRUCTION DO NOT SCALE DRAWINGS ©2007 VITETTA

SEAL

SEAL

EXPANSION AND RENOVATION TO THE PENNSYLVANIA CONVENTION CENTER

1101 ARCH STREET • PHILADELPHIA, PENNSYLVANIA 19107

PENNSYLVANIA CONVENTION CENTER AUTHORITY
ONE PENNSYLVANIA CONVENTION CENTER PLACE
1101 ARCH STREET
PHILADELPHIA, PENNSYLVANIA 19107

RECORD SET

NO.	REVISIONS	DATE
	RECORD SET CONTRACTS 1 AND 2	05/02/11

DRAWING TITLE
ENTIRE BUILDING PLAN

PROJECT NO. VT 9303.04
DRAWN BY MGIGNARD
CHECKED BY JK / RH
DATE 9/28/07
SCALE AS NOTED

DRAWING NO. G-004