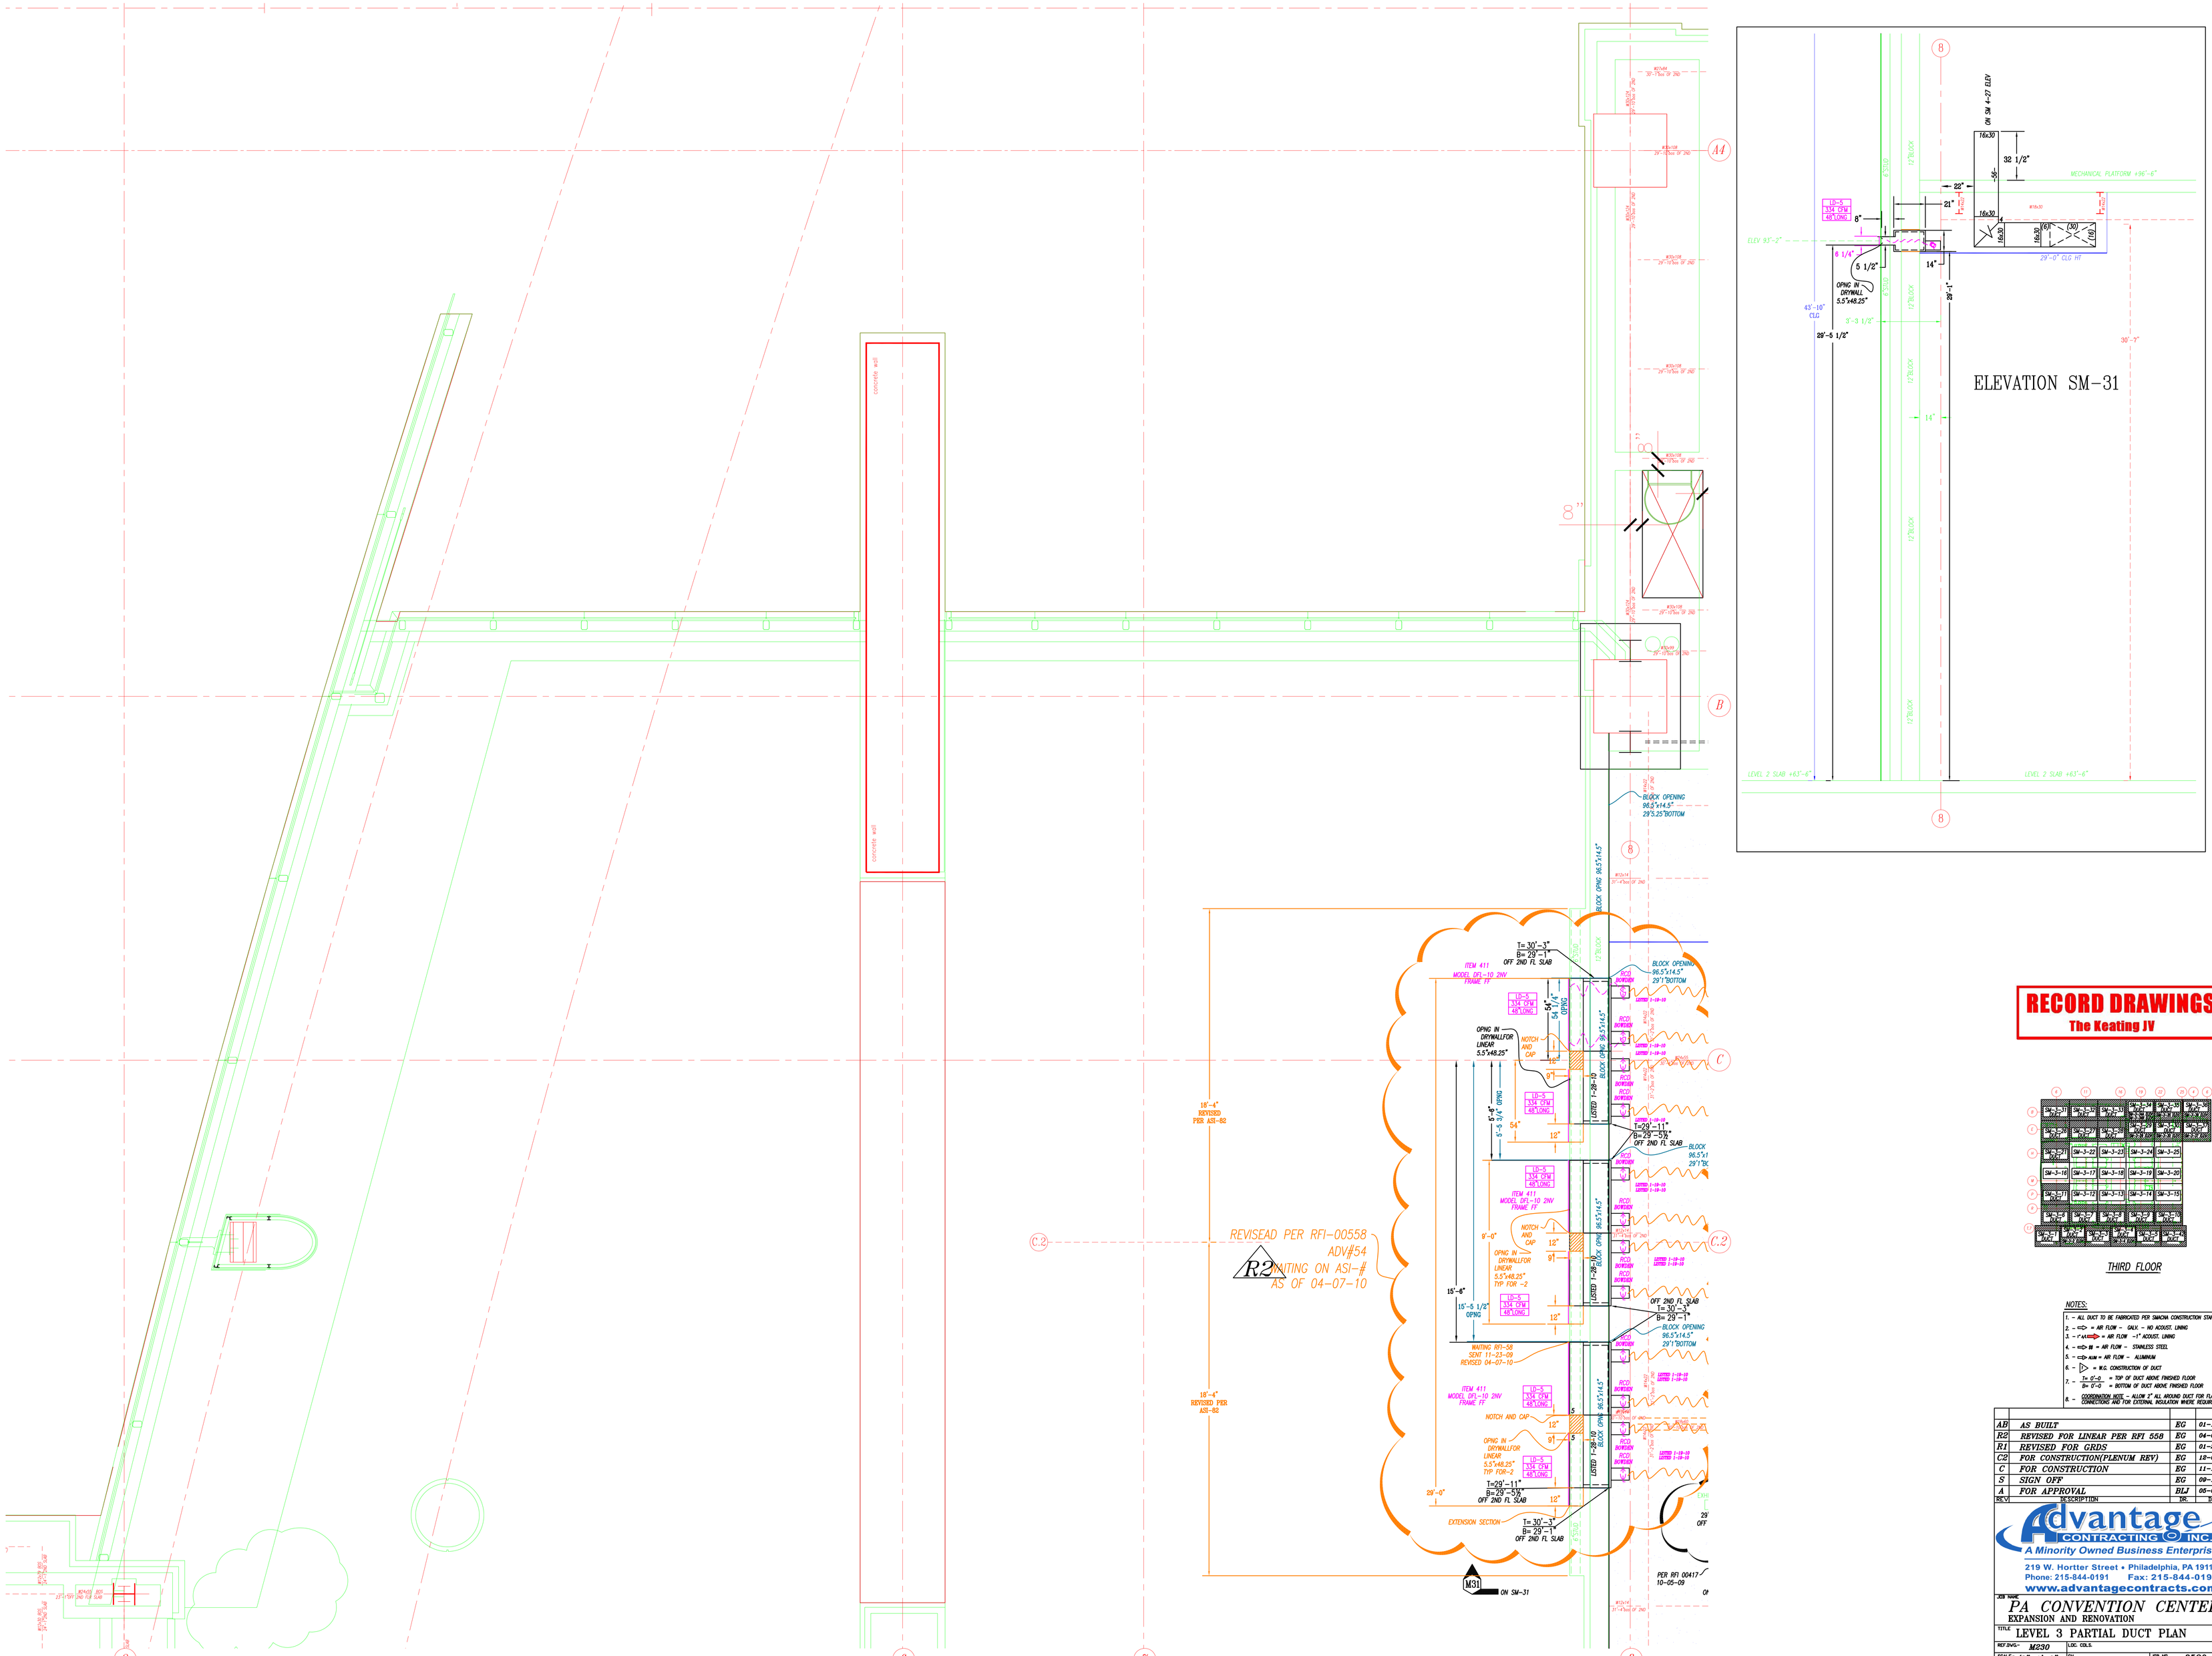
ELEVATION SM-31
ON SM 4-27 ELEV
16x30
32 1/2"
MECHANICAL PLATFORM +96'-6"
22"
21"
8"
LD-5 334 CFM 48"LONG
6 1/4"
5 1/2"
14"
29'-0" CLG HT
OPNG IN DRYWALL 5.5"x48.25"
43'-10" CLG
29'-5 1/2"
1'-3 1/2"
29'-1"
30'-7"
12"BLOCK
6"SLAB
LEVEL 2 SLAB +63'-6"
LEVEL 2 SLAB +63'-6"
concrete wall
concrete wall
BLOCK OPENING 96.5"x14.5" 29'5.25"BOTTOM
BLOCK OPNG 96.5"x14.5"
REVISEAD PER RFI-00558 ADV#54
R2 WAITING ON ASI-# AS OF 04-07-10
18'-4" REVISED PER ASI-82
18'-4" REVISED PER ASI-82
T= 30'-3" B= 29'-1" OFF 2ND FL SLAB
ITEM 411 MODEL DFL-10 2NV FRAME TT
OPNG IN DRYWALLFOR LINEAR 5.5"x48.25"
NOTCH AND CAP
54 1/4" OPNG
5'-5 3/4" OPNG
54"
12"
9"
T=29'-11" B=29'-5 3/4" OFF 2ND FL SLAB
9'-0"
15'-6"
15'-5 1/2" OPNG
WAITING RFI-58 SENT 11-23-09 REVISED 04-07-10
OFF 2ND FL SLAB T= 30'-3" B= 29'-1"
EXTENSION SECTION
T= 30'-3" B= 29'-1" OFF 2ND FL SLAB
29'-0"
M31 ON SM-31
PER RFI 00417 10-05-09
LISTED 1-28-10
RCD1 BOWDEN
LISTED 1-18-10
LISTED 1-18-10
LISTED 1-18-10

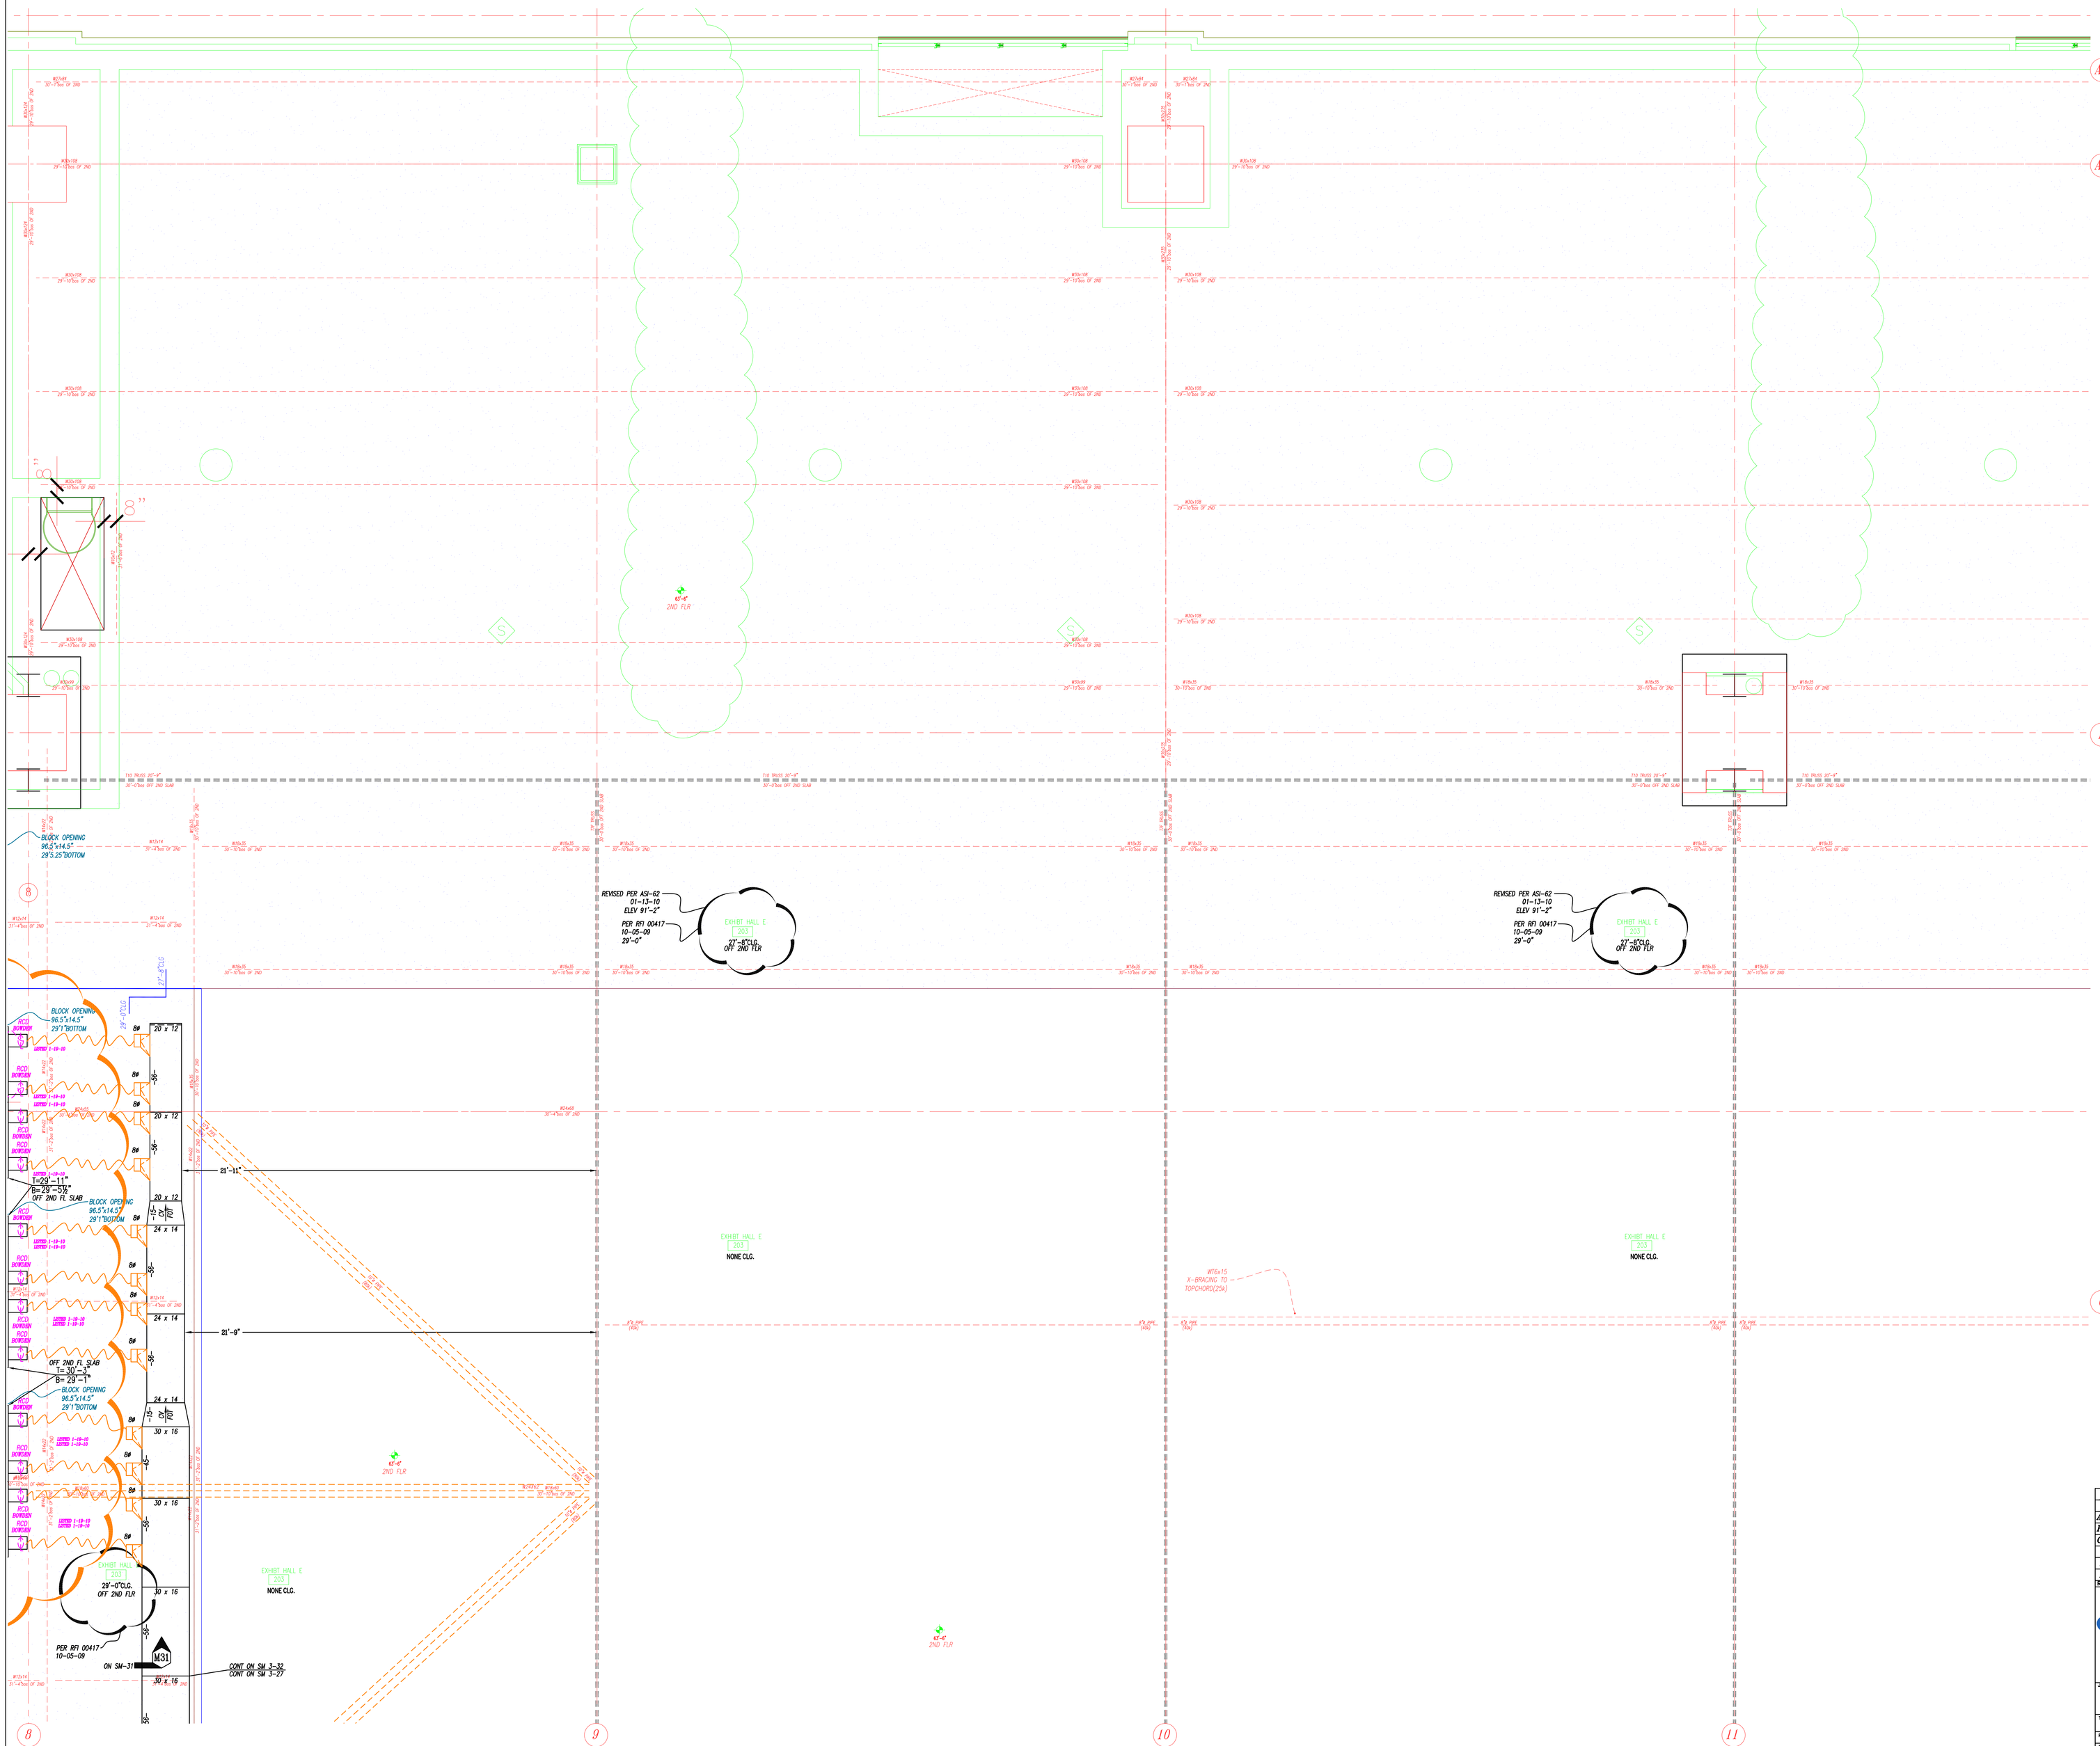

RECORD DRAWINGS
The Keating JV

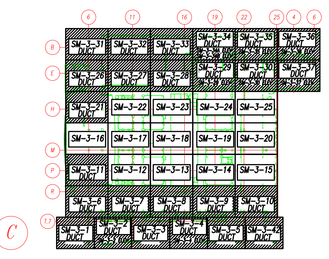

THIRD FLOOR

NOTES:

1. – ALL DUCT TO BE FABRICATED PER SMACNA CONSTRUCTION STANDARDS.
2. – <=> = AIR FLOW – GALV. – NO ACOUST. LINING
3. – <=> = AIR FLOW – 1" ACOUST. LINING
4. – <=> SS = AIR FLOW – STAINLESS STEEL
5. – <=> ALUM = AIR FLOW – ALUMINUM
6. – ▷ = W.G. CONSTRUCTION OF DUCT
7. – 1x 0'-0" = TOP OF DUCT ABOVE FINISHED FLOOR; 8x 0'-0" = BOTTOM OF DUCT ABOVE FINISHED FLOOR
8. – COORDINATION NOTE – ALLOW 2" ALL AROUND DUCT FOR FLANGE CONNECTIONS AND FOR EXTERNAL INSULATION WHERE REQUIRED.

REV'D	DESCRIPTION	BR.	DATE
AB	AS BUILT	EG	01-11-11
R1	REVISED FOR GRDS	EG	01-28-10
C2	FOR CONSTRUCTION(PLENUM REV)	EG	12-02-09
C	FOR CONSTRUCTION	EG	11-16-09
S	SIGN OFF	EG	09-16-09
A	FOR APPROVAL	BLJ	05-15-09

Advantage CONTRACTING INC.
A Minority Owned Business Enterprise
219 W. Hortter Street • Philadelphia, PA 19119
Phone: 215-844-0191 Fax: 215-844-0192
www.advantagecontracts.com

JOB NAME
PA CONVENTION CENTER
EXPANSION AND RENOVATION

TITLE
LEVEL 3 PARTIAL DUCT PLAN

REF.DWG.- M230	LOC. COLS.		
SCALE 3/8"=1'-0"	CH.	JOB NO.	8520
DATE 05-13-09	BR. BLJ	DWG. NO.	SM 3-32

REVISED FOR STEEL

DELETED TRANS IN ASI-29

REVISED PER ASI-62
01-13-10
ELEV 91'-2"
PER RFI 00417
10-05-09
29'-0"

EXHIBIT HALL E
[203]
27'-8"CLG.
OFF 2ND FLR

EXHIBIT HALE E
[203]
NONE CLG.

ADDED DOOR
AS-74

CENTRAL PLAZA
[301]
NONE CLG.

STAIR
STR-E
NO CLG.

DN
UP
UP
DN
UP
DN
UP

38'-0"Lx12'-0"Wx5'-0"H PLENUM
VIBRO-ACOUSTIC MODEL
4" DOUBLE WALL PERF CONSTRUCTION

T=35'-10"
B=31'-10"
OFF 2ND FL SLAB

T=45'-5"
B=38'-3"
OFF LEVEL 2 SLAB
A I-940 DETAIL 1/V

DUCT ON SM 3-33

CONT ON SM 4-33

DAMPER REMOVED BY-36

T=16'-9"
B=11'-9"

AHU
14

THIRD FLOOR

NOTES:

1. — ALL DUCT TO BE FABRICATED PER SMACNA CONSTRUCTION STANDARDS.
2. — <=D= = AIR FLOW — GALV. — NO ACOUST. LINING
3. — <=D= = AIR FLOW —1" ACOUST. LINING
4. — <=D= = AIR FLOW — STAINLESS STEEL
5. — <=D= ALUM = AIR FLOW — ALUMINUM
6. — [▷ = W.G. CONSTRUCTION OF DUCT
7. — T= 0'-0 = TOP OF DUCT ABOVE FINISHED FLOOR
B= 0'-0 = BOTTOM OF DUCT ABOVE FINISHED FLOOR
8. — COORDINATION NOTE — ALLOW 2" ALL AROUND DUCT FOR FLANGE CONNECTIONS AND FOR EXTERNAL INSULATION WHERE REQUIRED.

REV	DESCRIPTION	DR.	DATE
AB	AS BUILT	EG	01-11-11
R2	REVISED FOR GRDS	EG	01-28-10
C	FOR CONSTRUCTION	EG	09-22-09
R1	REVISED UNITS	EG	09-16-09
S1	SIGN OFF REV-1	EG	09-16-09
S	SIGN OFF	BLJ	07-09-09
A	FOR APPROVAL	BLJ	05-15-09

RECORD DRAWINGS
The Keating JV

Advantage CONTRACTING INC.
A Minority Owned Business Enterprise
219 W. Hortter Street • Philadelphia, PA 19119
Phone: 215-844-0191 Fax: 215-844-0192
www.advantagecontracts.com

JOB NAME
PA CONVENTION CENTER
EXPANSION AND RENOVATION

TITLE
LEVEL 3 PARTIAL DUCT PLAN

REF.DWG.- M230 M233 | LOC. COLS.

SCALE 3/8"=1'-0" | CH. | JOB NO. 8520

DATE 05-13-09 | DR. BLJ | DWG. NO. SM 3-33

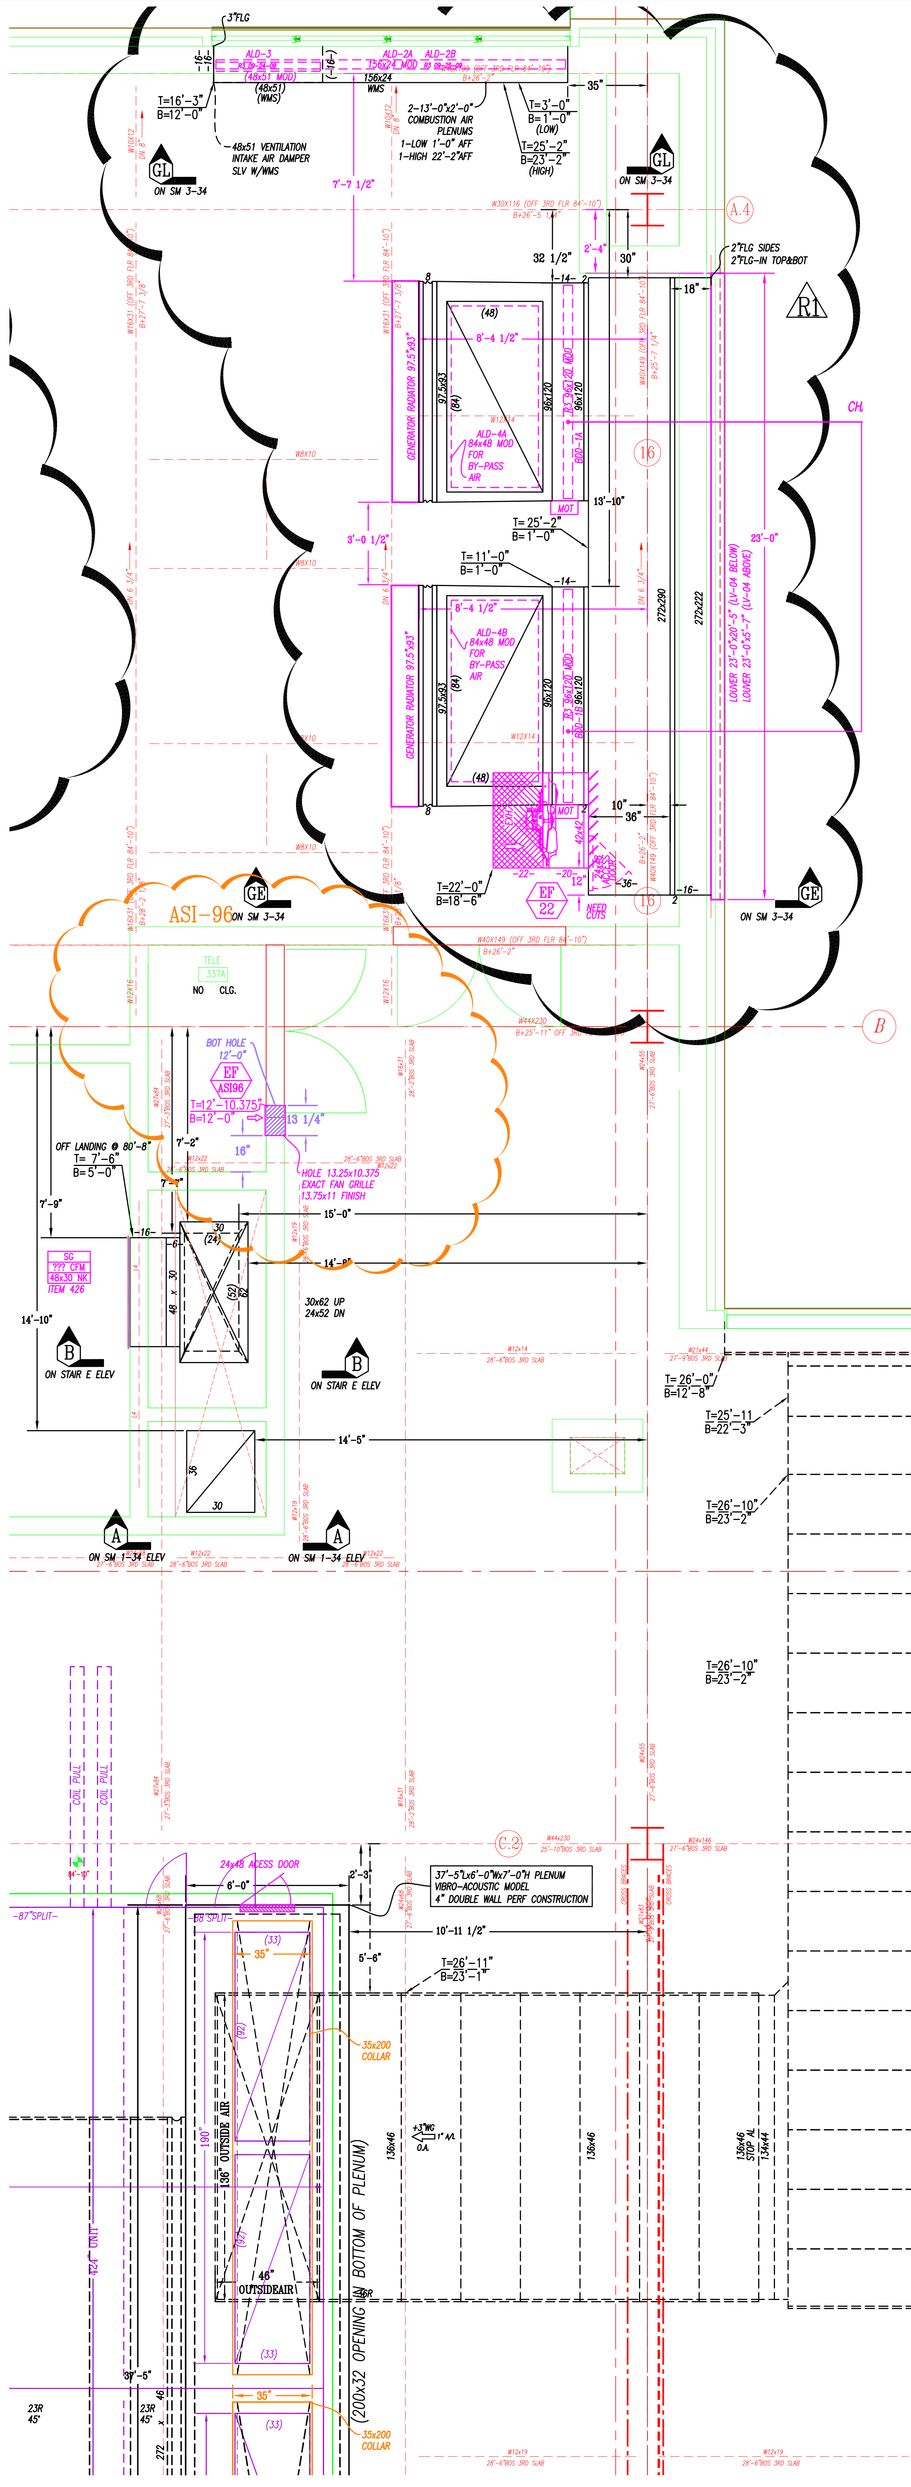

RECORD DRAWINGS
The Keating JV

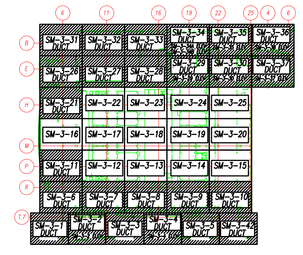

THIRD FLOOR

NOTES:

1. – ALL DUCT TO BE FABRICATED PER SMACNA CONSTRUCTION STANDARDS.
2. – <=> = AIR FLOW – GALV. – NO ACOUST. LINING
3. – <=> = AIR FLOW –1" ACOUST. LINING
4. – <=> SS = AIR FLOW – STAINLESS STEEL
5. – <=> ALM = AIR FLOW – ALUMINUM
6. – ▷ = W.G. CONSTRUCTION OF DUCT.
7. – T= 0'-0" = TOP OF DUCT ABOVE FINISHED FLOOR; B= 0'-0" = BOTTOM OF DUCT ABOVE FINISHED FLOOR
8. – COORDINATION NOTE – ALLOW 2" ALL AROUND DUCT FOR FLANGE CONNECTIONS AND FOR EXTERNAL INSULATION WHERE REQUIRED.

REV.	DESCRIPTION	DR.	DATE
AB	AS BUILT	EG	01-11-11
R2	REVISED FOR GRDS	EG	01-28-10
C	FOR CONSTRUCTION	EG	09-22-09
R1	REVISED PER RFI-329 ADV#40	BLJ	07-09-09
S	SIGN OFF	BLJ	07-09-09
A	FOR APPROVAL	BLJ	05-15-09

Advantage CONTRACTING INC.
A Minority Owned Business Enterprise
219 W. Hortter Street • Philadelphia, PA 19119
Phone: 215-844-0191 Fax: 215-844-0192
www.advantagecontracts.com

JOB NAME: PA CONVENTION CENTER
EXPANSION AND RENOVATION

TITLE: LEVEL 3 PARTIAL DUCT PLAN

REF DWGS: M-233	LOC. COILS:		
SCALE: 3/8"=1'-0"	DR:	JOB NO.	8520
DATE: 05-13-09	DR. BLJ	DWG NO.	SM 3-34

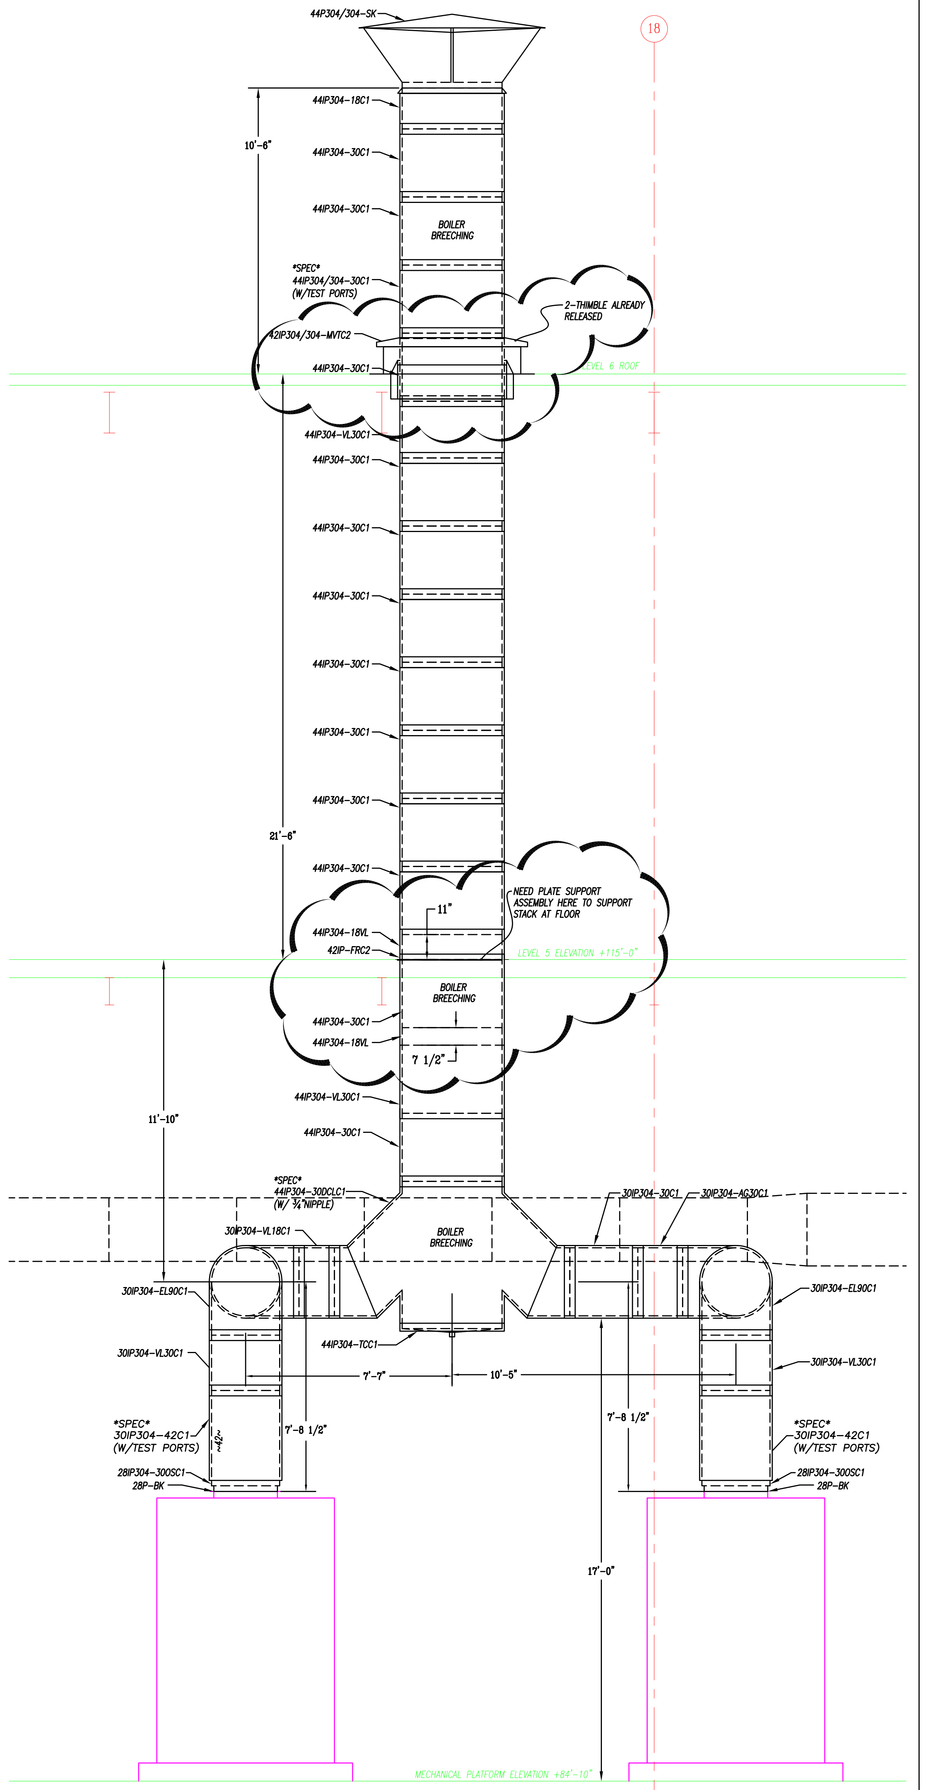

SECTION "A–A"

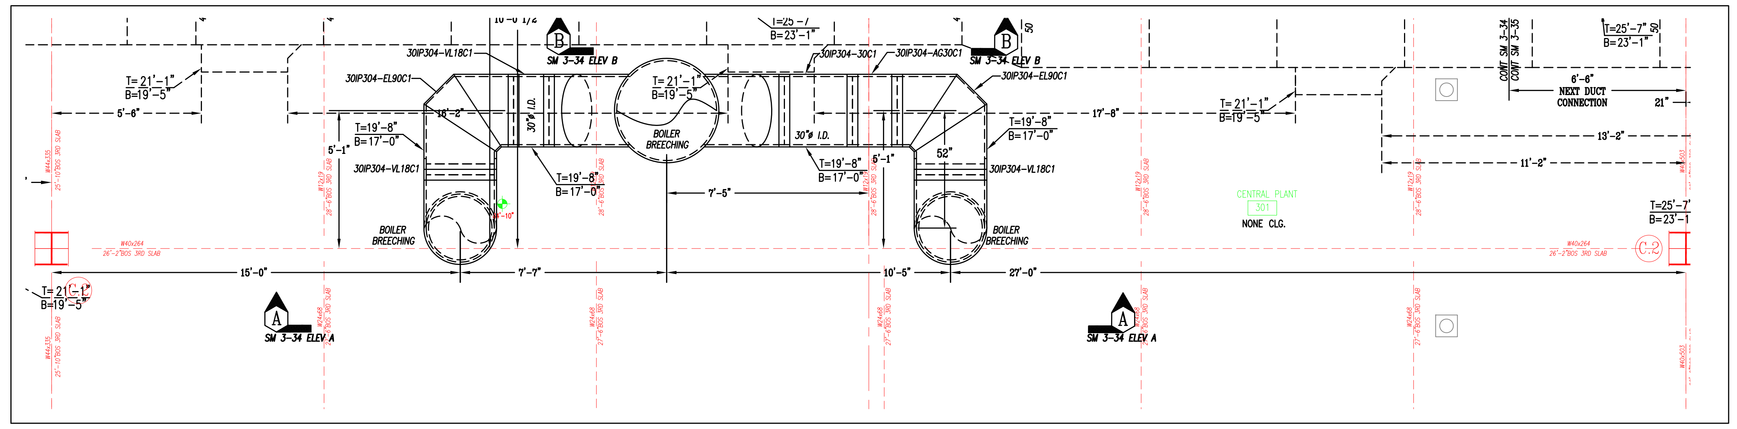

BOILER PLAN

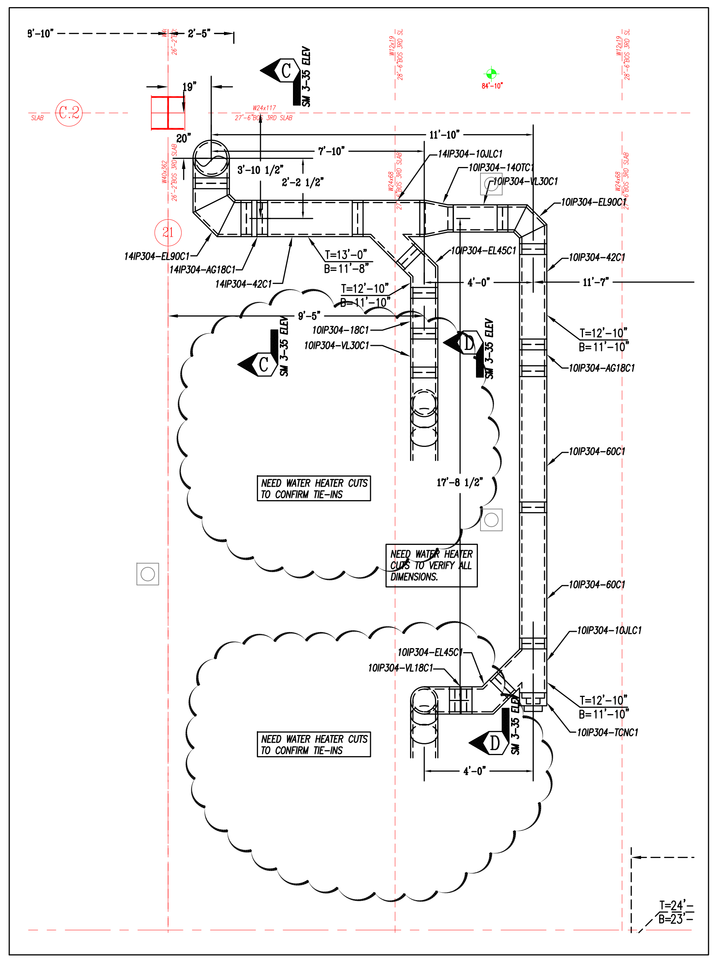

HOT WATER PLAN

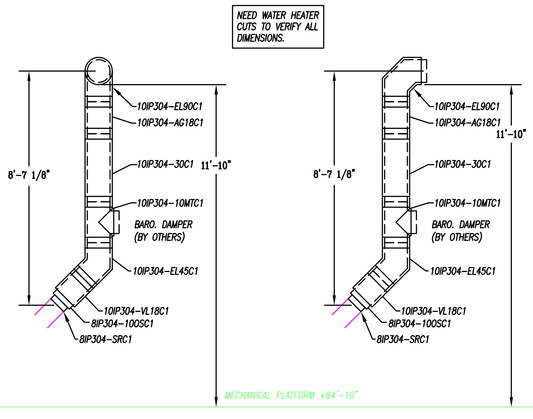

SECTION "D–D"

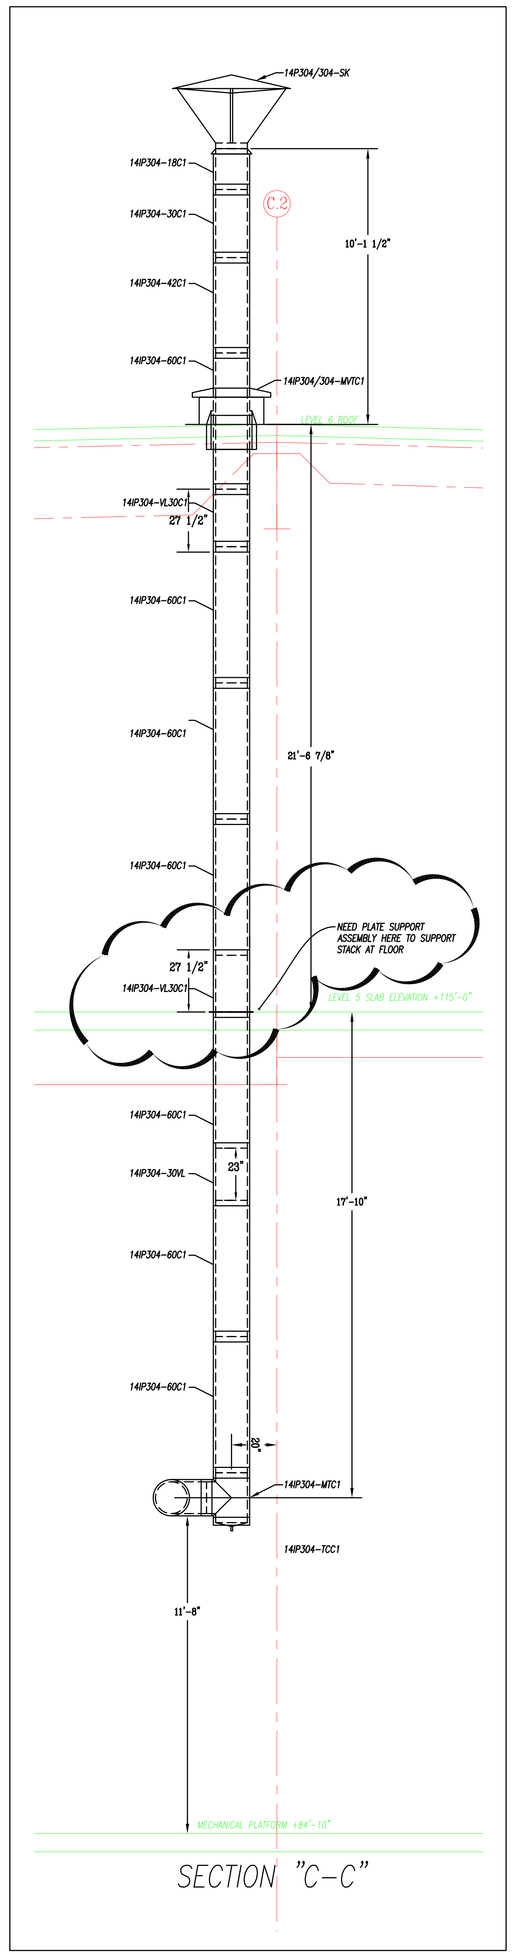

SECTION "C–C"

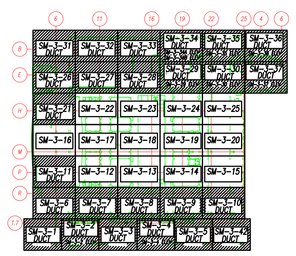

THIRD FLOOR

NOTES:

1. – ALL DUCT TO BE FABRICATED PER SMACNA CONSTRUCTION STANDARDS.
2. – ⇨ = AIR FLOW – GALV. – NO ACOUST. LINING
3. – ⇨ = AIR FLOW – 1" ACOUST. LINING
4. – ⇨ W = AIR FLOW – STAINLESS STEEL
5. – ⇨ ALUM = AIR FLOW – ALUMINUM
6. – ▷ = W.G. CONSTRUCTION OF DUCT
7. – Tx 0'-0" = TOP OF DUCT ABOVE FINISHED FLOOR; Bx 0'-0" = BOTTOM OF DUCT ABOVE FINISHED FLOOR
8. – COORDINATION NOTE – ALLOW 2" ALL AROUND DUCT FOR FLANGE CONNECTIONS AND FOR EXTERNAL INSULATION WHERE REQUIRED.

REV#	DESCRIPTION	DR.	DATE
AB	AS BUILT	BLJ	01-11-11
A	RELEASE	BLJ	09-22-09

RECORD DRAWINGS
The Keating JV

Advantage CONTRACTING INC.
A Minority Owned Business Enterprise
219 W. Hortter Street • Philadelphia, PA 19119
Phone: 215-844-0191 Fax: 215-844-0192
www.advantagecontracts.com

JOB NAME: PA CONVENTION CENTER
EXPANSION AND RENOVATION

TITLE: BOILER PLAN AND ELEVATION
HOT WATER HEATERS PLAN AN ELEVATIONS

REF. DWG. M-239	LOC. COLS		
SCALE 3/8"=1'-0"	CH.	JOB NO. 8520	
DATE 05-13-09	DR. BLJ	DWG. NO. SM 3-34 ELEV A	

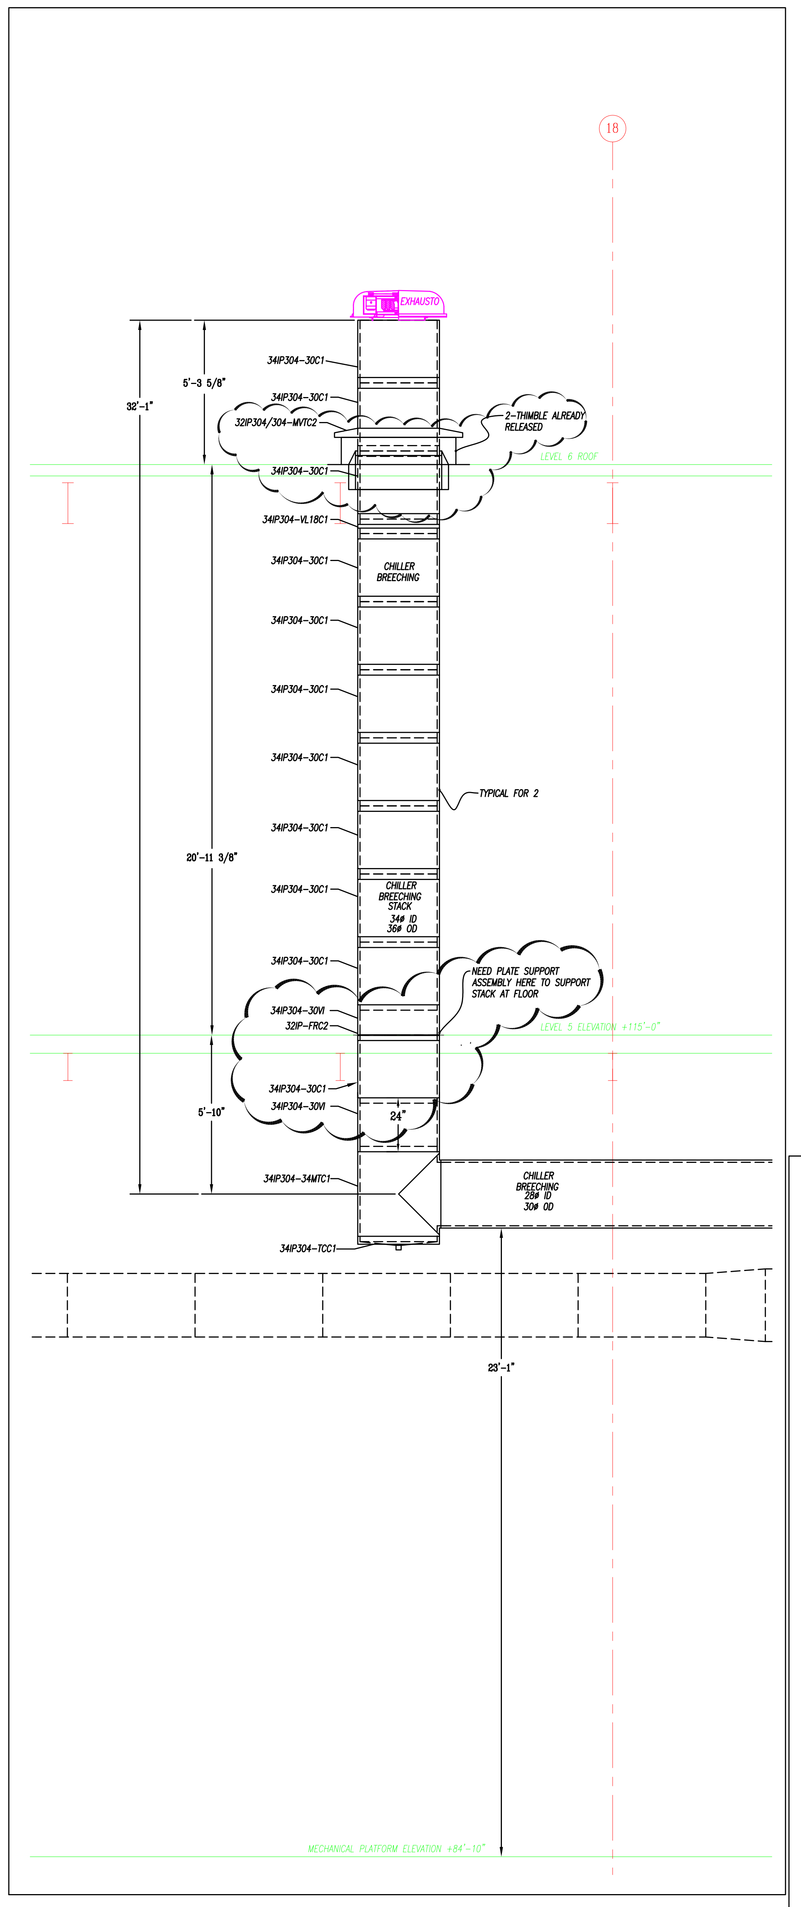

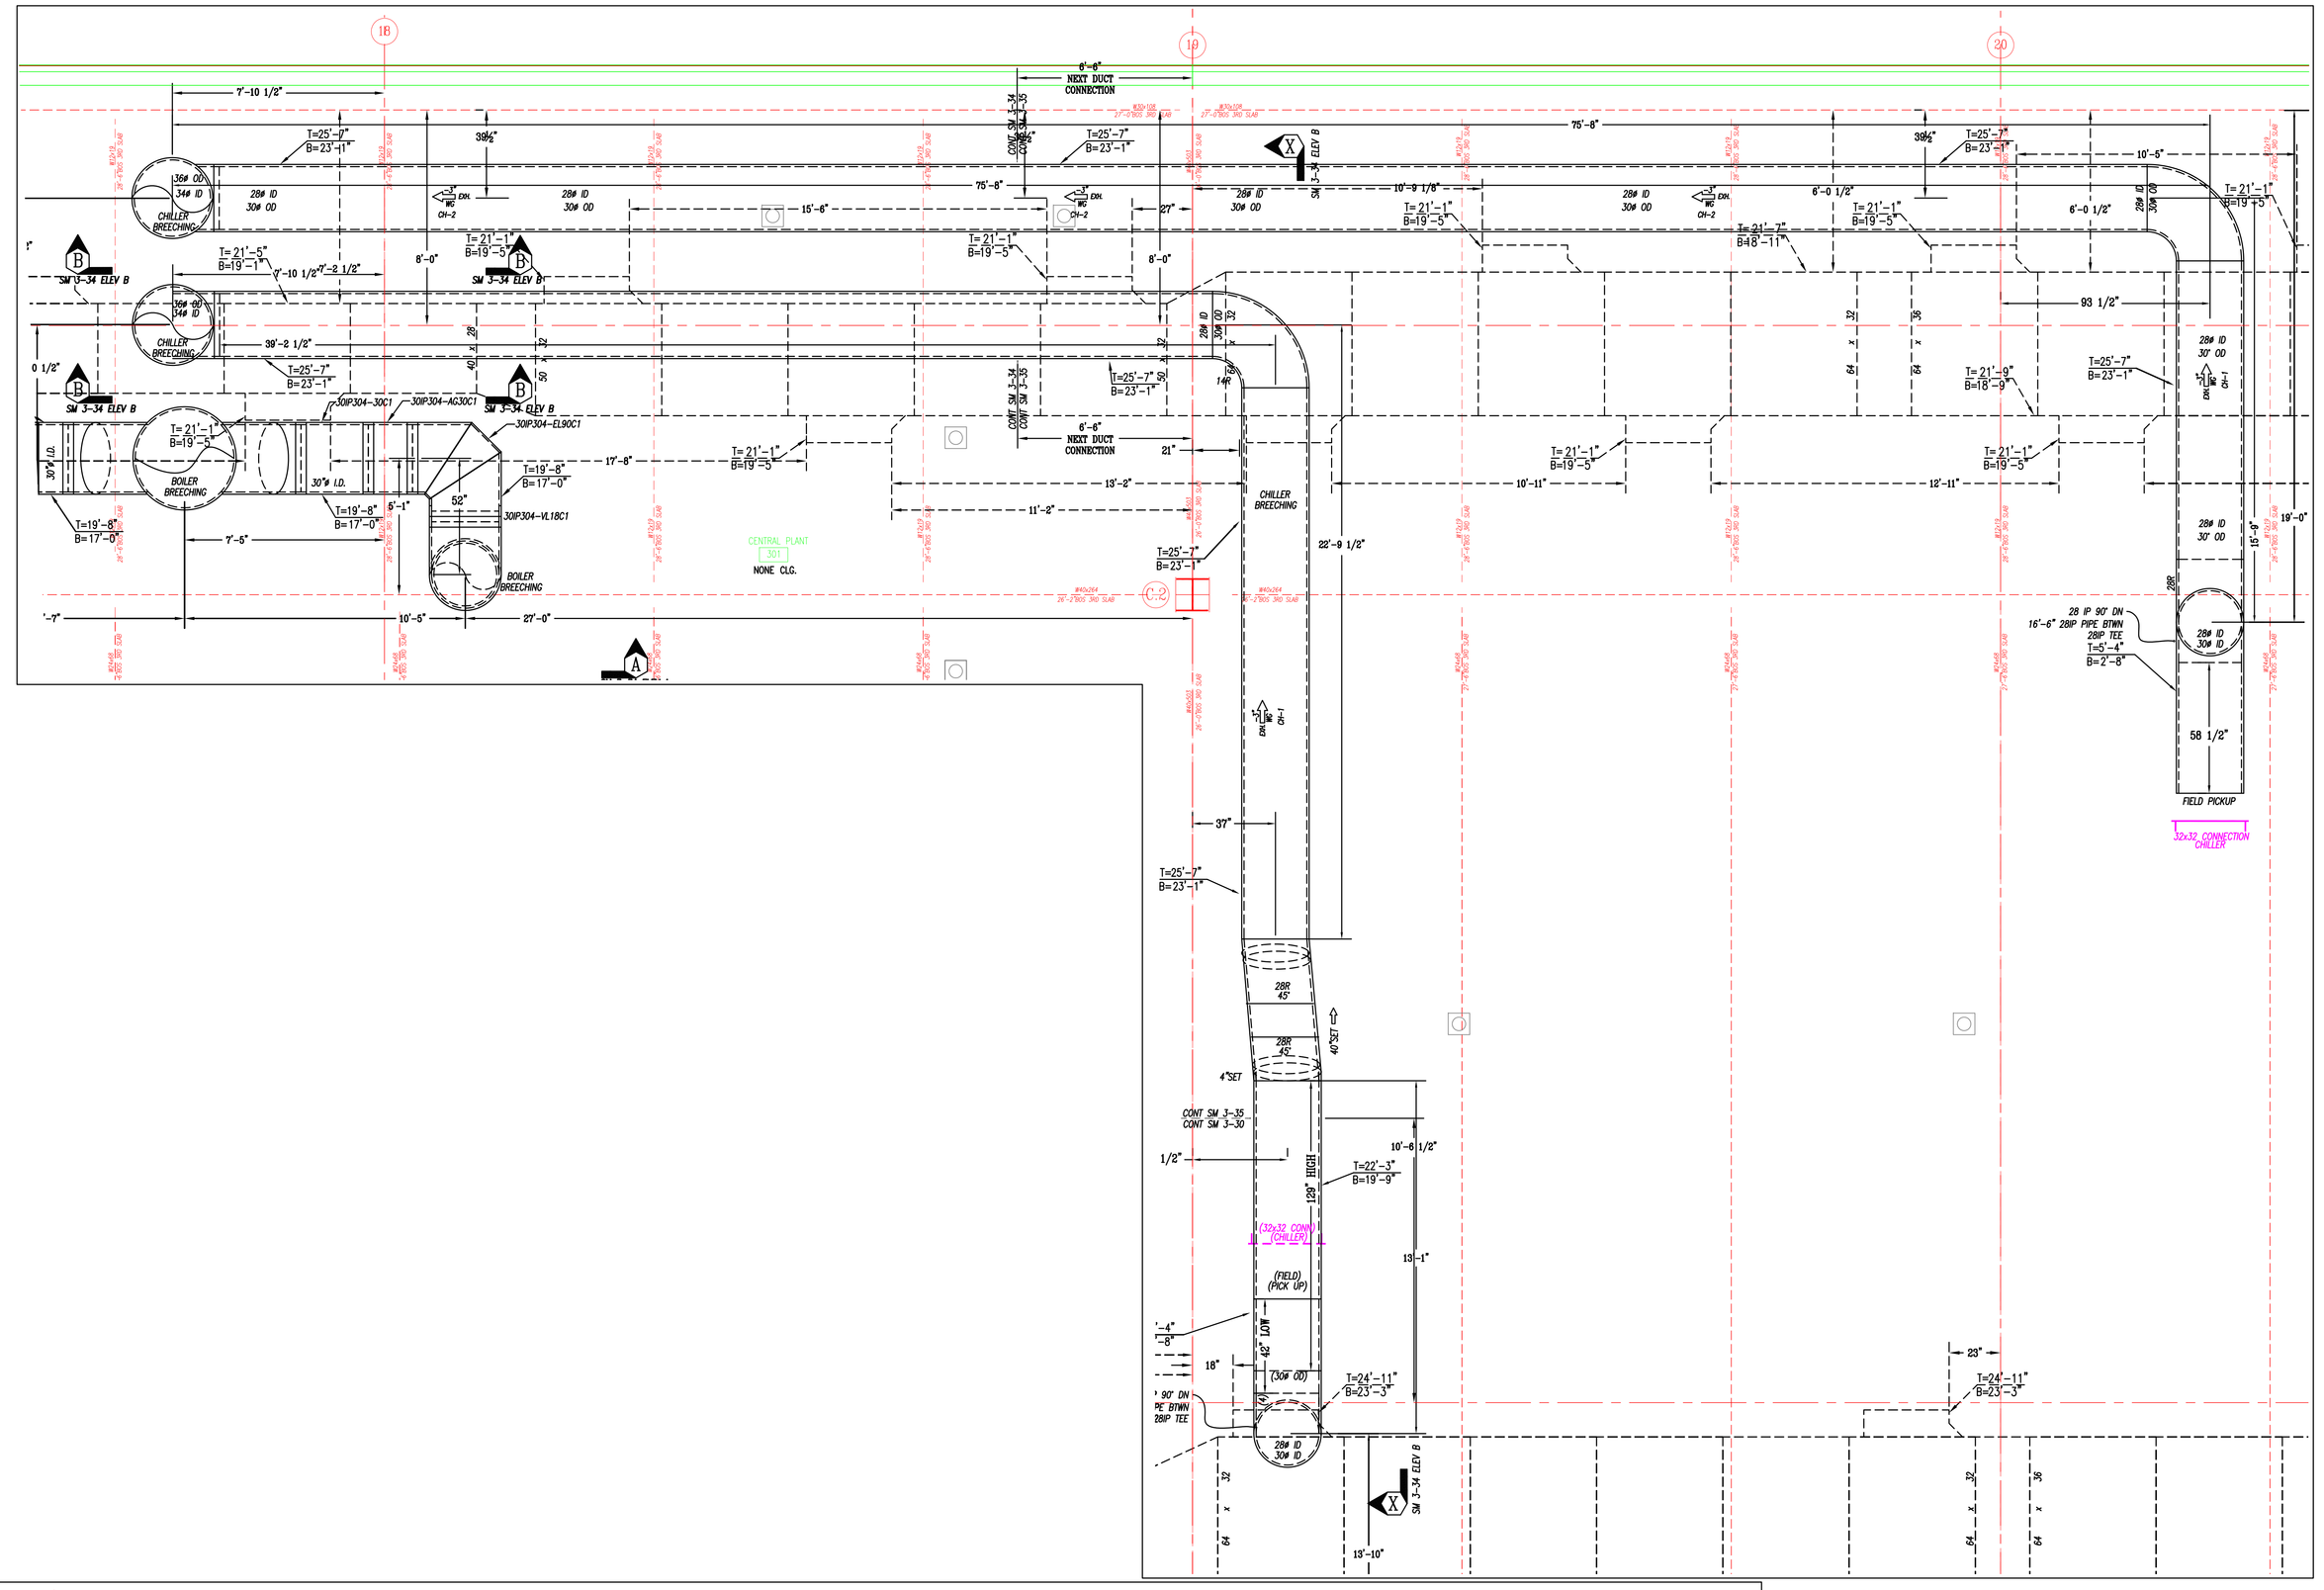

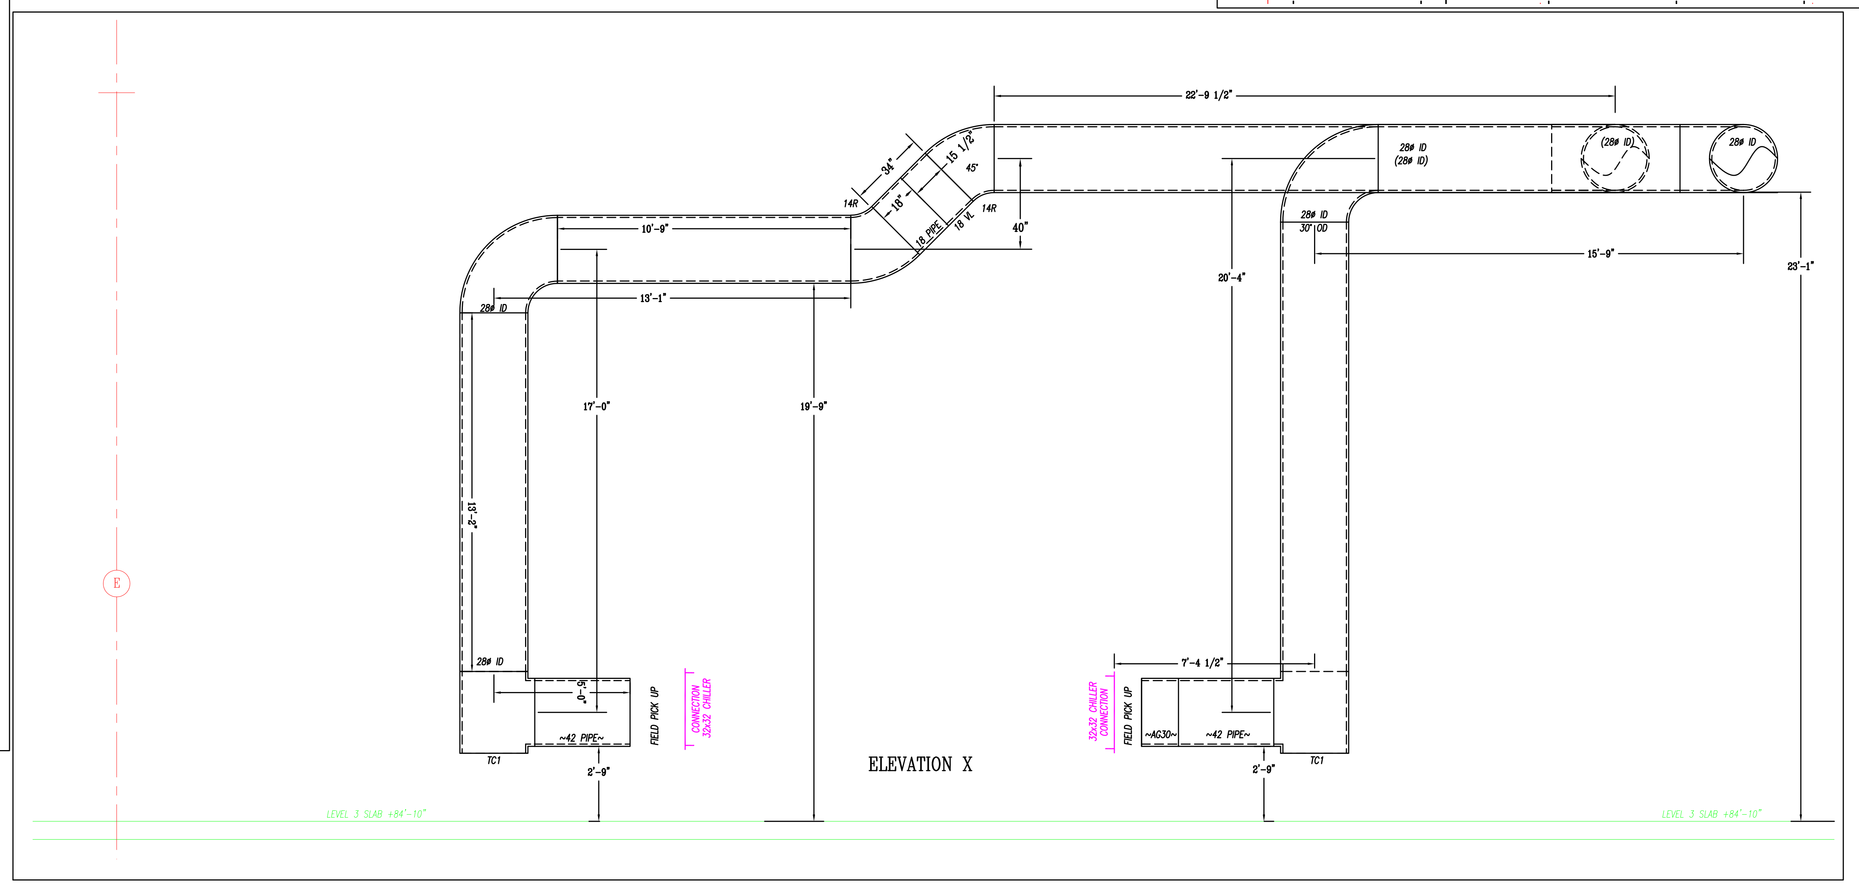

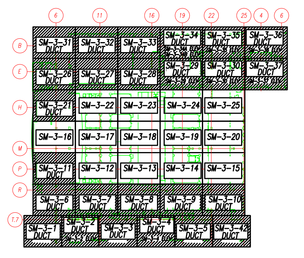

THIRD FLOOR

RECORD DRAWINGS
The Keating JV

NOTES:
1. – ALL DUCT TO BE FABRICATED PER SMACNA CONSTRUCTION STANDARDS.
2. – <=> = AIR FLOW – GALV. – NO ACOUST. LINING
3. – <=> = AIR FLOW –1" ACOUST. LINING
4. – <=> SS = AIR FLOW – STAINLESS STEEL
5. – <=> ALUM = AIR FLOW – ALUMINUM
6. – [▷] = W.G. CONSTRUCTION OF DUCT
7. – T= 0'-0" = TOP OF DUCT ABOVE FINISHED FLOOR; B= 0'-0" = BOTTOM OF DUCT ABOVE FINISHED FLOOR
8. – COORDINATION NOTE – ALLOW 2" ALL AROUND DUCT FOR FLANGE CONNECTIONS AND FOR EXTERNAL INSULATION WHERE REQUIRED.

REV	DESCRIPTION	DR.	DATE
AB	AS BUILT	EG	01-11-11
C	FOR CONSTRUCTION	EG	09-22-09
A	RELEASE	EG	09-22-09

Advantage CONTRACTING INC.
A Minority Owned Business Enterprise
219 W. Hortter Street • Philadelphia, PA 19119
Phone: 215-844-0191 Fax: 215-844-0192
www.advantagecontracts.com

JOB NAME: PA CONVENTION CENTER
EXPANSION AND RENOVATION

TITLE: BOILER BREECHING PLAN AND ELEVATION

REF. DWG. M-233	LDG. COLS.		
SCALE 3/8"=1'-0"	CH.	JOB NO.	8520
DATE 05-13-09	DR. BLJ	DWG. NO.	SM 3-34 ELEV B

SHEET	DESCRIPTION	DR	DATE
A	FOR APPROVAL	BLJ	06-12-09
S	SIGN OFF	BLJ	07-09-09
C	FOR CONSTRUCTION	EG	09-26-09
R1	REVISED PER ORDS	EG	01-28-10
AB	AS BUILT	EG	01-11-11


THIRD FLOOR

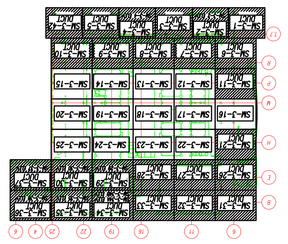

RECORD DRAWINGS
The Keating JV

SCALE: 1/8"=1'-0"	JOB NO. 8520
DATE 05-13-09	DR. BLJ
KEY DWG: M233 M236	CHK. BY
TITLE LEVEL 3 PARTIAL DUCT PLAN	
JOB NAME PA CONVENTION CENTER EXPANSION AND RENOVATION	

Advantage CONTRACTING INC
A Minority Owned Business Enterprise
219 W. Hortter Street • Philadelphia, PA 19119
Phone: 215-844-0191 Fax: 215-844-0192
www.advantagecontracts.com

SHT. NO. M233 SM 3-35

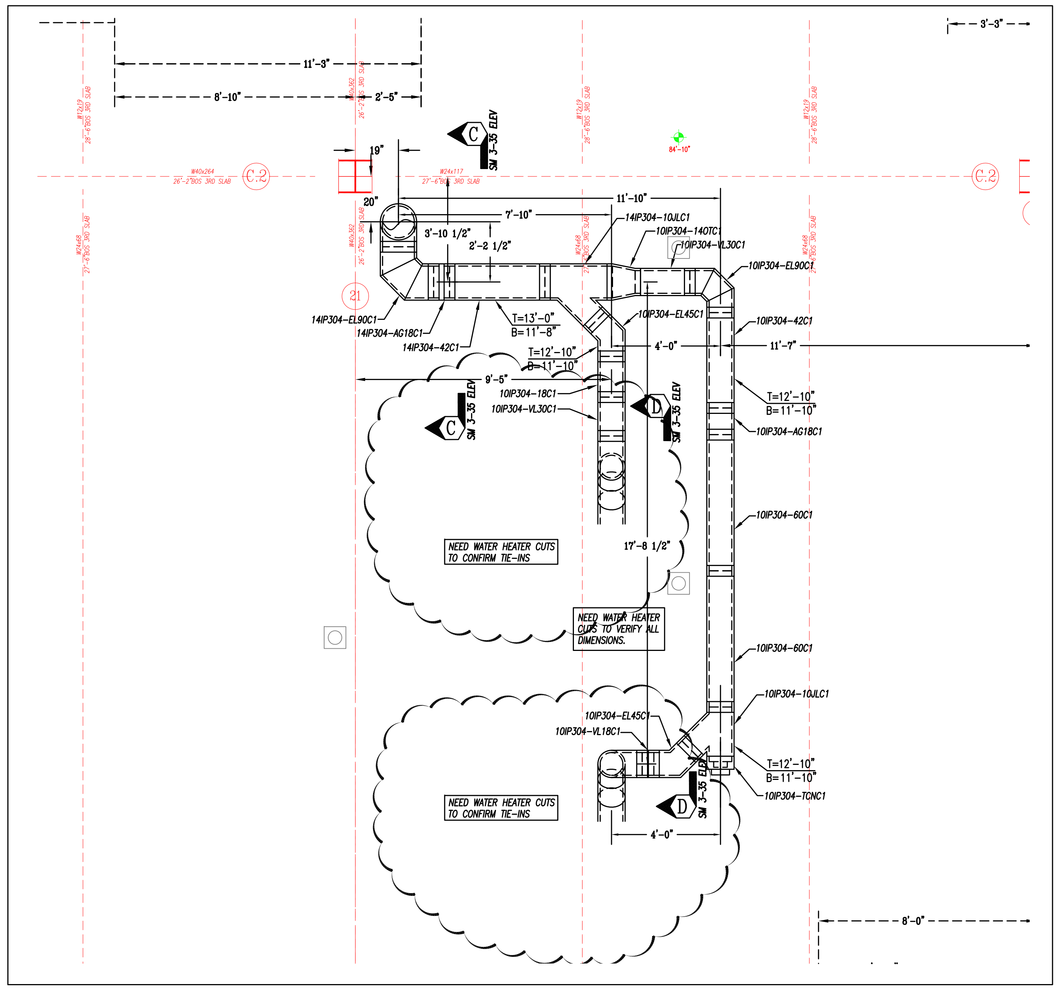

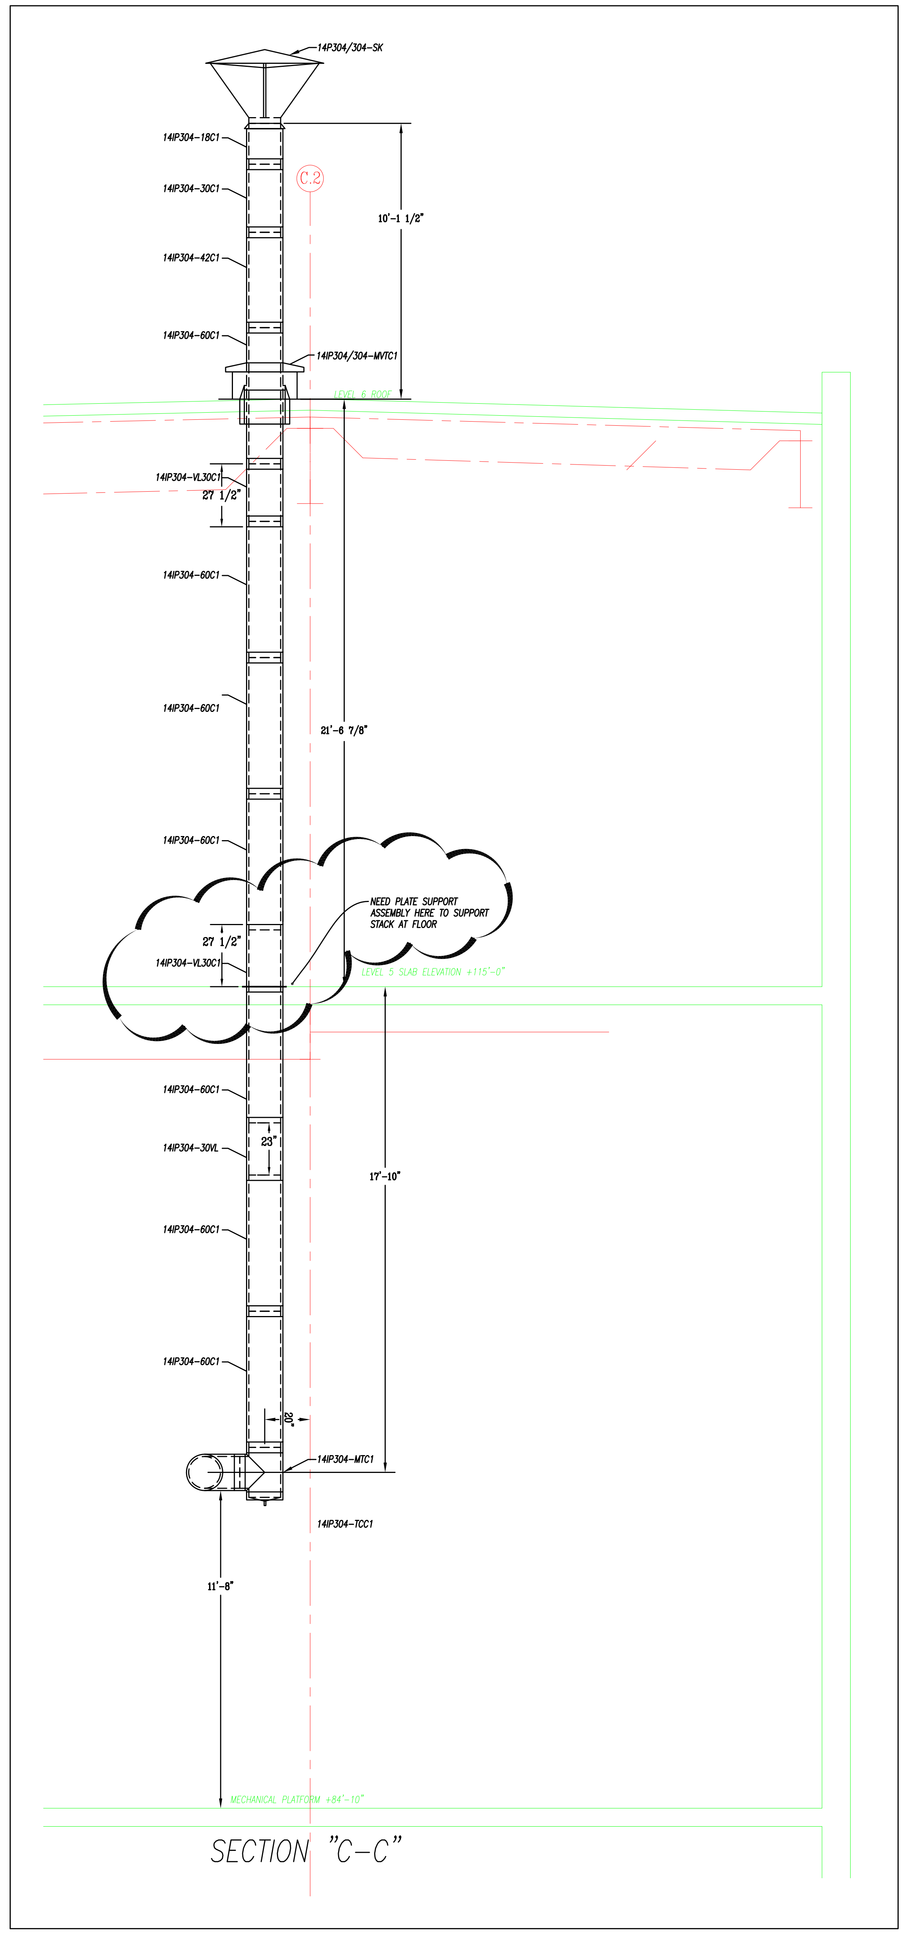

SECTION "C-C"

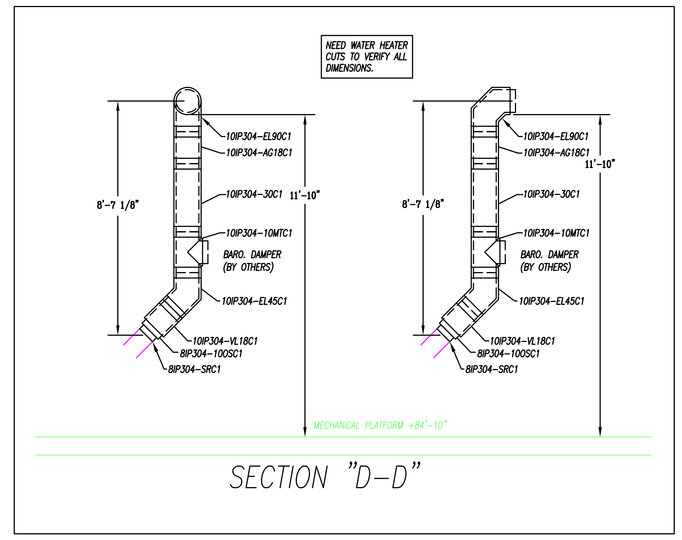

SECTION "D-D"

RECORD DRAWINGS
The Keating JV

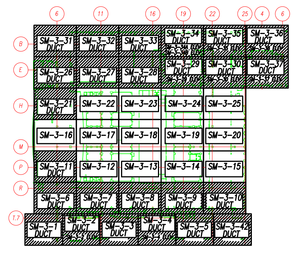

THIRD FLOOR

NOTES:

1. – ALL DUCT TO BE FABRICATED PER SMACNA CONSTRUCTION STANDARDS.
2. – <=> = AIR FLOW – GALV. – NO ACOUST. LINING
3. – <=> = AIR FLOW –1" ACOUST. LINING
4. – <=> IS = AIR FLOW – STAINLESS STEEL
5. – <=> ALUM = AIR FLOW – ALUMINUM
6. – [>] = W.G. CONSTRUCTION OF DUCT
7. – T= 0'-0" = TOP OF DUCT ABOVE FINISHED FLOOR; B= 0'-0" = BOTTOM OF DUCT ABOVE FINISHED FLOOR
8. – COORDINATION NOTE – ALLOW 2" ALL AROUND DUCT FOR FLANGE CONNECTIONS AND FOR EXTERNAL INSULATION WHERE REQUIRED.

REV.	DESCRIPTION	DR.	DATE
AB	AS BUILT	BLJ	01-11-11
A	FOR APPROVAL	BLJ	05-13-09

Advantage CONTRACTING INC.
A Minority Owned Business Enterprise
219 W. Hortter Street • Philadelphia, PA 19119
Phone: 215-844-0191 Fax: 215-844-0192
www.advantagecontracts.com

JOB NAME
PA CONVENTION CENTER
EXPANSION AND RENOVATION

TITLE
WATER HEATER EXHAUST PLAN AND ELEVATION

REF. DWG. M-233	LOC. COLS.		
SCALE 3/8"=1'-0"	CH.	JOB NO.	8520
DATE 05-13-09	DR. BLJ	DWG. NO.	SM 3-35 ELEV

RECORD DRAWINGS
The Keating JV

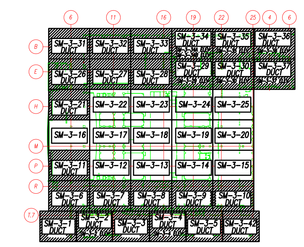

THIRD FLOOR

NOTES:

1. – ALL DUCT TO BE FABRICATED PER SMACNA CONSTRUCTION STANDARDS.
2. – ⇨ = AIR FLOW – GALV. – NO ACOUST. LINING
3. – 1" A/L ⇨ = AIR FLOW – 1" ACOUST. LINING
4. – ⇨ SS = AIR FLOW – STAINLESS STEEL
5. – ⇨ ALUM = AIR FLOW – ALUMINUM
6. – ▷ = W.G. CONSTRUCTION OF DUCT
7. – T= 0'-0 = TOP OF DUCT ABOVE FINISHED FLOOR; B= 0'-0 = BOTTOM OF DUCT ABOVE FINISHED FLOOR
8. – COORDINATION NOTE – ALLOW 2" ALL AROUND DUCT FOR FLANGE CONNECTIONS AND FOR EXTERNAL INSULATION WHERE REQUIRED.

REV	DESCRIPTION	DR.	DATE
AB	AS BUILT	EG	01-11-11
R2	REVISED FOR GRDS	EG	01-28-10
C	FOR CONSTRUCTION	EG	09-24-09
R1	REVISED FOR AHUS	EG	09-10-09
S	SIGN OFF	BLJ	07-09-09
A	FOR APPROVAL	BLJ	05-15-09

Advantage CONTRACTING INC.
A Minority Owned Business Enterprise
219 W. Hortter Street • Philadelphia, PA 19119
Phone: 215-844-0191 Fax: 215-844-0192
www.advantagecontracts.com

JOB NAME
PA CONVENTION CENTER
EXPANSION AND RENOVATION

TITLE
LEVEL 3 PARTIAL DUCT PLAN

REF.DWG.- M236	LOC. COLS.		
SCALE 3/8"=1'-0"	CH.	JOB NO.	8520
DATE 05-15-09	DR. BLJ	DWG. NO.	SM 3-36

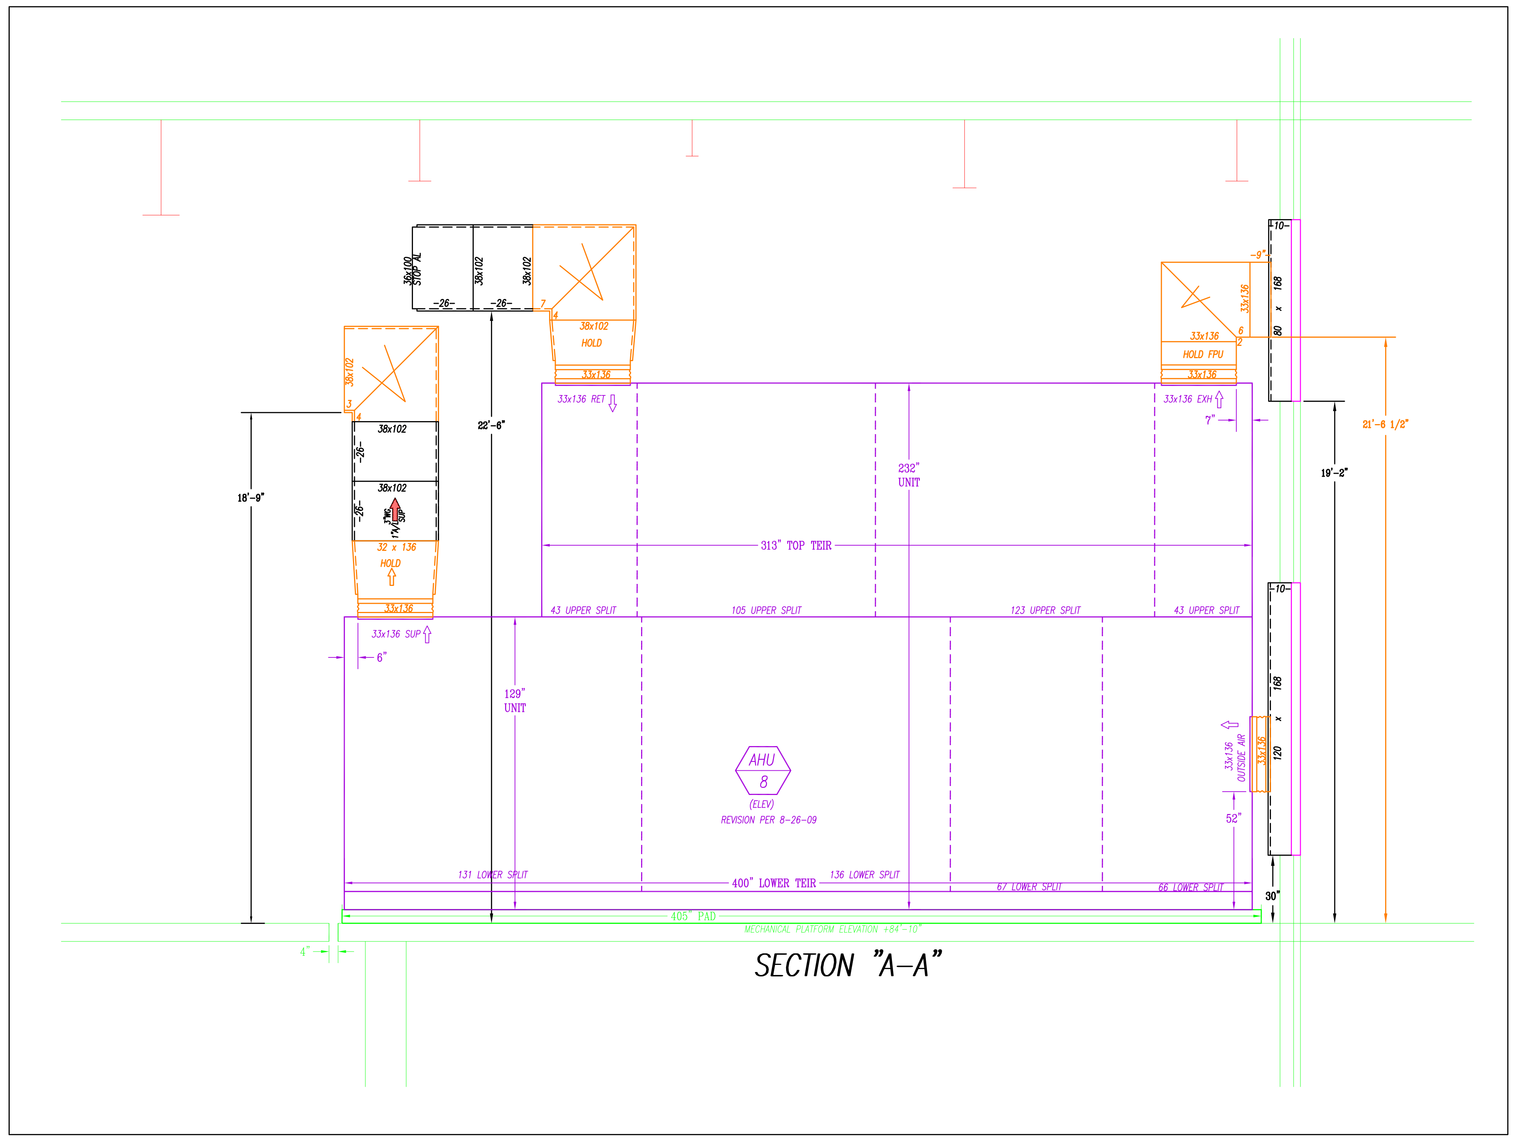

SECTION "A-A"

RECORD DRAWINGS
The Keating JV

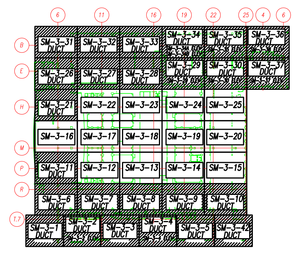

THIRD FLOOR

NOTES:

1. – ALL DUCT TO BE FABRICATED PER SMACNA CONSTRUCTION STANDARDS.
2. – ⟨=⟩ = AIR FLOW – ONLY – NO ACOUST. LINING
3. – ⟨=⟩ 1" = AIR FLOW – 1" ACOUST. LINING
4. – ⟨=⟩ SS = AIR FLOW – STAINLESS STEEL
5. – ⟨=⟩ ALUM = AIR FLOW – ALUMINUM
6. – ▷ = W.G. CONSTRUCTION OF DUCT
7. – 5x 0'-0" = TOP OF DUCT ABOVE FINISHED FLOOR
   5x 0'-0 = BOTTOM OF DUCT ABOVE FINISHED FLOOR
8. – COORDINATION NOTE – ALLOW 2" ALL AROUND DUCT FOR FLANGE CONNECTIONS AND FOR EXTERNAL INSULATION WHERE REQUIRED.

REV'D	DESCRIPTION	DR.	DATE
AB	AS BUILT	EG	01-11-11
C2	FOR CONSTRUCTION UNIT REVS	EG	09-24-09
R1	REVISED FOR AHUS	EG	09-10-09
C	FOR CONSTRUCTION	BLJ	07-28-09
A	FOR APPROVAL	BLJ	05-15-09

Advantage CONTRACTING INC.
A Minority Owned Business Enterprise
219 W. Horttor Street • Philadelphia, PA 19119
Phone: 215-844-0191 Fax: 215-844-0192
www.advantagecontracts.com

JOB NAME
PA CONVENTION CENTER
EXPANSION AND RENOVATION

TITLE
LEVEL 3 DUCT ELEVATIONS

REF.DWG.- SM 3-36	LOC. COLS.		
SCALE 3/8"=1'-0"	CH.	JOB NO.	8520
DATE 05-13-09	DR.	DWG. NO.	SM 3-36 ELEV

OPEN

STEEL FRAMING

T=11'-10"
B=9'-0"

15'-0"x10'-0"
O.A. LOUVER

ACCESS DOOR

T= 25'-7"
B=22'-7"

T=24'-11"
B=23'-3"

25'-8"

18'-0"

21'-3"

16'-4 1/8"

7'-5"

21'-3"x2'-9"Wx4'-2"H PLENUM
VIBRO-ACOUSTIC MODEL
4" DOUBLE WALL PERF CONSTRUCTION

T=17'-7"
B=15'-3"

424" UNIT

270 UNIT

COIL PAD

T=17'-6"
B=15'-10"

CENTRAL PLANT
ROOF
NONE CLG.

AHU 10 (PLAN) REVISION PER 8-17-09

28'-5"

T=14'-11.5"
B=11'-1.5"

240" COIL PAD

441" PAD

240x27 CANVAS

28'-5"x7'-0"Wx3'-10"H PLENUM
VIBRO-ACOUSTIC MODEL
4" DOUBLE WALL PERF CONSTRUCTION

T=17'-6"
B=15'-10"

COIL PAD

247"

T=14'-7.5"
B=11'-11.5"

T=14'-8.5"
B=12'-10.5"

T=14'-2"
B=12'-4"

T=14'-5.5"
B=11'-11.5"

T=12'-6"
B=9'-10"

T=12'-5"
B=9'-11"

T=11'-5"
B=9'-8"

T=39'-2"
B=36'-2"

30'-0" x 3'-0"

6x6 TUBE STEEL

REWORK 6x8 TUBE STEEL

TRUSS T3

TRUSS T3 BOTTOM CHORD

WT6x11 BRACE

WT6x11 BRACE

HOR. LIP CHANNEL

VERT. LIP CHANNEL

DIAG. BRACE

CONT ON SM 4-37

DAMPER REMOVED RTI-38

DAMPER REMOVED RTI-39

DAMPER REMOVED RTI-40

LOUV. REMOVED RTI-41

PICKED OFF SM-36-39

PICKED OFF SM-36-40

PICKED OFF SM-36-41

PICKED OFF SM-36-42

REWORK 6x8 TUBE STEEL

REWORK 6x8 TUBE STEEL

LV-28

LV-28

LV 28

37B

ON SM 3-37 ELEV

ON SM 1-37 ELEV

ON SM 1-37 ELEV

ON SM 3-37 ELEV

TD 6.5"

TD 8.5"

SD

C2

THIRD FLOOR

NOTES:

1. - ALL DUCT TO BE FABRICATED PER SMACNA CONSTRUCTION STANDARDS.
2. - =▭= = AIR FLOW - GALV. - NO ACOUST. LINING
3. - =▭= = AIR FLOW -1" ACOUST. LINING
4. - =▭= = AIR FLOW - STAINLESS STEEL
5. - =▭= = AIR FLOW - ALUMINUM
6. - |▷ = W.G. CONSTRUCTION OF DUCT
7. - T= 0'-0" = TOP OF DUCT ABOVE FINISHED FLOOR; B= 0'-0" = BOTTOM OF DUCT ABOVE FINISHED FLOOR
8. - COORDINATION NOTE - ALLOW 1" ALL AROUND DUCT FOR FLANGE CONNECTIONS AND FOR EXTERNAL INSULATION WHERE REQUIRED.

REV.	DESCRIPTION	DR.	DATE
AB	AS BUILT	EG	01-11-11
R2	REVISED FOR GRDS	EG	01-28-10
C2	REVISED FOR PLENUM AHU-10	EG	11-10-09
C	FOR CONSTRUCTION	EG	09-22-09
R1	REVISED FOR AHUS	EG	09-10-09
S	SIGN OFF	BLJ	07-09-09
A	FOR APPROVAL	BLJ	05-15-09

RECORD DRAWINGS
The Keating JV

Advantage CONTRACTING INC
A Minority Owned Business Enterprise
219 W. Hortter Street • Philadelphia, PA 19119
Phone: 215-844-0191 Fax: 215-844-0192
www.advantagecontracts.com

JOB NAME: PA CONVENTION CENTER
EXPANSION AND RENOVATION

TITLE: LEVEL 3 PARTIAL DUCT PLAN

REF.DWG.- M236	LOC. COILS:		
SCALE 3/8"=1'-0"	CH.	JOB NO.	8520
DATE 05-13-09	DR.	DWG. NO.	SM 3-37

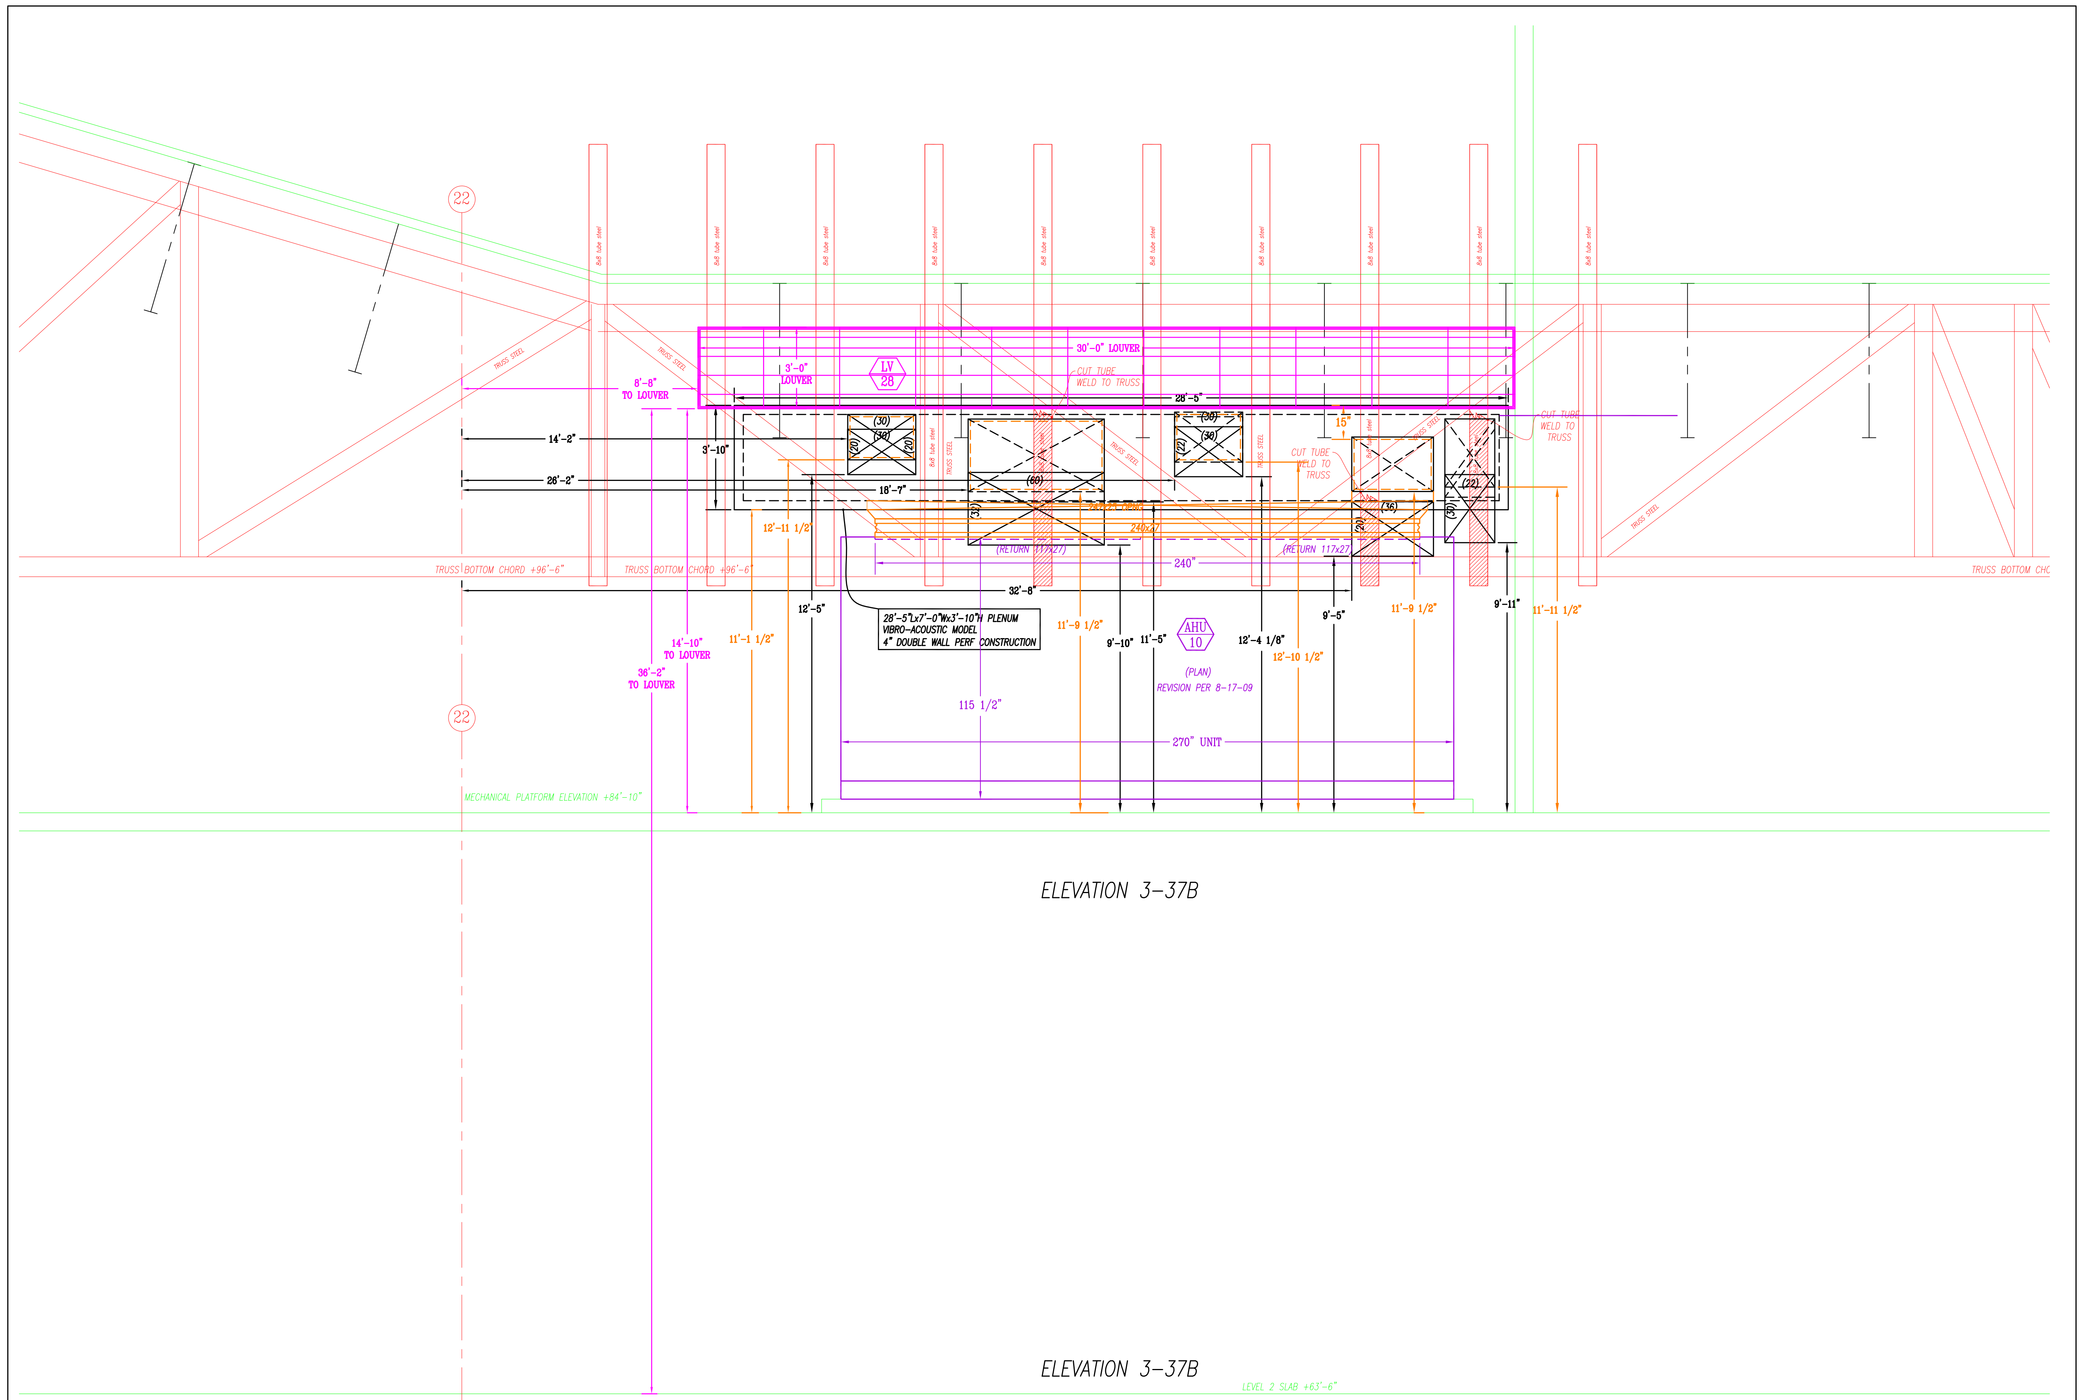

ELEVATION 3–37B

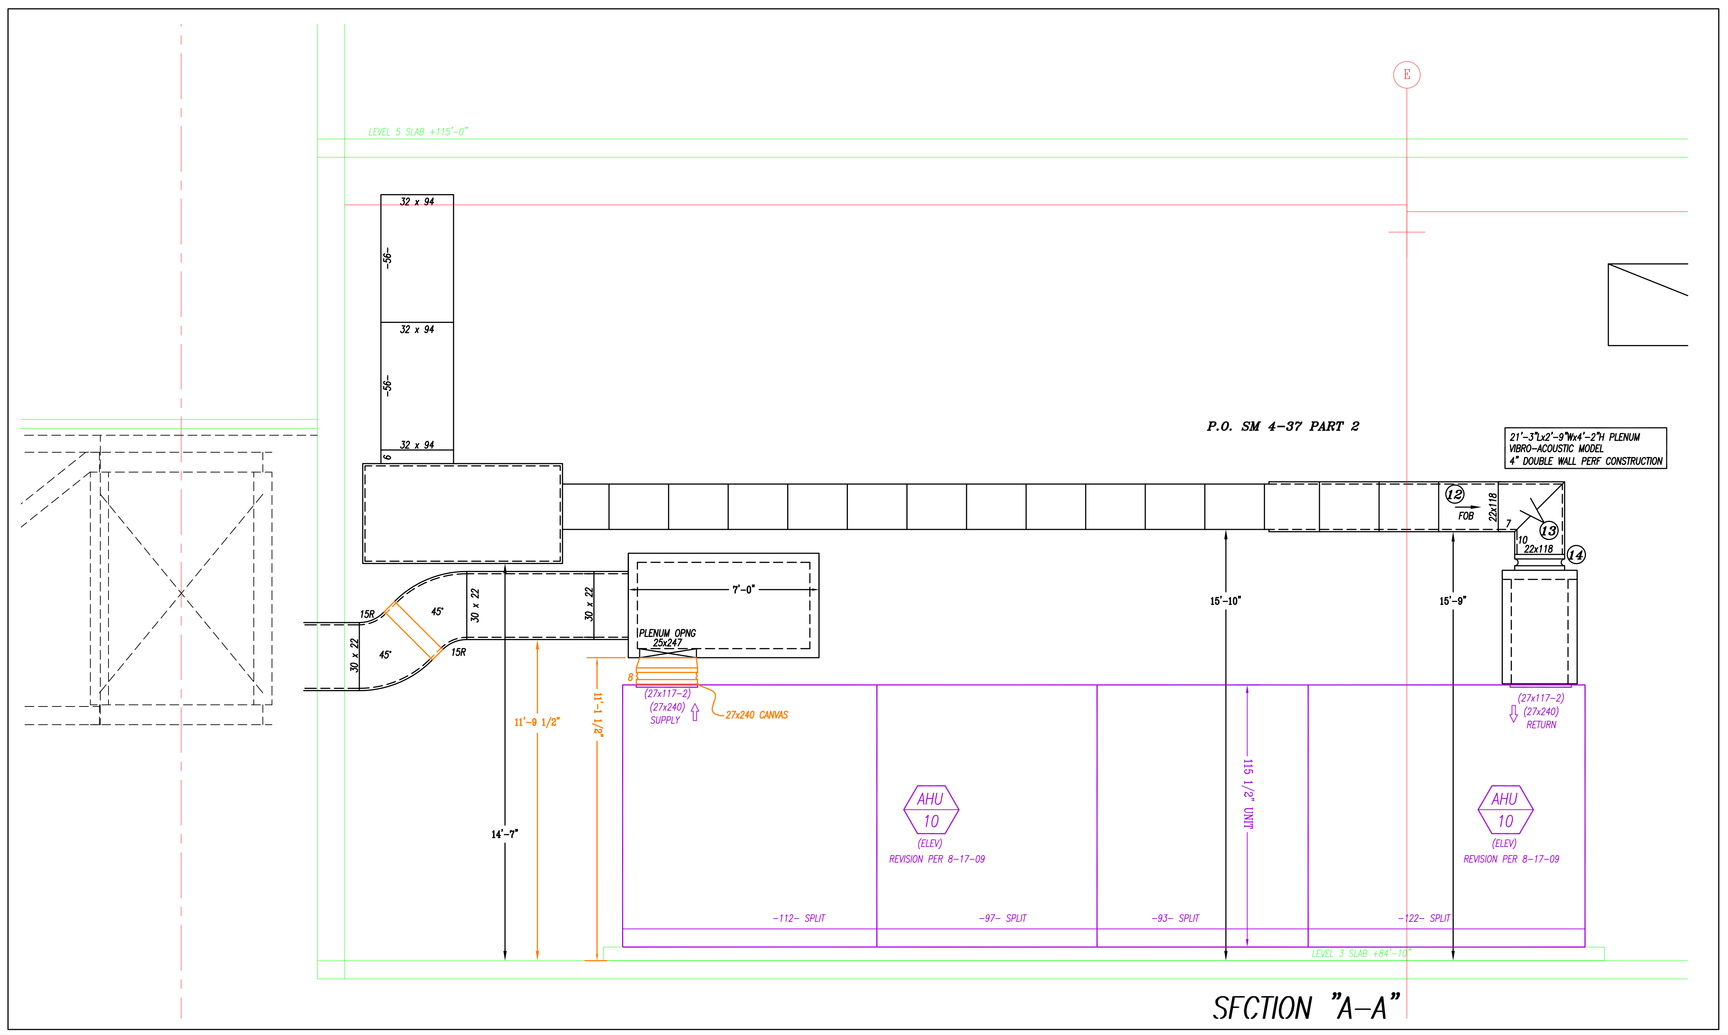

SFCTION "A–A"

RECORD DRAWINGS
The Keating JV

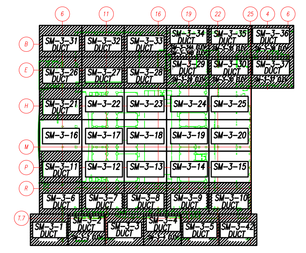

THIRD FLOOR

NOTES:

1. – ALL DUCT TO BE FABRICATED PER SMACNA CONSTRUCTION STANDARDS.
2. – <▭> = AIR FLOW – GALV. – NO ACOUST. LINING
3. – <▭▭> = AIR FLOW –1" ACOUST. LINING
4. – <▭≡▭> = AIR FLOW – STAINLESS STEEL
5. – <▭> ALUM = AIR FLOW – ALUMINUM
6. – [▷] = W.G. CONSTRUCTION OF DUCT
7. – 5'-0" = TOP OF DUCT ABOVE FINISHED FLOOR; 5'-0" = BOTTOM OF DUCT ABOVE FINISHED FLOOR
8. – COORDINATION NOTE – ALLOW 2" ALL AROUND DUCT FOR FLANGE CONNECTIONS AND FOR EXTERNAL INSULATION WHERE REQUIRED.

REV.	DESCRIPTION	BY.	DATE
AB	AS BUILT	EG	01-11-11
C2	FOR CONSTRUCTION	EG	09-24-09
R2	REVISED FOR AHUS	EG	09-10-09
R1	REVISED FOR TUBE STEEL	EG	07-30-09
C	FOR CONSTRUCTION	EG	07-28-09
A	FOR APPROVAL	EG	05-04-09

Advantage CONTRACTING INC.
A Minority Owned Business Enterprise
219 W. Horttor Street • Philadelphia, PA 19119
Phone: 215-844-0191 Fax: 215-844-0192
www.advantagecontracts.com

JOB NAME: PA CONVENTION CENTER
EXPANSION AND RENOVATION

TITLE: LEVEL 3 DUCT ELEVATIONS

REF. DWG.- SM 3-37	LOC. COLS.		
SCALE 3/8"=1'-0"	CH.	JOB NO.	8520
DATE 05-04-09	BY. EG	DWG. NO.	SM 3-37 ELEV

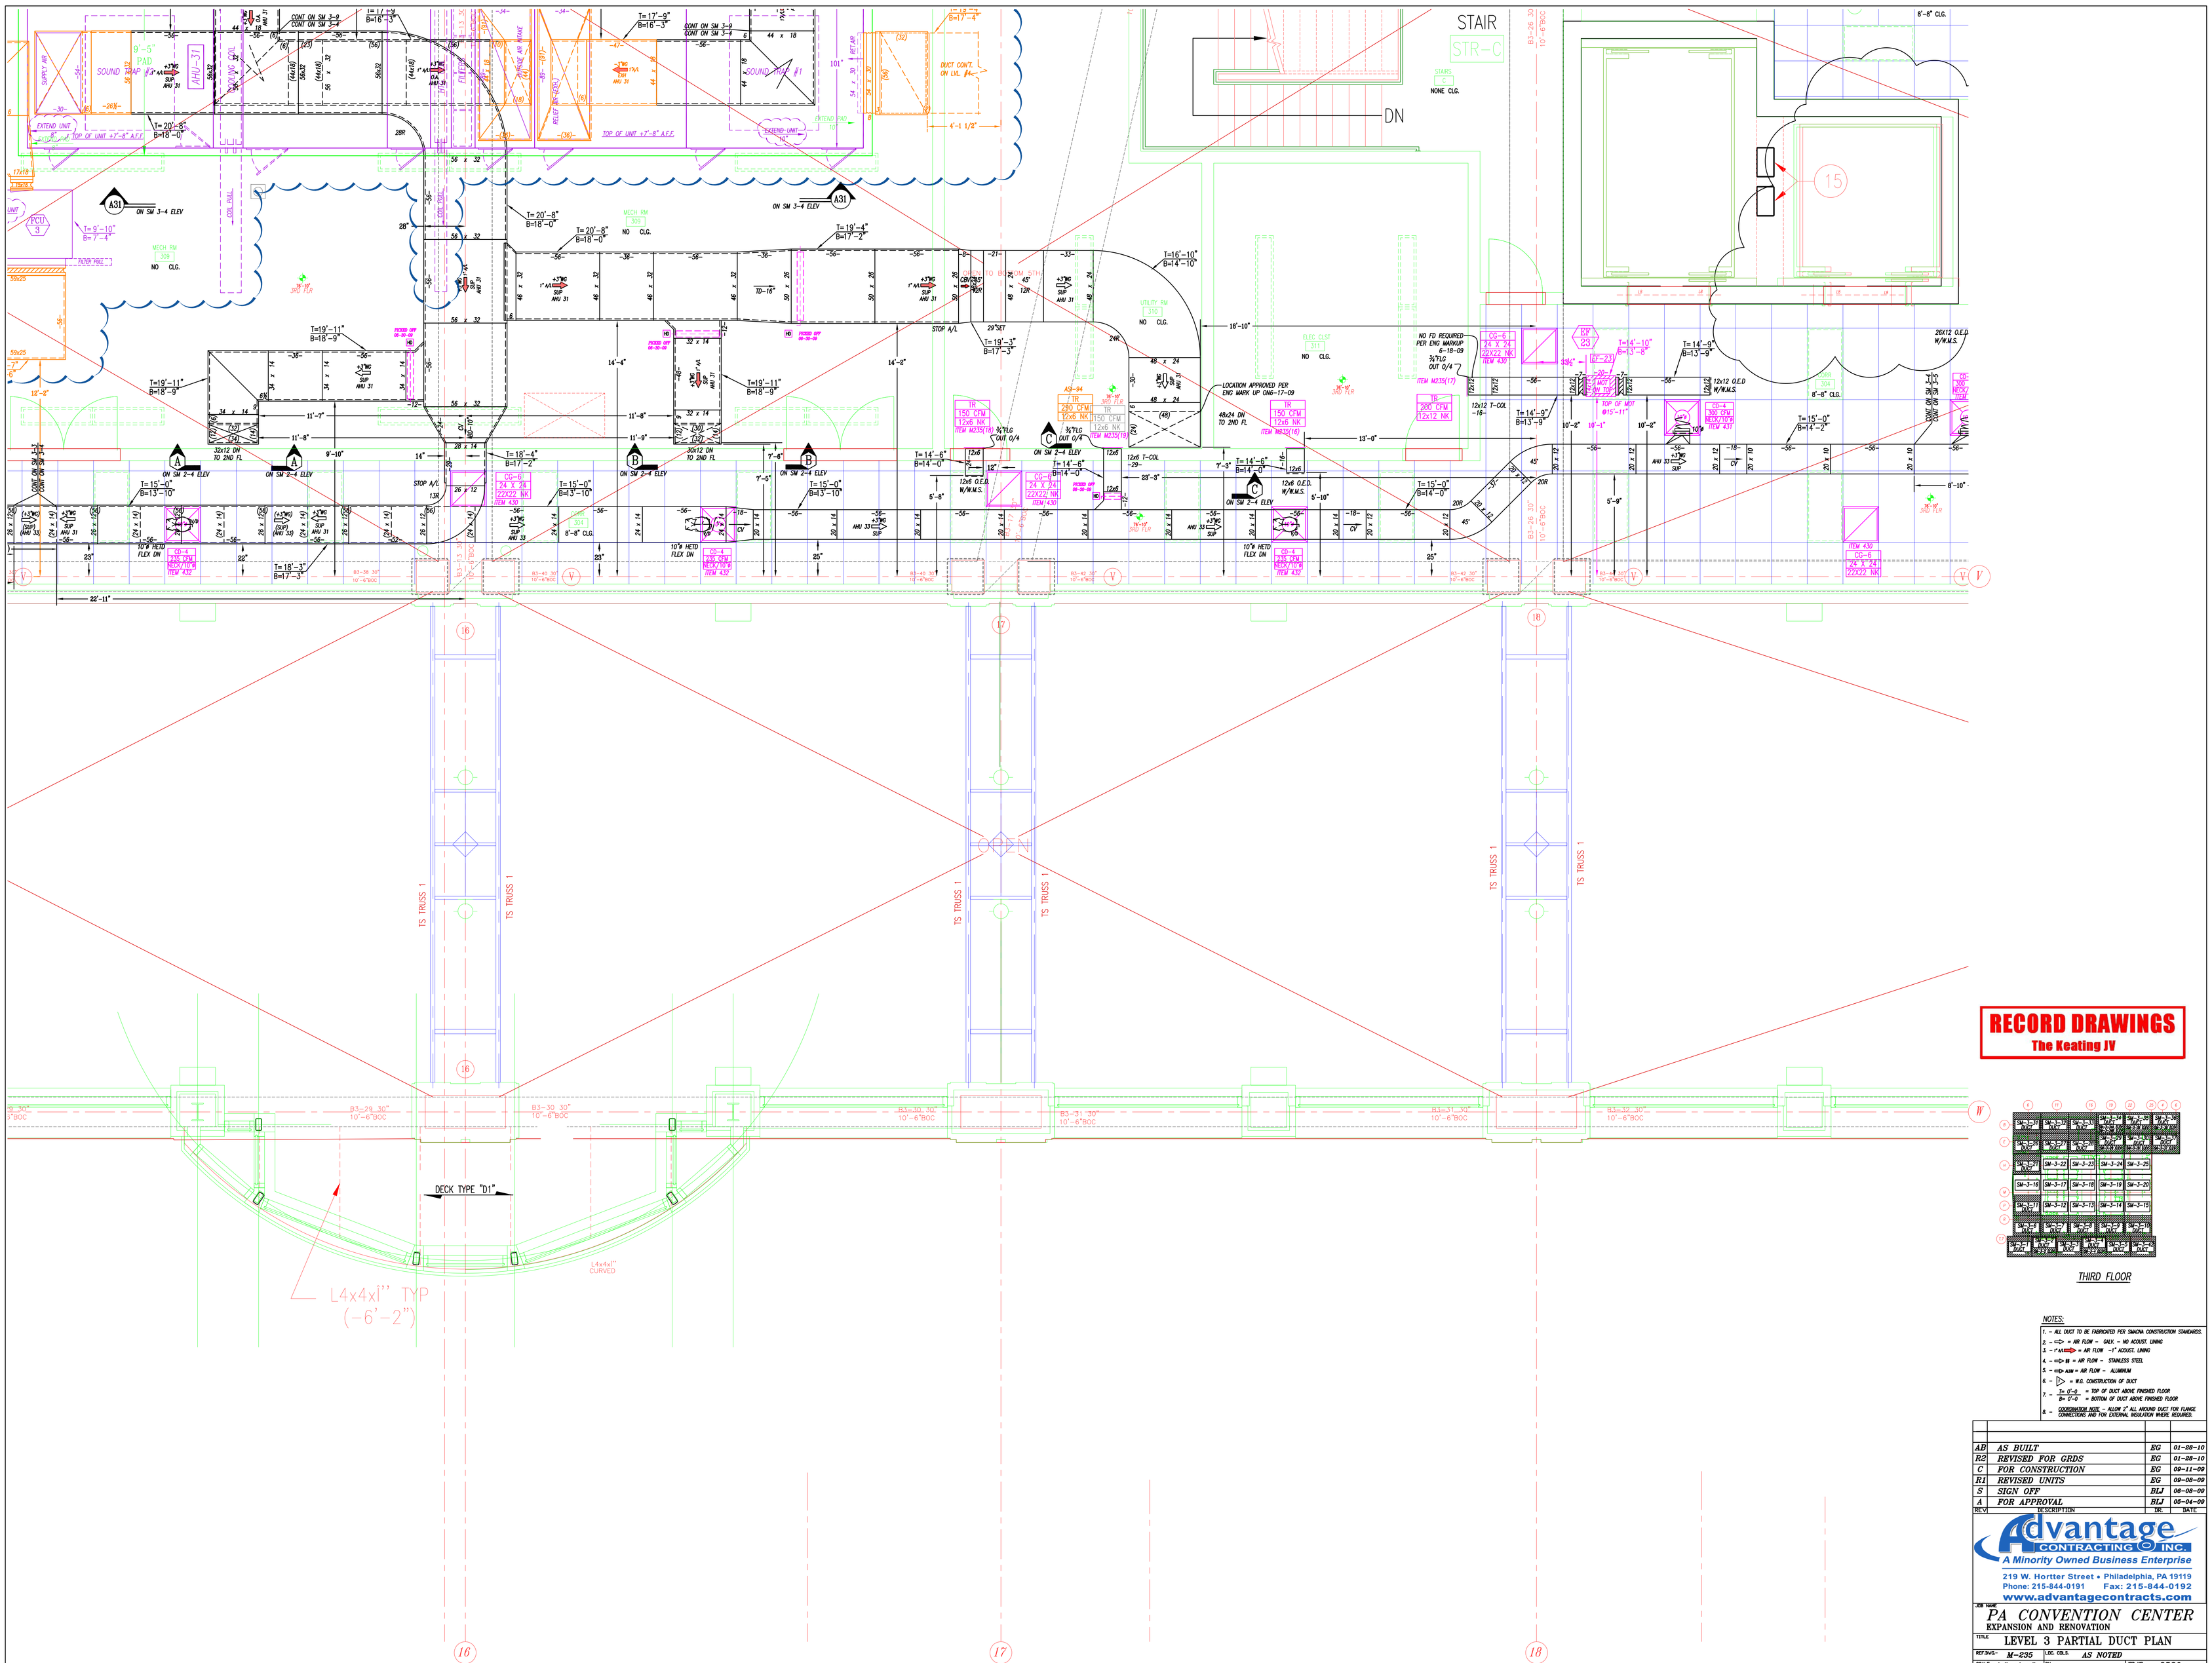

RECORD DRAWINGS
The Keating JV

THIRD FLOOR

NOTES:

1. – ALL DUCT TO BE FABRICATED PER SMACNA CONSTRUCTION STANDARDS.
2. – ⇨ = AIR FLOW – GALV. – NO ACOUST. LINING
3. – ⇨ = AIR FLOW – 1" ACOUST. LINING
4. – ⇨ = AIR FLOW – STAINLESS STEEL
5. – ⇨ = AIR FLOW – ALUMINUM
6. – ▷ = W.G. CONSTRUCTION OF DUCT
7. – T= 0'-0" = TOP OF DUCT ABOVE FINISHED FLOOR; B= 0'-0" = BOTTOM OF DUCT ABOVE FINISHED FLOOR
8. – COORDINATION NOTE – ALLOW 2" ALL AROUND DUCT FOR FLANGE CONNECTIONS AND FOR EXTERNAL INSULATION WHERE REQUIRED.

REV.	DESCRIPTION	DR.	DATE
AB	AS BUILT	EG	01-28-10
R2	REVISED FOR GRDS	EG	01-28-10
C	FOR CONSTRUCTION	EG	09-11-09
R1	REVISED UNITS	EG	09-08-09
S	SIGN OFF	BLJ	06-08-09
A	FOR APPROVAL	BLJ	05-04-09

Advantage CONTRACTING INC.
A Minority Owned Business Enterprise
219 W. Hortter Street • Philadelphia, PA 19119
Phone: 215-844-0191 Fax: 215-844-0192
www.advantagecontracts.com

JOB NAME: PA CONVENTION CENTER
EXPANSION AND RENOVATION

TITLE: LEVEL 3 PARTIAL DUCT PLAN

REF.DWG.-	M-235	LDD. COLS.	AS NOTED
SCALE	3/8"=1'-0"	CH.	JOB NO. 8520
DATE	05-04-09	DR. BLJ	DWG. NO. SM 3-4

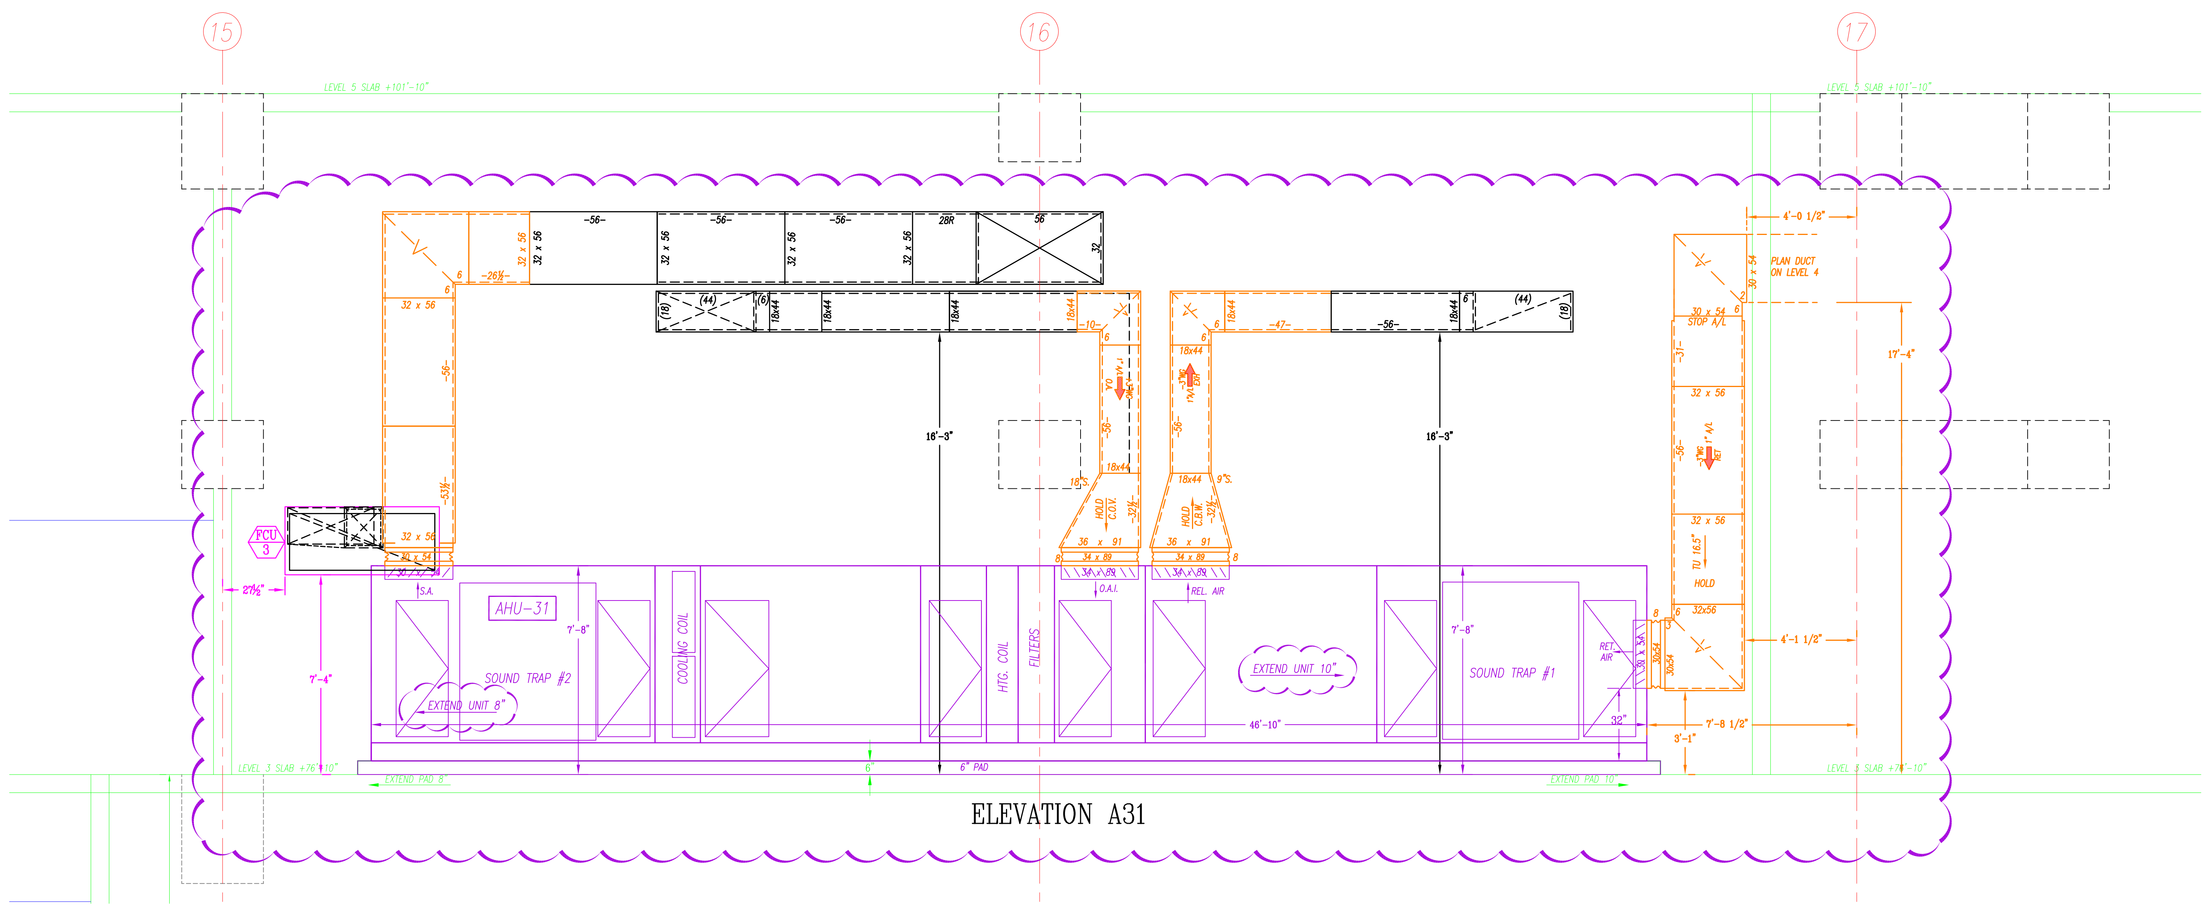

ELEVATION A31

RECORD DRAWINGS
The Keating JV

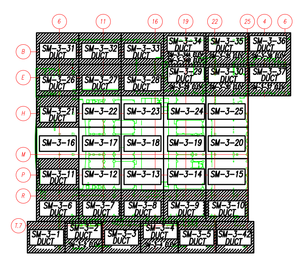

THIRD FLOOR

NOTES:

1. – ALL DUCT TO BE FABRICATED PER SMACNA CONSTRUCTION STANDARDS.
2. – <=> = AIR FLOW – GALV. – NO ACOUST. LINING
3. – <=> = AIR FLOW –1" ACOUST. LINING
4. – <=> SS = AIR FLOW – STAINLESS STEEL
5. – <=> ALUM = AIR FLOW – ALUMINUM
6. – ▷ = W.G. CONSTRUCTION OF DUCT.
7. – 1= 10'-0 = TOP OF DUCT ABOVE FINISHED FLOOR
   B= 8'-0 = BOTTOM OF DUCT ABOVE FINISHED FLOOR
8. – COORDINATION NOTE – ALLOW 2" ALL AROUND DUCT FOR FLANGE CONNECTIONS AND FOR EXTERNAL INSULATION WHERE REQUIRED.

REV.	DESCRIPTION	DR.	DATE
AB	AS BUILT	EG	01-11-11
C	FOR CONSTRUCTION	EG	09-21-09
R1	REVISED UNITS	EG	09-08-09
A	FOR APPROVAL	BLJ	05-04-09

Advantage CONTRACTING INC.
A Minority Owned Business Enterprise
219 W. Hortter Street • Philadelphia, PA 19119
Phone: 215-844-0191 Fax: 215-844-0192
www.advantagecontracts.com

JOB NAME
PA CONVENTION CENTER
EXPANSION AND RENOVATION

TITLE
LEVEL 3 DUCT ELEVATIONS

KEY DWG.	SM 3-4	LOC. COLS.	AS NOTED
SCALE	3/8"=1'-0"	CK.	JOB NO. 8520
DATE	05-04-09	DR. BLJ	DWG. NO. SM 3-4 ELEV

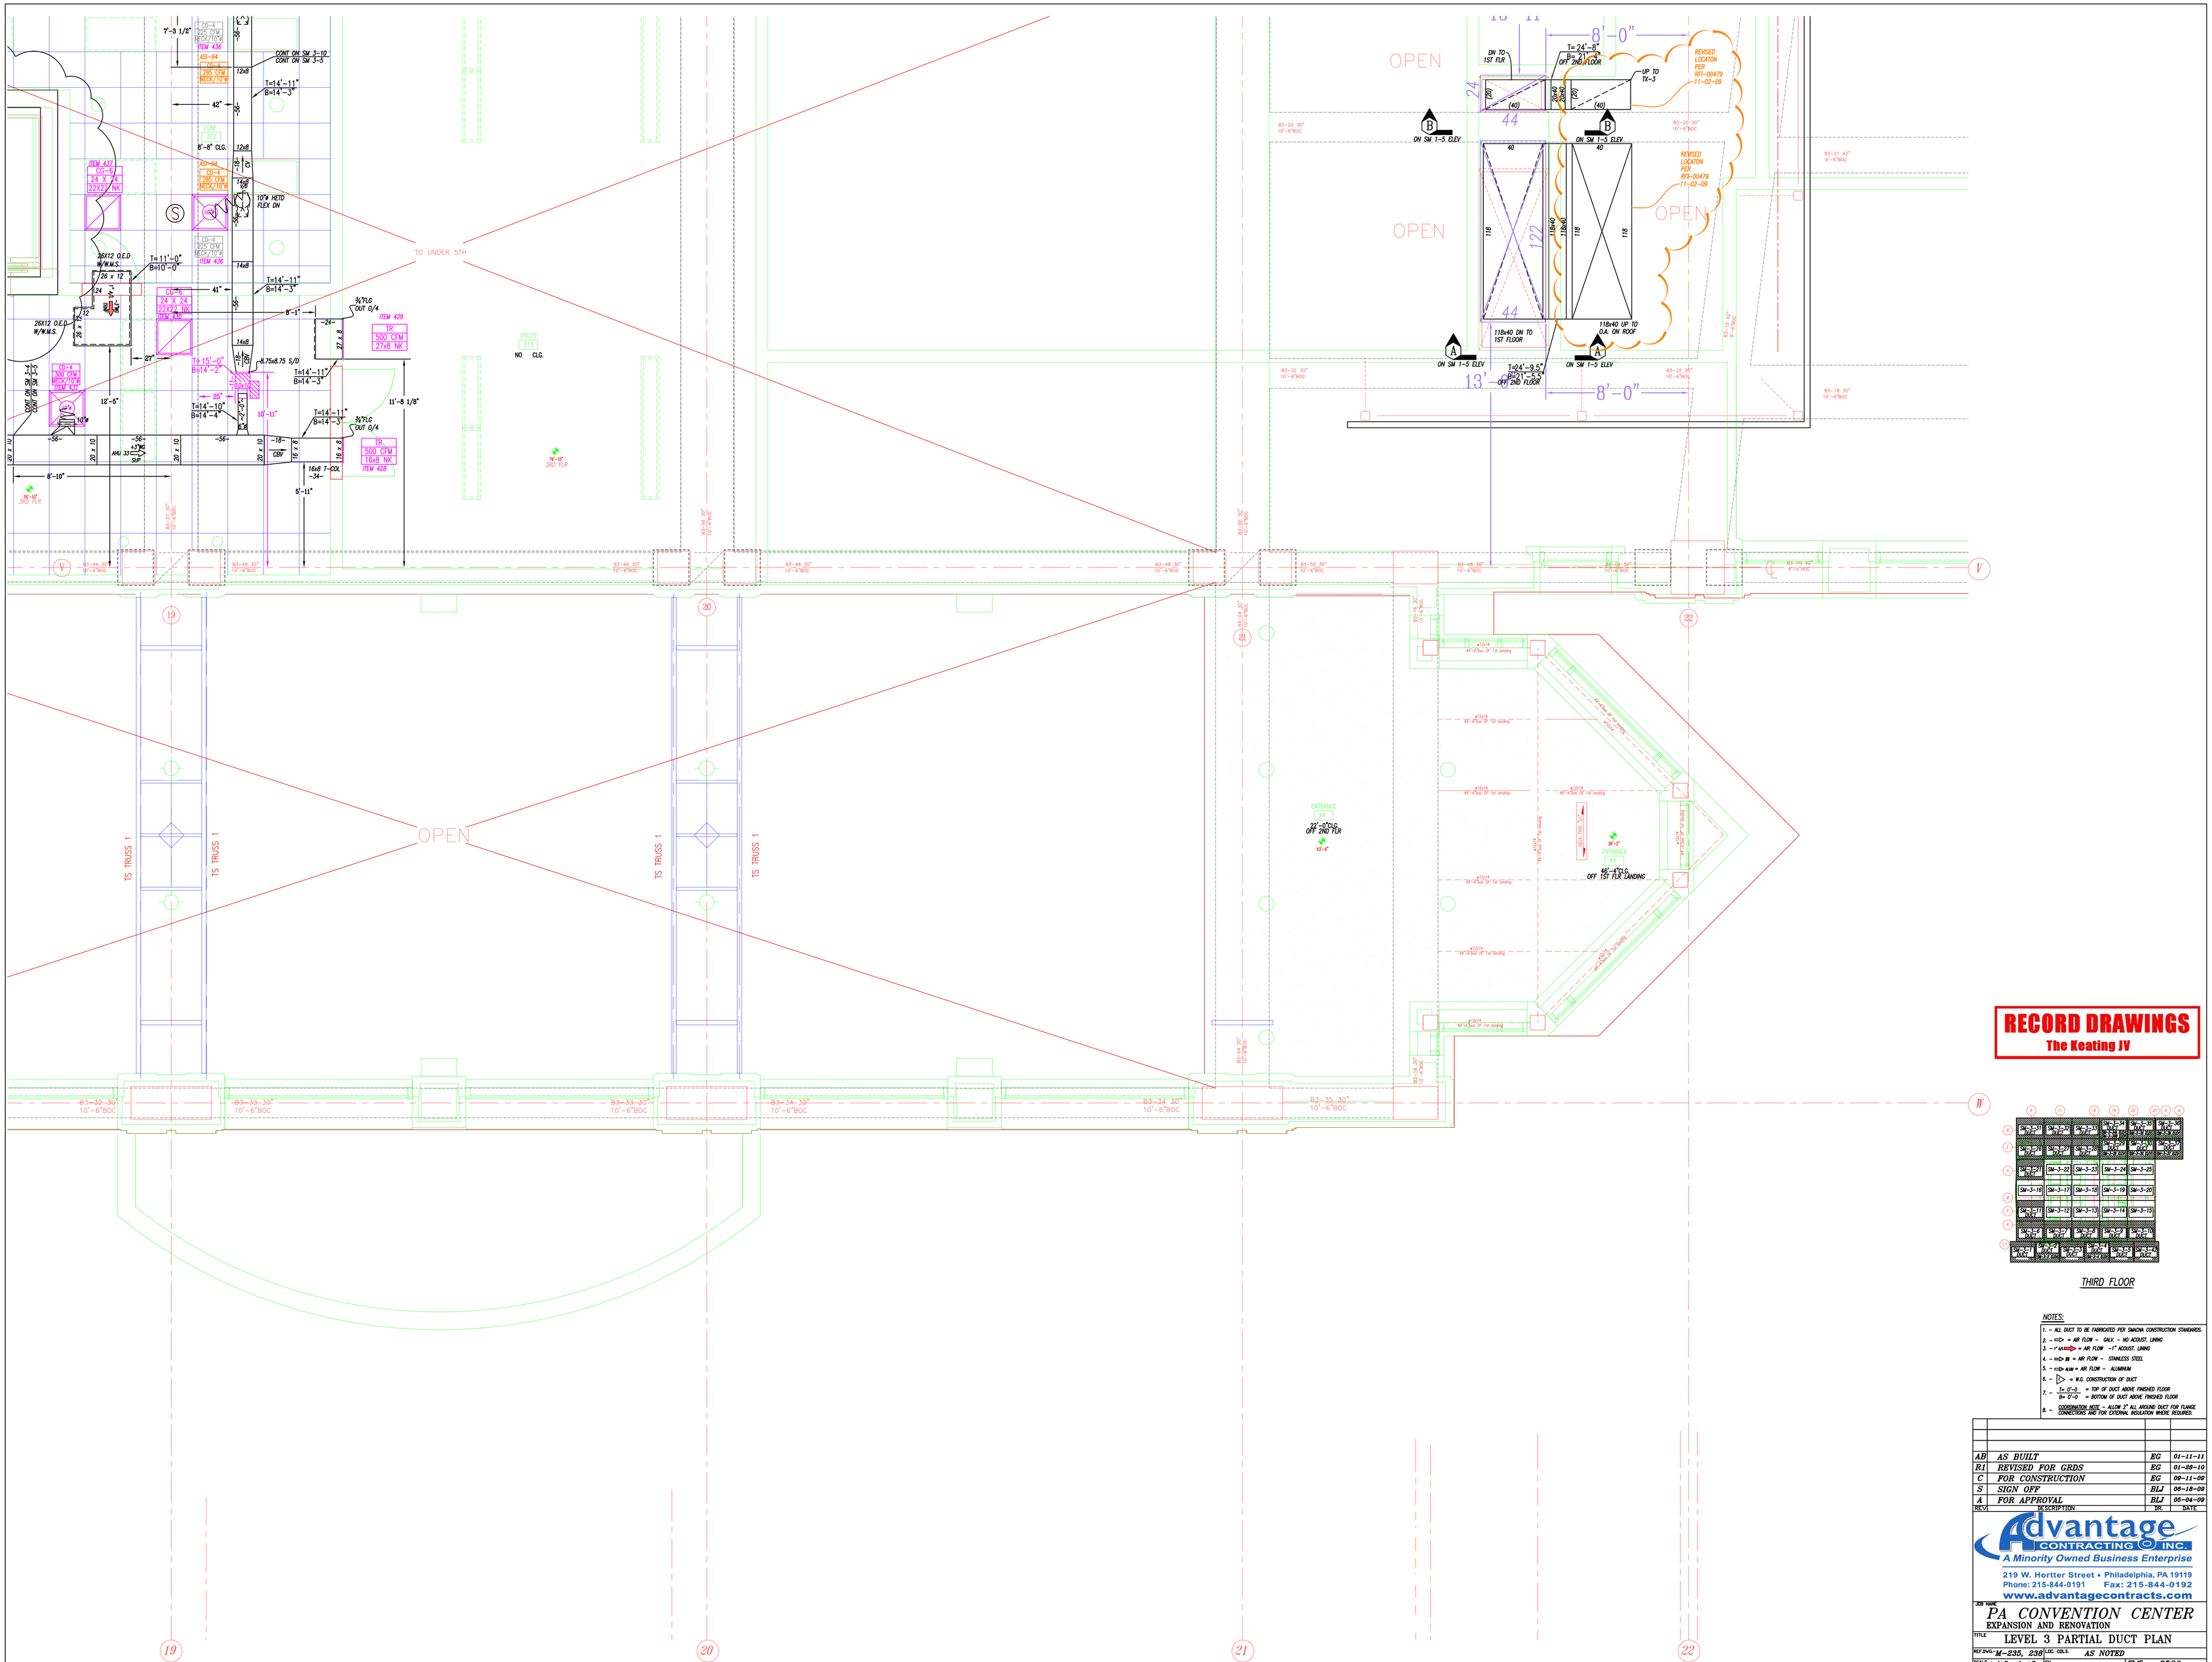

THIRD FLOOR

NOTES:

1. – ALL DUCT TO BE FABRICATED PER SMACNA CONSTRUCTION STANDARDS.
2. – ⊂⊃ = AIR FLOW – GALV. – NO ACOUST. LINING
3. – ⊂⊃ = AIR FLOW – 1" ACOUST. LINING
4. – ⊂⊃ SS = AIR FLOW – STAINLESS STEEL
5. – ⊂⊃ ALUM = AIR FLOW – ALUMINUM
6. – ▷ = W.G. CONSTRUCTION OF DUCT
7. – In 0'-0" = TOP OF DUCT ABOVE FINISHED FLOOR
   In 9'-0" = BOTTOM OF DUCT ABOVE FINISHED FLOOR
8. – COORDINATION NOTE – ALLOW 2" ALL AROUND DUCT FOR FLANGE CONNECTIONS AND FOR EXTERNAL INSULATION WHERE REQUIRED.

RECORD DRAWINGS
The Keating JV

REV'D	DESCRIPTION	BY:	DATE
AB	AS BUILT	EG	01-11-11
R1	REVISED FOR GRDS	EG	01-28-10
C	FOR CONSTRUCTION	EG	09-11-09
S	SIGN OFF	BLJ	06-18-09
A	FOR APPROVAL	BLJ	05-04-09

Advantage CONTRACTING INC.
A Minority Owned Business Enterprise
219 W. Hortter Street • Philadelphia, PA 19119
Phone: 215-844-0191 Fax: 215-844-0192
www.advantagecontracts.com

JOB NAME: PA CONVENTION CENTER
EXPANSION AND RENOVATION

TITLE: LEVEL 3 PARTIAL DUCT PLAN

REF.DWG: M-235, 238	LOC. COLS. AS NOTED		
SCALE: 3/8"=1'-0"	CH.	JOB NO.	8520
DATE: 05-04-09	DR. BLJ	DWG. NO.	SM 3-5

REVISED 12-7-09
PER RFI- 00559
ADVANTAGE 55
PER SK 15 11:30:09

REVISED 12-7-09
PER RFI- 00559
ADVANTAGE 55

ELEVATION L06

RECORD DRAWINGS
The Keating JV

THIRD FLOOR

NOTES:
1. - ALL DUCT TO BE FABRICATED PER SMACNA CONSTRUCTION STANDARDS.
2. - <=D> = AIR FLOW - GALV. = NO ACOUST. LINING
3. - <=D=> = AIR FLOW - 1" ACOUST. LINING
4. - <=D=> SS = AIR FLOW - STAINLESS STEEL
5. - <=D=> ALUM = AIR FLOW - ALUMINUM
6. - [▷] = W.G. CONSTRUCTION OF DUCT
7. - T= 0'-0" = TOP OF DUCT ABOVE FINISHED FLOOR
   B= 0'-0" = BOTTOM OF DUCT ABOVE FINISHED FLOOR
8. - COORDINATION NOTE - ALLOW 2" ALL AROUND DUCT FOR FLANGE CONNECTIONS AND FOR EXTERNAL INSULATION WHERE REQUIRED.

REV.	DESCRIPTION	DR.	DATE
AB	AS BUILT	EG	01-11-11
R1	REVISED FOR GRDS	EG	01-28-10
C2	FOR CONSTRUCTION(REV RFI-55-00559)	EG	12-16-09
C	FOR CONSTRUCTION	EG	11-11-09
S	SIGN OFF	BLJ	07-02-09
A	FOR APPROVAL	BLJ	04-15-09

Advantage CONTRACTING INC.
A Minority Owned Business Enterprise
219 W. Hortter Street • Philadelphia, PA 19119
Phone: 215-844-0191 Fax: 215-844-0192
www.advantagecontracts.com

JOB NAME: PA CONVENTION CENTER
EXPANSION AND RENOVATION

TITLE: LEVEL 3 PARTIAL DUCT PLAN

REF.DWG.- M-232	LOC. COLS.		
SCALE 3/8"=1'-0"	CH.	JOB NO.	8520
DATE 04-15-09	DR. BLJ	DWG. NO.	SM 3-6

TRUSS T5 BOTTOM CHORD

W8x31

WT6x15 X-BRACING TO TOPCHORD(25k)

TRUSS T1 BOTTOM CHORD

TRUSS T1 BOTTOM CHORD

SOUND TRAP #1

DN

UP

8'-6" TO PAD

11 1/2" TO PAD

NO CLG.

RECORD DRAWINGS
The Keating JV

THIRD FLOOR

NOTES:

1. – ALL DUCT TO BE FABRICATED PER SMACNA CONSTRUCTION STANDARDS.
2. – ⇨ = AIR FLOW – GALV. – NO ACOUST. LINING
3. – ⇨ = AIR FLOW – 1" ACOUST. LINING
4. – ⇨ = AIR FLOW – STAINLESS STEEL
5. – ⇨ = AIR FLOW – ALUMINUM
6. – ▷ = W.G. CONSTRUCTION OF DUCT.
7. – T= 0'-0" = TOP OF DUCT ABOVE FINISHED FLOOR
   B= 0'-0" = BOTTOM OF DUCT ABOVE FINISHED FLOOR
8. – COORDINATION NOTE – ALLOW 2" ALL AROUND DUCT FOR FLANGE CONNECTIONS AND FOR EXTERNAL INSULATION WHERE REQUIRED.

REV.	DESCRIPTION	BY:	DATE
AB	AS BUILT	EG	01-11-11
R1	REVISED FOR GRDS	EG	01-28-10
C	FOR CONSTRUCTION	EG	09-11-09
S	SIGN OFF	BLJ	07-02-09
A	FOR APPROVAL	BLJ	05-04-09

Advantage CONTRACTING INC.
A Minority Owned Business Enterprise
219 W. Hortter Street • Philadelphia, PA 19119
Phone: 215-844-0191 Fax: 215-844-0192
www.advantagecontracts.com

JOB NAME: PA CONVENTION CENTER
EXPANSION AND RENOVATION

TITLE: LEVEL 3 PARTIAL DUCT PLAN

REF.DWG.-	M-235	LOC. COLS.	
SCALE	3/8"=1'-0"	CH.	JOB NO. 8520
DATE	05-04-09	DR. BLJ	DWG. NO. SM 3-8

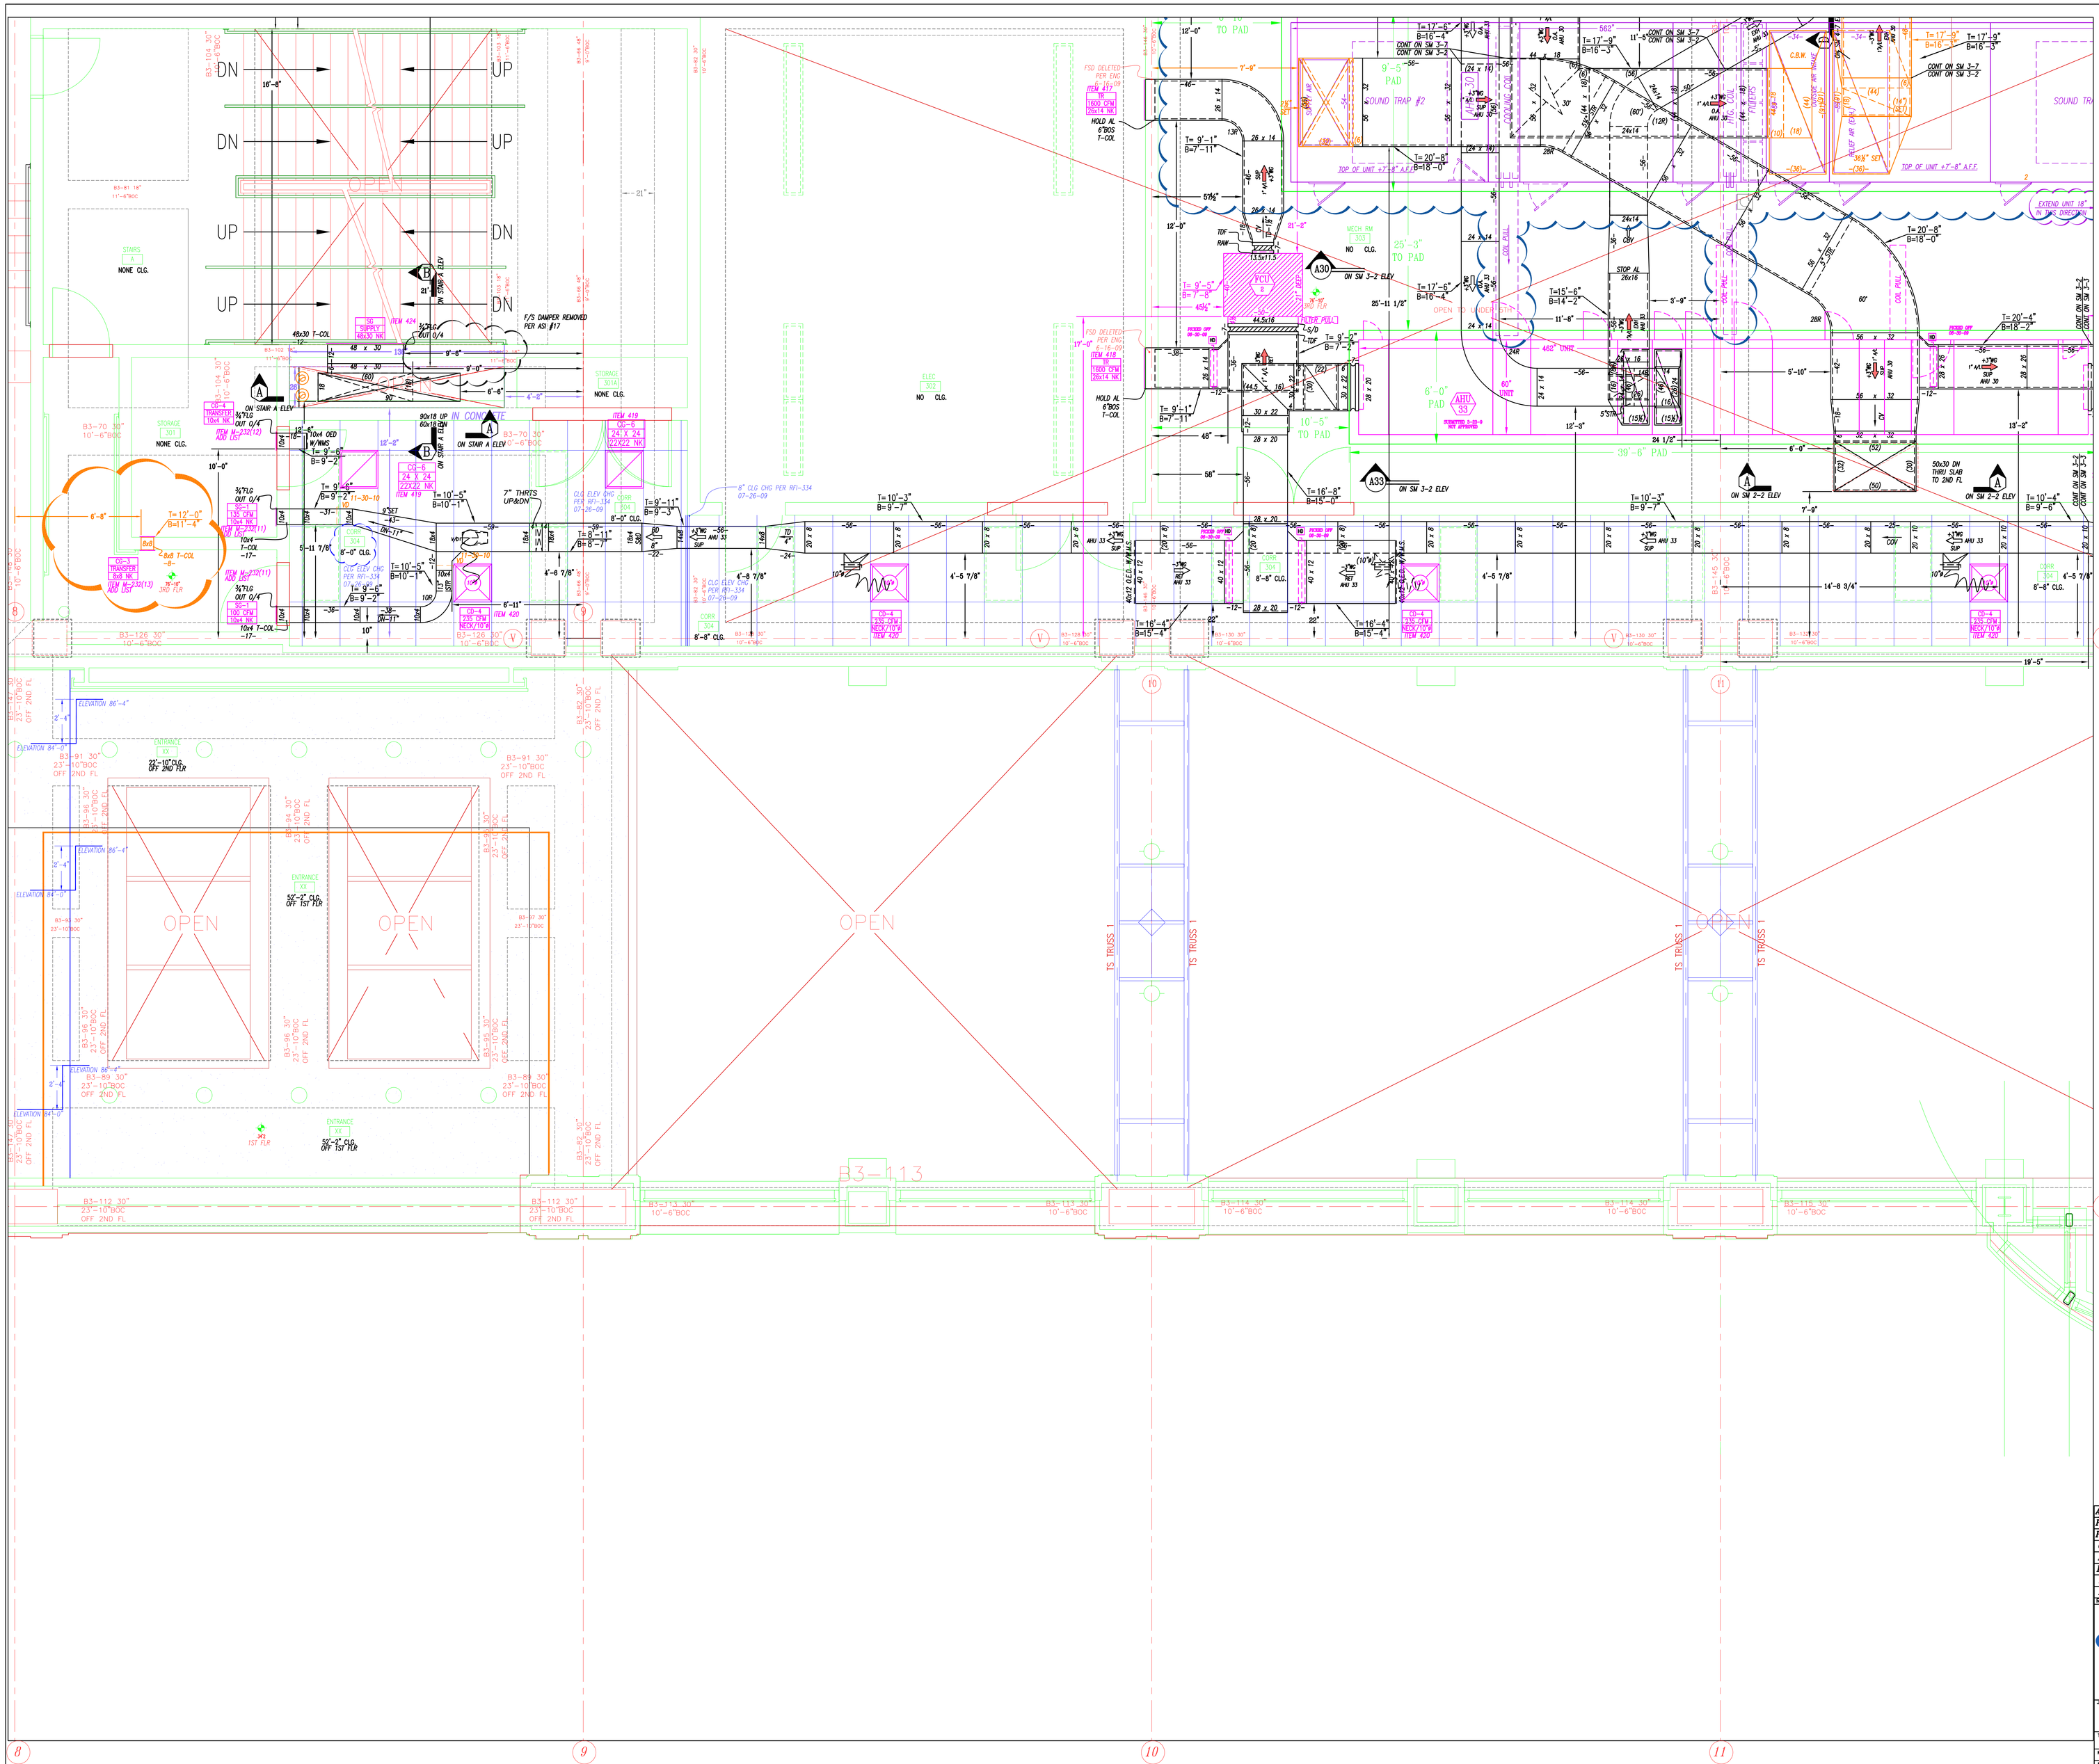
OPEN
OPEN
OPEN
B3-113
TS TRUSS 1
TS TRUSS 1
TS TRUSS 1
TS TRUSS 1
TOP OF UNIT +7'-8" A.F.F.
TOP OF UNIT +7'-8" A.F.F.
SOUND TRAP #2
9'-5" PAD
25'-9" TO PAD
10'-5" TO PAD
6'-0" PAD
39'-6" PAD
462" UNIT
60" UNIT
OPEN TO BELOW
STAIRS 1 NONE CLG.
STORAGE 301 NONE CLG.
STORAGE 301A NONE CLG.
ELEC 302 NO CLG.
MECH RM 303 NO CLG.
ENTRANCE XX 22'-10" CLG. OFF 2ND FLR
ENTRANCE XX 56'-2" CLG. OFF 1st FLR
ENTRANCE XX 56'-2" CLG. OFF 1st FLR
ELEVATION 86'-4"
ELEVATION 84'-0"
EXTEND UNIT 18" IN THIS DIRECTION
50x30 DN THRU SLAB TO 2ND FL
90x18 UP IN CONCRETE
F/S DAMPER REMOVED PER ASI #17
FSD DELETED PER ENG. E-16-09 ITEM 418
FSD DELETED PER ENG. E-16-09 ITEM 419
8" CLG CHG PER RFI-334 07-26-09
CLG ELEV CHG PER RFI-334 07-26-09
ON STAIR A ELEV
ON SM 3-2 ELEV
ON SM 2-2 ELEV
ON SM 3-2 ELEV
ON STAIR A ELEV
ON STAIR A ELEV
CONT ON SM 3-7 CONT ON SM 3-2
CONT ON SM 3-2 CONT ON SM 3-2
CONT ON SM 3-2 CONT ON SM 3-2
CONT ON SM 3-2

RECORD DRAWINGS
The Keating JV

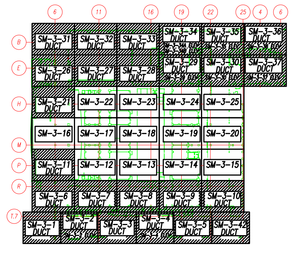

THIRD FLOOR

NOTES:
1. – ALL DUCT TO BE FABRICATED PER SMACNA CONSTRUCTION STANDARDS.
2. – <=> = AIR FLOW – GALV. – NO ACOUST. LINING
3. – ⊢⟹⊣ = AIR FLOW – =1" ACOUST. LINING
4. – =<>= = AIR FLOW – STAINLESS STEEL
5. – =<>= ALUM = AIR FLOW – ALUMINUM
6. – ▷ = W.G. CONSTRUCTION OF DUCT
7. – $\frac{T= 0'-0}{B= 0'-0}$ = TOP OF DUCT ABOVE FINISHED FLOOR = BOTTOM OF DUCT ABOVE FINISHED FLOOR
8. – COORDINATION NOTE – ALLOW 2" ALL AROUND DUCT FOR FLANGE CONNECTIONS AND FOR EXTERNAL INSULATION WHERE REQUIRED.

REV.	DESCRIPTION	DR.	DATE
AB	AS BUILT	EG	01-28-10
R1	REVISED FOR GRDS	EG	01-28-10
C	FOR CONSTRUCTION	EG	09-11-09
S	SIGN OFF	BLJ	07-02-09
A	FOR APPROVAL	BLJ	04-15-09

Advantage CONTRACTING INC.
A Minority Owned Business Enterprise
219 W. Hortter Street • Philadelphia, PA 19119
Phone: 215-844-0191 Fax: 215-844-0192
www.advantagecontracts.com

JOB NAME: PA CONVENTION CENTER
EXPANSION AND RENOVATION

TITLE: LEVEL 3 PARTIAL DUCT PLAN

REF. DWG.-	M 232	LOC. COILS	
SCALE	3/8"=1'-0"	CH.	JOB NO. 8520
DATE	04-15-09	DR. BLJ	DWG. NO. SM 3-7

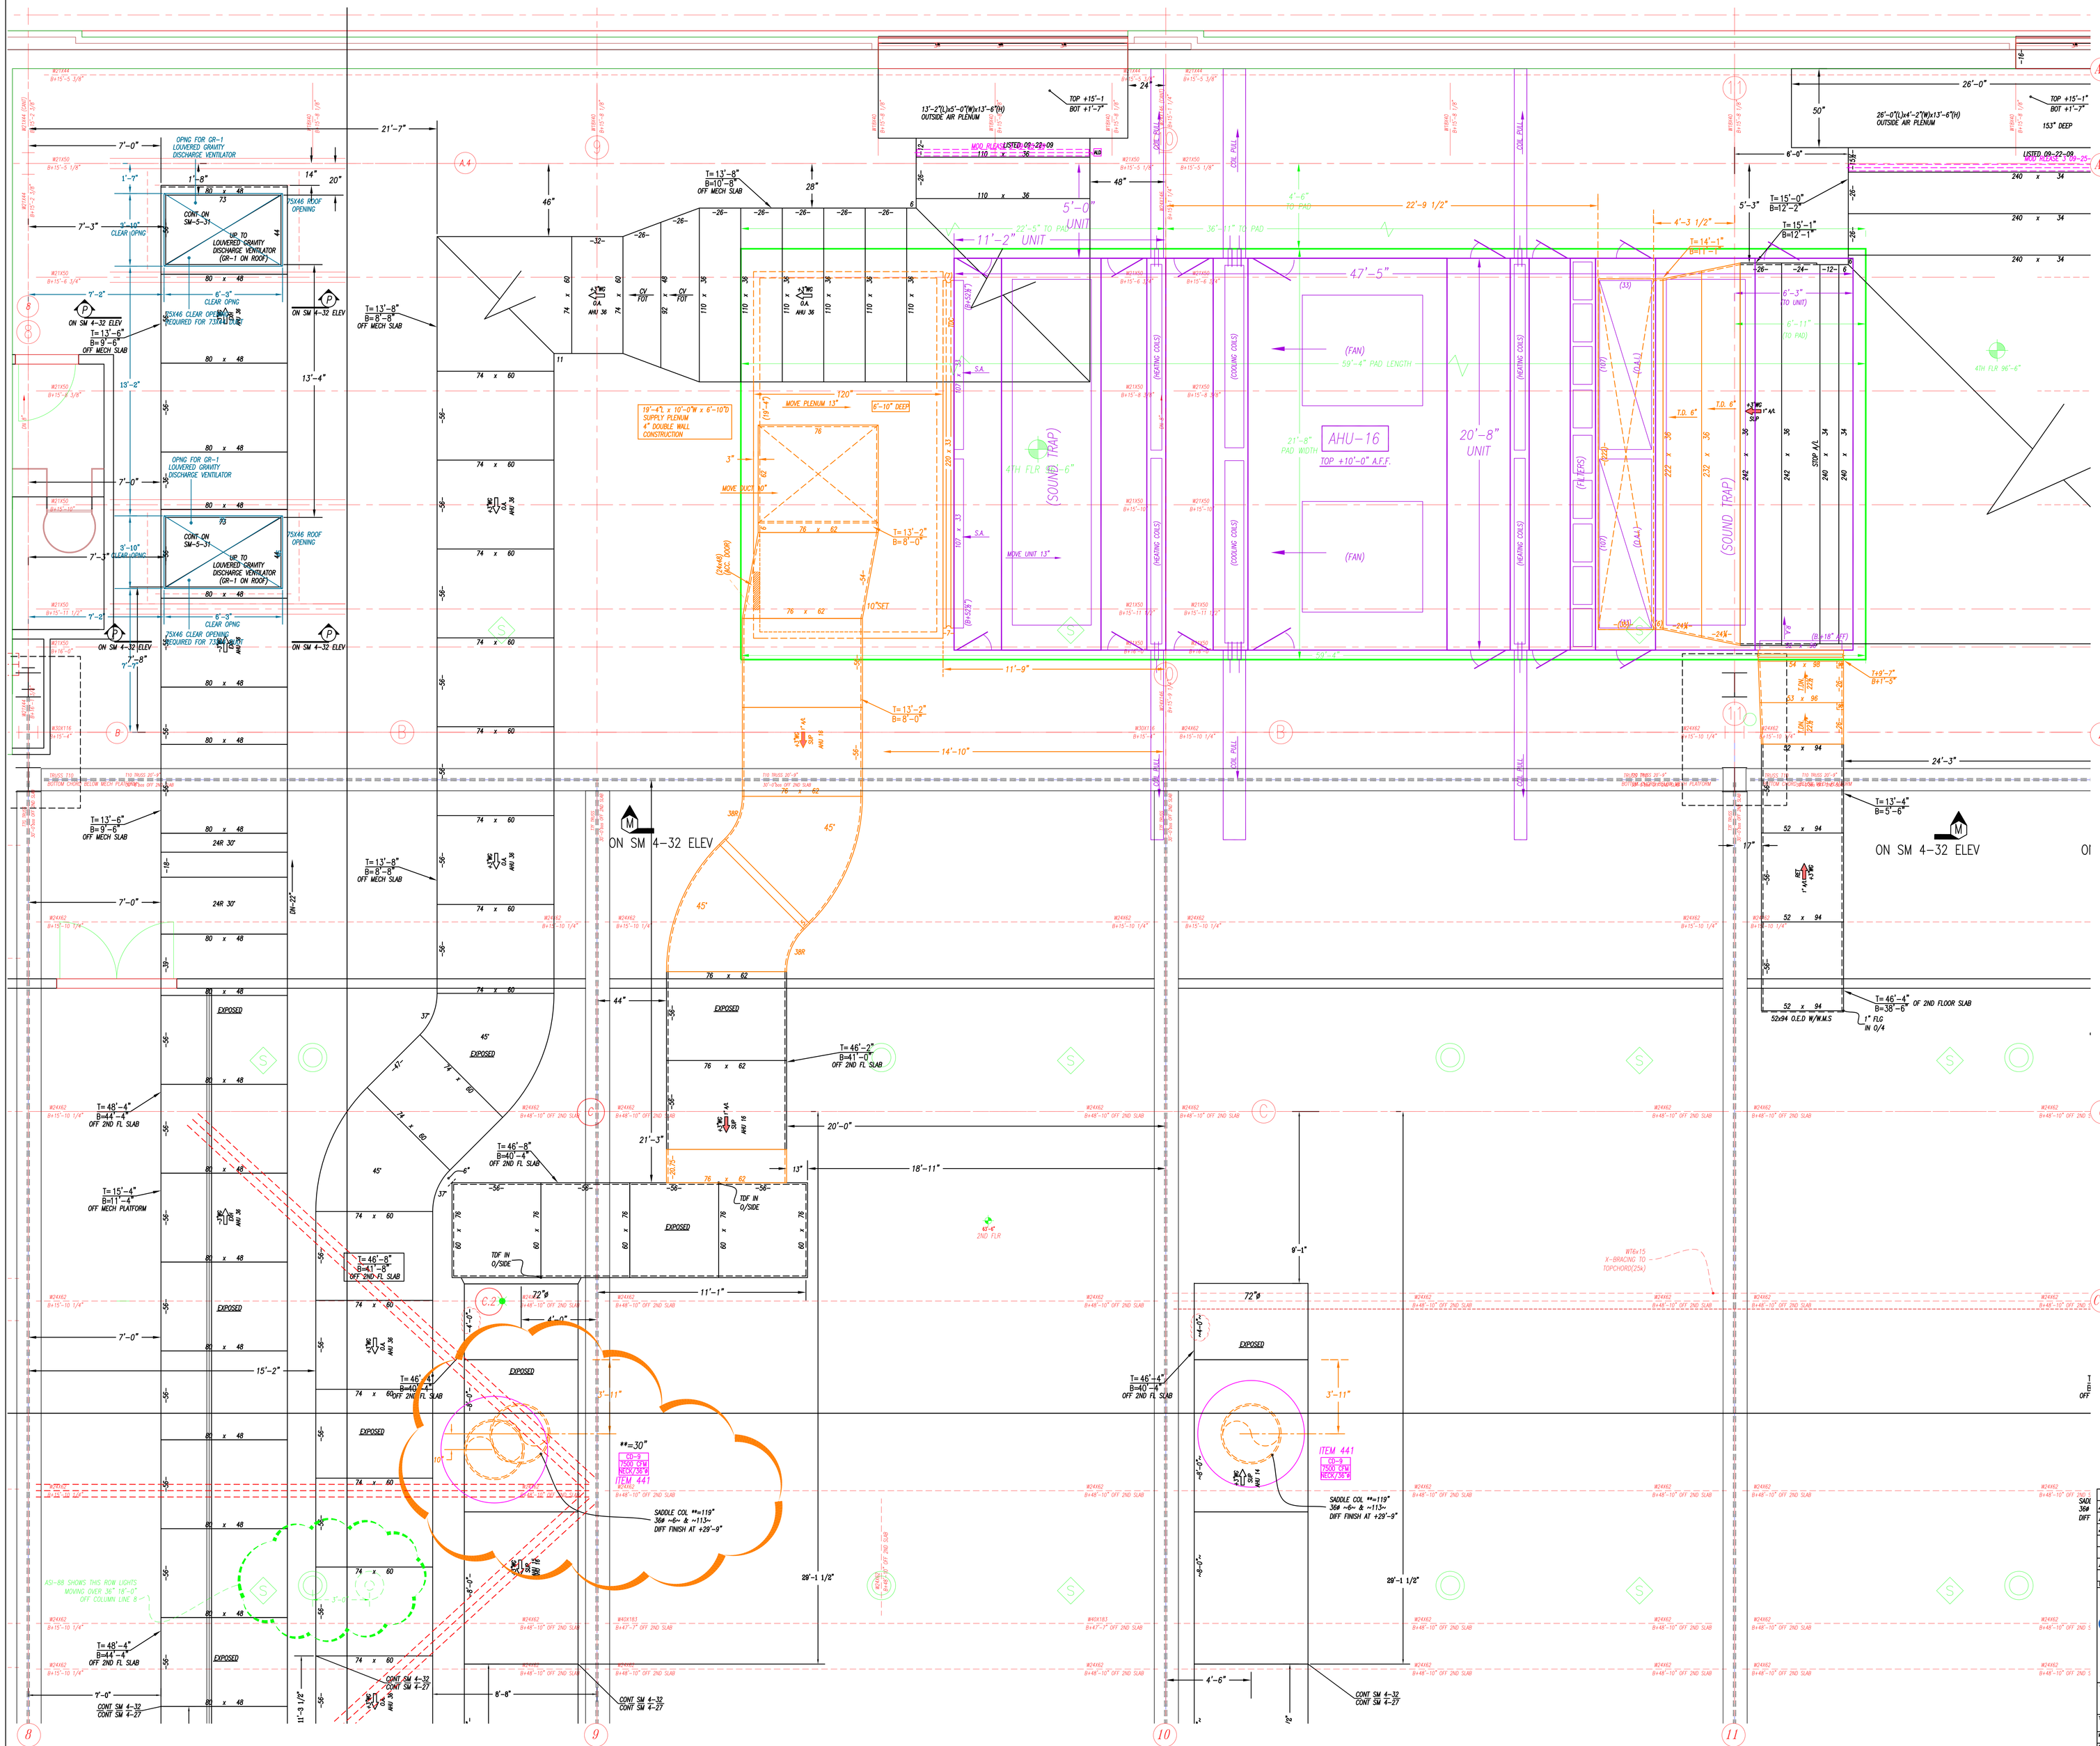

RECORD DRAWINGS
The Keating JV

NOTES:

1. – ALL DUCT TO BE FABRICATED PER SMACNA CONSTRUCTION STANDARDS.
2. – <=> = AIR FLOW – GALV. – NO ACOUST. LINING
3. – 1"=1.5=> = AIR FLOW – 1" ACOUST. LINING
4. – <=> SS = AIR FLOW – STAINLESS STEEL
5. – <=> ALUM = AIR FLOW – ALUMINUM
6. – |▷ = W.C. CONSTRUCTION OF DUCT
7. – Ts 0'-0 = TOP OF DUCT ABOVE FINISHED FLOOR; Bs 0'-0 = BOTTOM OF DUCT ABOVE FINISHED FLOOR
8. – COORDINATION NOTE – ALLOW 2" ALL AROUND DUCT FOR FLANGE CONNECTIONS AND FOR EXTERNAL INSULATION WHERE REQUIRED.

REV.	DESCRIPTION	DR.	DATE
AB	AS BUILT	EG	01-11-11
R2	REVISED FOR GRDS	EG	01-29-10
S2	RESIGN (PIPING CONFLICTS)	EG	12-17-09
C	FOR CONSTRUCTION	EG	10-20-09
S	SIGN OFF	BLJ	09-24-09
R1	UNIT REVISION	MSO	09-08-09
A	FOR APPROVAL	BLJ	08-08-09

Advantage CONTRACTING INC.
A Minority Owned Business Enterprise
219 W. Hortter Street • Philadelphia, PA 19119
Phone: 215-844-0191 Fax: 215-844-0192
www.advantagecontracts.com

JOB NAME
PA CONVENTION CENTER
EXPANSION AND RENOVATION

TITLE
LEVEL 4 PARTIAL DUCT PLAN

REF. DWGS.	M240	LOC. COLS.	
SCALE	3/8"=1'-0"	CH.	JOB NO. 8520
DATE	08-08-09	DR. BLJ	DWG. NO. SM 4-32

THIS AREA
REVISED ON DISK
1-30-09

SLAB OPNG

10'-10 1/2"
4TH FLR
SLAB OPNG

54" TO OPNG

77" TO OPNG

SPF3 ON SM 4-1

SPF3 ON SM 4-1

ON STAIR A ELEV

ON STAIR A ELEV

ON STAIR A ELEV

ON STAIR A ELEV

SPRINKLER COORDINATION NOTES:
SPRINKLER PIPE ELEVATED TO CENTER LINE OF PIPE
ALL LINES NOT SIZED TO BE 8" MAX.
FOR COORD PURPOSES ONLY - THANKS

RECORD DRAWINGS
The Keating JV

FOURTH FLOOR

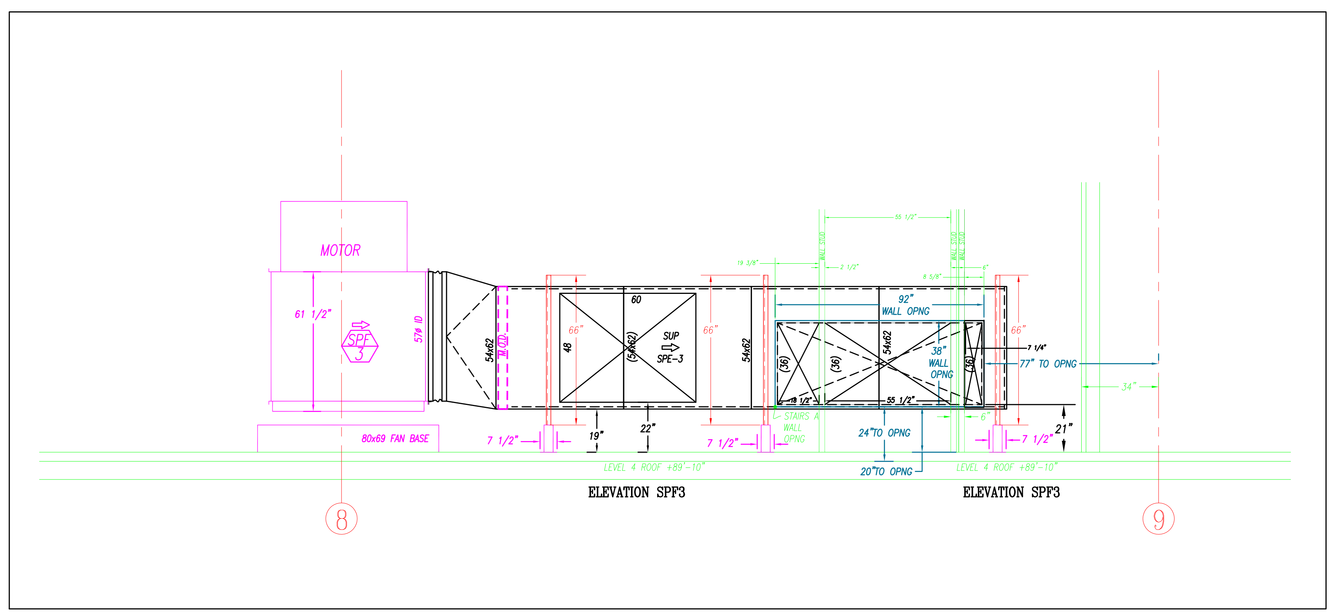

ELEVATION SPF3 ELEVATION SPF3

NOTES:

1. - ALL DUCT TO BE FABRICATED PER SMACNA CONSTRUCTION STANDARDS.
2. - <=> = AIR FLOW - GALV. - NO ACOUST. LINING
3. - <=> = AIR FLOW - 1" ACOUST. LINING
4. - <=> SS = AIR FLOW - STAINLESS STEEL
5. - <=> ALUM = AIR FLOW - ALUMINUM
6. - ▷ = W.G. CONSTRUCTION OF DUCT
7. - 1'-0" = TOP OF DUCT ABOVE FINISHED FLOOR; 0'-0" = BOTTOM OF DUCT ABOVE FINISHED FLOOR
8. - COORDINATION NOTE - ALLOW 2" ALL AROUND DUCT FOR FLANGE CONNECTIONS AND FOR EXTERNAL INSULATION WHERE REQUIRED.

REV'D	DESCRIPTION	DR.	DATE
AB	AS BUILT	EG	01-11-11
R1	REVISED FOR GRDS	EG	01-28-10
C	FOR CONSTRUCTION	EG	11-04-09
S	SIGN-OFF	BLJ	07-16-09
A	FOR APPROVAL	BLJ	05-19-09

Advantage CONTRACTING INC.
A Minority Owned Business Enterprise
219 W. Hortter Street • Philadelphia, PA 19119
Phone: 215-844-0191 Fax: 215-844-0192
www.advantagecontracts.com

JOB NAME: PA CONVENTION CENTER
EXPANSION AND RENOVATION

TITLE: LEVEL 4 PARTIAL DUCT PLAN

REF. DWG.- M242	LOC. COLS.		
SCALE 3/8"=1'-0"	CH.	JOB NO.	8520
DATE XX-XX-XX	DR. BLJ	DWG. NO.	SM 4-1

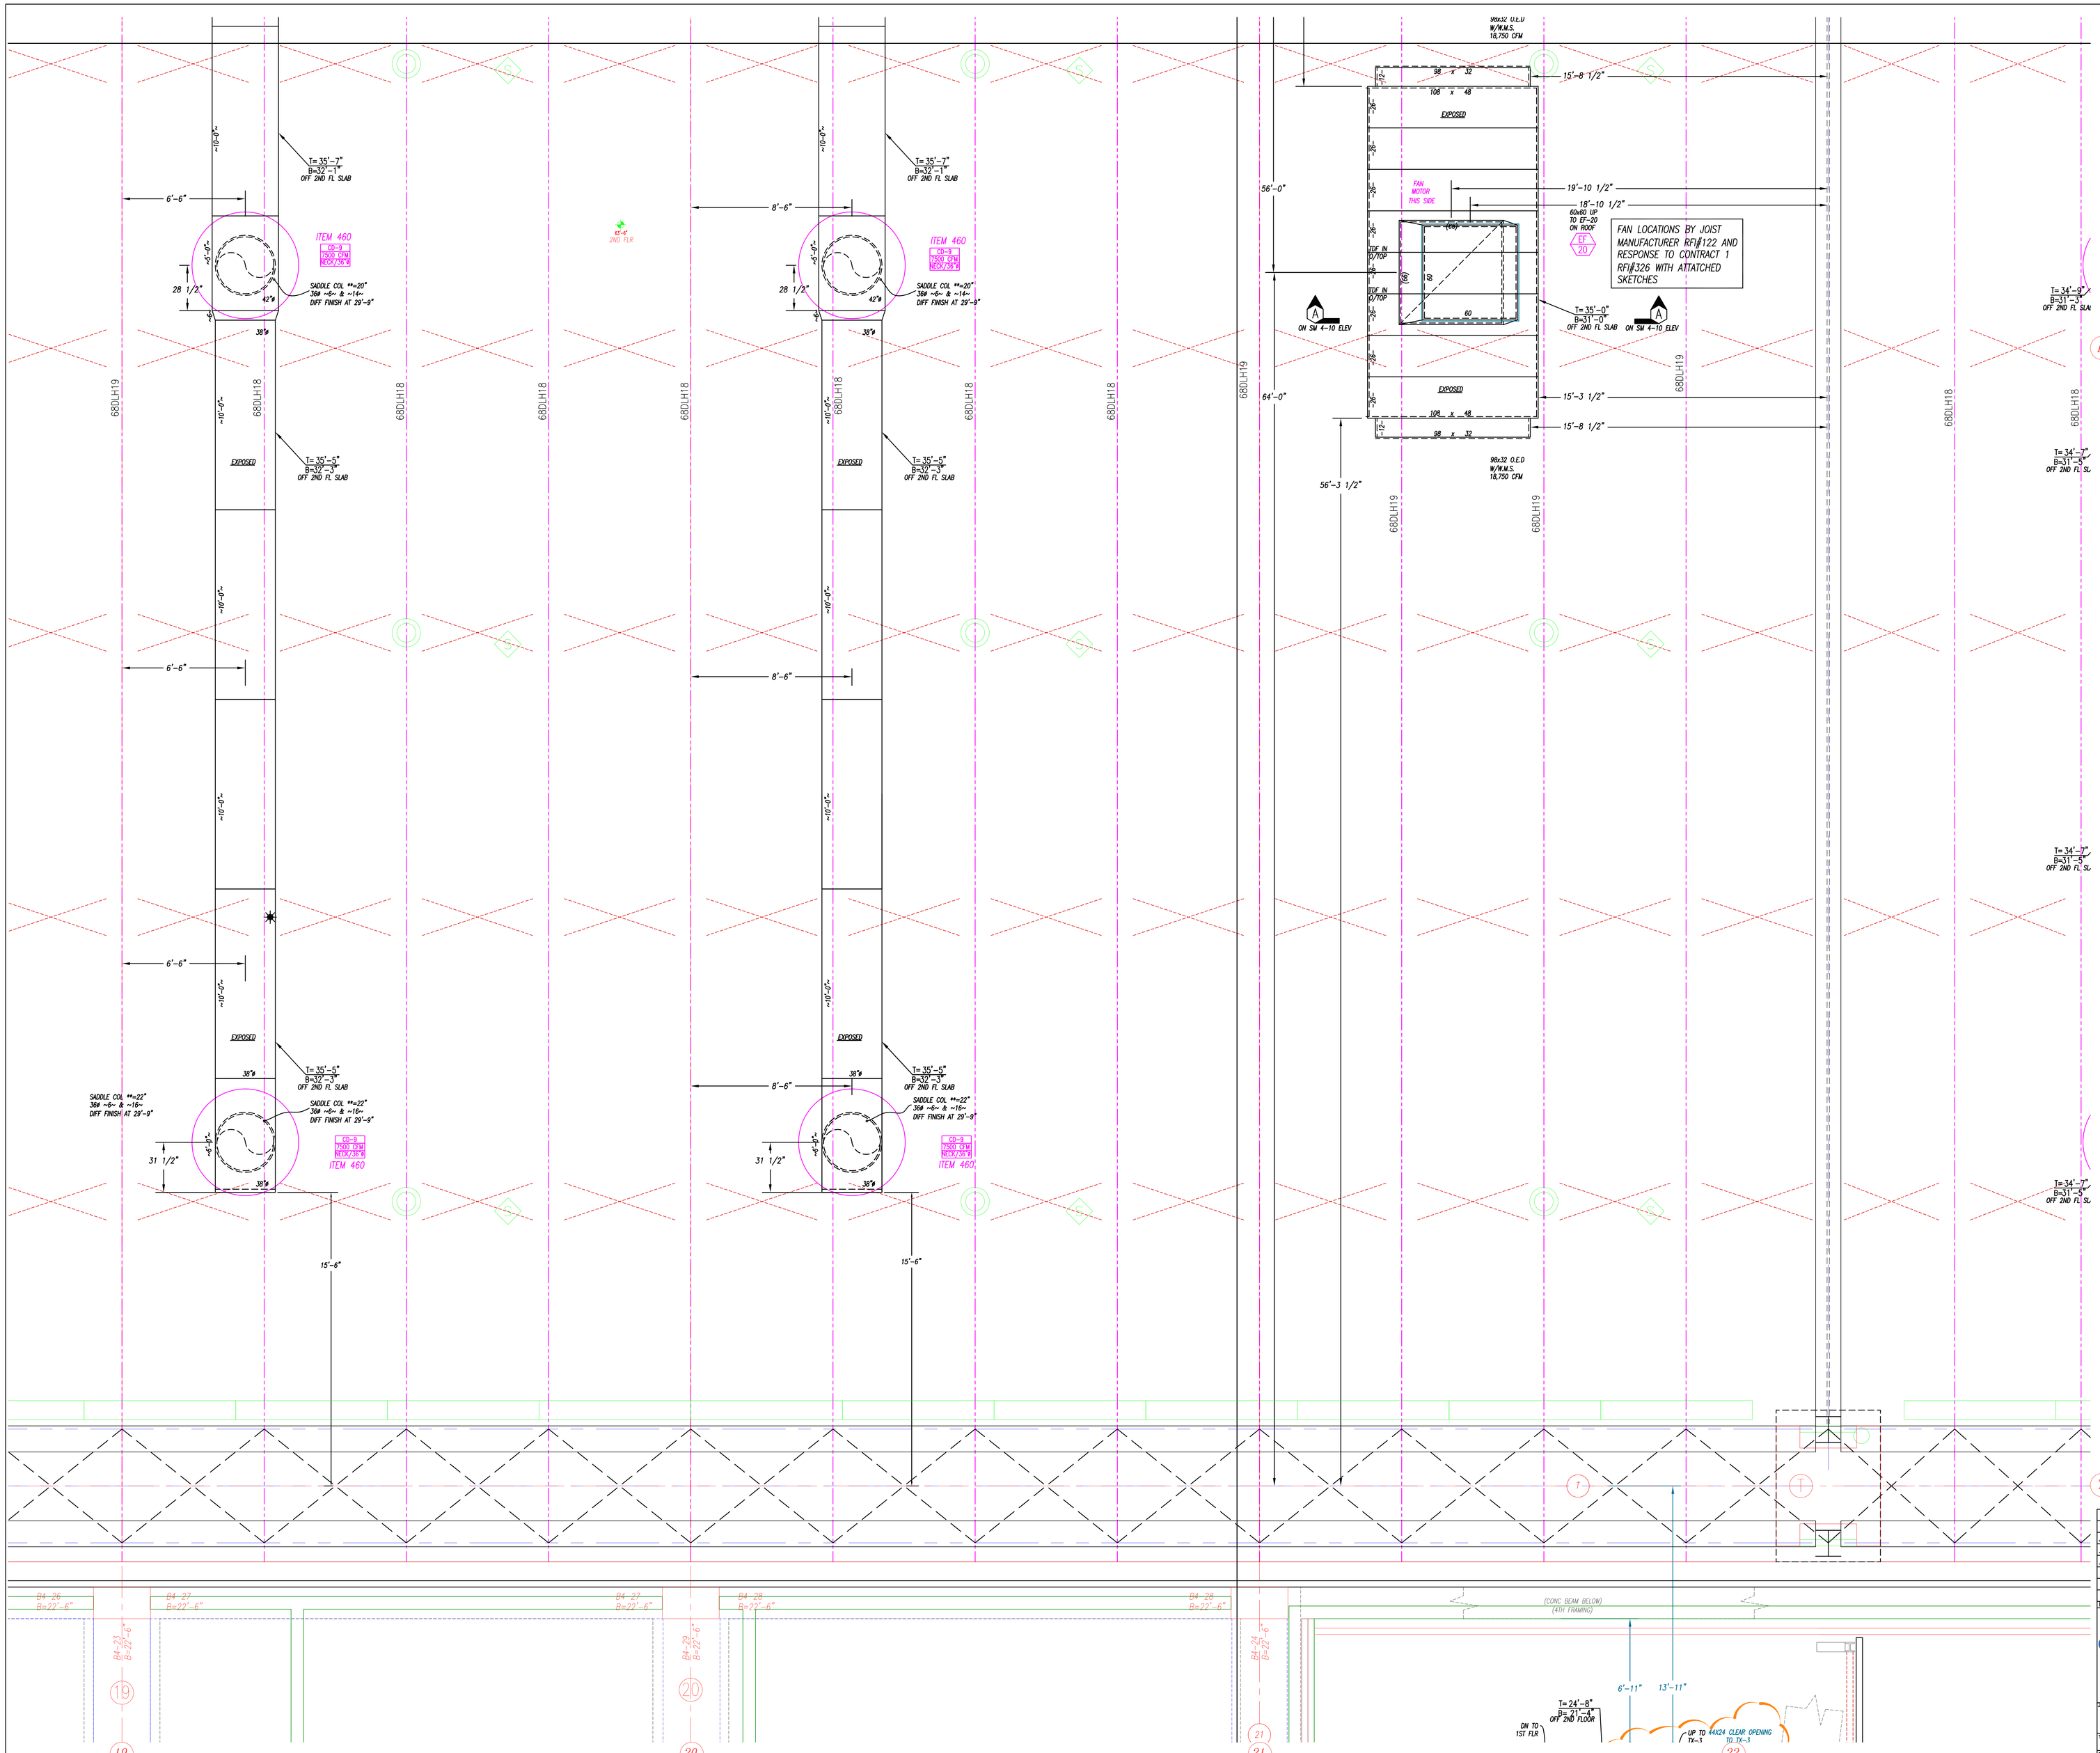

RECORD DRAWINGS
The Keating JV

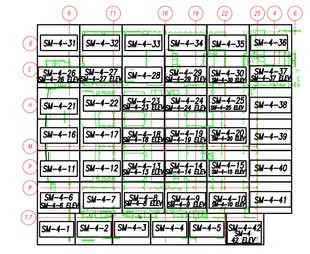

FOURTH FLOOR

NOTES:

1. - ALL DUCT TO BE FABRICATED PER SMACNA CONSTRUCTION STANDARDS.
2. - =C= = AIR FLOW - DUCT; - NO ACOUST. LINING
3. - =C= = AIR FLOW - =1" ACOUST. LINING
4. - =C= IS = AIR FLOW - STAINLESS STEEL
5. - =C= ALUM = AIR FLOW - ALUMINUM
6. - [▷ = W.G. CONSTRUCTION OF DUCT
7. - T= 0'-0" = TOP OF DUCT ABOVE FINISHED FLOOR
   B= 0'-0" = BOTTOM OF DUCT ABOVE FINISHED FLOOR
8. - COORDINATION NOTE - ALLOW 3" ALL AROUND DUCT FOR FLANGE CONNECTIONS AND FOR EXTERNAL INSULATION WHERE REQUIRED.

REV.	DESCRIPTION	DR.	DATE
AB	AS BUILT	EG	01-11-11
R2	REVISED FOR GRDS	EG	01-20-10
R1	REVISED LENGTHS	EG	09-16-09
C	FOR CONSTRUCTION	EG	09-14-09
S	SIGN OFF	EG	09-09-09
A	FOR APPROVAL	BLJ	05-19-09

Advantage CONTRACTING INC.
A Minority Owned Business Enterprise
219 W. Hortter Street • Philadelphia, PA 19119
Phone: 215-844-0191 Fax: 215-844-0192
www.advantagecontracts.com

JOB NAME: PA CONVENTION CENTER
EXPANSION AND RENOVATION

TITLE: LEVEL 4 PARTIAL DUCT PLAN

REF DWGS- M-245,248	LOC. COLS.	AS NOTED	
SCALE 3/8"=1'-0"	CH.	JOB NO.	8520
DATE XX-XX-XX	DR. BLJ	DWG NO.	SM 4-10

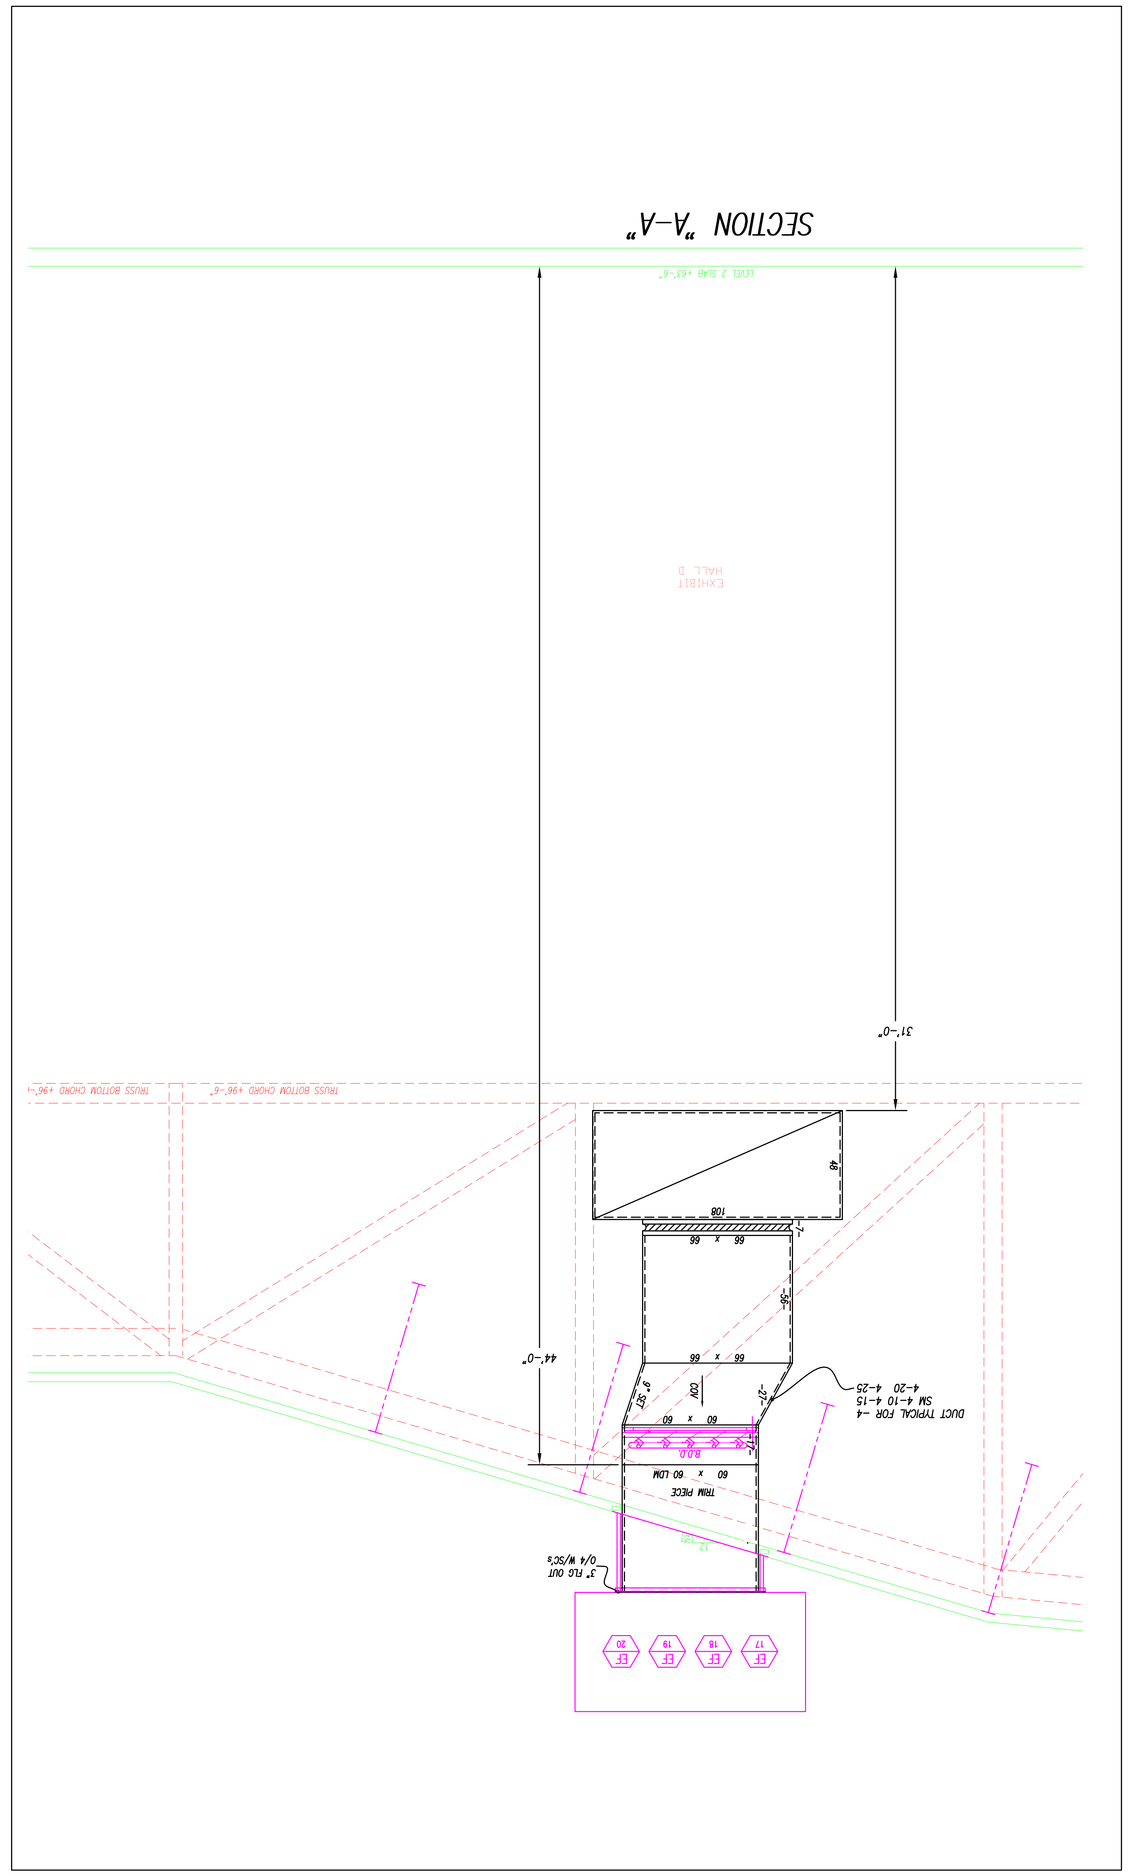

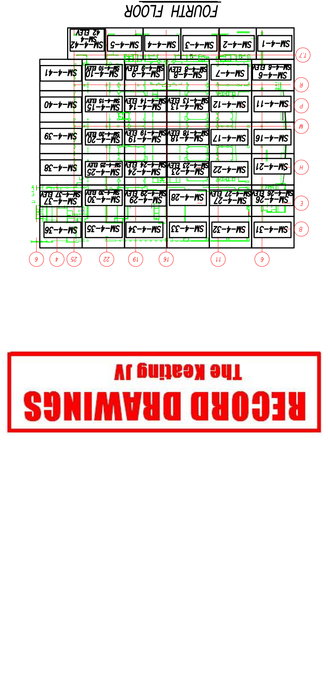

NOTES:

1. - ALL DUCT TO BE FABRICATED PER SMACNA CONSTRUCTION STANDARDS.
2. - <=> = AIR FLOW - DUCT - NO ACOUST. LINING
3. - [VAV] = AIR FLOW -1" ACOUST. LINING
4. - <=>.W = AIR FLOW - STAINLESS STEEL
5. - <=>.ALM = AIR FLOW - ALUMINUM
6. - [▷ = M.S. CONSTRUCTION OF DUCT
7. - T.O.-0 = TOP OF DUCT ABOVE FINISHED FLOOR
B.O.-0 = BOTTOM OF DUCT ABOVE FINISHED FLOOR
8. - COORDINATION NOTE - ALLOW 2" ALL AROUND DUCT FOR FLANGE CONNECTIONS AND FOR CRITICAL INSULATION WHERE SHOWN.

REV	DESCRIPTION	BY	DATE
AB	AS BUILT	EG	01-11-11
C	FOR CONSTRUCTION	EG	09-14-09
A	FOR APPROVAL	BLJ	05-19-09

Advantage CONTRACTING INC.
A Minority Owned Business Enterprise
219 W. Hortter Street • Philadelphia, PA 19119
Phone: 215-844-0191 Fax: 215-844-0192
www.advantagecontracts.com

JOB TITLE
PA CONVENTION CENTER
EXPANSION AND RENOVATION

TITLE
LEVEL 4 DUCT ELEVATIONS

SHT./REV.-	SM 4-10
SCALE-	3/8"=1'-0"
DATE	XX-XX-XX
LOC. CODE	
JOB NO.	8520
DR.	BLJ
DWG NO.	SM 4-10 ELEV

RECORD DRAWINGS
The Keating JV

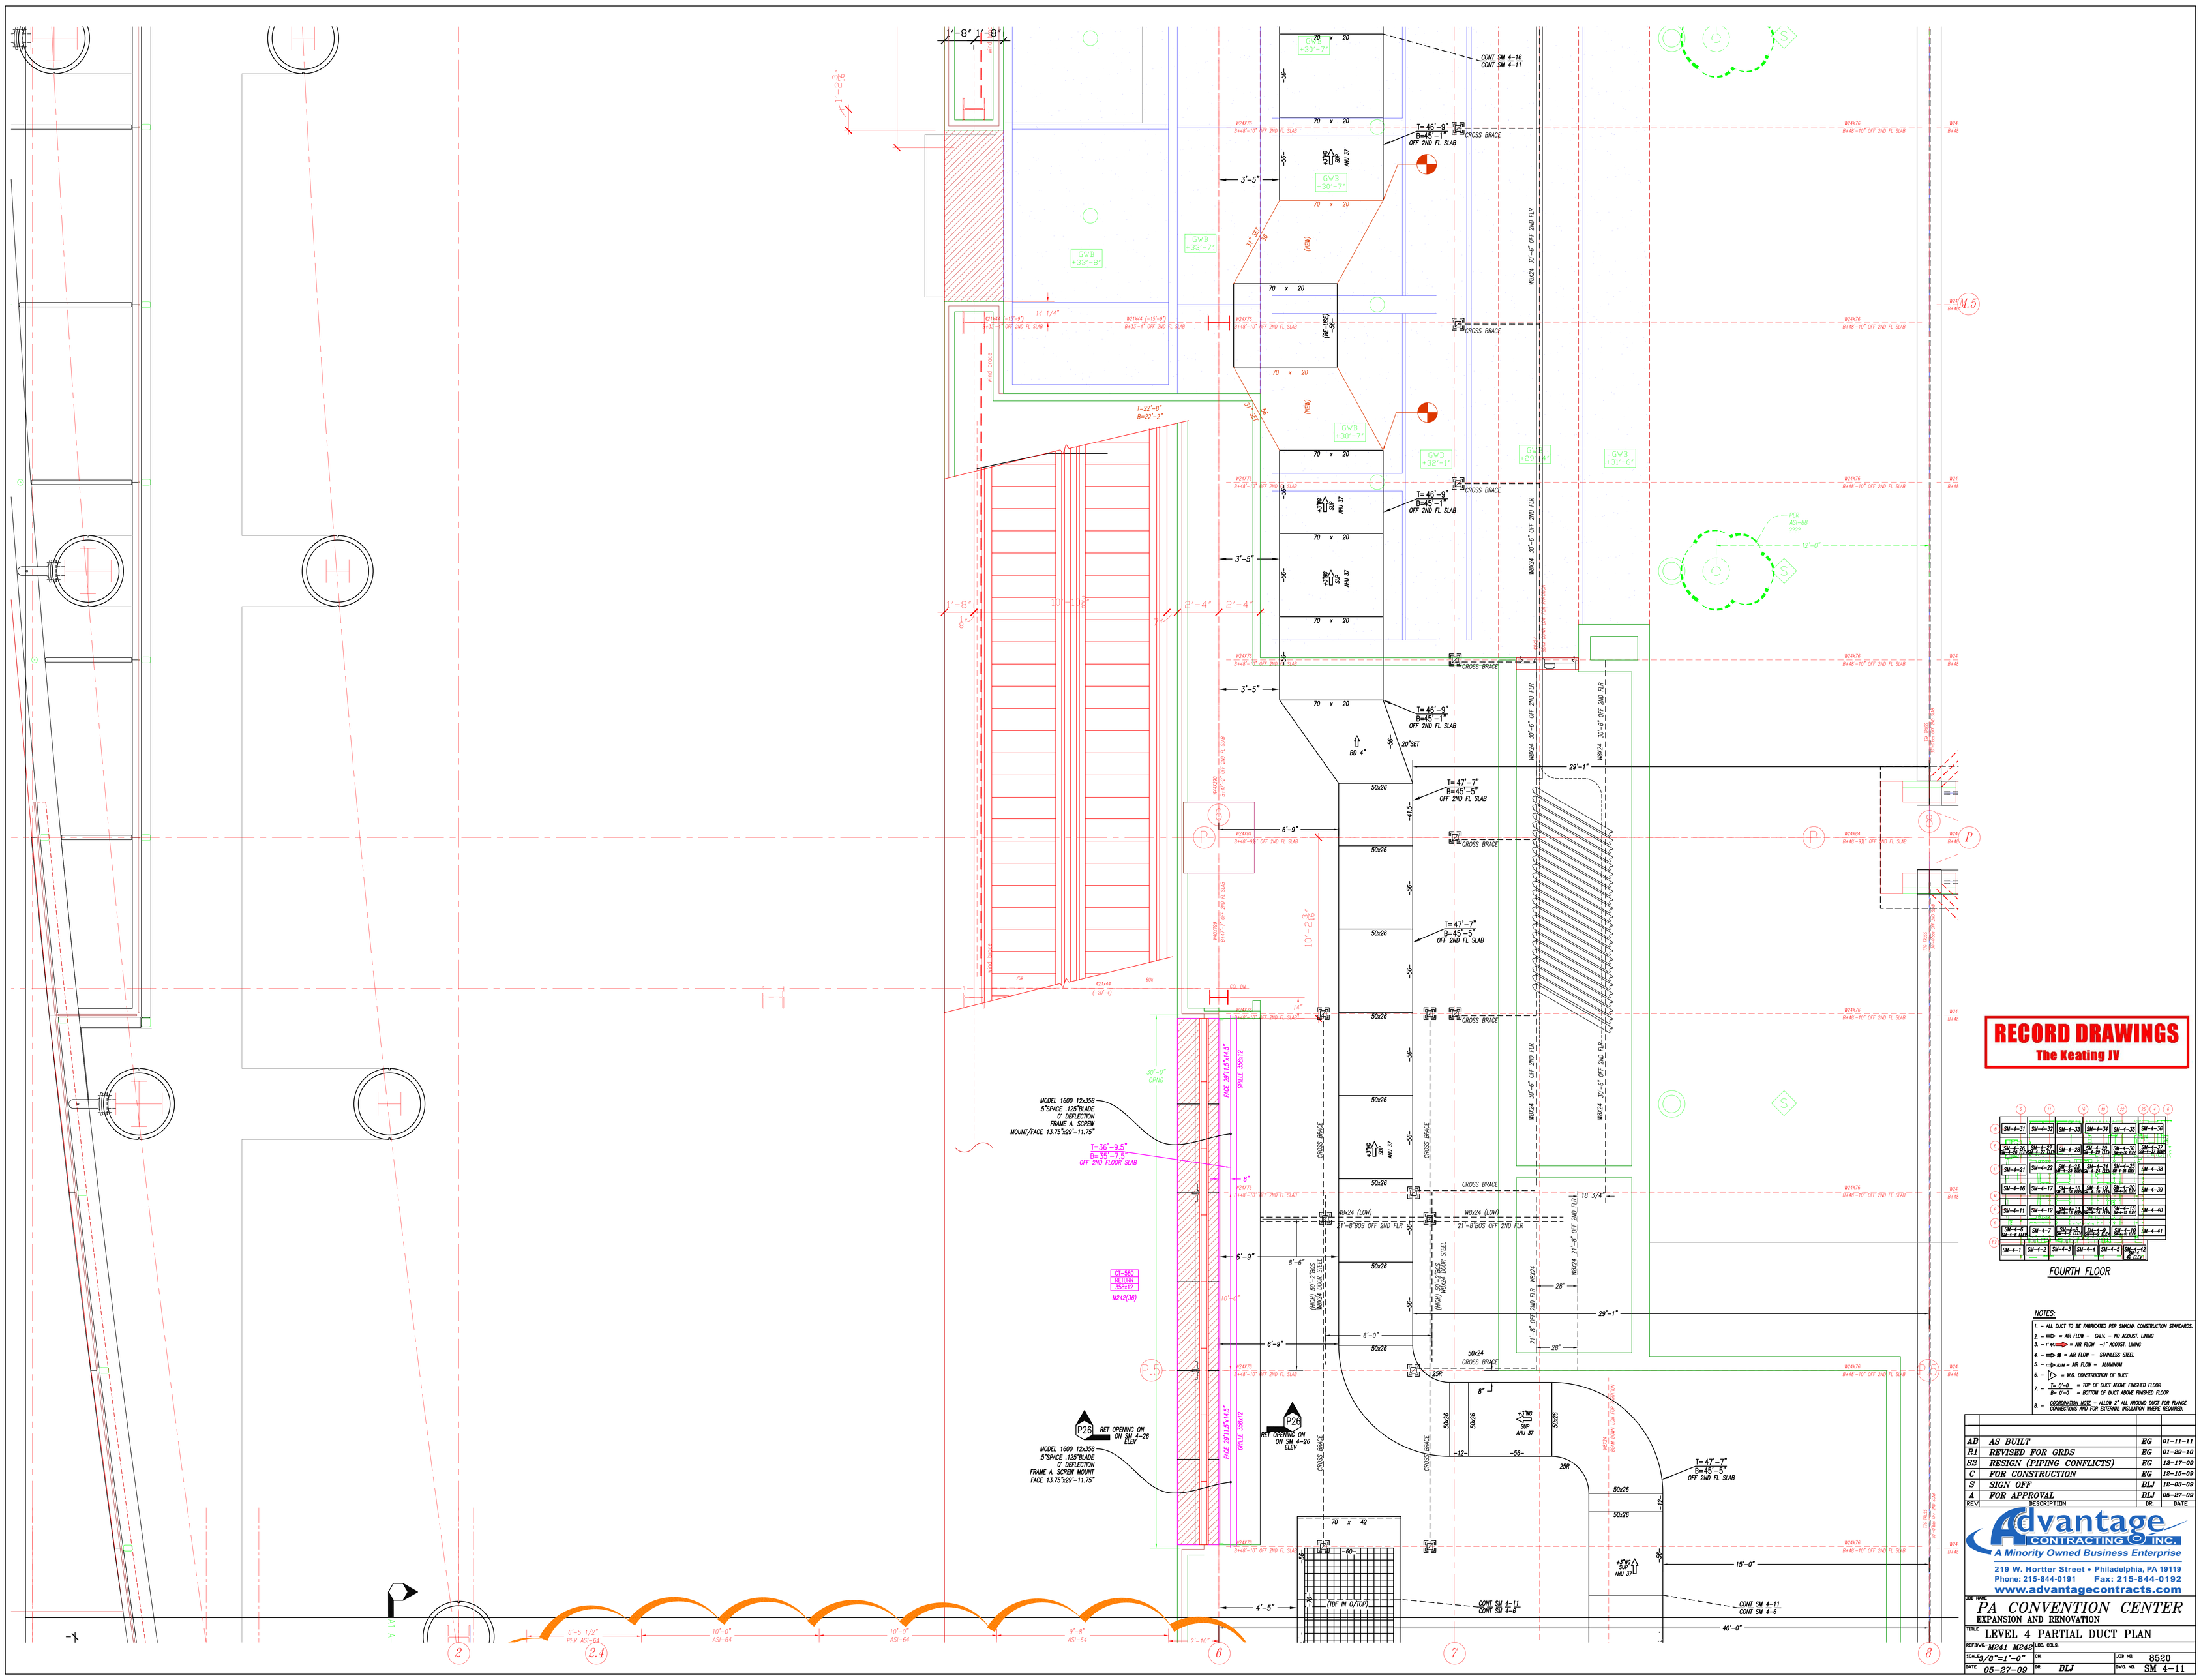

NOTES:

1. – ALL DUCT TO BE FABRICATED PER SMACNA CONSTRUCTION STANDARDS.
2. – <G> = AIR FLOW – GALV. – NO ACOUST. LINING
3. – <A> = AIR FLOW –1" ACOUST. LINING
4. – <SS> IN = AIR FLOW – STAINLESS STEEL
5. – <AL> ALUM = AIR FLOW – ALUMINUM
6. – ▷ = W.G. CONSTRUCTION OF DUCT
7. – Tx 0'-0" = TOP OF DUCT ABOVE FINISHED FLOOR; Bx 0'-0" = BOTTOM OF DUCT ABOVE FINISHED FLOOR
8. – COORDINATION NOTE – ALLOW 2" ALL AROUND DUCT FOR FLANGE CONNECTIONS AND FOR EXTERNAL INSULATION WHERE REQUIRED.

REV'I	DESCRIPTION	DR.	DATE
AB	AS BUILT	EG	01-11-11
R1	REVISED FOR GRDS	EG	01-29-10
S2	RESIGN (PIPING CONFLICTS)	EG	12-17-09
C	FOR CONSTRUCTION	EG	12-16-09
S	SIGN OFF	BLJ	12-03-09
A	FOR APPROVAL	BLJ	05-27-09

Advantage CONTRACTING INC.
A Minority Owned Business Enterprise
219 W. Hortter Street • Philadelphia, PA 19119
Phone: 215-844-0191 Fax: 215-844-0192
www.advantagecontracts.com

JOB NAME: PA CONVENTION CENTER
EXPANSION AND RENOVATION

TITLE: LEVEL 4 PARTIAL DUCT PLAN

REF. DWGS:	M241 M242	LOC. COLS	
SCALE:	3/8"=1'-0"	CH.	JOB NO. 8520
DATE:	05-27-09	DR. BLJ	DWG. NO. SM 4-11

T=45'-10"
B=40'-10"
OFF 2ND FL SLAB

CONT SM 4-17
CONT SM 4-12

60"ø

2'-0"

CD-9
4500 CFM
RECK/36"ø

NEW ITEM 445

SADDLE COL **=125°
36ø ~6~ & ~119~
DIFF FINISH AT +29'-9"

~10'-0"~

42'-0"

60"ø

~14~

52"ø

T= 45'-6"
B=41'-2"
OFF 2ND FL SLAB

EXPOSED

10'-4"
2ND FLR

48x48 O.E.D.
W/W.M.S.
25000 CFM
(75000 CFM TOTAL)
TYP FOR 3

4'-0"
OFF 2ND FL SLAB

T= 37'-6"
B=33'-10"

48 x 48

96 x 80

T= 37'-6"
B=30'-10"
OFF 2ND FL SLAB

TDF IN
O/SIDE

96 x 80

48 x 48

1" PER FT

T= 37'-6"
B=33'-10"
OFF 2ND FL SLAB

96 x 80

10'-0 1/2"
TYP.

70"ø

GRV

MW 15

~6'-0"~

T= 37'-1"
B=31'-3"
OFF 2ND FL SLAB

35'-3"

MW 15

4'-0"

CONT SM 4-12
/CONT SM 4-7

ITEM 445
CD-9
4500 CFM
RECK/36"ø

SADDLE COL **=129°
36ø ~6~ & ~123~
DIFF FINISH AT +29'-9"

42"ø

6'-0"

~6'-0"~

MW 15

10'-5 1/2"

MW 15

4'-6"

CONT SM 4-12
/CONT SM 4-7

SADDLE COL **=125°
36ø ~6~ & ~119~
DIFF FINISH AT +29'-9"

42'-11 1/2"

WT6x15
X-BRACING TO
TOPCHORD(25A)

M.5

P

8

9

10

11

RECORD DRAWINGS
The Keating JV

FOURTH FLOOR

NOTES:

1. - ALL DUCT TO BE FABRICATED PER SMACNA CONSTRUCTION STANDARDS.
2. - <⊏> = AIR FLOW – GALV. – NO ACOUST. LINING
3. - <⊏1"AL> = AIR FLOW – 1" ACOUST. LINING
4. - <⊏> SS = AIR FLOW – STAINLESS STEEL
5. - <⊏> ALUM = AIR FLOW – ALUMINUM
6. - [▷] = W.G. CONSTRUCTION OF DUCT
7. - 7'-0"-0" = TOP OF DUCT ABOVE FINISHED FLOOR; 5'-9"-0" = BOTTOM OF DUCT ABOVE FINISHED FLOOR
8. - COORDINATION NOTE – ALLOW 2" ALL AROUND DUCT FOR FLANGE CONNECTIONS AND FOR EXTERNAL INSULATION WHERE REQUIRED.

REV.'D	DESCRIPTION	DR.	DATE
AB	AS BUILT	EG	01-11-11
R1	REVISED FOR GRDS	EG	01-29-10
C	FOR CONSTRUCTION	EG	11-04-09
S	SIGN OFF	BLJ	09-24-09
A	FOR APPROVAL	BLJ	09-27-09

Advantage CONTRACTING INC.
A Minority Owned Business Enterprise
219 W. Hortter Street • Philadelphia, PA 19119
Phone: 215-844-0191 Fax: 215-844-0192
www.advantagecontracts.com

JOB NAME
PA CONVENTION CENTER
EXPANSION AND RENOVATION

TITLE
LEVEL 4 PARTIAL DUCT PLAN

REF.DWGS	M241 M242	LOC. COLS.	
SCALE	3/8"=1'-0"	CH.	JOB NO. 8520
DATE	05-27-09	DR. BLJ	DWG. NO. SM 4-12

ITEM 459
EF-9
75000 CFM
140'X/36"ø

ITEM 445
EF-8
75000 CFM
140'X/36"ø

SADDLE COL **=125"
36ø ~6~ & ~119~
DIFF FINISH AT +29'-9"

SADDLE COL **=129"
36ø ~6~ & ~123~
DIFF FINISH AT +29'-9"

T=45'-10"
B=40'-10"
OFF 2ND FL SLAB

T= 45'-6"
B=41'-2"
OFF 2ND FL SLAB

T= 37'-6"
B=30'-10"
OFF 2ND FL SLAB

T= 37'-6"
B=33'-10"
OFF 2ND FL SLAB

T= 37'-1"
B=31'-3"
OFF 2ND FL SLAB

T= 36'-0"
B=32'-4"
OFF 2ND FL SLAB

T= 36'-2"
B=32'-6"
OFF 2ND FL SLAB

CONT SM 4-18
CONT SM 4-13

CONT SM 4-13
CONT SM 4-8

48x48 O.E.D.
W/W.M.S.
25000 CFM
(75000 CFM TOTAL)
TYP FOR 3

FAN LOCATIONS BY JOIST MANUFACTURER RFI#122 AND RESPONSE TO CONTRACT 1 RFI#326 WITH ATTATCHED SKETCHES

60x60 UP TO EF-9 ON ROOF

60x60 UP TO EF-10 ON ROOF

ON SM 4-8 ELEV

EXPOSED

STOP A/L

X-BRACING TO TOPCHORD(TYP)

RECORD DRAWINGS
The Keating JV

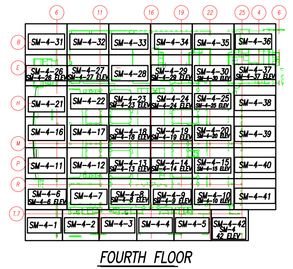

FOURTH FLOOR

NOTES:
1. – ALL DUCT TO BE FABRICATED PER SMACNA CONSTRUCTION STANDARDS.
2. – =▷= = AIR FLOW – GALV. – NO ACOUST. LINING
3. – =▷= = AIR FLOW –1" ACOUST. LINING
4. – =▷= ≡ = AIR FLOW – STAINLESS STEEL
5. – =▷= ALUM = AIR FLOW – ALUMINUM
6. – ▷ = W.G. CONSTRUCTION OF DUCT
7. – 1'-0" = TOP OF DUCT ABOVE FINISHED FLOOR
0'-0" = BOTTOM OF DUCT ABOVE FINISHED FLOOR
8. – COORDINATION NOTE – ALLOW 2" ALL AROUND DUCT FOR FLANGE CONNECTIONS AND FOR EXTERNAL INSULATION WHERE REQUIRED.

REV	DESCRIPTION	DR.	DATE
AB	AS BUILT	EG	01-11-11
R1	REVISED FOR GRDS	EG	01-29-10
C	FOR CONSTRUCTION	EG	11-04-09
S	SIGN OFF	BLJ	09-24-09
A	FOR APPROVAL	BLJ	05-28-09

Advantage CONTRACTING INC.
A Minority Owned Business Enterprise
219 W. Hortter Street • Philadelphia, PA 19119
Phone: 215-844-0191 Fax: 215-844-0192
www.advantagecontracts.com

JOB NAME: PA CONVENTION CENTER
EXPANSION AND RENOVATION

TITLE: LEVEL 4 PARTIAL DUCT PLAN

REF.DWG.- M244	LOC. COLS.		
SCALE 3/8"=1'-0"	CH.	JOB NO.	8520
DATE XX-XX-XX	DR. BLJ	DWG. NO.	SM 4-13

T= 36'-4"
B=31'-4"
OFF 2ND FL SLAB

ITEM 459
QD-9
17500 CFM
NECK/36"ø

SADDLE COL **=11"
DIFF FINISH AT 29'-9"

32 1/2"

60"ø

42'-4"
2ND FLR

52"ø

EXPOSED

8'-6"

~10'-0"

T= 36'-0"
B=31'-8"
OFF 2ND FL SLAB

~5'-0"

~1'-4"

M1.5

6'-6"

T= 36'-0"
B=31'-8"
OFF 2ND FL SLAB

15.5

15

16

17

18

P

T= 35'-7"
B=31'-1"
OFF 2ND FL SLAB

31 1/2"

~12"

42"ø

A
S ELEV

1'-6"

56'-0"

98x32 O.E.D
W/M.M.S.
18,750 CFM

7'-6 1/2"

11'-0"

FAN
MOTOR
SHED SIDE

108 x 48

(66)

60

TDF IN
D/TOP

98 x 32

15'-8 1/2"

60x60 UP
TO EF-15
ON ROOF

EF
15

FAN LOCATIONS BY JOIST
MANUFACTURER RFI#122 AND
RESPONSE TO CONTRACT 1
RFI#326 WITH ATTATCHED
SKETCHES

ON SM 4-9 ELEV

18'-10 1/2"

19'-10 1/2"

T= 35'-0"
B=31'-0"
OFF 2ND FL SLAB

15'-3 1/2"

46'-2 1/2"

42'-4"
2ND FLR

RECORD DRAWINGS
The Keating JV

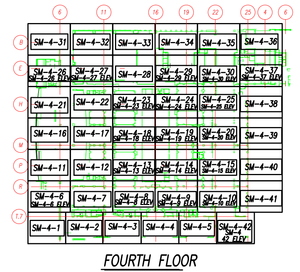

FOURTH FLOOR

NOTES:

1. – ALL DUCT TO BE FABRICATED PER SMACNA CONSTRUCTION STANDARDS.
2. – <=> = AIR FLOW – GALV. – NO ACOUST. LINING
3. – 1"=> = AIR FLOW – 1" ACOUST. LINING
4. – <=> SS = AIR FLOW – STAINLESS STEEL
5. – <=> ALM = AIR FLOW – ALUMINUM
6. – ▷ = W.G. CONSTRUCTION OF DUCT
7. – T= 0'-0" = TOP OF DUCT ABOVE FINISHED FLOOR; B= 0'-0" = BOTTOM OF DUCT ABOVE FINISHED FLOOR
8. – COORDINATION NOTE – ALLOW 3" ALL AROUND DUCT FOR FLANGE CONNECTIONS AND FOR EXTERNAL INSULATION WHERE REQUIRED.

REV	DESCRIPTION	DR.	DATE
AB	AS BUILT	EG	01-11-11
R2	REVISED FOR GRDS	EG	01-29-10
R1	REVISED LENGTHS	EG	09-18-09
C	FOR CONSTRUCTION	EG	09-14-09
S	SIGN OFF	EG	09-09-09
A	FOR APPROVAL	BLJ	05-28-09

Advantage CONTRACTING INC.
A Minority Owned Business Enterprise
219 W. Hortter Street • Philadelphia, PA 19119
Phone: 215-844-0191 Fax: 215-844-0192
www.advantagecontracts.com

JOB NAME: PA CONVENTION CENTER
EXPANSION AND RENOVATION

TITLE: LEVEL 4 PARTIAL PARTIAL PLAN

KEY DWG.- M244	LOC. COLS.		
SCALE 3/8"=1'-0"	CH.	JOB NO.	8520
DATE XX-XX-XX	DR. B JONES	DWG. NO.	SM 4-14

T=36'-4"
B=31'-4"
OFF 2ND FL SLAB

ITEM 459
EF-9
7500 CFM
NECK/36"ø

SADDLE COL **=11"
DIFF FINISH AT 29'-9"

61'-4"
2ND FLR

32 1/2"

60"ø

52"ø

EXPOSED

~14"

~10'-0"

6'-6"

T=36'-0"
B=31'-8"
OFF 2ND FL SLAB

8'-6"

T=35'-7"
B=32'-1"
OFF 2ND FL SLAB

T=35'-0"
B=31'-0"
OFF 2ND FL SLAB

T=34'-10"
B=31'-2"
OFF 2ND FL SLAB

T=34'-9"
B=31'-3"
OFF 2ND FL SLAB

42"ø

31 1/2"

~10'-

DECK TYPE "D1"

98x32 O.E.D
W/M.M.S.
18,750 CFM

FAN
MOTOR
1HP5 SOLE

108 x 48

(68)

(68)

60

7'-6 1/2"

11'-0"

TDF IN
0/TOP

60x60 UP
TO EF-19
ON ROOF

EF
19

FAN LOCATIONS BY JOIST MANUFACTURER RFI#122 AND RESPONSE TO CONTRACT 1 RFI#326 WITH ATTATCHED SKETCHES

A
ON SM 4-10 ELEV

15'-8 1/2"

18'-10 1/2"

19'-10 1/2"

15'-3 1/2"

108 x 48

98 x 32

46'-2 1/2"

30'-0"ø± OFF 2ND SLAB

19

20

21

P

RECORD DRAWINGS
The Keating JV

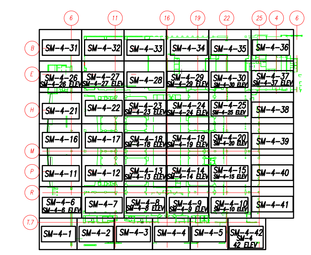

FOURTH FLOOR

NOTES:

1. - ALL DUCT TO BE FABRICATED PER SMACNA CONSTRUCTION STANDARDS.
2. - <□> = AIR FLOW = - ONLY - = NO ACOUST. LINING
3. - <□> = AIR FLOW = -1" ACOUST. LINING
4. - <□> IS = AIR FLOW = - STAINLESS STEEL
5. - <□> ALUM = AIR FLOW = - ALUMINUM
6. - [▷] = W.G. CONSTRUCTION OF DUCT
7. - Tx'-0" = TOP OF DUCT ABOVE FINISHED FLOOR; Bx'-0" = BOTTOM OF DUCT ABOVE FINISHED FLOOR
8. - COORDINATION NOTE - ALLOW 2" ALL AROUND DUCT FOR FLANGE CONNECTIONS AND FOR EXTERNAL INSULATION WHERE REQUIRED.

REV'D	DESCRIPTION	DR.	DATE
AB	AS BUILT	EG	01-11-11
R2	REVISED FOR GRDS	EG	01-29-10
R1	REVISED LENGTHS	EG	09-18-09
C	FOR CONSTRUCTION	EG	09-14-09
S	SIGN OFF	EG	09-09-09
A	FOR APPROVAL	BLJ	05-28-09

Advantage CONTRACTING INC.
A Minority Owned Business Enterprise
219 W. Hortter Street • Philadelphia, PA 19119
Phone: 215-844-0191 Fax: 215-844-0192
www.advantagecontracts.com

JOB NAME
PA CONVENTION CENTER
EXPANSION AND RENOVATION

TITLE
LEVEL 4 PARTIAL DUCT PLAN

REF.DWGS.-	244-245	LOC. COLS.	
SCALE	3/8"=1'-0"	CH.	JOB NO. 8520
DATE	XX-XX-XX	DR. BLJ	DWG. NO. SM 4-15

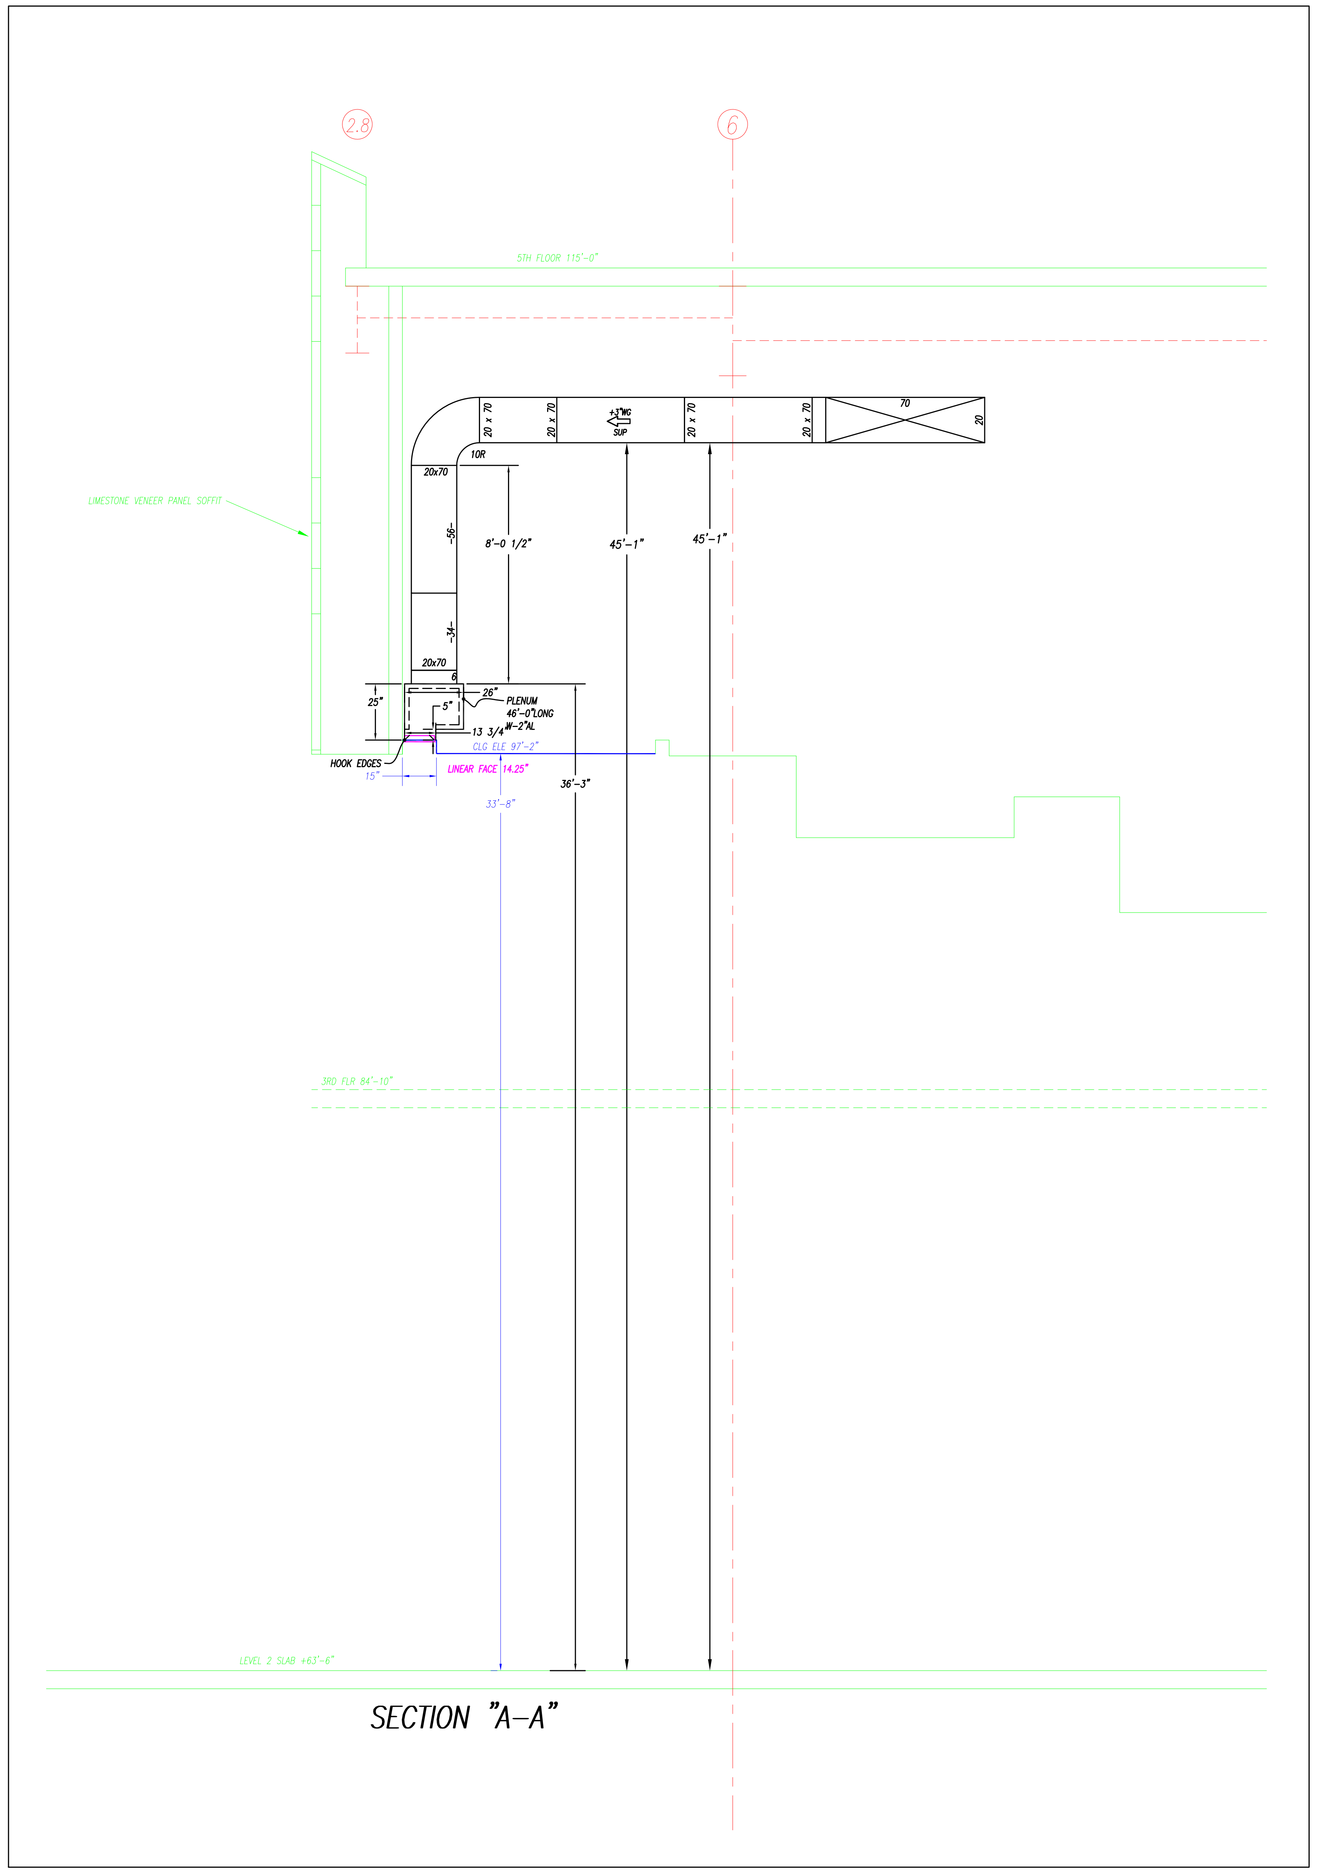

SECTION "A–A"

RECORD DRAWINGS
The Keating JV

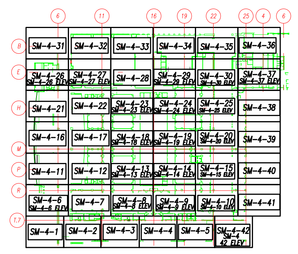

FOURTH FLOOR

NOTES:

1. – ALL DUCT TO BE FABRICATED PER SMACNA CONSTRUCTION STANDARDS.
2. – <C> = AIR FLOW – GALV. – NO ACOUST. LINING
3. – <A> = AIR FLOW – 1" ACOUST. LINING
4. – <S> SS = AIR FLOW – STAINLESS STEEL
5. – <S> ALUM = AIR FLOW – ALUMINUM
6. – ▷ = W.G. CONSTRUCTION OF DUCT
7. – 7'± 0'-0 = TOP OF DUCT ABOVE FINISHED FLOOR
   8'± 0'-0 = BOTTOM OF DUCT ABOVE FINISHED FLOOR
8. – COORDINATION NOTE – ALLOW 2" ALL AROUND DUCT FOR FLANGE CONNECTIONS AND FOR EXTERNAL INSULATION WHERE REQUIRED.

REV.	DESCRIPTION	DR.	DATE
AB	AS BUILT	BLJ	01-11-11
C	FOR CONSTRUCTION	BLJ	12-15-09
A	FOR APPROVAL	BLJ	05-28-09

Advantage CONTRACTING INC.
A Minority Owned Business Enterprise
219 W. Hortter Street • Philadelphia, PA 19119
Phone: 215-844-0191 Fax: 215-844-0192
www.advantagecontracts.com

JOB NAME: PA CONVENTION CENTER
EXPANSION AND RENOVATION

TITLE: LEVEL 4 DUCT ELEVATIONS

REF. DWGS.- SM 4-16	LOC. COLS.		
SCALE 3/8"=1'-0"	CH.	JOB NO.	8520
DATE 05-28-09	DR. BLJ	DWG. NO.	SM 4-16 ELEV

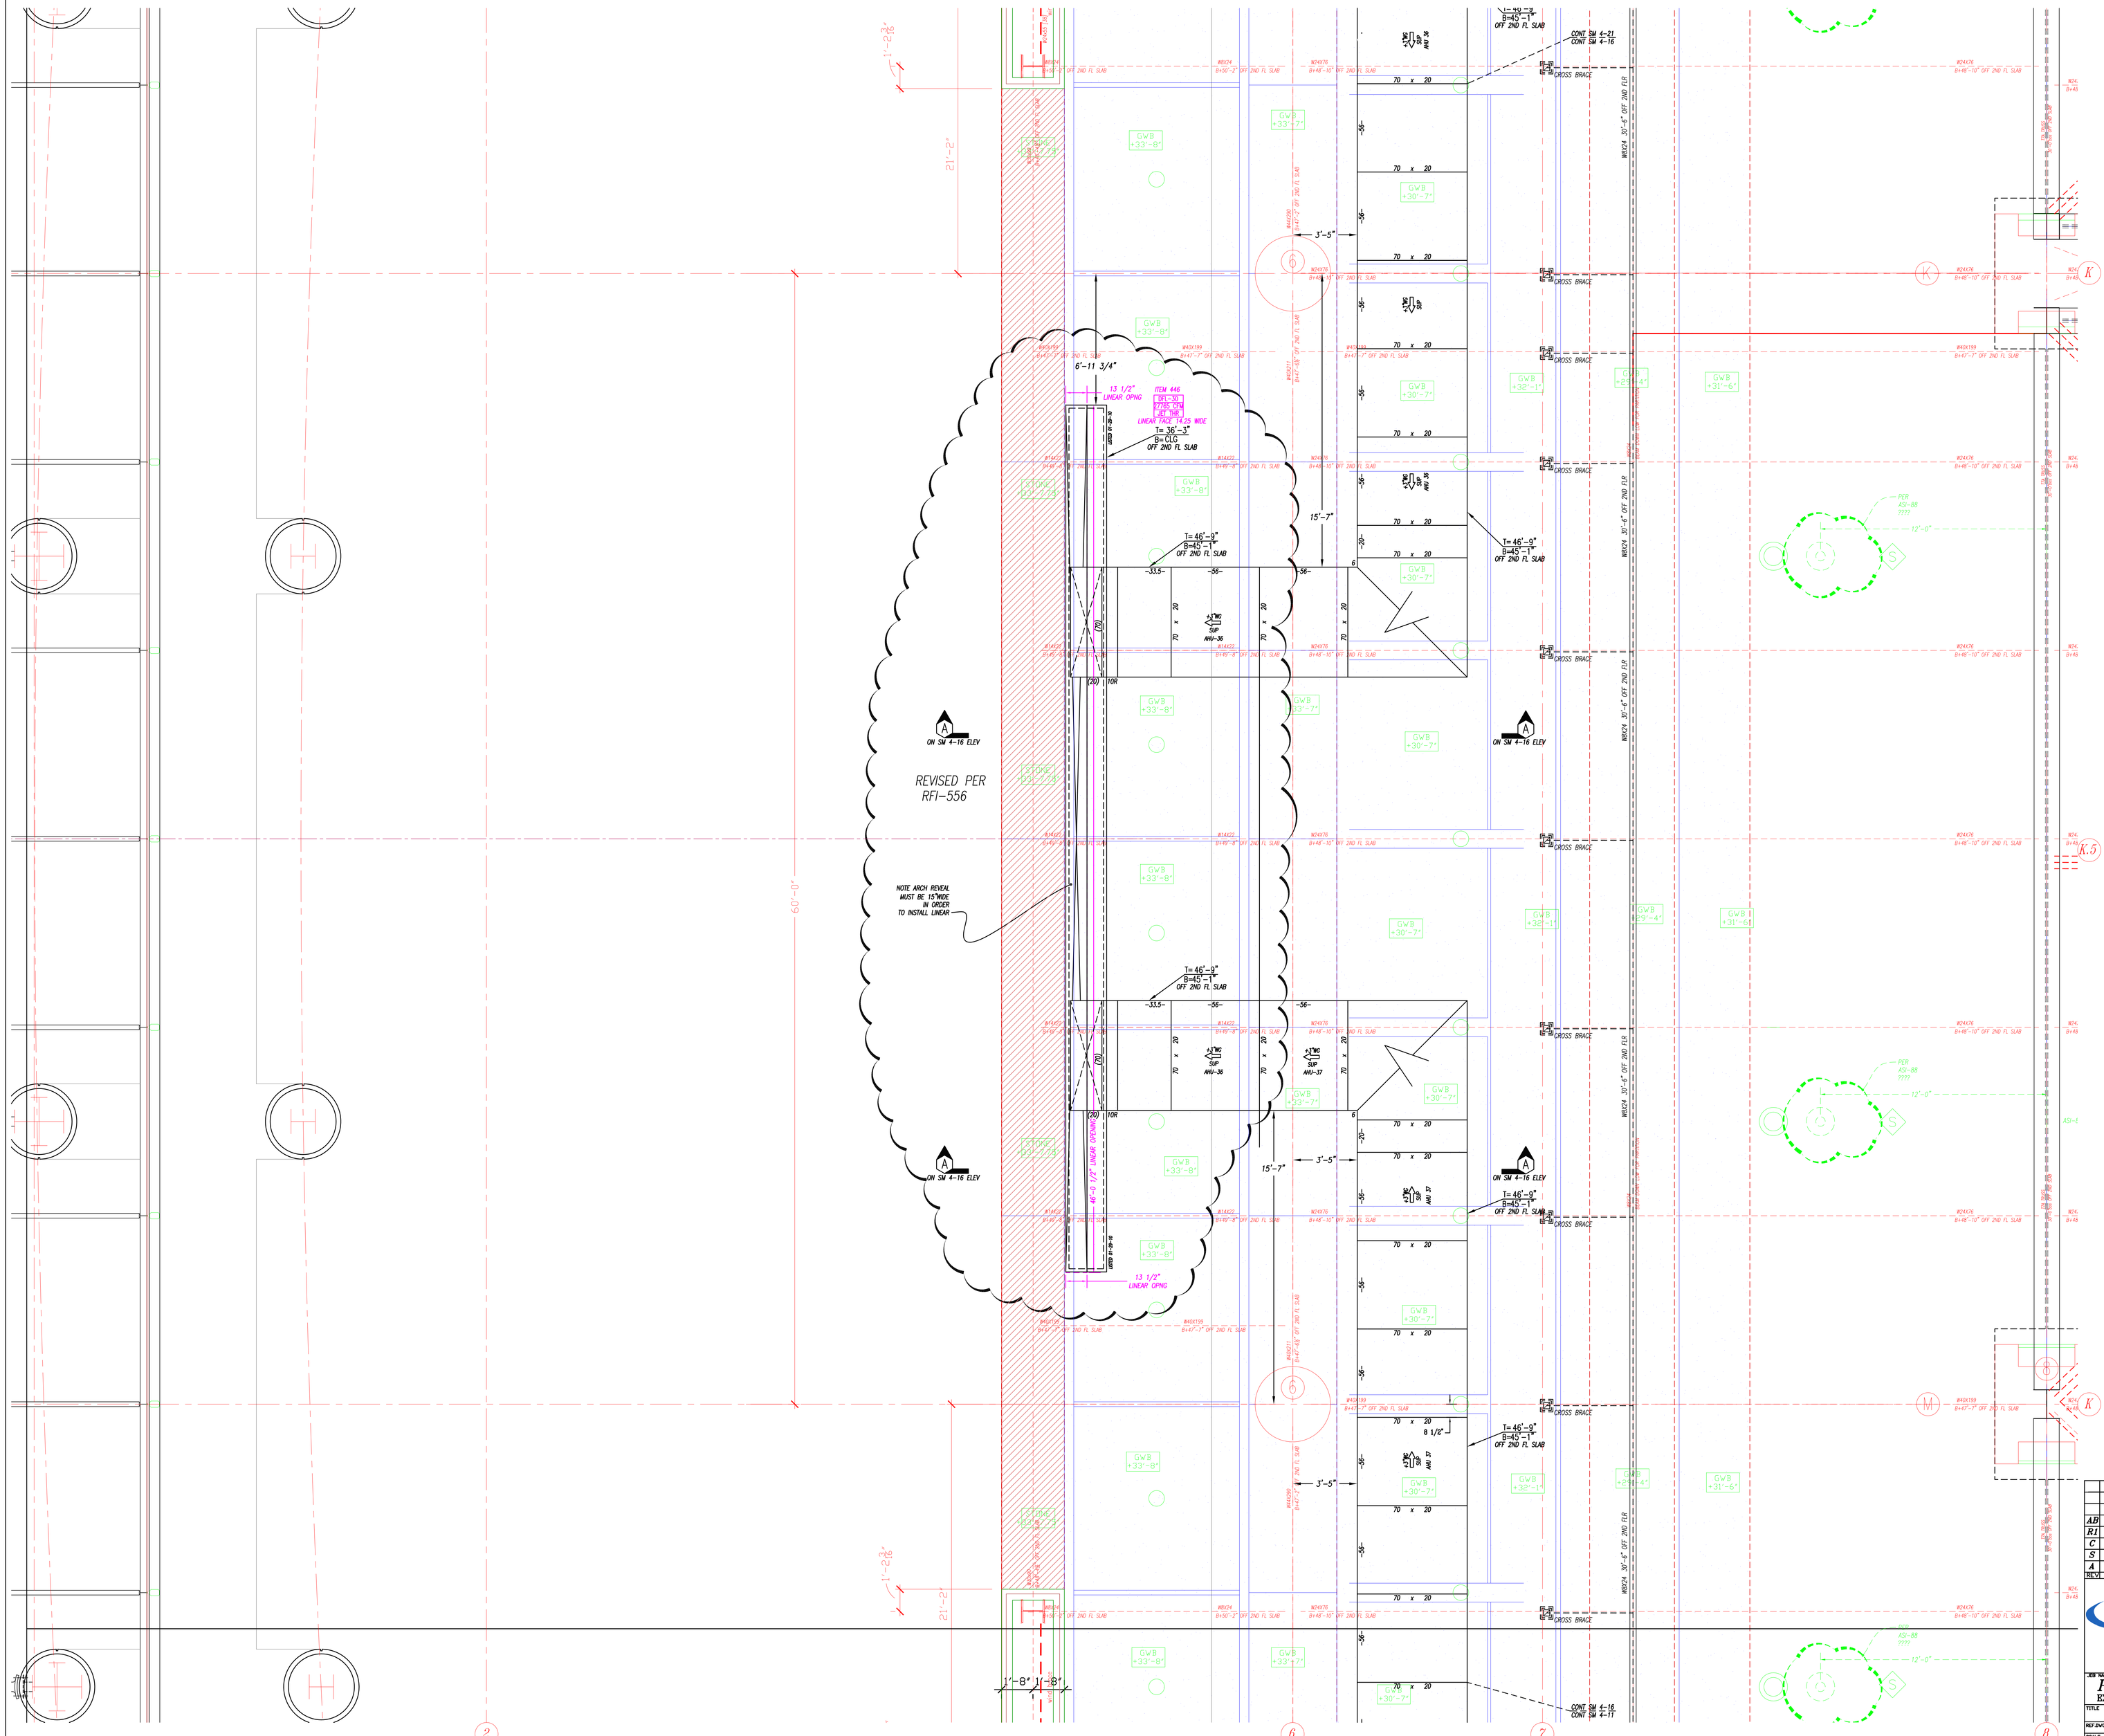

RECORD DRAWINGS
The Keating JV

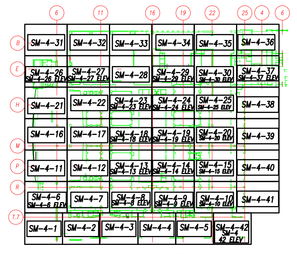

FOURTH FLOOR

NOTES:

1. - ALL DUCT TO BE FABRICATED PER SMACNA CONSTRUCTION STANDARDS.
2. - <=> = AIR FLOW - GALV. - NO ACOUST. LINING
3. - <=> = AIR FLOW - 1" ACOUST. LINING
4. - <=> = AIR FLOW - STAINLESS STEEL
5. - <=> = AIR FLOW - ALUMINUM
6. - ▷ = W.G. CONSTRUCTION OF DUCT
7. - T= 0'-0" = TOP OF DUCT ABOVE FINISHED FLOOR
   B= 0'-0" = BOTTOM OF DUCT ABOVE FINISHED FLOOR
8. - COORDINATION NOTE - ALLOW 3" ALL AROUND DUCT FOR FLANGE CONNECTIONS AND FOR EXTERNAL INSULATION WHERE REQUIRED.

REV	DESCRIPTION	DR.	DATE
AB	AS BUILT	EG	01-11-11
R1	REVISED FOR GRDS	EG	01-29-10
C	FOR CONSTRUCTION	EG	12-15-09
S	SIGN OFF	BLJ	12-03-09
A	FOR APPROVAL	BLJ	05-28-09

Advantage CONTRACTING © INC.
A Minority Owned Business Enterprise
219 W. Hortter Street • Philadelphia, PA 19119
Phone: 215-844-0191 Fax: 215-844-0192
www.advantagecontracts.com

JOB NAME: PA CONVENTION CENTER
EXPANSION AND RENOVATION

TITLE: LEVEL 4 PARTIAL DUCT PLAN

REF. DWG.- M-241	LOC. COLS.		
SCALE: 3/8"=1'-0"	CH.	JOB NO.	8520
DATE: XX-XX-XX	DR. BLJ	DWG. NO.	SM 4-16

ITEM 445
GS-8
7500 CFM
NCV.75# ø

CONT SM 4-22
CONT SM 4-17

3'-6 1/2"

9'-5 1/2"

-8'-0"

EXPOSED

4'-0"

68"ø

OFF 2ND FL SLAB

18'-7"
OFF COLUMN K

9'-5"

4'-6"

T=46'-2"
B=40'-6"
OFF 2ND FL SLAB

T=45'-10"
B=40'-10"
OFF 2ND FL SLAB

SM 4-15
SM 4-16
AND 15

62'-4"
2ND FLR

ASI-88 SHOWS THIS ROW LIGHTS
MOVING OVER 36" 18'-0"
OFF COLUMN LINE 8

3'-0"

SADDLE COL **=121"
36ø =6~ & =115~
DIFF FINISH AT +29'-9"

5'-2 1/2"

18"

30"

6'-2 1/2"

3'-8 1/2"

60"ø

~7'-0"

~10'-0"

17'-0"

17'-0 1/2"

CONT SM 4-17
CONT SM 4-12

WT6x15
X-BRACING TO
TOPCHORD(25k)

SADDLE COL **=121"
36ø =6~ & =115~
DIFF FINISH AT +29'-9"

OFF 2ND FL SLAB

OF

SADDLE COL **=121"
36ø =6~ & =115~
DIFF

RECORD DRAWINGS
The Keating JV

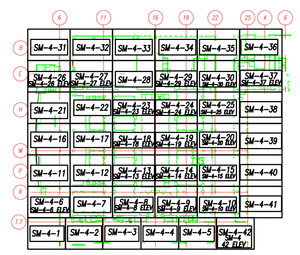

FOURTH FLOOR

NOTES:

1. = ALL DUCT TO BE FABRICATED PER SMACNA CONSTRUCTION STANDARDS.
2. = <C> = AIR FLOW – GALV. – NO ACOUST. LINING
3. = <AL> = AIR FLOW –1" ACOUST. LINING
4. = <SS> = AIR FLOW – STAINLESS STEEL
5. = <AL> ALUM = AIR FLOW – ALUMINUM
6. = [▷] = W.G. CONSTRUCTION OF DUCT
7. = 7= 67'-0 = TOP OF DUCT ABOVE FINISHED FLOOR
   B= 0'-0 = BOTTOM OF DUCT ABOVE FINISHED FLOOR
8. = COORDINATION NOTE – ALLOW 2" ALL AROUND DUCT FOR FLANGE CONNECTIONS AND FOR EXTERNAL INSULATION WHERE REQUIRED.

REV.	DESCRIPTION	BR.	DATE
AB	AS BUILT	EG	01-11-11
R1	REVISED FOR GRDS	EG	01-29-10
C	FOR CONSTRUCTION	EG	11-02-09
S	SIGN OFF	BLJ	09-24-09
A	FOR APPROVAL	BLJ	05-28-09

Advantage CONTRACTING INC.
A Minority Owned Business Enterprise
219 W. Hortter Street • Philadelphia, PA 19119
Phone: 215-844-0191 Fax: 215-844-0192
www.advantagecontracts.com

JOB NAME
PA CONVENTION CENTER
EXPANSION AND RENOVATION

TITLE
LEVEL 4 PARTIAL DUCT PLAN

REF DWG- M244	LOC. COLS.		
SCALE 3/8"=1'-0"	CH.	JOB NO.	8520
DATE 05-28-09	DR. BLJ	DWG. NO.	SM 4-17

8 9 10 11

CI-9
7500 CFM
HCK/36"ø

CONT SM 4-23
CONT SM 4-18

SADDLE COL **=121"
36ø ~6~ & ~115~
DIFF FINISH AT +29'-9"

3'-6 1/2"

18'-7"
OFF COLUMN K

B=31 -3
OFF 2ND FL SLAB

(36"ø)

7'-7"

EXPOSED

68"ø

5'-0"

~8'-0"~

~10'-0"~

W30X116
B+48'-4" OFF 2ND SLAB

W24X68
B+48'-10" OFF 2ND SLAB

W12X16
B+49'-10" OFF 2ND SLAB

W16X26
B+49'-4" OFF 2ND SLAB

B=31 -9

B=31 -4

B=31 -5
OFF 2ND FL SLAB

14'-7"
OFF COLUMN K

A
ON SM 4-8 ELEV

T= 36'-2"
B=32'-2"
OFF 2ND FL SLAB

TDF IN
O/TOP

60

48

FAN
MOTOR
THIS SIDE

60x60 UP
TO EF-8
ON ROOF

EF
8

11'-0"

25'-0 1/2"

6'-5"

FAN LOCATIO
MANUFACTUR
RESPONSE i
RFI#326 WIT
SKETCHES

15

16

13.3

K

K.5

K.6

M

13.8

14

14.7

15

68DLH19

68DLH18

CI-9
7500 CFM
HCK/36"ø
ITEM 445

ITEM 459

T=46'-2"
B=40'-6"
OFF 2ND FL SLAB

T=45'-10"
B=40'-10"
OFF 2ND FL SLAB

W16x15
X-BRACING TO
TOP(HORIZ)(25k)

6'-11 1/2"

60"ø

CONT SM 4-18
CONT SM 4-13

12

13

RECORD DRAWINGS
The Keating JV

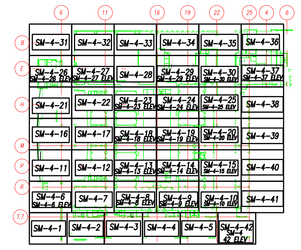

FOURTH FLOOR

NOTES:

1. - ALL DUCT TO BE FABRICATED PER SMACNA CONSTRUCTION STANDARDS.
2. - <G> = AIR FLOW - GALV. - NO ACOUST. LINING
3. - <A> = AIR FLOW -1" ACOUST. LINING
4. - <SS> = AIR FLOW - STAINLESS STEEL
5. - <AL> = AIR FLOW - ALUMINUM
6. - ▷ = W.G. CONSTRUCTION OF DUCT
7. - Te 0'-0" = TOP OF DUCT ABOVE FINISHED FLOOR
   Be 0'-0" = BOTTOM OF DUCT ABOVE FINISHED FLOOR
8. - COORDINATION NOTE - ALLOW 2" ALL AROUND DUCT FOR FLANGE CONNECTIONS AND FOR EXTERNAL INSULATION WHERE REQUIRED.

REV.	DESCRIPTION	DR.	DATE
AB	AS BUILT	EG	01-11-11
R1	REVISED FOR GRDS	EG	01-29-10
C	FOR CONSTRUCTION	EG	11-02-09
S	SIGN OFF	BLJ	09-24-09
A	FOR APPROVAL	BLJ	05-28-09

Advantage CONTRACTING INC.
A Minority Owned Business Enterprise
219 W. Hortter Street • Philadelphia, PA 19119
Phone: 215-844-0191 Fax: 215-844-0192
www.advantagecontracts.com

JOB NAME
PA CONVENTION CENTER
EXPANSION AND RENOVATION

TITLE
LEVEL 4 PARTIAL DUCT PLAN

REF.DWG.- M244 M241	LOC. COLS.		
SCALE 3/8"=1'-0"	CH.	JOB NO.	8520
DATE 05-28-09	DR. BLJ	DWG. NO.	SM 4-18

LOCATIONS BY JOIST
FACTURER RFI#122 AND
ONSE TO CONTRACT 1
26 WITH ATTATCHED
CHES

A
8 ELEV

B=80'-10"
OFF 2ND FL SLAB

SADDLE COL **=5"
DIFF FINISH AT 29'-9"

ITEM 459
CD-9
7500 CFM
HEXX/36"W

32 1/2"

72"ø

68"ø

~1'-0"

~8'-0"

~10'-0"

61'-4"
2ND FLR

B=80'-10"
OFF 2ND FL SLAB

SADDLE COL **=5"
DIFF FINISH AT 29'-9"

ON SM 4-9 ELEV

ITEM 459
CD-9
7500 CFM
HEXX/36"W

32 1/2"

72"ø

68"ø

10 EJ-14
ON ROOF

EF
14

11'-0"

7'-4 1/2"

TDF IN
D/TOP

(66)

18

60

FAN
MOTOR
108 x 48
THIS SIDE

90x32 O.E.D
W/M.M.S.
18,750 CFM

T= 35'-0"
B=31'-0"
OFF 2ND FL SLAB

A
11'-0"
ON SM 4-9 ELEV

15'-3 1/2"

15'-8 1/2"

FAN LOCATIONS BY JOIST MANUFACTURER RFI#122 AND RESPONSE TO CONTRACT 1 RFI#326 WITH ATTATCHED SKETCHES

16 17 18

K

6'-6"

8'-6"

EXPOSED

T= 36'-8"
B=31'-0"
OFF 2ND FL SLAB

T= 36'-4"
B=31'-4"
OFF 2ND FL SLAB

CD-9
7500 CFM
HEXX/36"W

ITEM 459

SADDLE COL **=7"
DIFF FINISH AT 29'-9"

33 1/2"

68"ø

60"ø

68DLH18 68DLH18 68DLH18 68DLH18 68DLH18 68DLH19 68DLH19 68DLH19 68DLH19 68PLH18 68PLH18

15.3 16 17 18

RECORD DRAWINGS
The Keating JV

FOURTH FLOOR

NOTES:
1. – ALL DUCT TO BE FABRICATED PER SMACNA CONSTRUCTION STANDARDS.
2. – <=> = AIR FLOW – GALV. – NO ACOUST. LINING
3. – <=> = AIR FLOW –1" ACOUST. LINING
4. – <=> SS = AIR FLOW – STAINLESS STEEL
5. – <=> ALUM = AIR FLOW – ALUMINUM
6. – [▷] = W.G. CONSTRUCTION OF DUCT
7. – 1x 0'-0 = TOP OF DUCT ABOVE FINISHED FLOOR
B= 0'-0 = BOTTOM OF DUCT ABOVE FINISHED FLOOR
8. – COORDINATION NOTE – ALLOW 2" ALL AROUND DUCT FOR FLANGE CONNECTIONS AND FOR EXTERNAL INSULATION WHERE REQUIRED.

REV.	DESCRIPTION	DR.	DATE
AB	AS BUILT	EG	01-11-11
R2	REVISED FOR GRDS	EG	01-29-10
R1	REVISED LENGTHS	EG	09-16-09
C	FOR CONSTRUCTION	EG	09-15-09
S	SIGN OFF	EG	09-09-09
A	FOR APPROVAL	BLJ	05-28-09

Advantage CONTRACTING INC.
A Minority Owned Business Enterprise
219 W. Hortter Street • Philadelphia, PA 19119
Phone: 215-844-0191 Fax: 215-844-0192
www.advantagecontracts.com

JOB NAME
PA CONVENTION CENTER
EXPANSION AND RENOVATION

TITLE
LEVEL 4 PARTIAL DUCT PLAN

REF. DWG.-	M244	LOC. COLS.	
SCALE	3/8"=1'-0"	CK.	JOB NO. 8520
DATE	XX-XX-XX	DR. BLJ	DWG. NO. SM 4-19

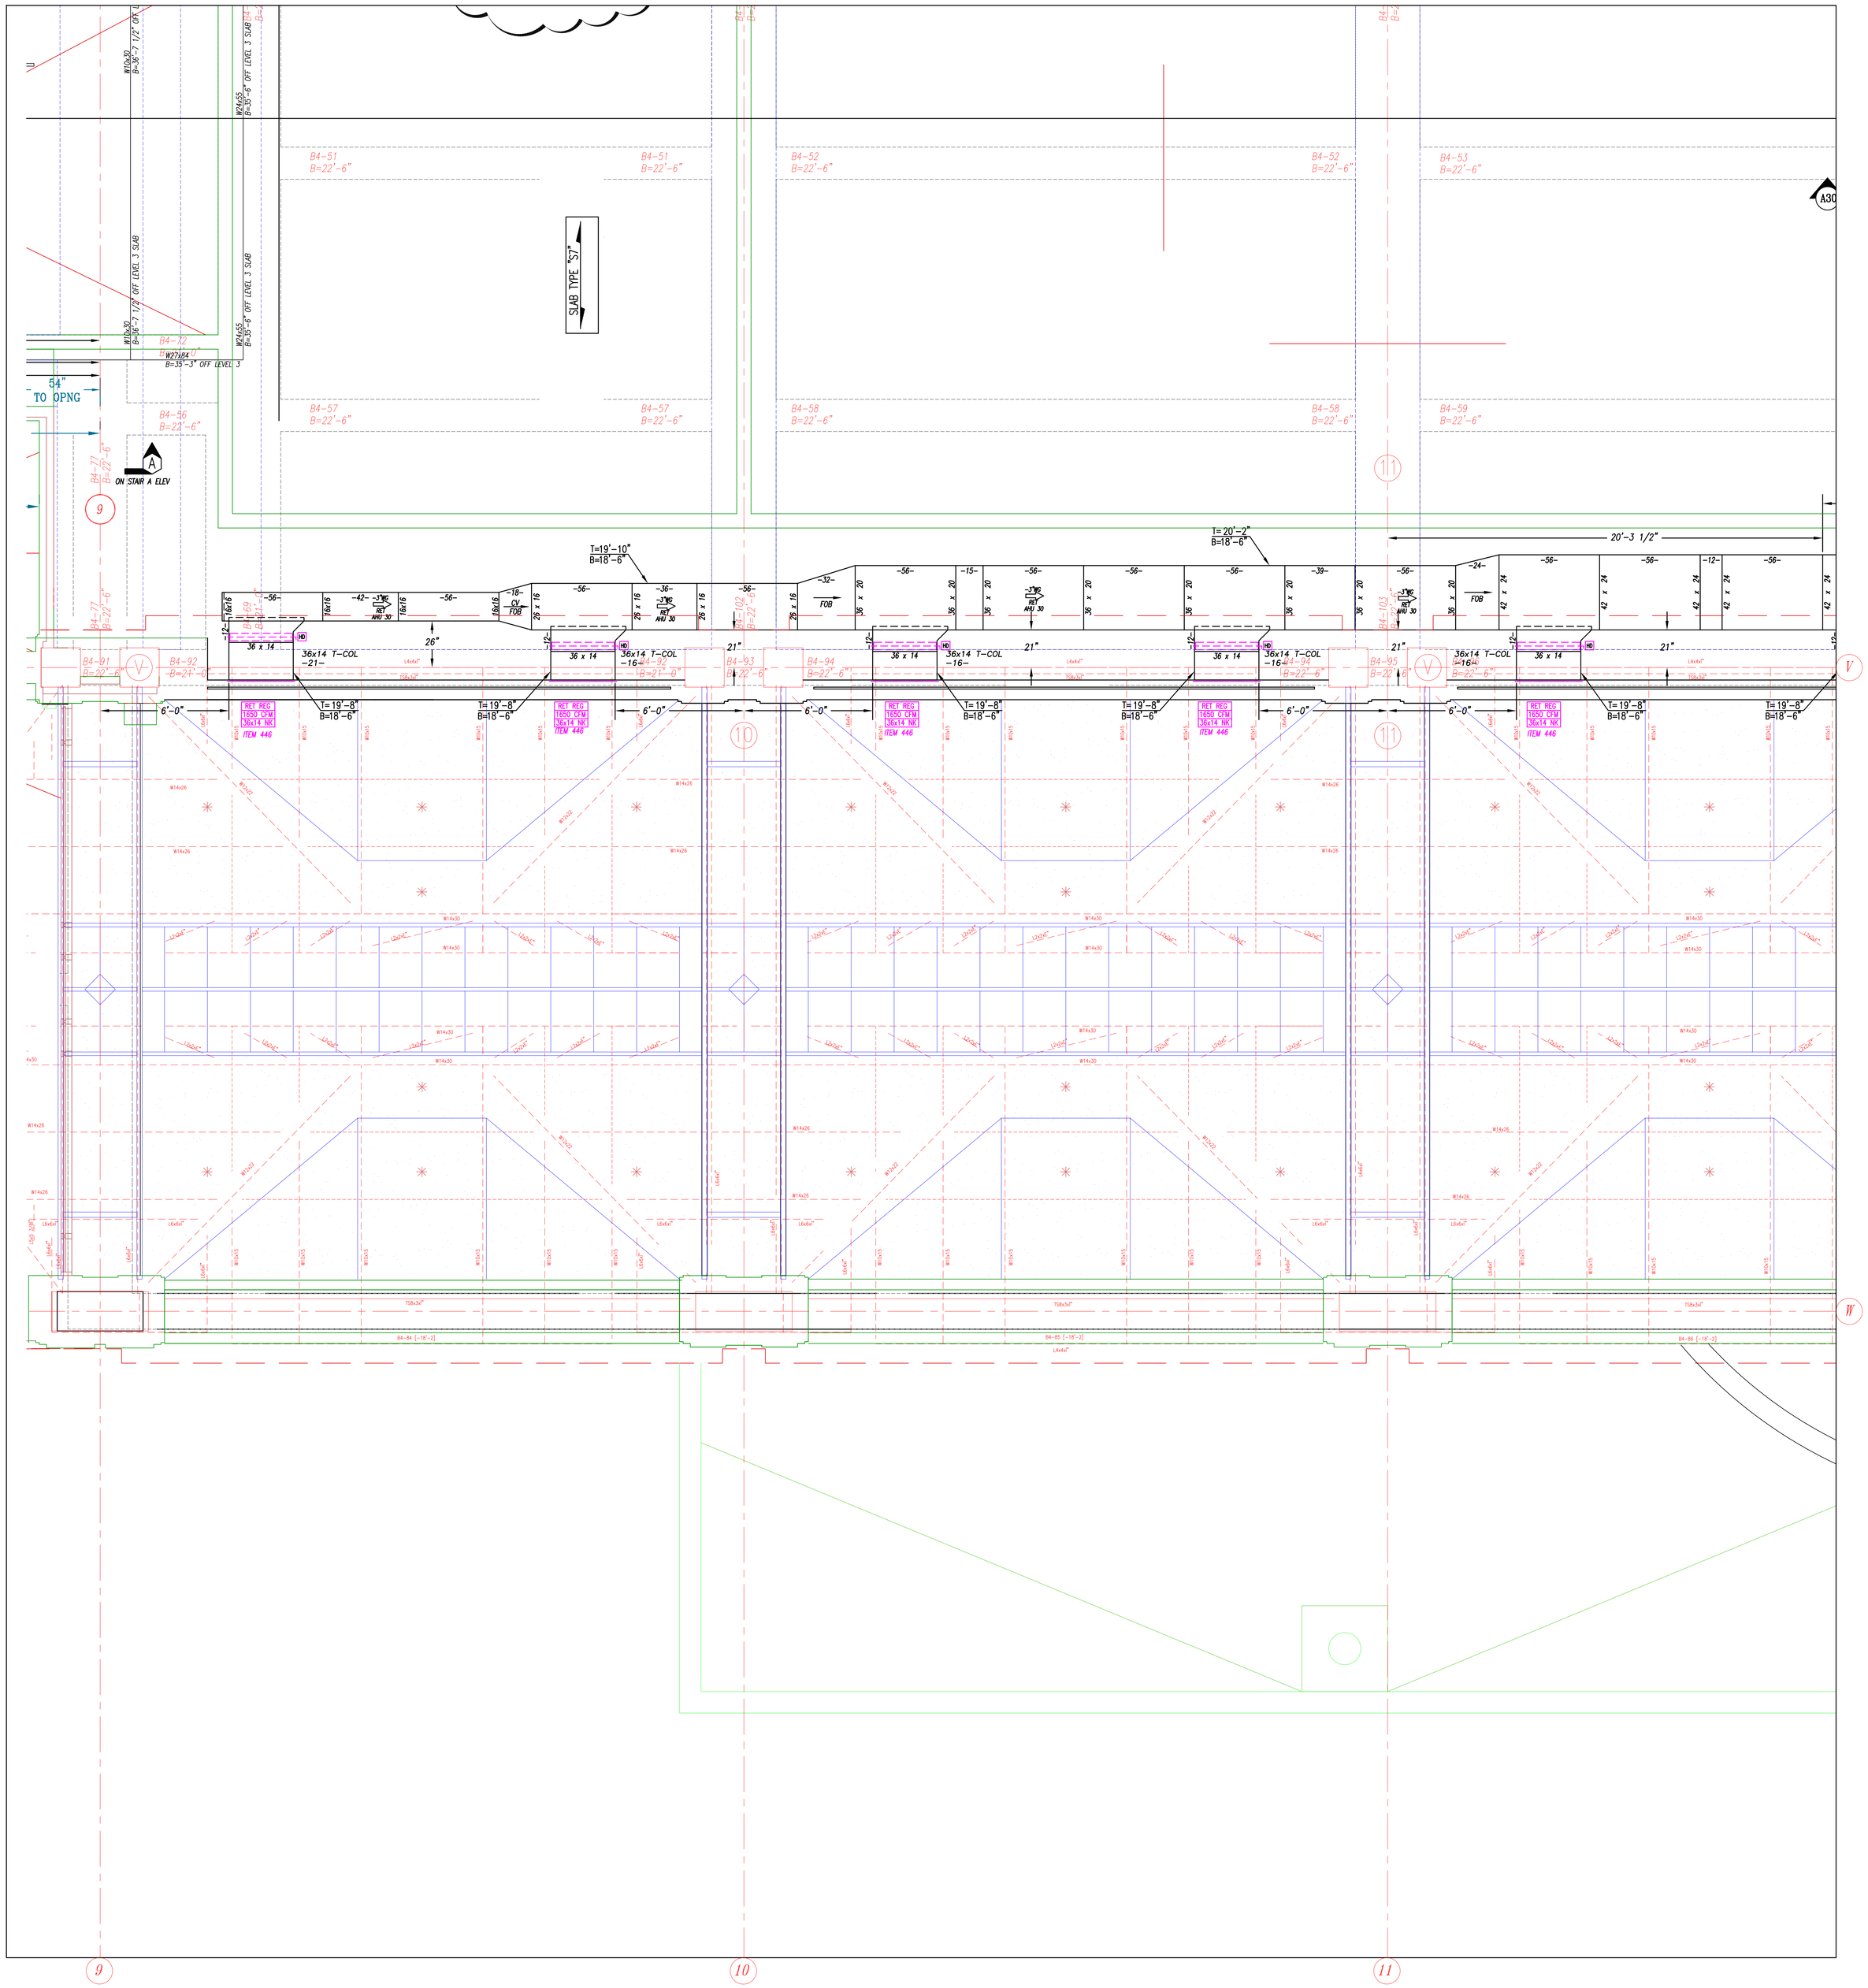

FOURTH FLOOR

RECORD DRAWINGS
The Keating JV

NOTES:

1. – ALL DUCT TO BE FABRICATED PER SMACNA CONSTRUCTION STANDARDS.
2. – <G> = AIR FLOW – GALV. – NO ACOUST. LINING
3. – <R1> = AIR FLOW – 1" ACOUST. LINING
4. – <SS> = AIR FLOW – STAINLESS STEEL
5. – <AL> = AIR FLOW – ALUMINUM
6. – ▷ = W.G. CONSTRUCTION OF DUCT
7. – 1'-0" / 0'-0" = TOP OF DUCT ABOVE FINISHED FLOOR / BOTTOM OF DUCT ABOVE FINISHED FLOOR
8. – COORDINATION NOTE – ALLOW 1" ALL AROUND DUCT FOR FLANGE CONNECTIONS AND FOR EXTERNAL INSULATION WHERE REQUIRED.

REV	DESCRIPTION	DR.	DATE
AR	AS BUILT	EG	01-11-11
R1	REVISED FOR GRDS	EG	01-09-09
C	FOR CONSTRUCTION	EG	11-04-09
S	SIGN-OFF	BLJ	07-16-09
A	FOR APPROVAL	BLJ	05-19-09

Advantage CONTRACTING INC.
A Minority Owned Business Enterprise
219 W. Hortter Street • Philadelphia, PA 19119
Phone: 215-844-0191 Fax: 215-844-0192
www.advantagecontracts.com

JOB NAME: PA CONVENTION CENTER
EXPANSION AND RENOVATION

TITLE: LEVEL 4 PARTIAL DUCT PLAN

REF. DWG.– M242	LOC. COLS.		
SCALE 3/8"=1'-0"	CH.	JOB NO.	8520
DATE XX-XX-XX	DR. BLJ	DWG. NO.	SM 4-2

FAN LOCATIONS BY JOIST MANUFACTURER RFI#122 AND RESPONSE TO CONTRACT 1 RFI#326 WITH ATTATCHED SKETCHES

DECK TYPE "D1"

CONFLICT

FOURTH FLOOR

RECORD DRAWINGS
The Keating JV

NOTES:
1. – ALL DUCT TO BE FABRICATED PER SMACNA CONSTRUCTION STANDARDS.
2. – <G> = AIR FLOW – GALV. – NO ACOUST. LINING
3. – <A> = AIR FLOW – 1" ACOUST. LINING
4. – <S> = AIR FLOW – STAINLESS STEEL
5. – <SA> = AIR FLOW – ALUMINUM
6. – ▷ = W.G. CONSTRUCTION OF DUCT
7. – T= 0'-0" = TOP OF DUCT ABOVE FINISHED FLOOR; B= 0'-0" = BOTTOM OF DUCT ABOVE FINISHED FLOOR
8. – COORDINATION NOTE – ALLOW 1" ALL AROUND DUCT FOR FLANGE CONNECTIONS AND FOR EXTERNAL INSULATION WHERE REQUIRED.

REV	DESCRIPTION	DR.	DATE
AB	AS BUILT	EG	01-11-11
R2	REVISED FOR GRDS	EG	01-29-10
R1	REVISED LENGTHS	EG	09-18-09
C	FOR CONSTRUCTION	EG	09-15-09
S	SIGN OFF	EG	09-09-09
A	FOR APPROVAL	BLJ	05-28-09

Advantage CONTRACTING INC.
A Minority Owned Business Enterprise
219 W. Hortter Street • Philadelphia, PA 19119
Phone: 215-844-0191 Fax: 215-844-0192
www.advantagecontracts.com

JOB NAME: PA CONVENTION CENTER
EXPANSION AND RENOVATION

TITLE: LEVEL 4 PARTIAL DUCT PLAN

KEY SYS: M244–M247	LOC. COLS.		
SCALE: 3/8"=1'-0"	CH.	JOB NO.	8520
DATE: XX-XX-XX	DR. BLJ	DWG. NO.	SM 4-20

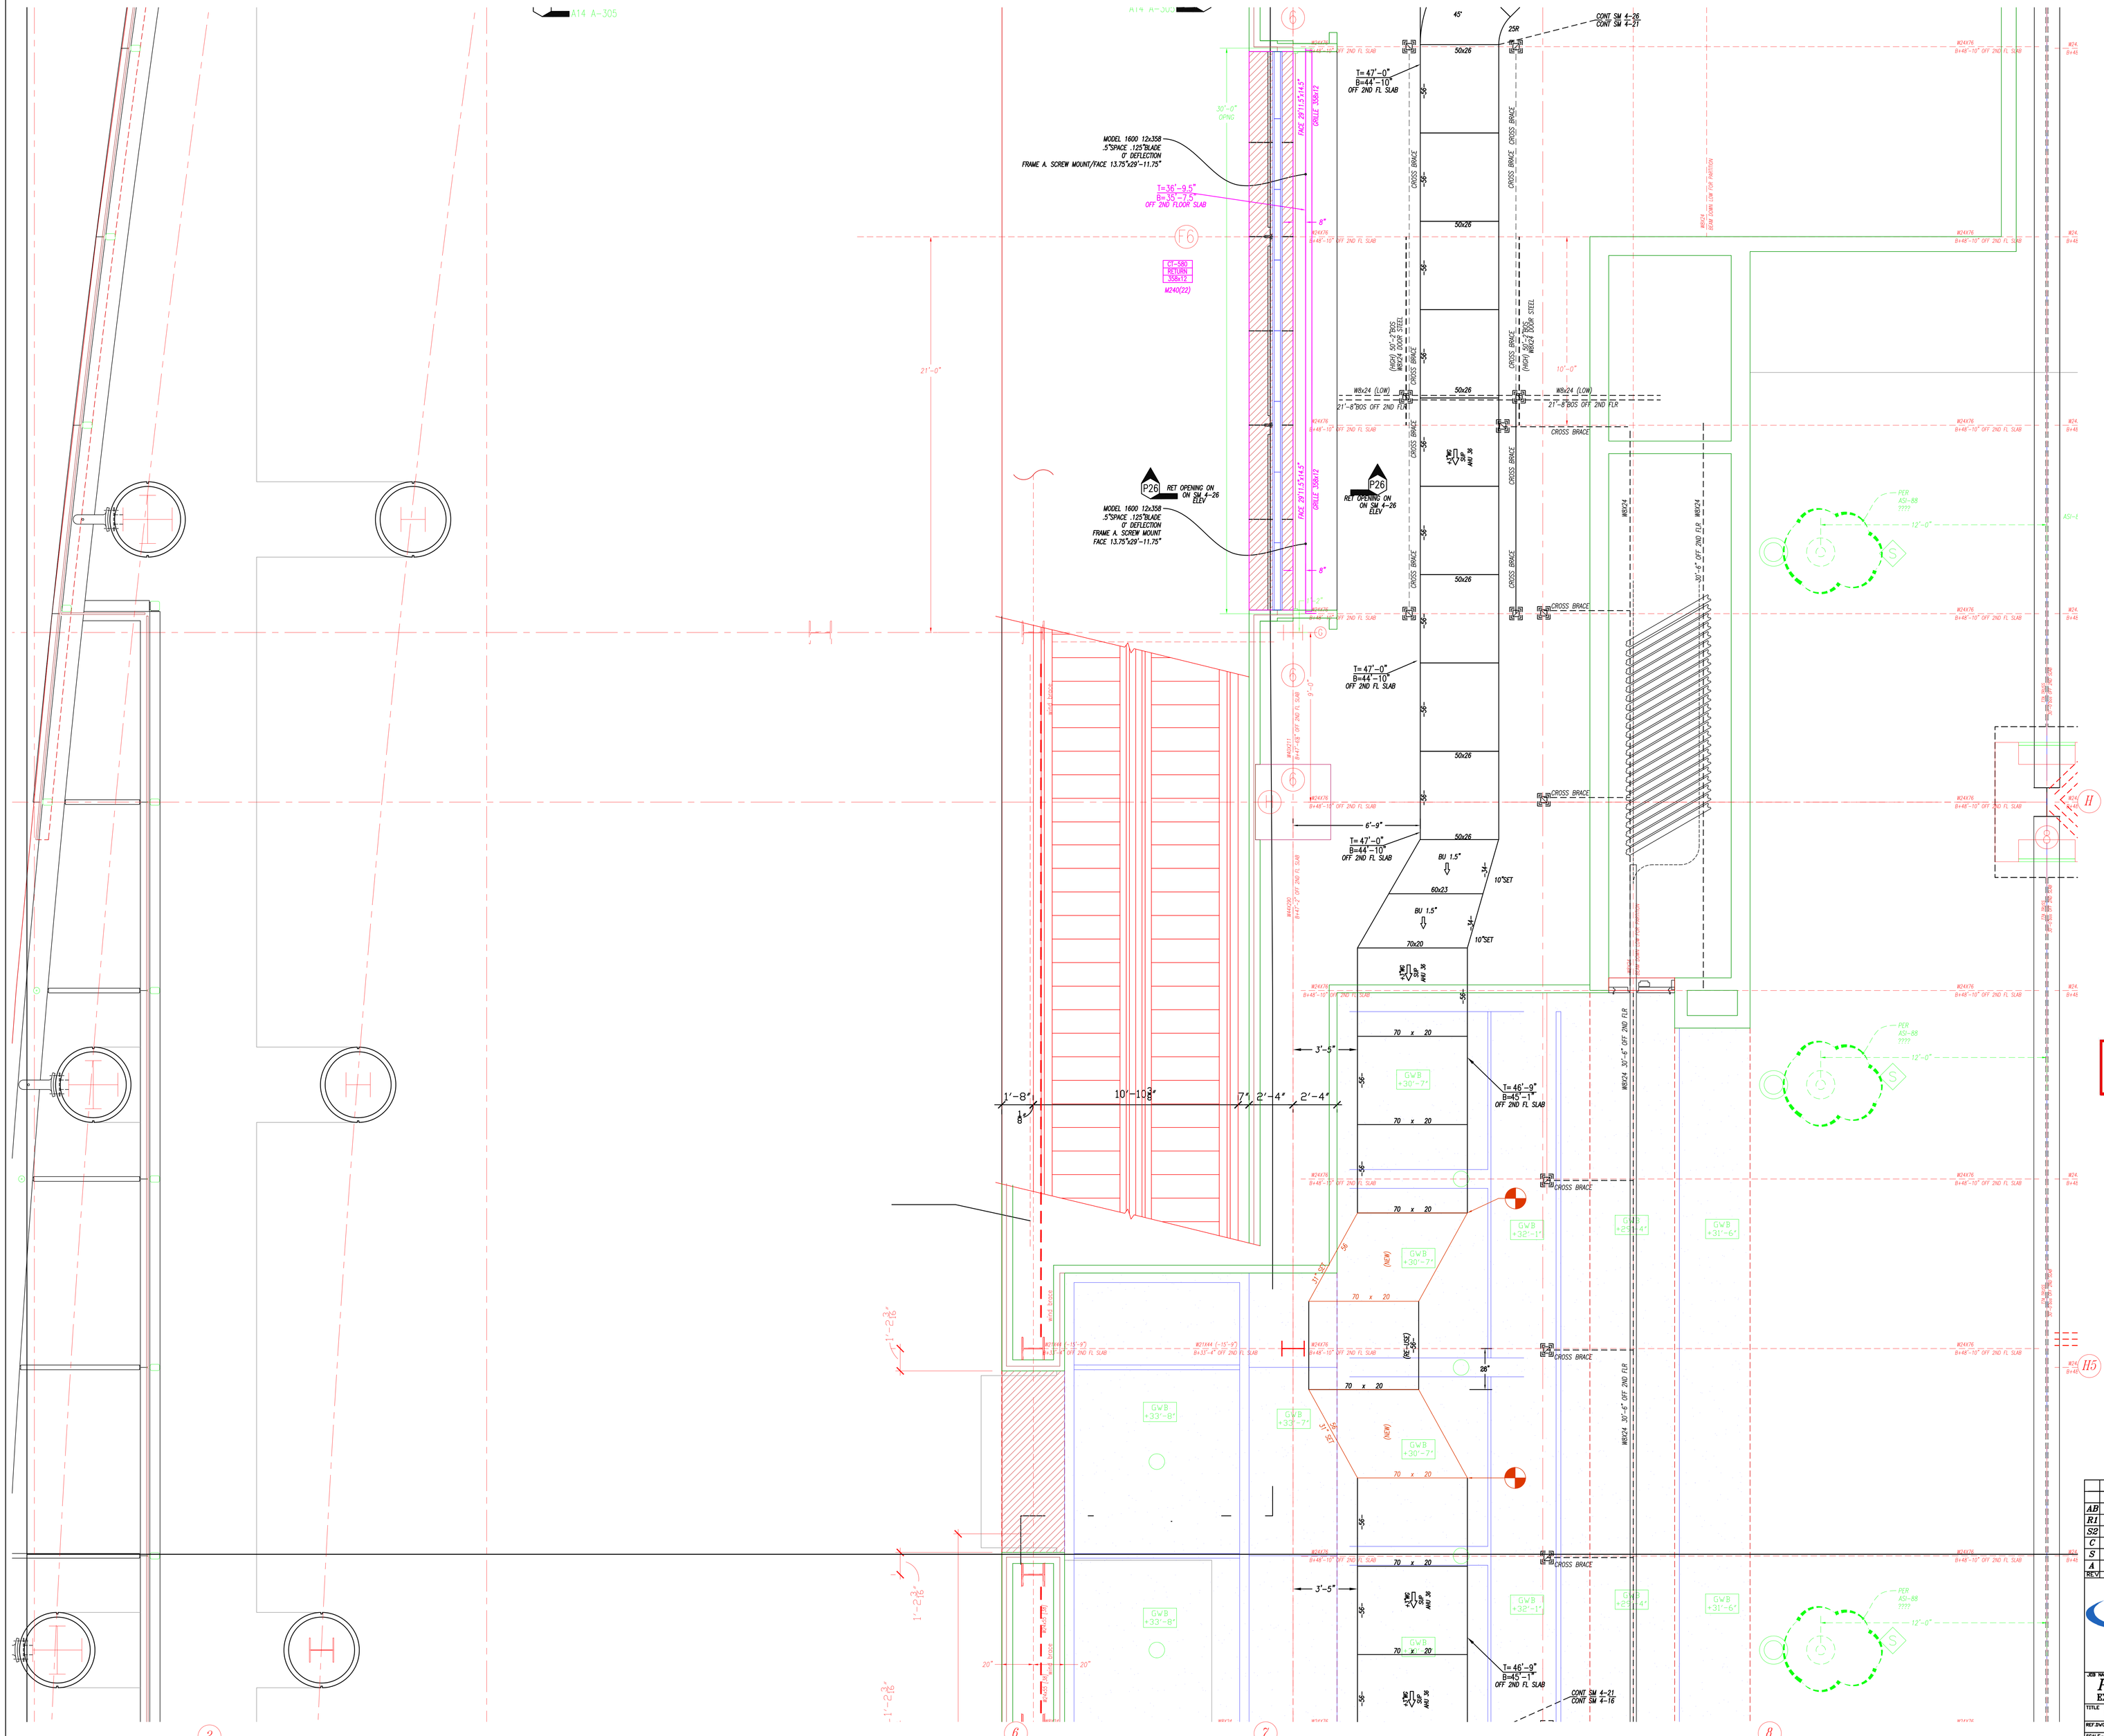
M14 A=305
MODEL 1600 12x358
.5"SPACE .125"BLADE
0° DEFLECTION
FRAME A. SCREW MOUNT/FACE 13.75"x29"-11.75"
T=36'-9.5"
B=35'-7.5"
OFF 2ND FLOOR SLAB
F6
RET-SM5
RETURN
358x12
M240(22)
FACE 291.5"x14.5"
GRILLE 358x12
32'-0" OPNG
21'-0"
P26
RET OPENING ON
ON SM 4-26
ELEV
MODEL 1600 12x358
.5"SPACE .125"BLADE
0° DEFLECTION
FRAME A. SCREW MOUNT
FACE 13.75"x29"-11.75"
T= 47'-0"
B=44'-10"
OFF 2ND FL SLAB
50x26
CROSS BRACE
W8x24 (LOW)
21'-8"BOS OFF 2ND FLR
W8x24 (LOW)
21'-8"BOS OFF 2ND FLR
10'-0"
W8X24 30"-6" OFF 2ND FLR
W8X24 30"-5" OFF 2ND FLR
W8X24 30"-4" OFF 2ND FLR
W8X24 30"-0" OFF 2ND FLR
W8X24

CONT SM 4-27
CONT SM 4-22

EXPOSED

72"ø

70"ø

68"ø

4'-0"

6'-0"

4'-6"

T= 46'-4"
B=40'-4"
OFF 2ND FL SLAB

T= 46'-2"
B=40'-6"
OFF 2ND FL SLAB

T= 37'-1"
B=31'-3"
OFF 2ND FL SLAB

SADDLE COL **=119"
36# =6= & =113=
DIFF FINISH AT +29'-9"

CO-9
7500 CFM
16"X736"ø
ITEM 445

3'-7"

3'-6 1/2"

42'-6 1/2"

35'-7"

35R

STOP 1/4

18'-7"
OFF COLUMN K

17'-9 1/2"

W16x15
X-BRACING TO
TOPCHORD(25k)

ASI-88 SHOWS THIS ROW LIGHTS
MOVING OVER 36" 16'-0"
OFF COLUMN LINE 8

15'-4"
2ND FLR

W24X62
8+48'-10" OFF 2ND SLAB

RECORD DRAWINGS
The Keating JV

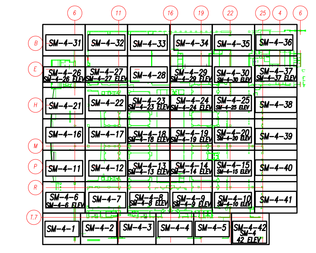

FOURTH FLOOR

NOTES:

1. = ALL DUCT TO BE FABRICATED PER SMACNA CONSTRUCTION STANDARDS.
2. = <G> = AIR FLOW – GALV. – NO ACOUST. LINING
3. = r'xH> = AIR FLOW –1" ACOUST. LINING
4. = <SS> SS = AIR FLOW – STAINLESS STEEL
5. = <AL> ALUM = AIR FLOW – ALUMINUM
6. = [▷] = W.G. CONSTRUCTION OF DUCT
7. = T= 0'-0" = TOP OF DUCT ABOVE FINISHED FLOOR; B= 0'-0" = BOTTOM OF DUCT ABOVE FINISHED FLOOR
8. = COORDINATION NOTE – ALLOW 3" ALL AROUND DUCT FOR FLANGE CONNECTIONS AND FOR EXTERNAL INSULATION WHERE REQUIRED.

REV.	DESCRIPTION	DR.	DATE
AB	AS BUILT	EG	01-11-11
R1	REVISED FOR GRDS	EG	01-29-10
C	FOR CONSTRUCTION	EG	11-02-09
S	SIGN OFF	BLJ	09-24-09
A	FOR APPROVAL	BLJ	05-28-09

Advantage CONTRACTING INC.
A Minority Owned Business Enterprise
219 W. Hortter Street • Philadelphia, PA 19119
Phone: 215-844-0191 Fax: 215-844-0192
www.advantagecontracts.com

JOB NAME: PA CONVENTION CENTER
EXPANSION AND RENOVATION
TITLE: LEVEL 4 PARTIAL DUCT PLAN

KEY DWG.: M241	LDG. CDLS.		
SCALE: 3/8"=1'-0"	DN.	JOB NO.	8520
DATE: 05-28-09	DR. BLJ	DWG. NO.	SM 4-22

CONT SM 4-28
CONT SM 4-23

W30X116 B=48'-4" OFF 2ND SLAB

W12X16 B=49'-10" OFF 2ND SLAB

W16X26 B=49'-6" OFF 2ND SLAB

W24X68 B=48'-10" OFF 2ND SLAB

72"ø

38'-6 1/2"

41'-3"

70"ø

EXPOSED

T= 37'-1"
B=31'-3"
OFF 2ND FL SLAB

17'-7"

35R

72"ø

68"ø

T= 46'-4"
B=40'-4"
OFF 2ND FL SLAB

ITEM 445
CO-9
7500 CFM
NECK/36"ø

WT6x15
X-BRACING TO
TOP CHORD(25k)

3'-7"

SADDLE COL **=119"
36ø ~6~ & ~113~
DIFF FINISH AT +29'-9"

(36"ø)

ITEM 459
CO-8
7500 CFM
NECK/36"ø

T= 46'-2"
B=40'-6"
OFF 2ND FL SLAB

5'-0"

7'-7"

12'-6 1/2"

12'-2 1/2"

(70ø)

18'-7"
OFF COLUMN K

CONT SM 4-23
CONT SM 4-18

1'-0"

~6'-0"

~2'-0"

1'X18" EF 5,6

1'X18" EF 7,8

25'-0 1/2"

20'-6 1/2"

38'-7"
OFF COLUMN F

41'-6"
OFF COLUMN F

60x60 UP
TO EF-5
ON ROOF
EF 5

60x60 UP
TO EF-6
ON ROOF
EF 6

60x60 UP
TO EF-7
ON ROOF
EF 7

60x60 UP
TO EF-8
ON ROOF
EF 8

A
ON SM 4-8 ELEV

T= 36'-0"
B=32'-4"
OFF 2ND FL SLAB

T= 36'-2"
B=32'-2"
OFF 2ND FL SLAB

TDF IN
O/TOP

TDF IN
O/SIDE

108 x 48

60

CBV

44 x 90

22'-6"

17'-6"

7'-5"

11'-5"

T= 37'-1"
B=31'-3"
OFF 2ND FL SLAB

T= 37'-2"
B=31'-9"

T= 37'-2"
B=31'-4"

T= 37'-1"
B=31'-3"
OFF 2ND FL SLAB

12 1/2"

654

FAN MOTOR THIS SIDE

FAN LOCATIONS BY JOIST MANUFACTURER RFI#122 AND RESPONSE TO CONTRACT 1 RFI#326 WITH ATTATCHED SKETCHES

FAN LOCATIONS BY JOIST MANUFACTURER RFI#122 AND RESPONSE TO CONTRACT 1 RFI#326 WITH ATTATCHED SKETCHES

RECORD DRAWINGS
The Keating JV

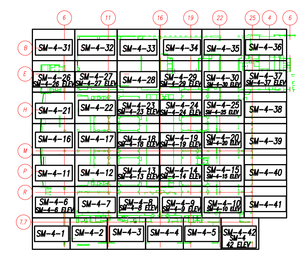

FOURTH FLOOR

H5

NOTES:

1. – ALL DUCT TO BE FABRICATED PER SMACNA CONSTRUCTION STANDARDS.
2. – <=> = AIR FLOW – GALV. – NO ACOUST. LINING
3. – 1"AL=> = AIR FLOW –1" ACOUST. LINING
4. – <=> SS = AIR FLOW – STAINLESS STEEL
5. – <=> ALUM = AIR FLOW – ALUMINUM
6. – [▷] = W.G. CONSTRUCTION OF DUCT
7. – T= 0'-0 = TOP OF DUCT ABOVE FINISHED FLOOR
   B= 0'-0 = BOTTOM OF DUCT ABOVE FINISHED FLOOR
8. – COORDINATION NOTE – ALLOW 3" ALL AROUND DUCT FOR FLANGE CONNECTIONS AND FOR EXTERNAL INSULATION WHERE REQUIRED.

REV.	DESCRIPTION	DR.	DATE
AB	AS BUILT	EG	01-11-11
R1	REVISED FOR GRDS	EG	01-29-10
C	FOR CONSTRUCTION	EG	11-02-09
S	SIGN OFF	BLJ	09-24-09
A	FOR APPROVAL	BLJ	05-28-09

Advantage CONTRACTING INC.
A Minority Owned Business Enterprise
219 W. Hortter Street • Philadelphia, PA 19119
Phone: 215-844-0191 Fax: 215-844-0192
www.advantagecontracts.com

JOB NAME
PA CONVENTION CENTER
EXPANSION AND RENOVATION

TITLE
LEVEL 4 PARTIAL DUCT PLAN

KEY SVS- M243 M244	LOC. COLS.		
SCALE 3/8"=1'-0"	DR.	JOB NO. 8520	
DATE 05-28-09	DR. BLJ	DWG. NO. SM 4-23	

12 13 13.8 14 14.7 15 H

SM 4-29
SM 4-24

26 1/2"

CD-9
(2000 CFM)
MDX730 M

SADDLE COL **=5"
DIFF FINISH AT 29'-9"

EXPOSED

62'-4"
2ND FLR

8'-0"

72"ø

8'-6"

T=36'-10"
B=30'-10"
OFF 2ND FL SLAB

6'-6"

ITEM 459
CD-9
(2000 CFM)
MDX730 M

29 1/2"

72"ø

ATIONS BY JOIST
TURER RFI#122 AND
E TO CONTRACT 1
WITH ATTATCHED
S

A
ELEV

98x32 O.E.D
W/M.M.S.
18,750 CFM

98 x 32
108 x 48

15'-8 1/2"

FAN LOCATIONS BY JOIST
MANUFACTURER RFI#122 AND
RESPONSE TO CONTRACT 1
RFI#326 WITH ATTATCHED
SKETCHES

17'-1 1/2"

16'-4 1/2"

T= 35'-0"
B=31'-0"
OFF 2ND FL SLAB

60x60 UP
TO EF-13
ON ROOF

EF
13

TDF IN
0"/TOP

(66)

60

56'-0"

ON SM 4-9 ELEV

FAN
MOTOR
THIS SIDE

15'-3 1/2"

51'-4"

60x60 UP
TO EF-14
ON ROOF

EF
14

19'-10 1/2"

18'-10 1/2"

FAN LOCATIONS BY JOIST
MANUFACTURER RFI#122 AND
RESPONSE TO CONTRACT 1

15.3

16

17

18

H5

| | | |

DECK TYPE "D1"

SM 4-30
SM 4-25

26 1/2"

SADDLE COL **=5"
DIFF FINISH AT +29'-9"

EXPOSED

8'-0"

72"ø

8'-6"

6'-6"

T=36'-10"
B=30'-10"
OFF 2ND FL SLAB

ITEM 459
CU-9
7500 CFM
NECK/36"ø

29 1/2"

SADDLE COL **=5"
DIFF FINISH AT 29'-9"

61'-4"
2ND FLR

98x32 O.E.D
W/M.M.S.
18,750 CFM

98 x 32
108 x 48

15'-8 1/2"

FAN LOCATIONS BY JOIST MANUFACTURER RFI#122 AND RESPONSE TO CONTRACT 1 RFI#326 WITH ATTATCHED SKETCHES

17'-1 1/2"
16'-4 1/2"

T= 35'-0"
B=31'-0"
OFF 2ND FL SLAB

60x60 UP
TO EF-17
ON ROOF

EF
17

TDF IN
O/TOP

(66)

48

60

FAN
MOTOR
THIS SIDE

A
ON SM 4-10 ELEV

56'-0"

15'-3 1/2"

51'-4"

EF
18

60x60 UP
TO EF-18
ON ROOF

19'-10 1/2"
18'-10 1/2"

T= 35'-2"
B=40'-10"
OFF 2ND FL SLAB

27"

H

H5

FOURTH FLOOR

NOTES:

1. – ALL DUCT TO BE FABRICATED PER SMACNA CONSTRUCTION STANDARDS.
2. – <=> = AIR FLOW – GALV. – NO ACOUST. LINING
3. – r <=> = AIR FLOW –1" ACOUST. LINING
4. – <=> IS = AIR FLOW – STAINLESS STEEL
5. – <=> ALM = AIR FLOW – ALUMINUM
6. – ▷ = W.G. CONSTRUCTION OF DUCT
7. – T= 0'-0" = TOP OF DUCT ABOVE FINISHED FLOOR
   B= 0'-0" = BOTTOM OF DUCT ABOVE FINISHED FLOOR
8. – COORDINATION NOTE – ALLOW 1" ALL AROUND DUCT FOR FLANGE CONNECTIONS AND FOR EXTERNAL INSULATION WHERE REQUIRED.

RECORD DRAWINGS
The Keating JV

REV	DESCRIPTION	DR.	DATE
AB	AS BUILT	EG	01-29-10
R2	REVISED FOR GRDS	EG	01-29-10
R1	REVISED LENGHTH	EG	09-18-09
C	FOR CONSTRUCTION	EG	09-15-09
S	SIGN OFF	EG	09-09-09
A	FOR APPROVAL	BLJ	05-28-09

Advantage CONTRACTING INC.
A Minority Owned Business Enterprise
219 W. Hortter Street • Philadelphia, PA 19119
Phone: 215-844-0191 Fax: 215-844-0192
www.advantagecontracts.com

JOB NAME: PA CONVENTION CENTER
EXPANSION AND RENOVATION

TITLE: LEVEL 4 PARTIAL DUCT PLAN

KEY DWG- M244 M249	LOC. COLS.		
SCALE: 3/8"=1'-0"	CH.	JOB NO.	8520
DATE: XX-XX-XX	DR. BLJ	DWG. NO.	SM 4-25

19 20 21 22

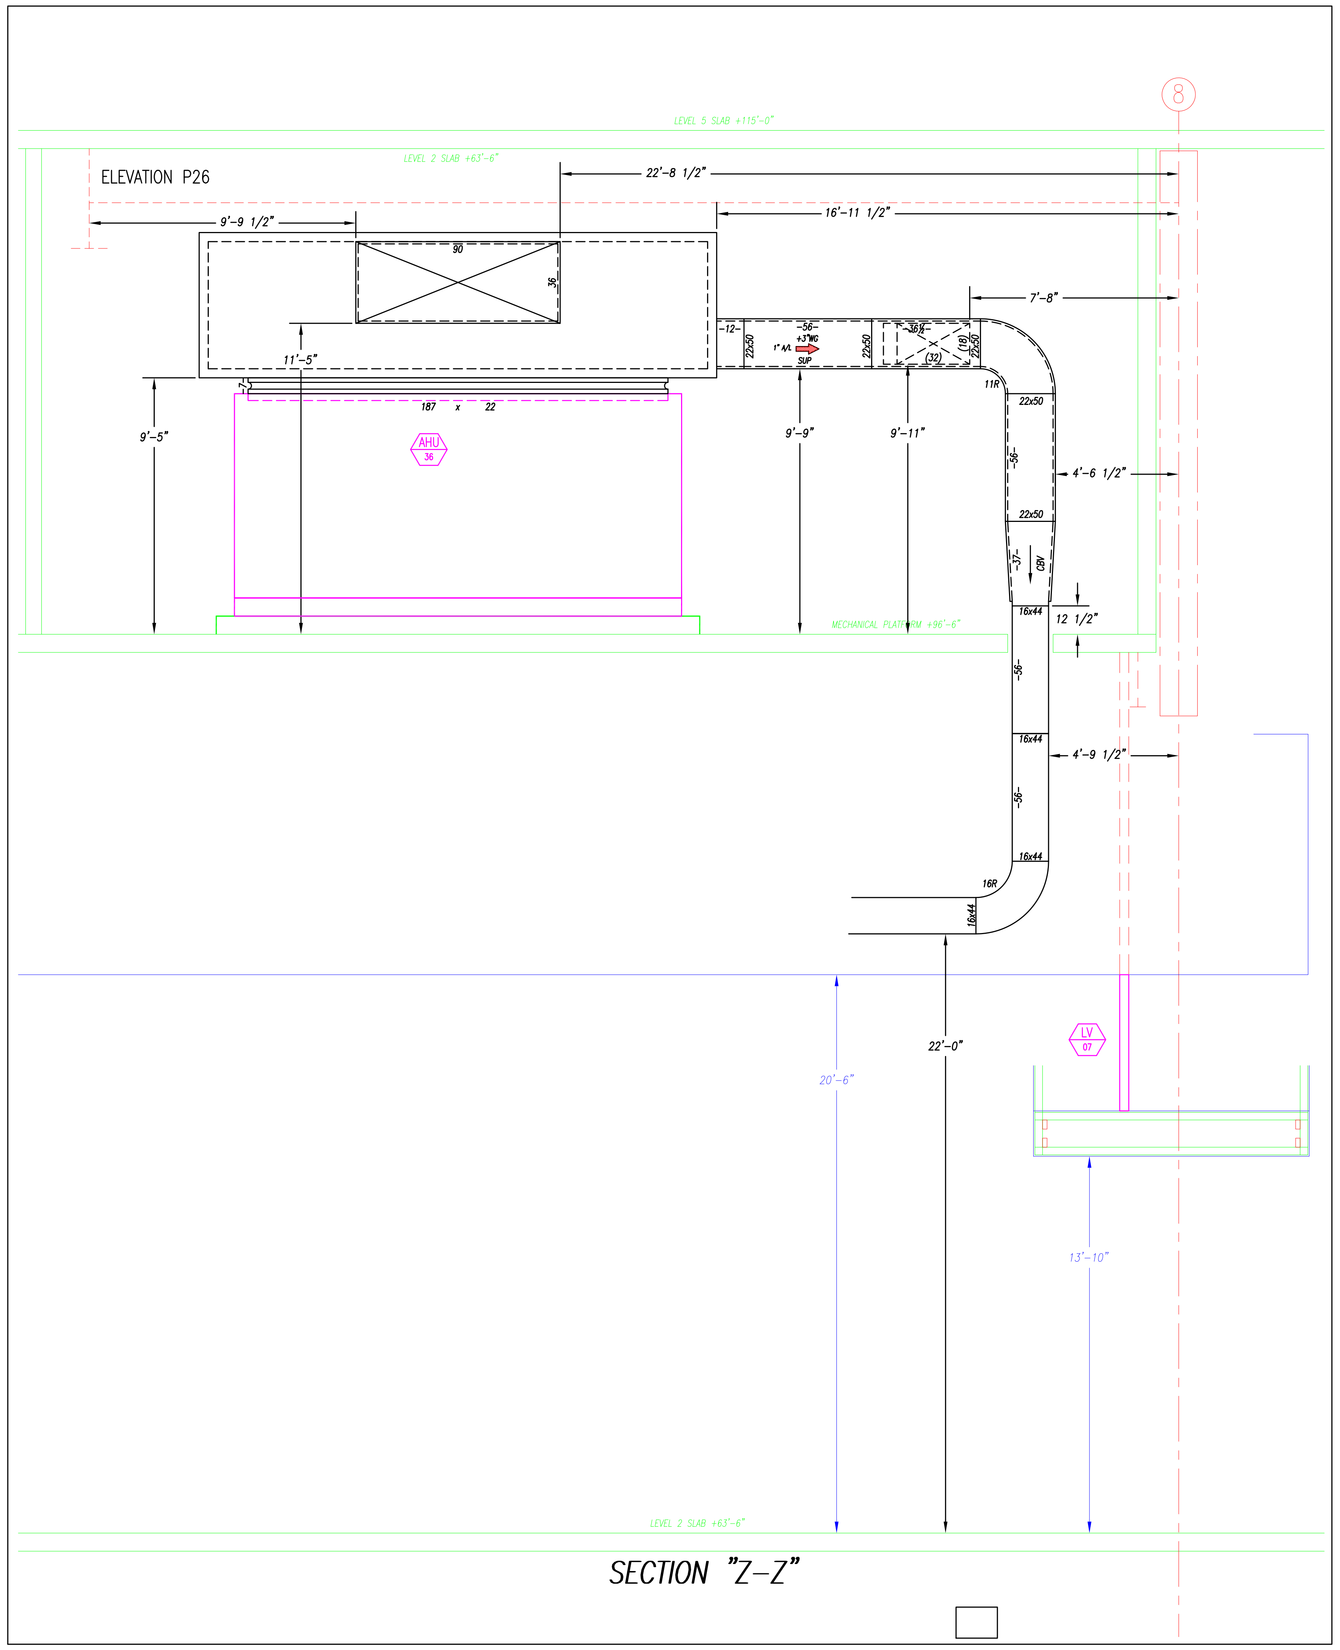

SECTION "Z-Z"

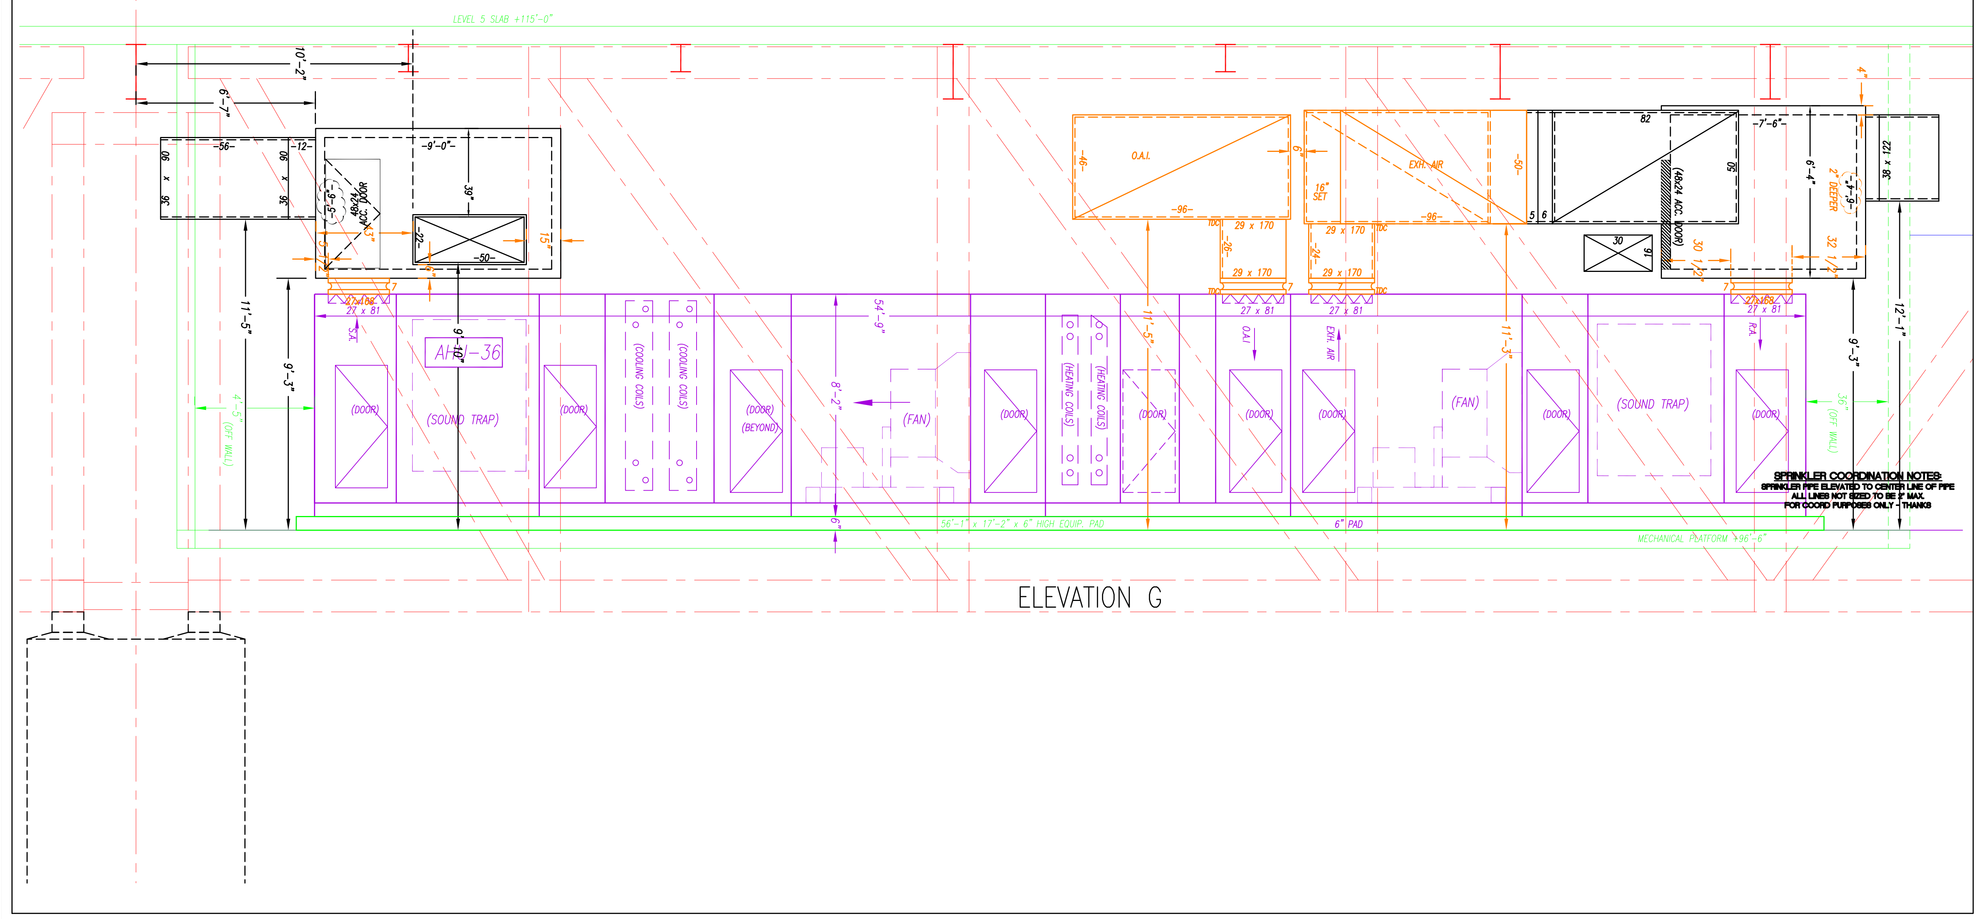

ELEVATION G

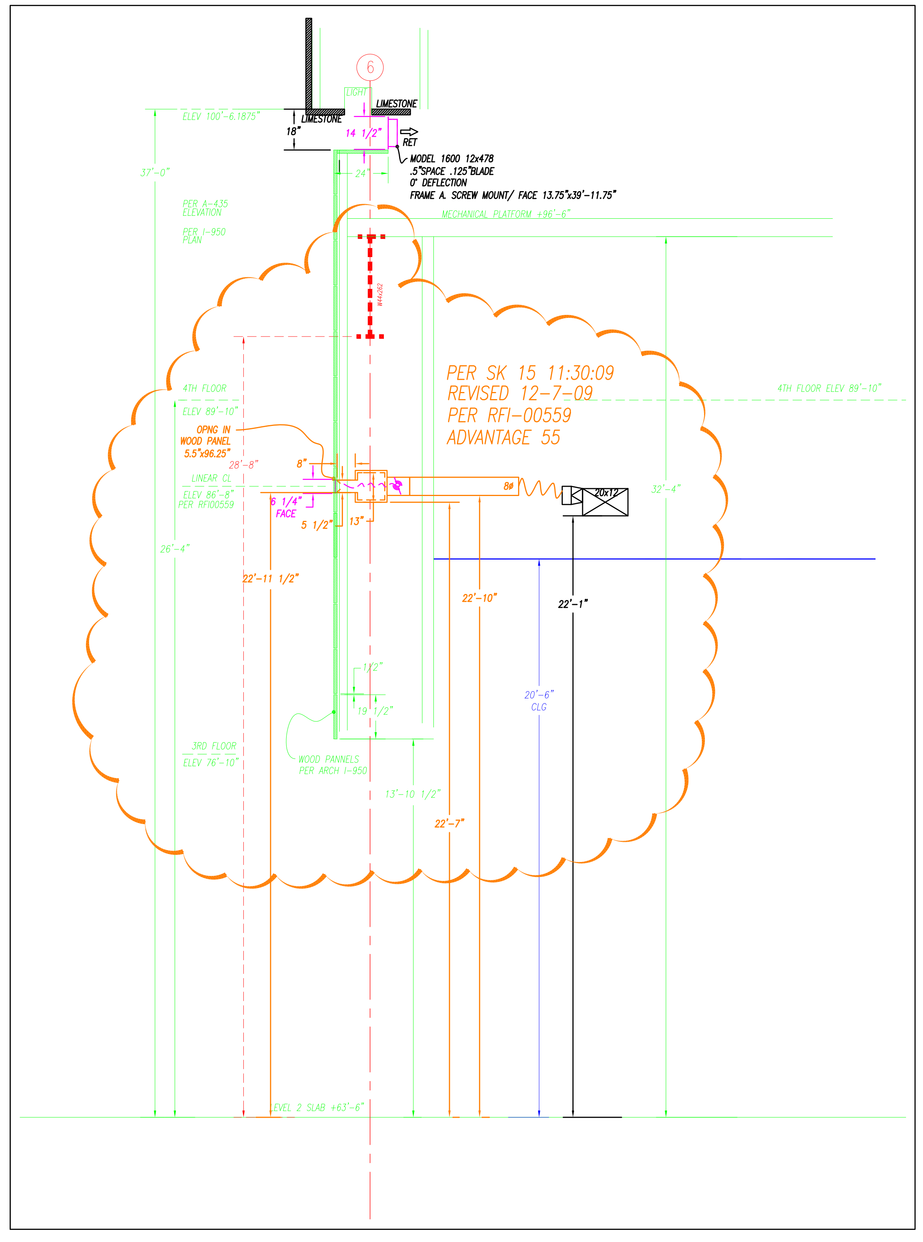

RECORD DRAWINGS
The Keating JV

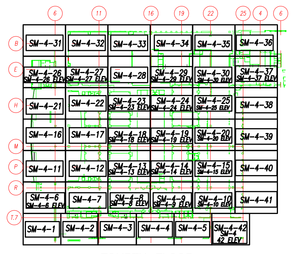

FOURTH FLOOR

NOTES:

1. - ALL DUCT TO BE FABRICATED PER SMACNA CONSTRUCTION STANDARDS.
2. - <=> = AIR FLOW - GALV. - NO ACOUST. LINING
3. - r'x'<=> = AIR FLOW - 1" ACOUST. LINING
4. - <=> SS = AIR FLOW - STAINLESS STEEL
5. - <=> ALUM = AIR FLOW - ALUMINUM
6. - ▷ = W.G. CONSTRUCTION OF DUCT
7. - T= 0'-0 = TOP OF DUCT ABOVE FINISHED FLOOR
   B= 0'-0 = BOTTOM OF DUCT ABOVE FINISHED FLOOR
8. - COORDINATION NOTE - ALLOW 2" ALL AROUND DUCT FOR FLANGE CONNECTIONS AND FOR EXTERNAL INSULATION WHERE REQUIRED.

REV	DESCRIPTION	DR.	DATE
AB	AS BUILT	EG	01-11-11
C	FOR CONSTRUCTION	EG	12-15-09
R1	UNIT REVISION	MSO	09-15-09
A	FOR APPROVAL	BLJ	08-04-09

Advantage CONTRACTING INC.
A Minority Owned Business Enterprise
219 W. Hortter Street • Philadelphia, PA 19119
Phone: 215-844-0191 Fax: 215-844-0192
www.advantagecontracts.com

JOB NAME: PA CONVENTION CENTER
EXPANSION AND RENOVATION

TITLE: LEVEL 4 DUCT ELEVATIONS

REF.DWG- SM 4-26	LOC. COLS.		
SCALE 3/8"=1'-0"	CH.	JOB NO.	8520
DATE XX-XX-XX	DR. BLJ	DWG. NO.	SM 4-26 ELEV

RECORD DRAWINGS
The Keating JV

REV'D	DESCRIPTION	DR.	DATE
AB	AS BUILT	EG	01-29-10
R2	REVISED FOR GRDS	EG	01-29-10
S1	SIGN OFF (REVISED FOR PLUMBING)	BLJ	01-14-10
C	FOR CONSTRUCTION	EG	10-15-09
S	SIGN OFF	MSO	10-17-09
R1	UNIT REVISION	MSO	09-15-09
A	FOR APPROVAL	BLJ	06-04-09

NOTES:
1. – ALL DUCT TO BE FABRICATED PER SMACNA CONSTRUCTION STANDARDS.
2. – <=> = AIR FLOW – GALV. – NO ACOUST. LINING
3. – <=> = AIR FLOW – 1" ACOUST. LINING
4. – <=> IN = AIR FLOW – STAINLESS STEEL
5. – <=> ALUM = AIR FLOW – ALUMINUM
6. – ▷ = W.G. CONSTRUCTION OF DUCT
7. – Tx: 0'-0 = TOP OF DUCT ABOVE FINISHED FLOOR; Bx: 0'-0 = BOTTOM OF DUCT ABOVE FINISHED FLOOR
8. – COORDINATION NOTE – ALLOW 2" ALL AROUND DUCT FOR FLANGE CONNECTIONS AND FOR EXTERNAL INSULATION WHERE REQUIRED.

Advantage CONTRACTING INC.
A Minority Owned Business Enterprise
219 W. Hortter Street • Philadelphia, PA 19119
Phone: 215-844-0191 Fax: 215-844-0192
www.advantagecontracts.com

JOB NAME: PA CONVENTION CENTER
EXPANSION AND RENOVATION

TITLE: LEVEL 4 PARTIAL DUCT PLAN

REF. DWG.: M240 | LOC. COILS:
SCALE: 3/8"=1'-0" | CH.: | JOB NO.: 8520
DATE: XX-XX-XX | DR.: BLJ | DWG. NO.: SM 4-26

FOURTH FLOOR

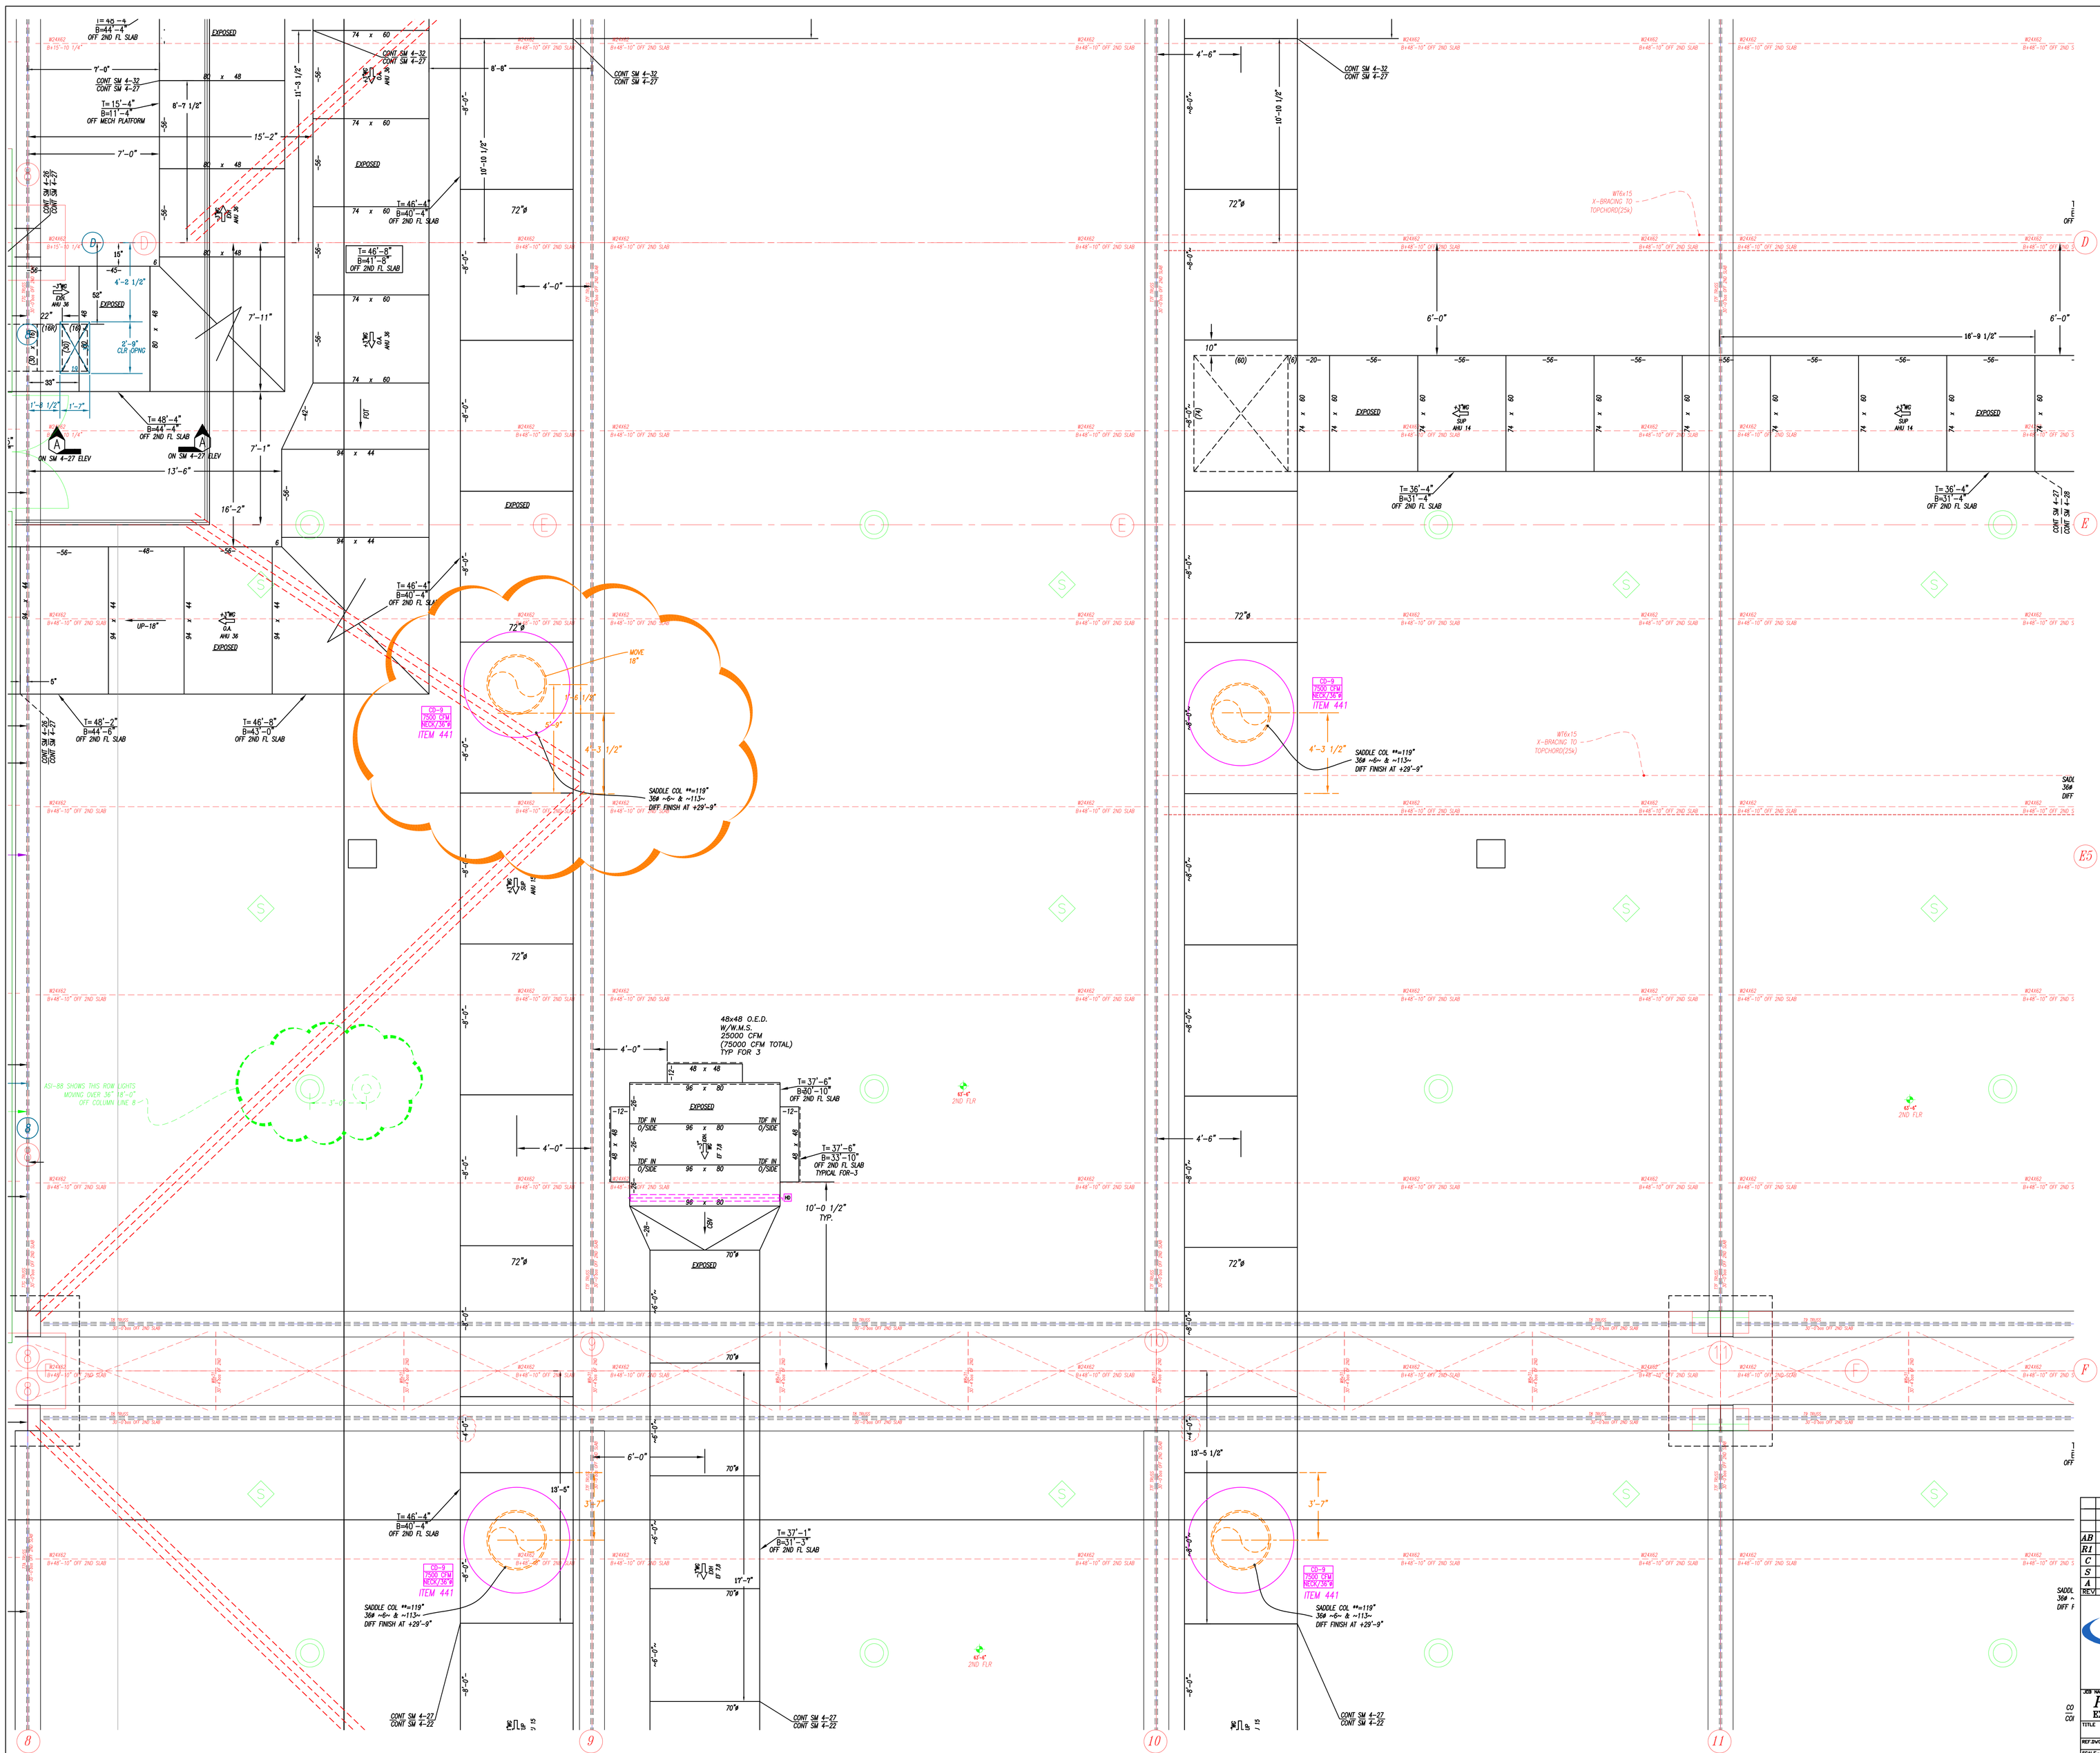

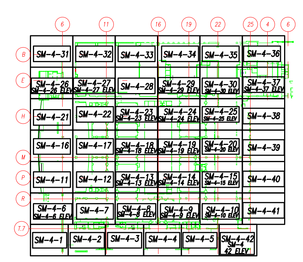

FOURTH FLOOR

RECORD DRAWINGS
The Keating JV

NOTES:

1. – ALL DUCT TO BE FABRICATED PER SMACNA CONSTRUCTION STANDARDS.
2. – <=> = AIR FLOW – GALV. – NO ACOUST. LINING
3. – <=> = AIR FLOW –1" ACOUST. LINING
4. – <=> #8 = AIR FLOW – STAINLESS STEEL
5. – <=> #36 = AIR FLOW – ALUMINUM
6. – [▷] = W.G. CONSTRUCTION OF DUCT
7. – T= 0'-0" = TOP OF DUCT ABOVE FINISHED FLOOR
   B= 0'-0" = BOTTOM OF DUCT ABOVE FINISHED FLOOR
8. – COORDINATION NOTE – ALLOW 2" ALL AROUND DUCT FOR FLANGE CONNECTIONS AND FOR EXTERNAL INSULATION WHERE REQUIRED.

REV	DESCRIPTION	DR.	DATE
AB	AS BUILT	EG	01-29-10
R1	REVISED FOR GRDS	EG	01-29-10
C	FOR CONSTRUCTION	EG	10-30-09
S	SIGN OFF	BLJ	08-24-09
A	FOR APPROVAL	BLJ	08-04-09

Advantage CONTRACTING INC.
A Minority Owned Business Enterprise
219 W. Hortter Street • Philadelphia, PA 19119
Phone: 215-844-0191 Fax: 215-844-0192
www.advantagecontracts.com

JOB NAME: PA CONVENTION CENTER
EXPANSION AND RENOVATION

TITLE: LEVEL 4 PARTIAL DUCT PLAN

REF.DWGS: M240	LOC. COLS.		
SCALE: 3/8"=1'-0"	CH.	JOB NO. 8520	
DATE: 08-04-09	DR. BLJ	DWG. NO. SM 4-27	

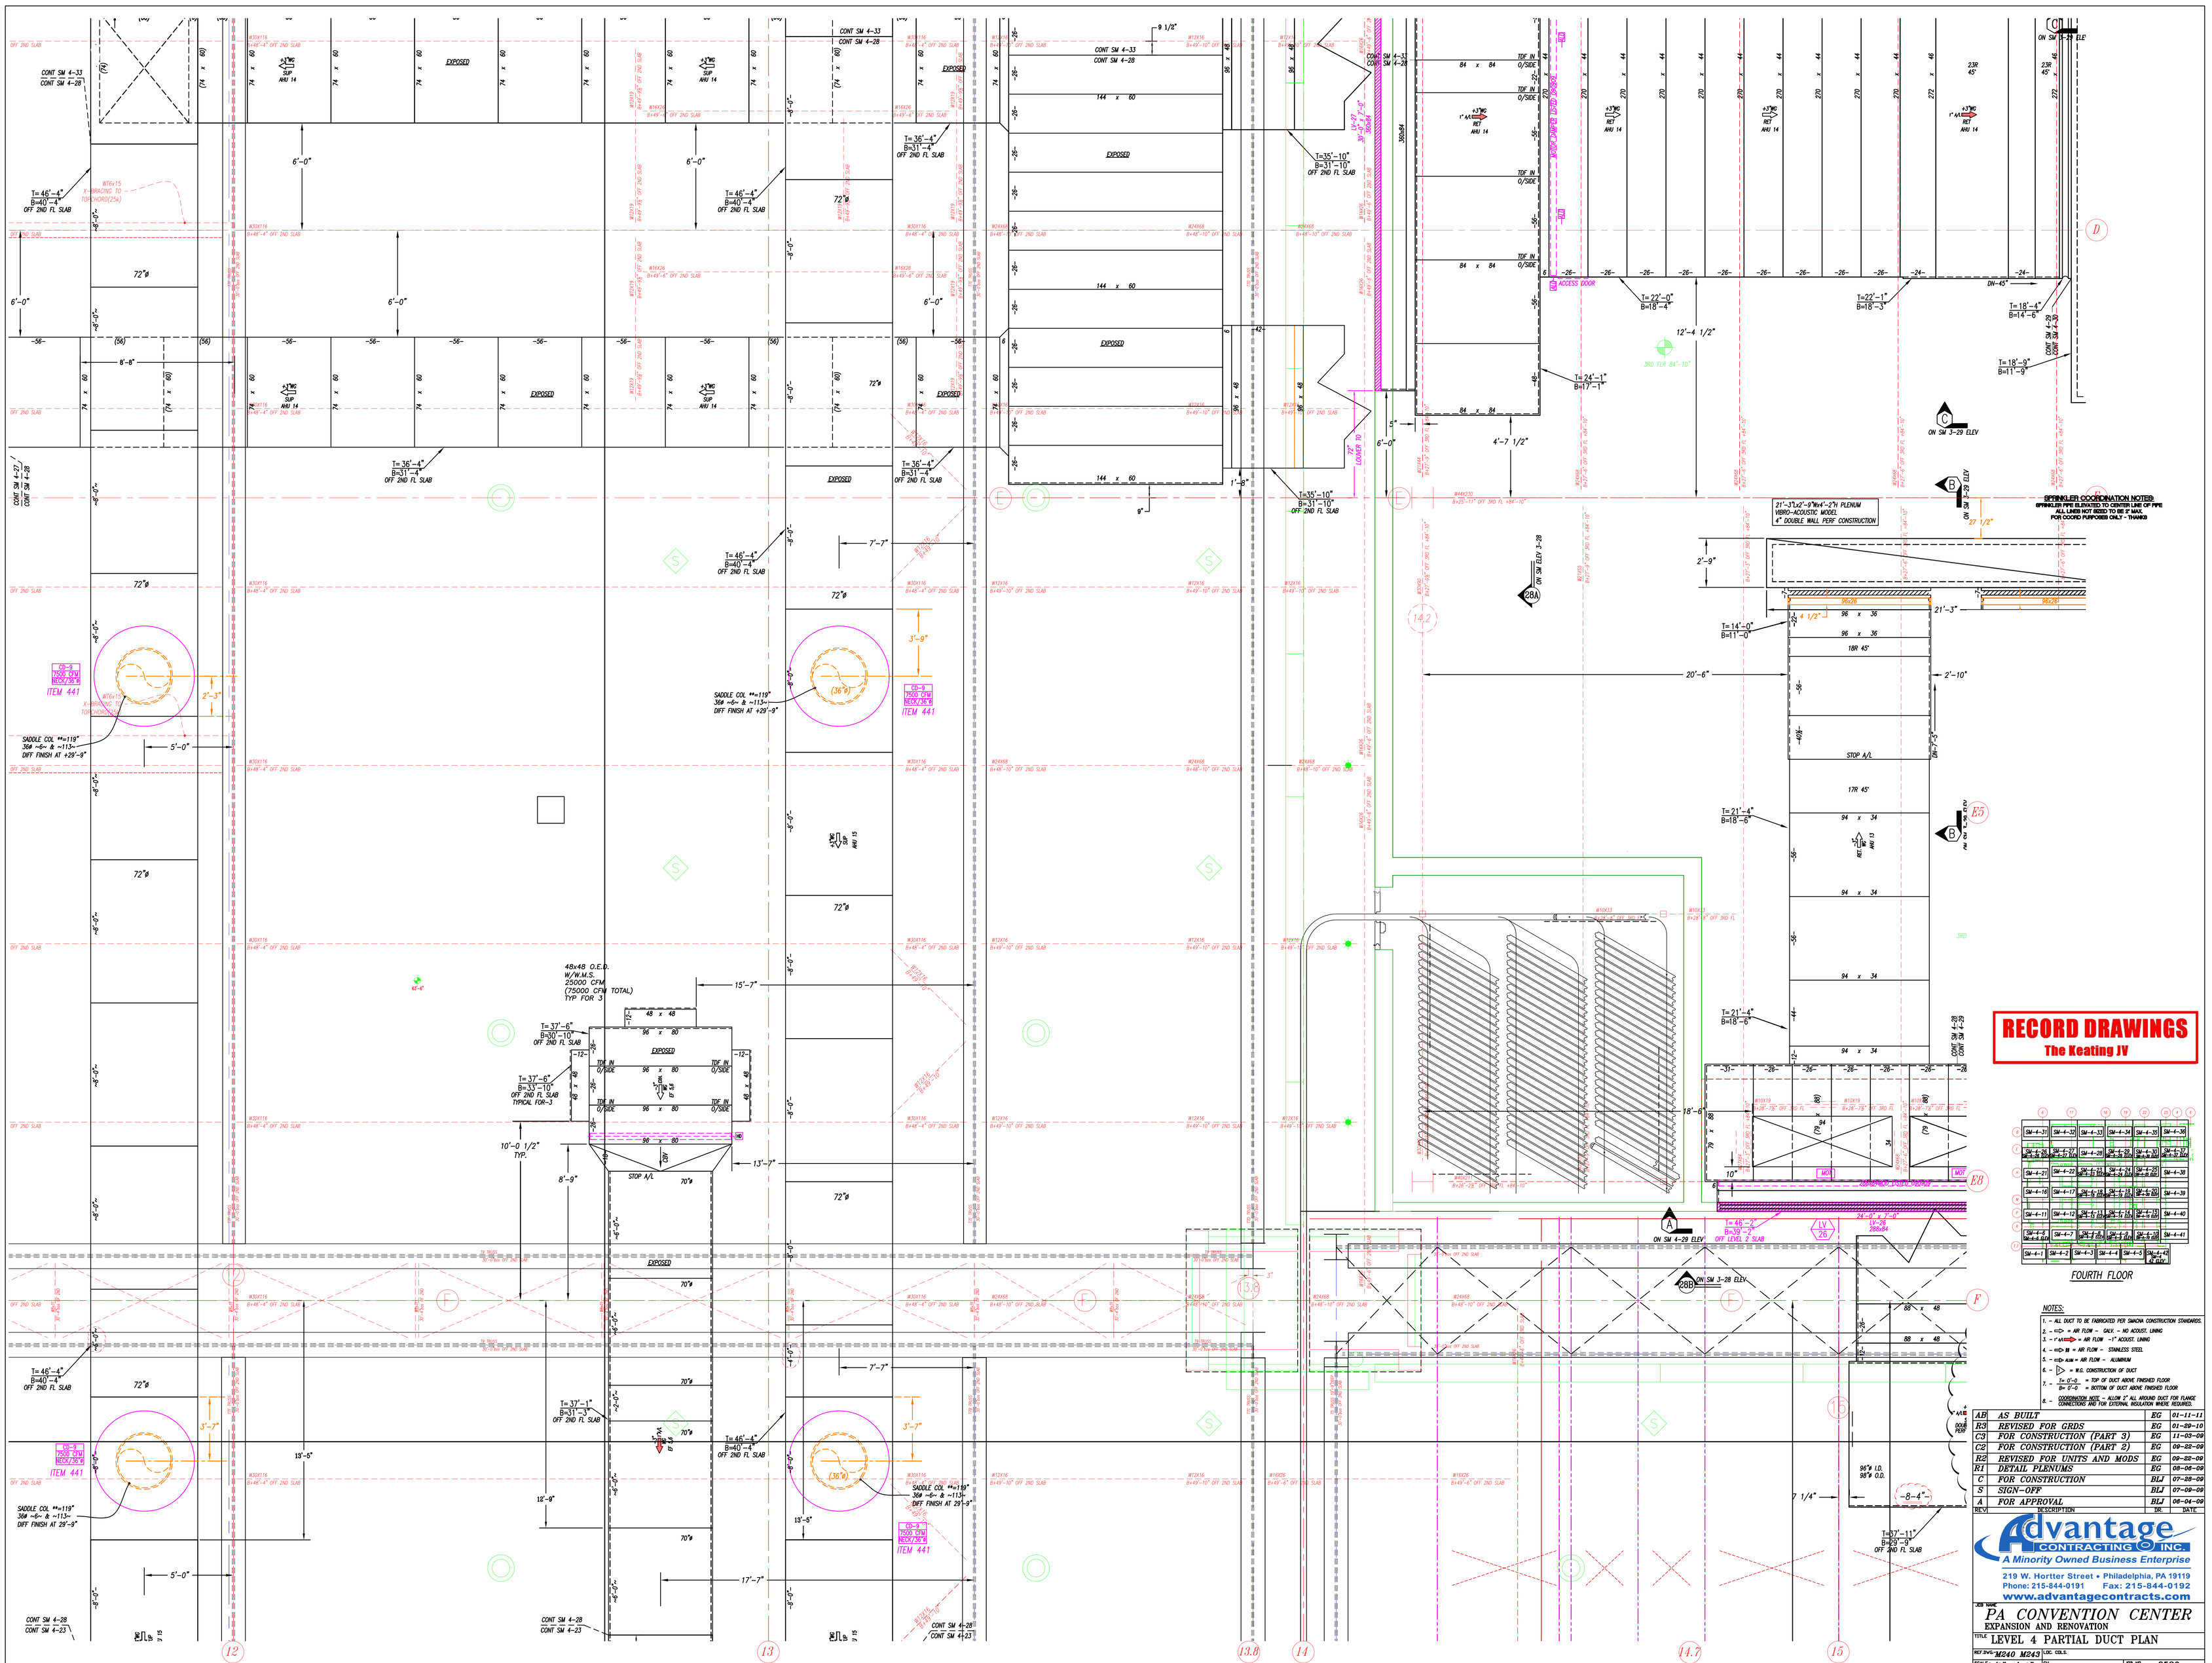

NOTES:

1. ALL DUCT TO BE FABRICATED PER SMACNA CONSTRUCTION STANDARDS.
2. =G> = AIR FLOW – GALV. – NO ACOUST. LINING
3. =I.A.L.> = AIR FLOW –1" ACOUST. LINING
4. =SS> = AIR FLOW – STAINLESS STEEL
5. =AL> = AIR FLOW – ALUMINUM
6. [▷ = W.G. CONSTRUCTION OF DUCT
7. T= 0'-0 = TOP OF DUCT ABOVE FINISHED FLOOR
   B= 0'-0 = BOTTOM OF DUCT ABOVE FINISHED FLOOR
8. COORDINATION NOTE – ALLOW 3" ALL AROUND DUCT FOR FLANGE CONNECTIONS AND FOR EXTERNAL INSULATION WHERE REQUIRED.

REV	DESCRIPTION	BY	DATE
AB	AS BUILT	EG	01-11-11
R3	REVISED FOR GRDS	EG	01-29-10
C3	FOR CONSTRUCTION (PART 3)	EG	11-03-09
C2	FOR CONSTRUCTION (PART 2)	EG	09-22-09
R2	REVISED FOR UNITS AND MODS	EG	08-22-09
R1	DETAIL PLENUMS	EG	08-06-09
C	FOR CONSTRUCTION	BLJ	07-28-09
S	SIGN-OFF	BLJ	07-09-09
A	FOR APPROVAL	BLJ	06-04-09

Advantage CONTRACTING INC.
A Minority Owned Business Enterprise
219 W. Hortter Street • Philadelphia, PA 19119
Phone: 215-844-0191 Fax: 215-844-0192
www.advantagecontracts.com

JOB NAME: PA CONVENTION CENTER
EXPANSION AND RENOVATION
TITLE: LEVEL 4 PARTIAL DUCT PLAN
KEY SVCS: M240 M243 LOC. COLS.
SCALE: 3/8"=1'-0" DR. BLJ
DATE: 06-04-09
JOB NO. 8520
DWG. NO. SM 4-28

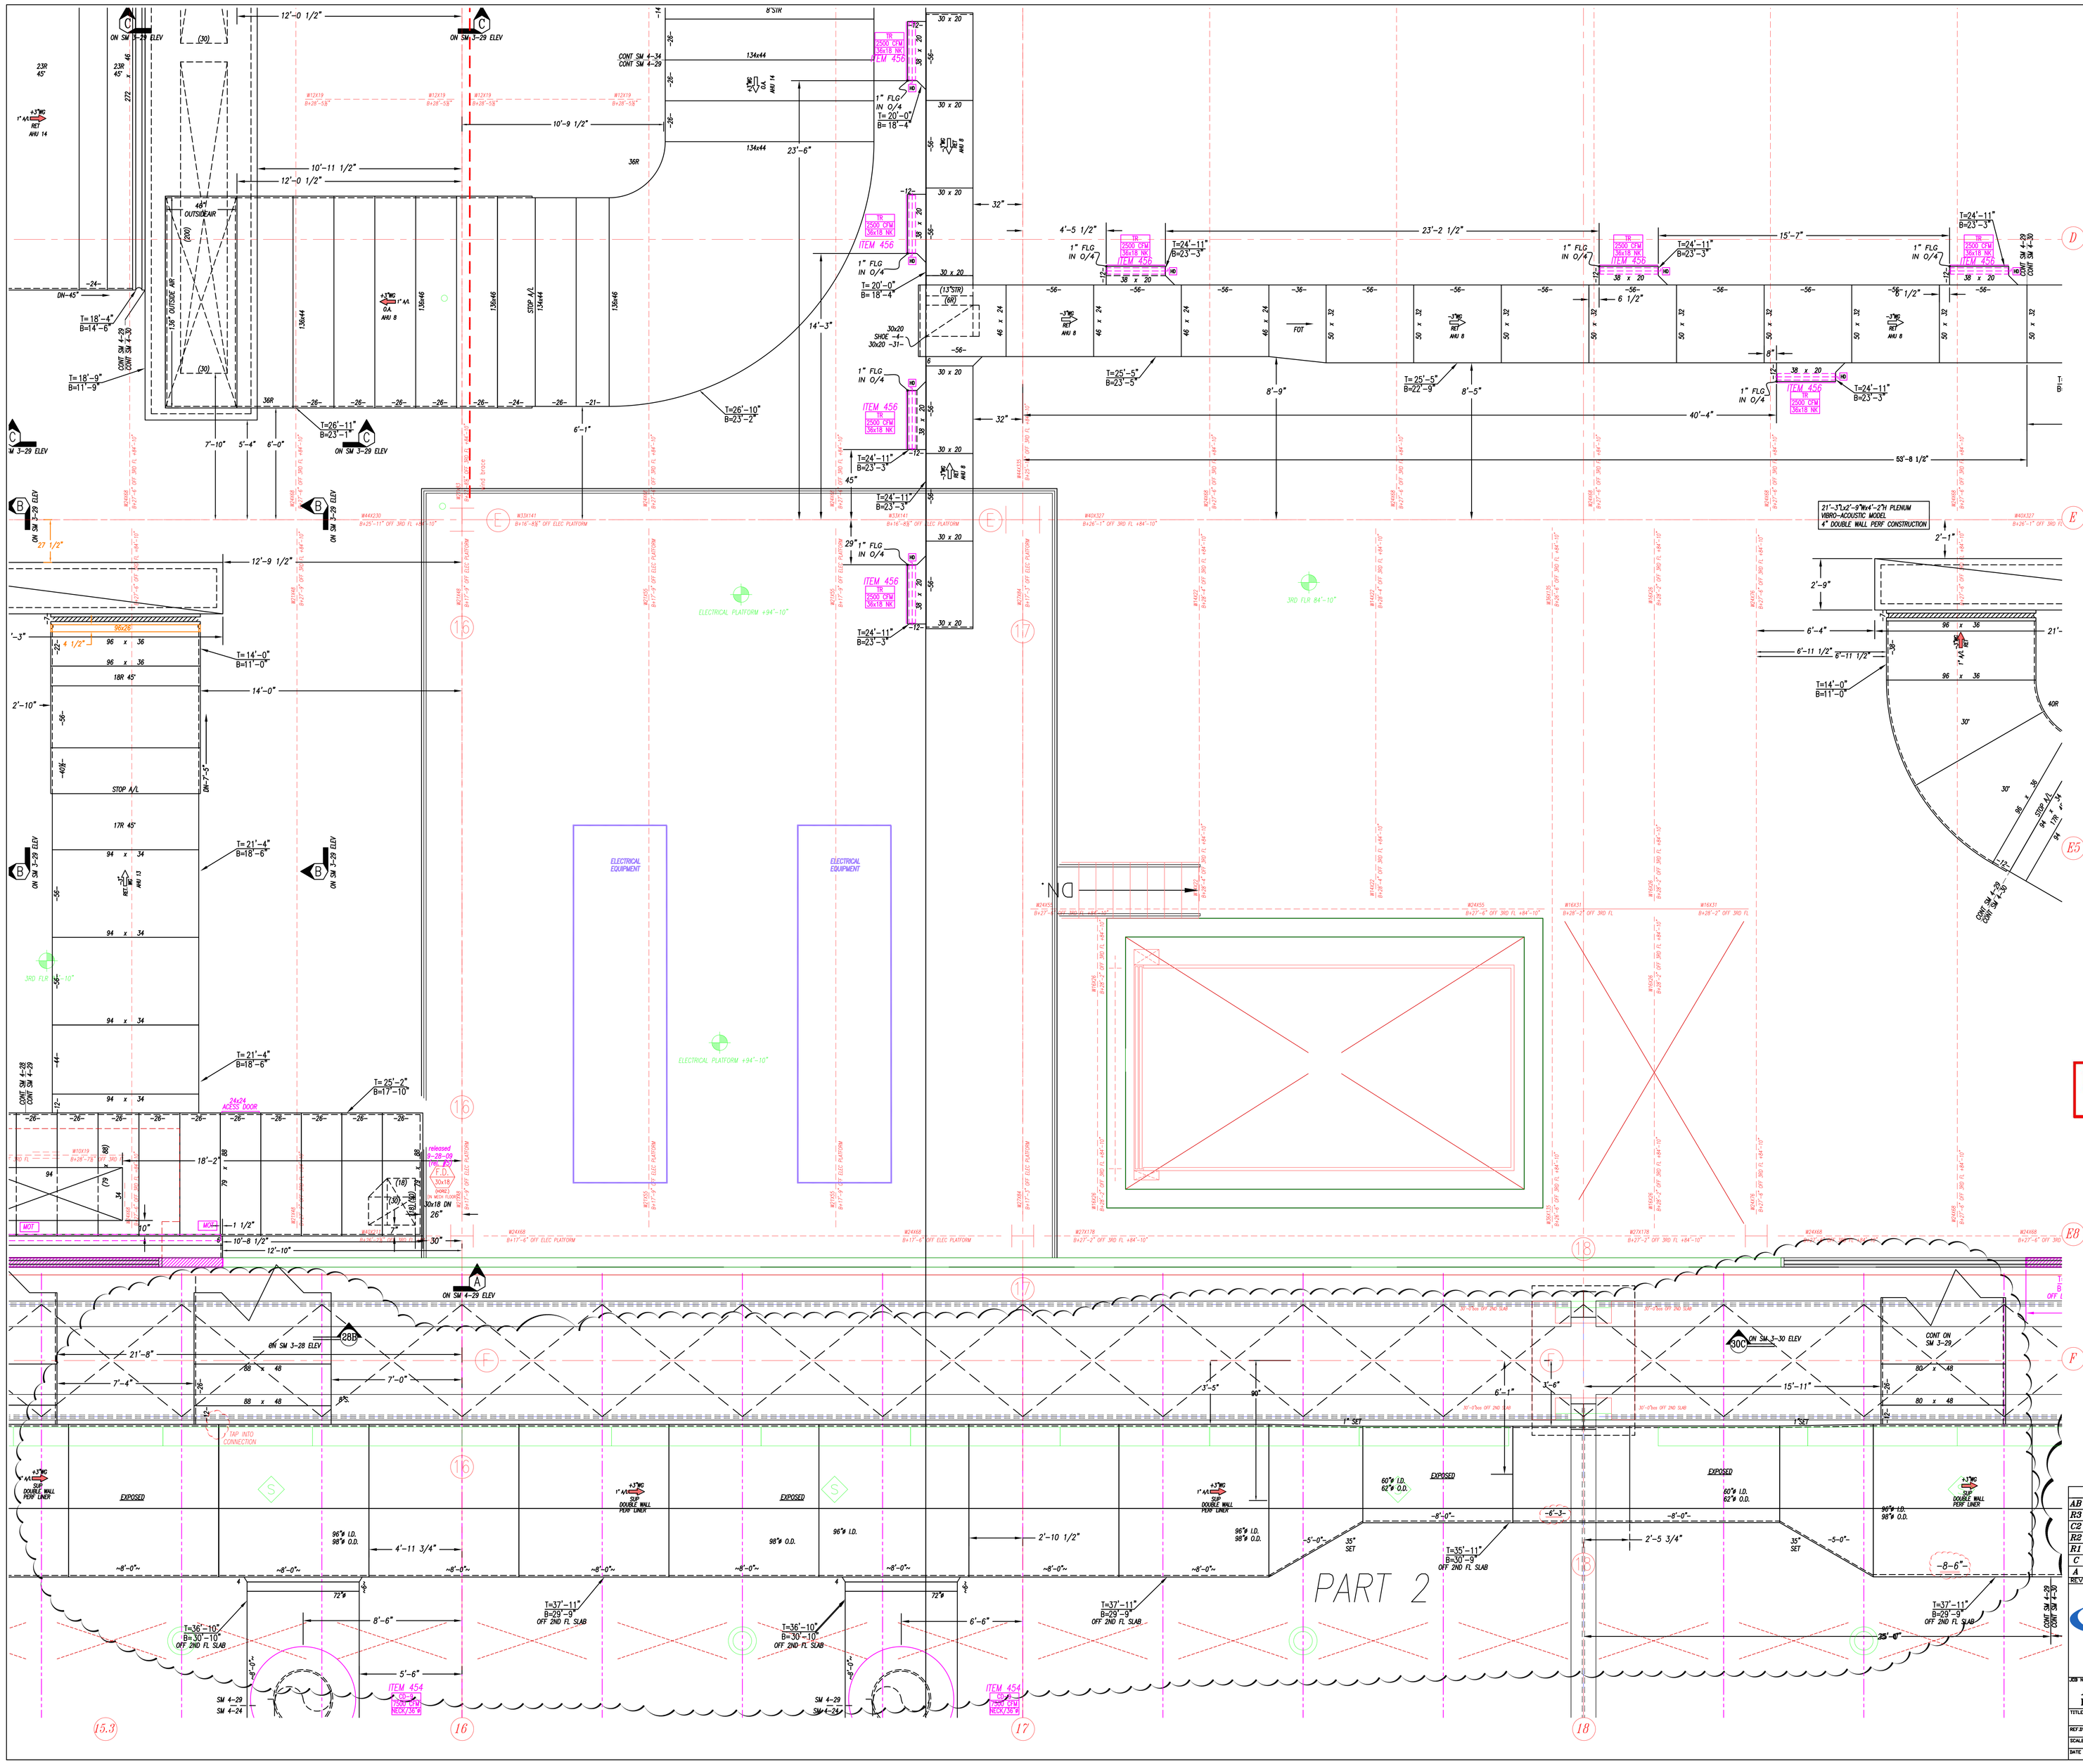
ON SM 3-29 ELEV
12'-0 1/2"
10'-9 1/2"
10'-11 1/2"
48" OUTSIDE AIR (200)
18" OUTSIDE AIR (200)
T=18'-4" B=14'-6"
T=18'-9" B=11'-9"
T=26'-11" B=23'-1"
T=26'-10" B=23'-2"
CONT SM 4-28 CONT SM 4-29
7'-10"
5'-4"
6'-0"
6'-1"
14'-3"
23'-6"
8'-5"TYP.
134x44
136x46
STOP A/L
ITEM 456
TR 2500 CFM 36x18 NK
1" FLG IN O/4
T=20'-0" B=18'-4"
T=24'-11" B=23'-3"
T=25'-5" B=23-5
T=25'-5" B=22'-9"
ITEM 456 TR 2500 CFM 38x18 NK
4'-5 1/2"
23'-2 1/2"
15'-7"
6 1/2"
8'-9"
8'-5"
40'-4"
53'-8 1/2"
FDT
45°
29°
32"
(13"STR)
(6R)
30x20 SHOE -4- 30x20 -31-
ELECTRICAL PLATFORM +94'-10"
3RD FLR 84'-10"
ELECTRICAL EQUIPMENT
21'-3"x2'-9"Wx4'-2"H PLENUM
VIBRO-ACOUSTIC MODEL
4" DOUBLE WALL PERF CONSTRUCTION
2'-1"
2'-9"
6'-4"
6'-11 1/2"
8'-11 1/2"
T=14'-0" B=11'-0"
96 x 36
40R
30"
STOP A/L
14 x 17R 45°
12'-9 1/2"
27 1/2"
2'-10"
14'-0"
18R 45°
17R 45°
94 x 34
T=21'-4" B=18'-6"
T=25'-2" B=17'-10"
24x24 ACCESS DOOR
18'-2"
79 x 88
94
10"
1 1/2"
10'-8 1/2"
12'-10"
30x18 DN 26"
(18")
(50")
MOT
MOT
released 11-28-09 TPK, PM
T.O. 30x18 DWG M-MCH-1104R2
ON SM 4-29 ELEV
6N SM 3-28 ELEV
26B
21'-8"
7'-4"
7'-0"
88 x 48
3'-5"
6'-1"
3'-6"
15'-11"
90°
1" SET
30C
ON SM 3-30 ELEV
CONT ON SM 3-29
80 x 48
INF. W/O CONNECTION
+3"WC
1" AA
SUP DOUBLE WALL PERF LINER
EXPOSED
96"ø I.D. 98"ø O.D.
98"ø O.D.
4'-11 3/4"
2'-10 1/2"
2'-5 3/4"
60"ø I.D. 62"ø O.D.
90"ø I.D. 98"ø O.D.
T=36'-10" B=30'-10" OFF 2ND FL SLAB
T=37'-11" B=29'-9" OFF 2ND FL SLAB
T=35'-11" B=30'-9" OFF 2ND FL SLAB
72"ø
8'-6"
6'-6"
5'-6"
35" SET
ITEM 454 TR 2500 CFM 36x18 NEK/36"W
SW 4-29 SW 4-24
PART 2
FOURTH FLOOR
NOTES:
1. – ALL DUCT TO BE FABRICATED PER SMACNA CONSTRUCTION STANDARDS.
2. – ⇨ = AIR FLOW – GALV. – NO ACOUST. LINING
3. – 1"AA ⇨ = AIR FLOW –1" ACOUST. LINING
4. – ⇨ SS = AIR FLOW – STAINLESS STEEL
5. – ⇨ ALUM = AIR FLOW – ALUMINUM
6. – ▷ = W.G. CONSTRUCTION OF DUCT
7. – T= 0'-0" = TOP OF DUCT ABOVE FINISHED FLOOR B= 0'-0" = BOTTOM OF DUCT ABOVE FINISHED FLOOR
8. – COORDINATION NOTE – ALLOW 2" ALL AROUND DUCT FOR FLANGE CONNECTIONS AND FOR EXTERNAL INSULATION WHERE REQUIRED.
AB AS BUILT EG 01-29-10
R3 REVISED FOR GRDS EG 01-29-10
C2 FOR CONSTRUCTION (PART 2) EG 09-22-09
R2 REVISED FOR UNITS AND MODS EG 09-22-09
R1 REVISED FOR PLENUM DETAILS EG 08-07-09
C FOR CONSTRUCTION BLJ 06-30-09
A FOR APPROVAL BLJ 06-08-09
DEVI DESCRIPTION DR. DATE
RECORD DRAWINGS
The Keating JV
Advantage CONTRACTING GROUP, INC.
A Minority Owned Business Enterprise
219 W. Hortter Street • Philadelphia, PA 19119
Phone: 215-844-0191 Fax: 215-844-0192
www.advantagecontracts.com
JOB NAME
PA CONVENTION CENTER
EXPANSION AND RENOVATION
TITLE
LEVEL 4 PARTIAL DUCT PLAN
REF.DWG- M243
LOC. COLS.
SCALE 3/8"=1'-0"
CH.
JOB NO. 8520
DATE 06-08-09
DR. BLJ
DWG. NO. SM 4-29

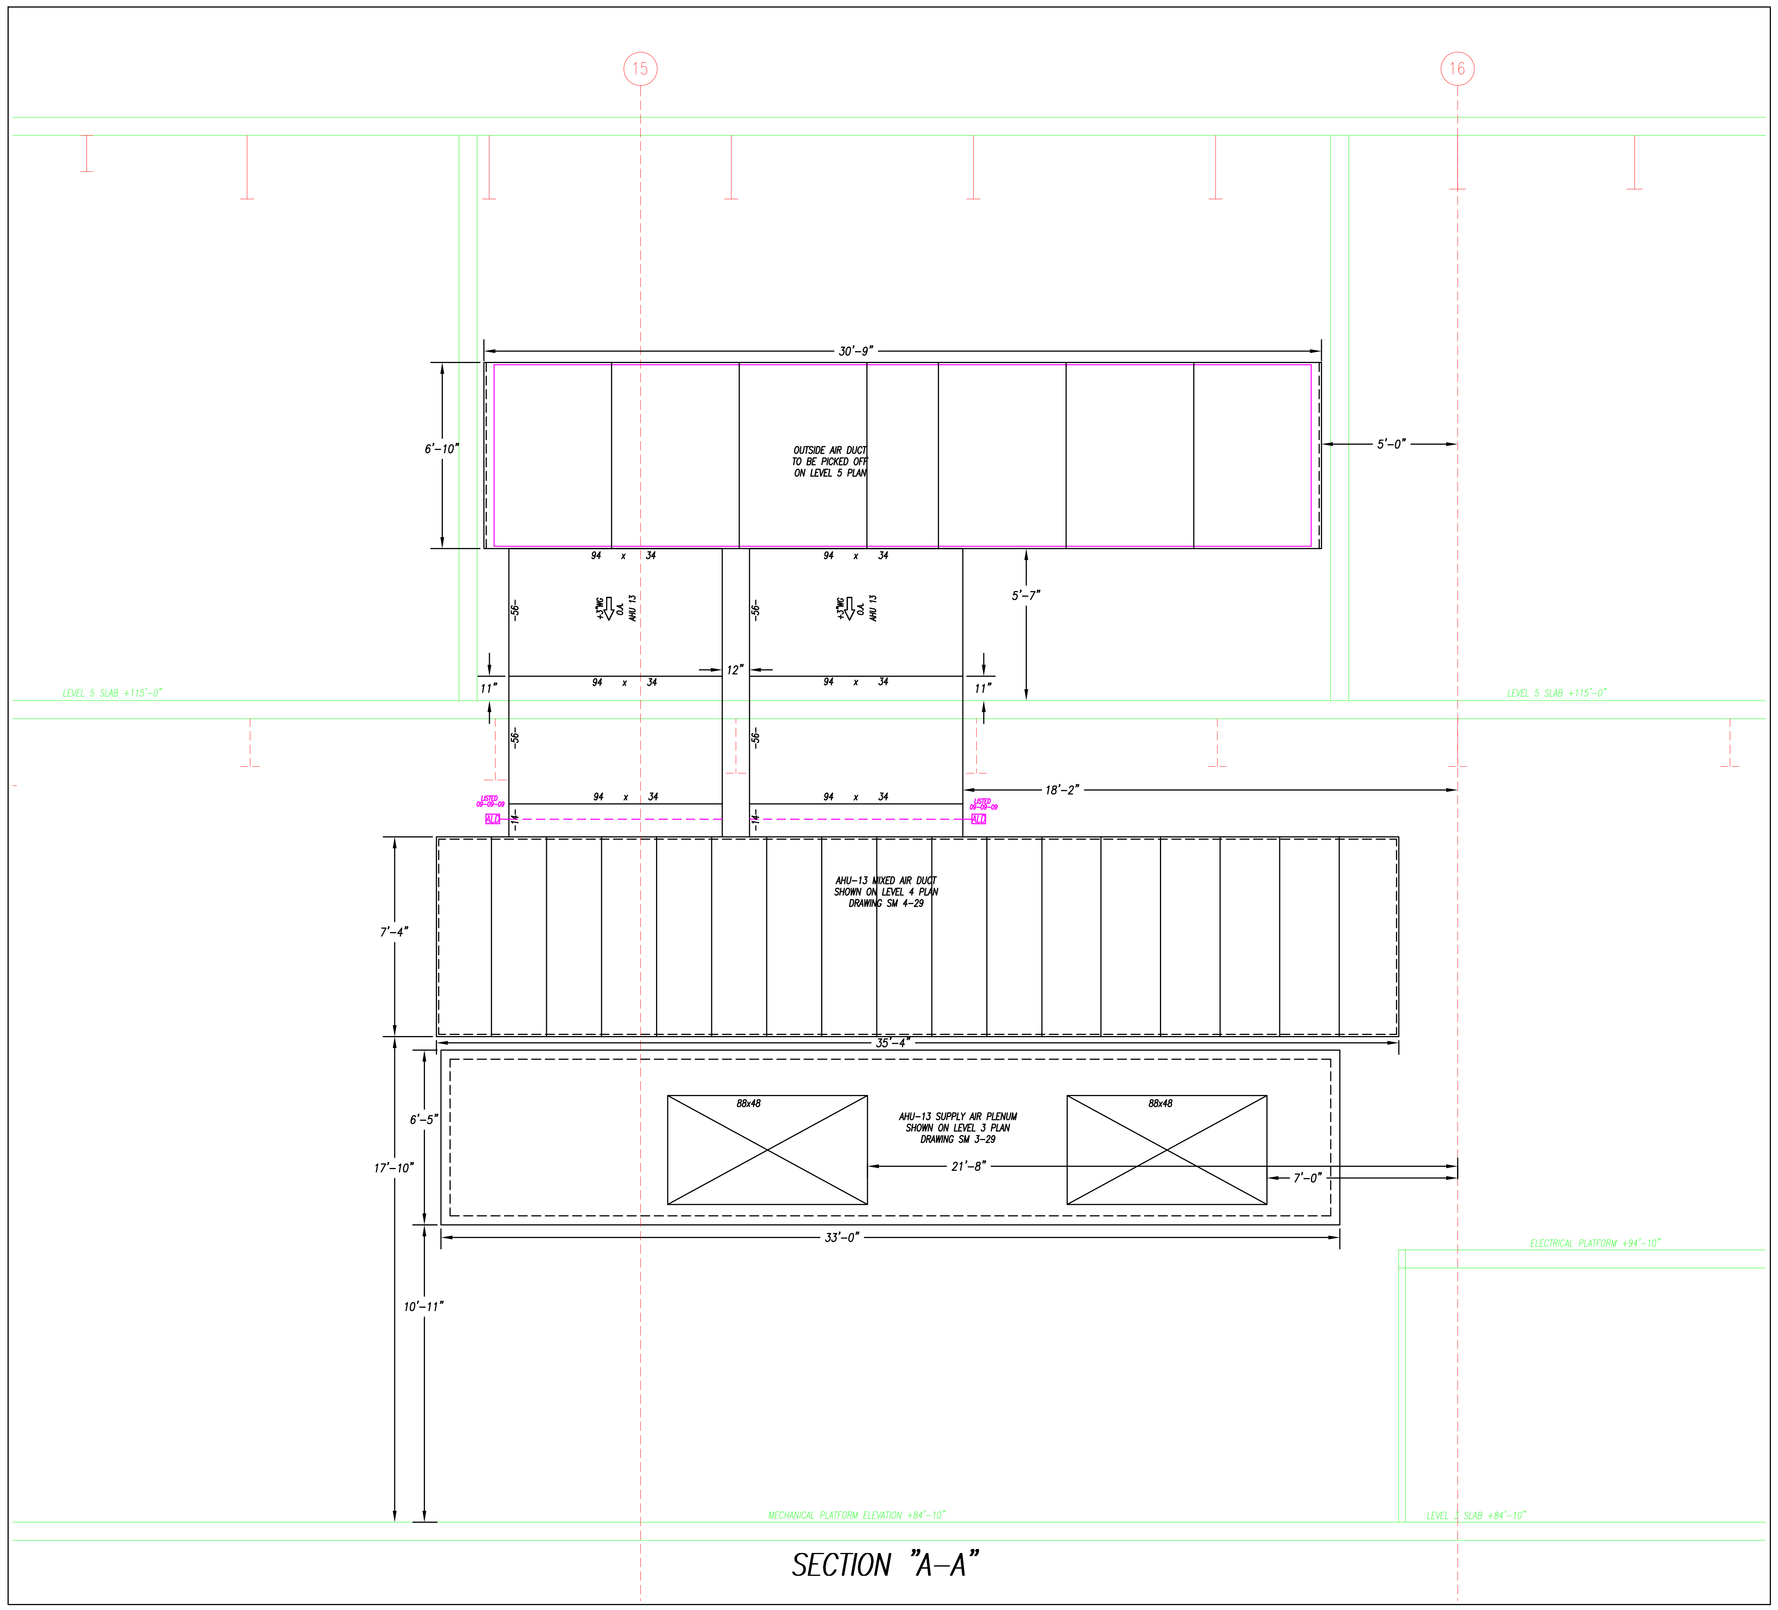

SECTION "A-A"

RECORD DRAWINGS
The Keating JV

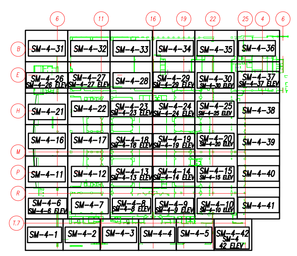

FOURTH FLOOR

NOTES:

1. - ALL DUCT TO BE FABRICATED PER SMACNA CONSTRUCTION STANDARDS.
2. - <=> = AIR FLOW - GALV. - NO ACOUST. LINING
3. - 1"AL<=> = AIR FLOW -1" ACOUST. LINING
4. - <=> SS = AIR FLOW - STAINLESS STEEL
5. - <=> ALUM = AIR FLOW - ALUMINUM
6. - ▷ = W.G. CONSTRUCTION OF DUCT
7. - 1x 0'-0 = TOP OF DUCT ABOVE FINISHED FLOOR
   8x 0'-0 = BOTTOM OF DUCT ABOVE FINISHED FLOOR
8. - COORDINATION NOTE - ALLOW 3" ALL AROUND DUCT FOR FLANGE CONNECTIONS AND TDC EXTERNAL INSULATION WHERE REQUIRED.

REV.	DESCRIPTION	DR.	DATE
AB	AS BUILT	BLJ	01-11-11
C	FOR CONSTRUCTION	BLJ	06-30-09
A	FOR APPROVAL	BLJ	06-08-09

Advantage CONTRACTING INC.
A Minority Owned Business Enterprise
219 W. Hortter Street • Philadelphia, PA 19119
Phone: 215-844-0191 Fax: 215-844-0192
www.advantagecontracts.com

JOB NAME: PA CONVENTION CENTER
EXPANSION AND RENOVATION

TITLE: LEVEL 4 DUCT ELEVATIONS

REF. DWG: SM 4-29	LOC. COLS:		
SCALE: 3/8"=1'-0"	CK.	JOB NO.	8520
DATE: 06-08-09	DR. BLJ	DWG. NO.	SM 4-29 ELEV

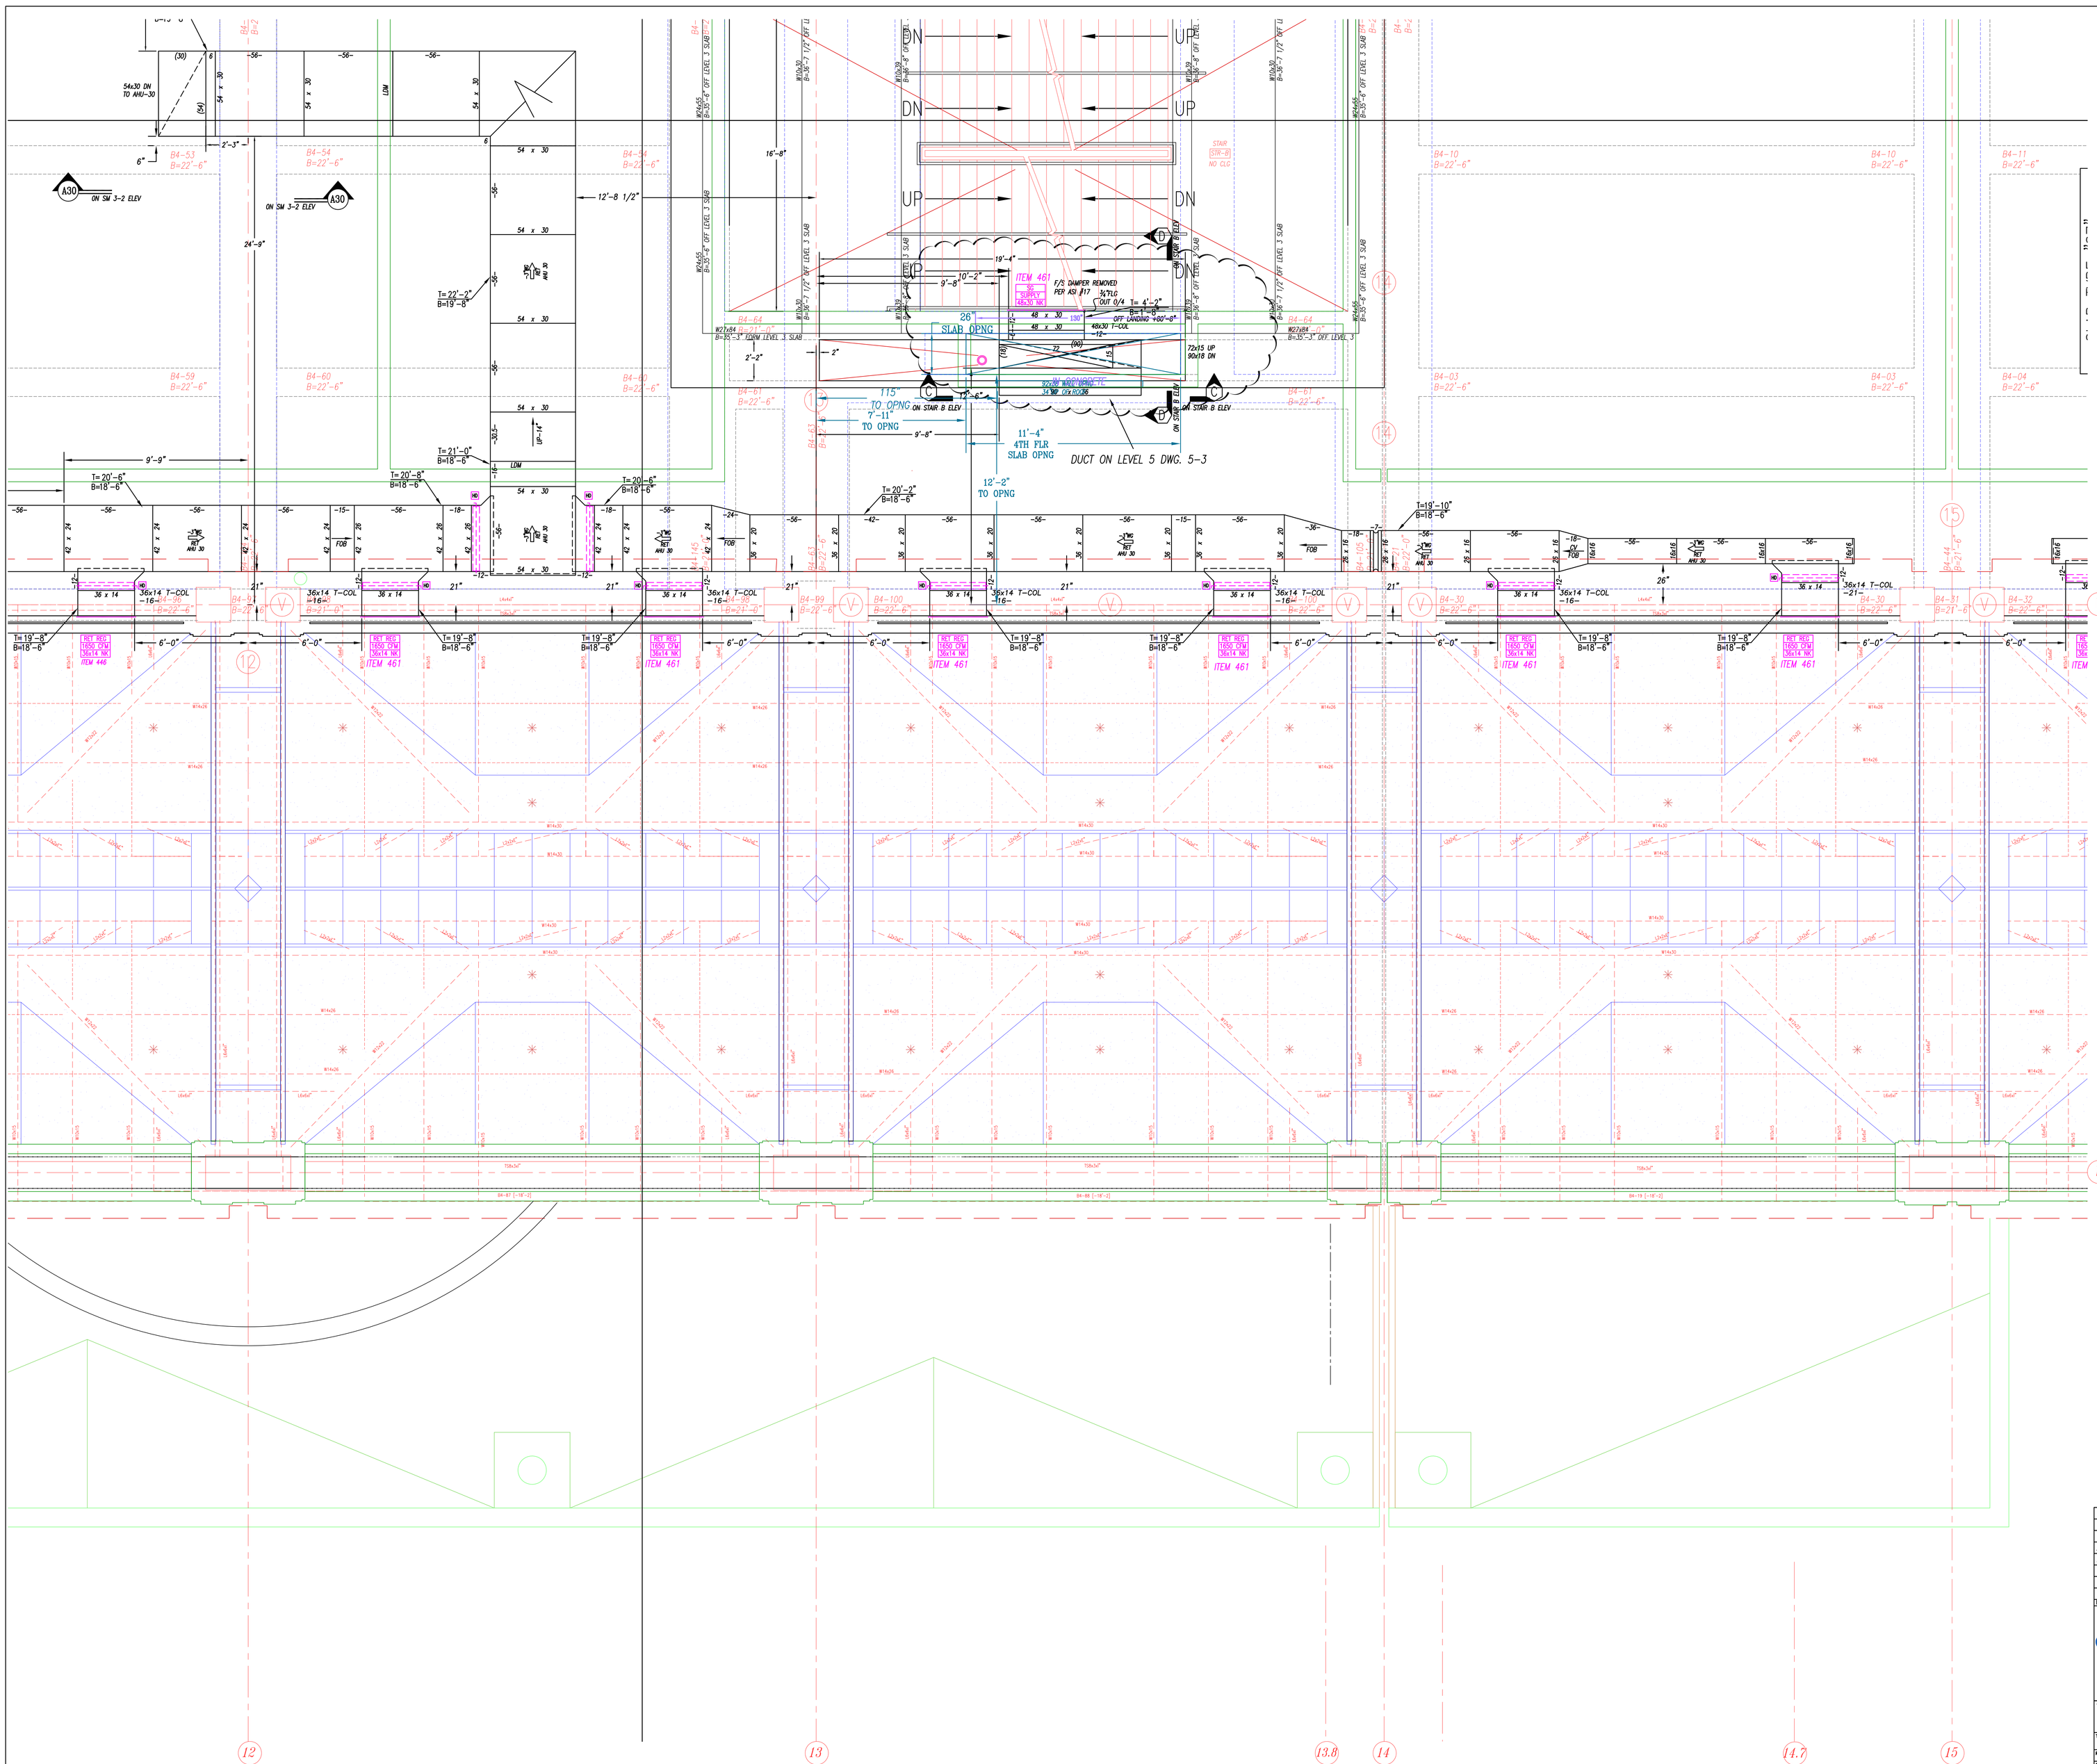

SPRINKLER COORDINATION NOTES:
SPRINKLER PIPE ELEVATED TO CENTER LINE OF PIPE
ALL LINES NOT SIZED TO BE 2" MAX.
FOR COORD PURPOSES ONLY - THANKS

RECORD DRAWINGS
The Keating JV

FOURTH FLOOR

NOTES:

1. – ALL DUCT TO BE FABRICATED PER SMACNA CONSTRUCTION STANDARDS.
2. – <C> = AIR FLOW – GALV. – NO ACOUST. LINING
3. – <AA150> = AIR FLOW –1" ACOUST. LINING
4. – <S> SS = AIR FLOW – STAINLESS STEEL
5. – <C> ALUM = AIR FLOW – ALUMINUM
6. – ▷ = W.G. CONSTRUCTION OF DUCT
7. – $\frac{7\pm\ 0'-0}{8\pm\ 9'-0}$ = TOP OF DUCT ABOVE FINISHED FLOOR / BOTTOM OF DUCT ABOVE FINISHED FLOOR
8. – COORDINATION NOTE – ALLOW 2" ALL AROUND DUCT FOR FLANGE CONNECTIONS AND FOR EXTERNAL INSULATION WHERE REQUIRED.

REV.	DESCRIPTION	BY	DATE
AB	AS BUILT	EG	01-11-11
R1	REVISED FOR GRDS	EG	01-29-10
C	FOR CONSTRUCTION	EG	11-04-09
S	SIGN-OFF	BLJ	08-19-09
A	FOR APPROVAL	BLJ	05-19-09

Advantage CONTRACTING INC.
A Minority Owned Business Enterprise
219 W. Hortter Street • Philadelphia, PA 19119
Phone: 215-844-0191 Fax: 215-844-0192
www.advantagecontracts.com

JOB NAME: PA CONVENTION CENTER
EXPANSION AND RENOVATION

TITLE: LEVEL 4 PARTIAL DUCT PLAN

REF.DWG.- M242	LOC. COILS.		
SCALE 3/8"=1'-0"	CH.	JOB NO. 8520	
DATE XX-XX-XX	DR. BLJ	DWG. NO. SM 4-3	

RECORD DRAWINGS
The Keating JV

PART 2

FOURTH FLOOR

NOTES:
1. – ALL DUCT TO BE FABRICATED PER SMACNA CONSTRUCTION STANDARDS.
2. – <=> = AIR FLOW – GALV. – NO ACOUST. LINING
3. – <=> = AIR FLOW – 1" ACOUST. LINING
4. – <=> IS = AIR FLOW – STAINLESS STEEL
5. – <=> ALM = AIR FLOW – ALUMINUM
6. – ▷ = W.G. CONSTRUCTION OF DUCT
7. – T= 0'-0 = TOP OF DUCT ABOVE FINISHED FLOOR
B= 0'-0 = BOTTOM OF DUCT ABOVE FINISHED FLOOR
8. – COORDINATION NOTE – ALLOW 3" ALL AROUND DUCT FOR FLANGE CONNECTIONS AND FOR EXTERNAL INSULATION WHERE REQUIRED.

REV	DESCRIPTION	DR.	DATE
AB	AS BUILT	EG	01-29-10
R3	REVISED FOR GRDS	EG	01-29-10
C2	FOR CONSTRUCTION (PART 2)	EG	09-22-09
R2	REVISED FOR UNITS AND MODS	EG	09-22-09
R1	PLENUM DETAILED	EG	08-07-09
S	SIGN OFF	BLJ	07-09-09
C	FOR CONSTRUCTION	BLJ	06-22-09
A	FOR APPROVAL	BLJ	06-08-09

Advantage CONTRACTING INC.
A Minority Owned Business Enterprise
219 W. Hortter Street • Philadelphia, PA 19119
Phone: 215-844-0191 Fax: 215-844-0192
www.advantagecontracts.com

JOB NAME: PA CONVENTION CENTER
EXPANSION AND RENOVATION

TITLE: LEVEL 4 PARTIAL DUCT PLAN

REF DWG: M243 M246	LOC. COLS.		
SCALE: 1/8"=1'-0"	CH.	JOB NO.	8520
DATE: 06-08-09	DR. BLJ	DWG. NO.	SM 4-30

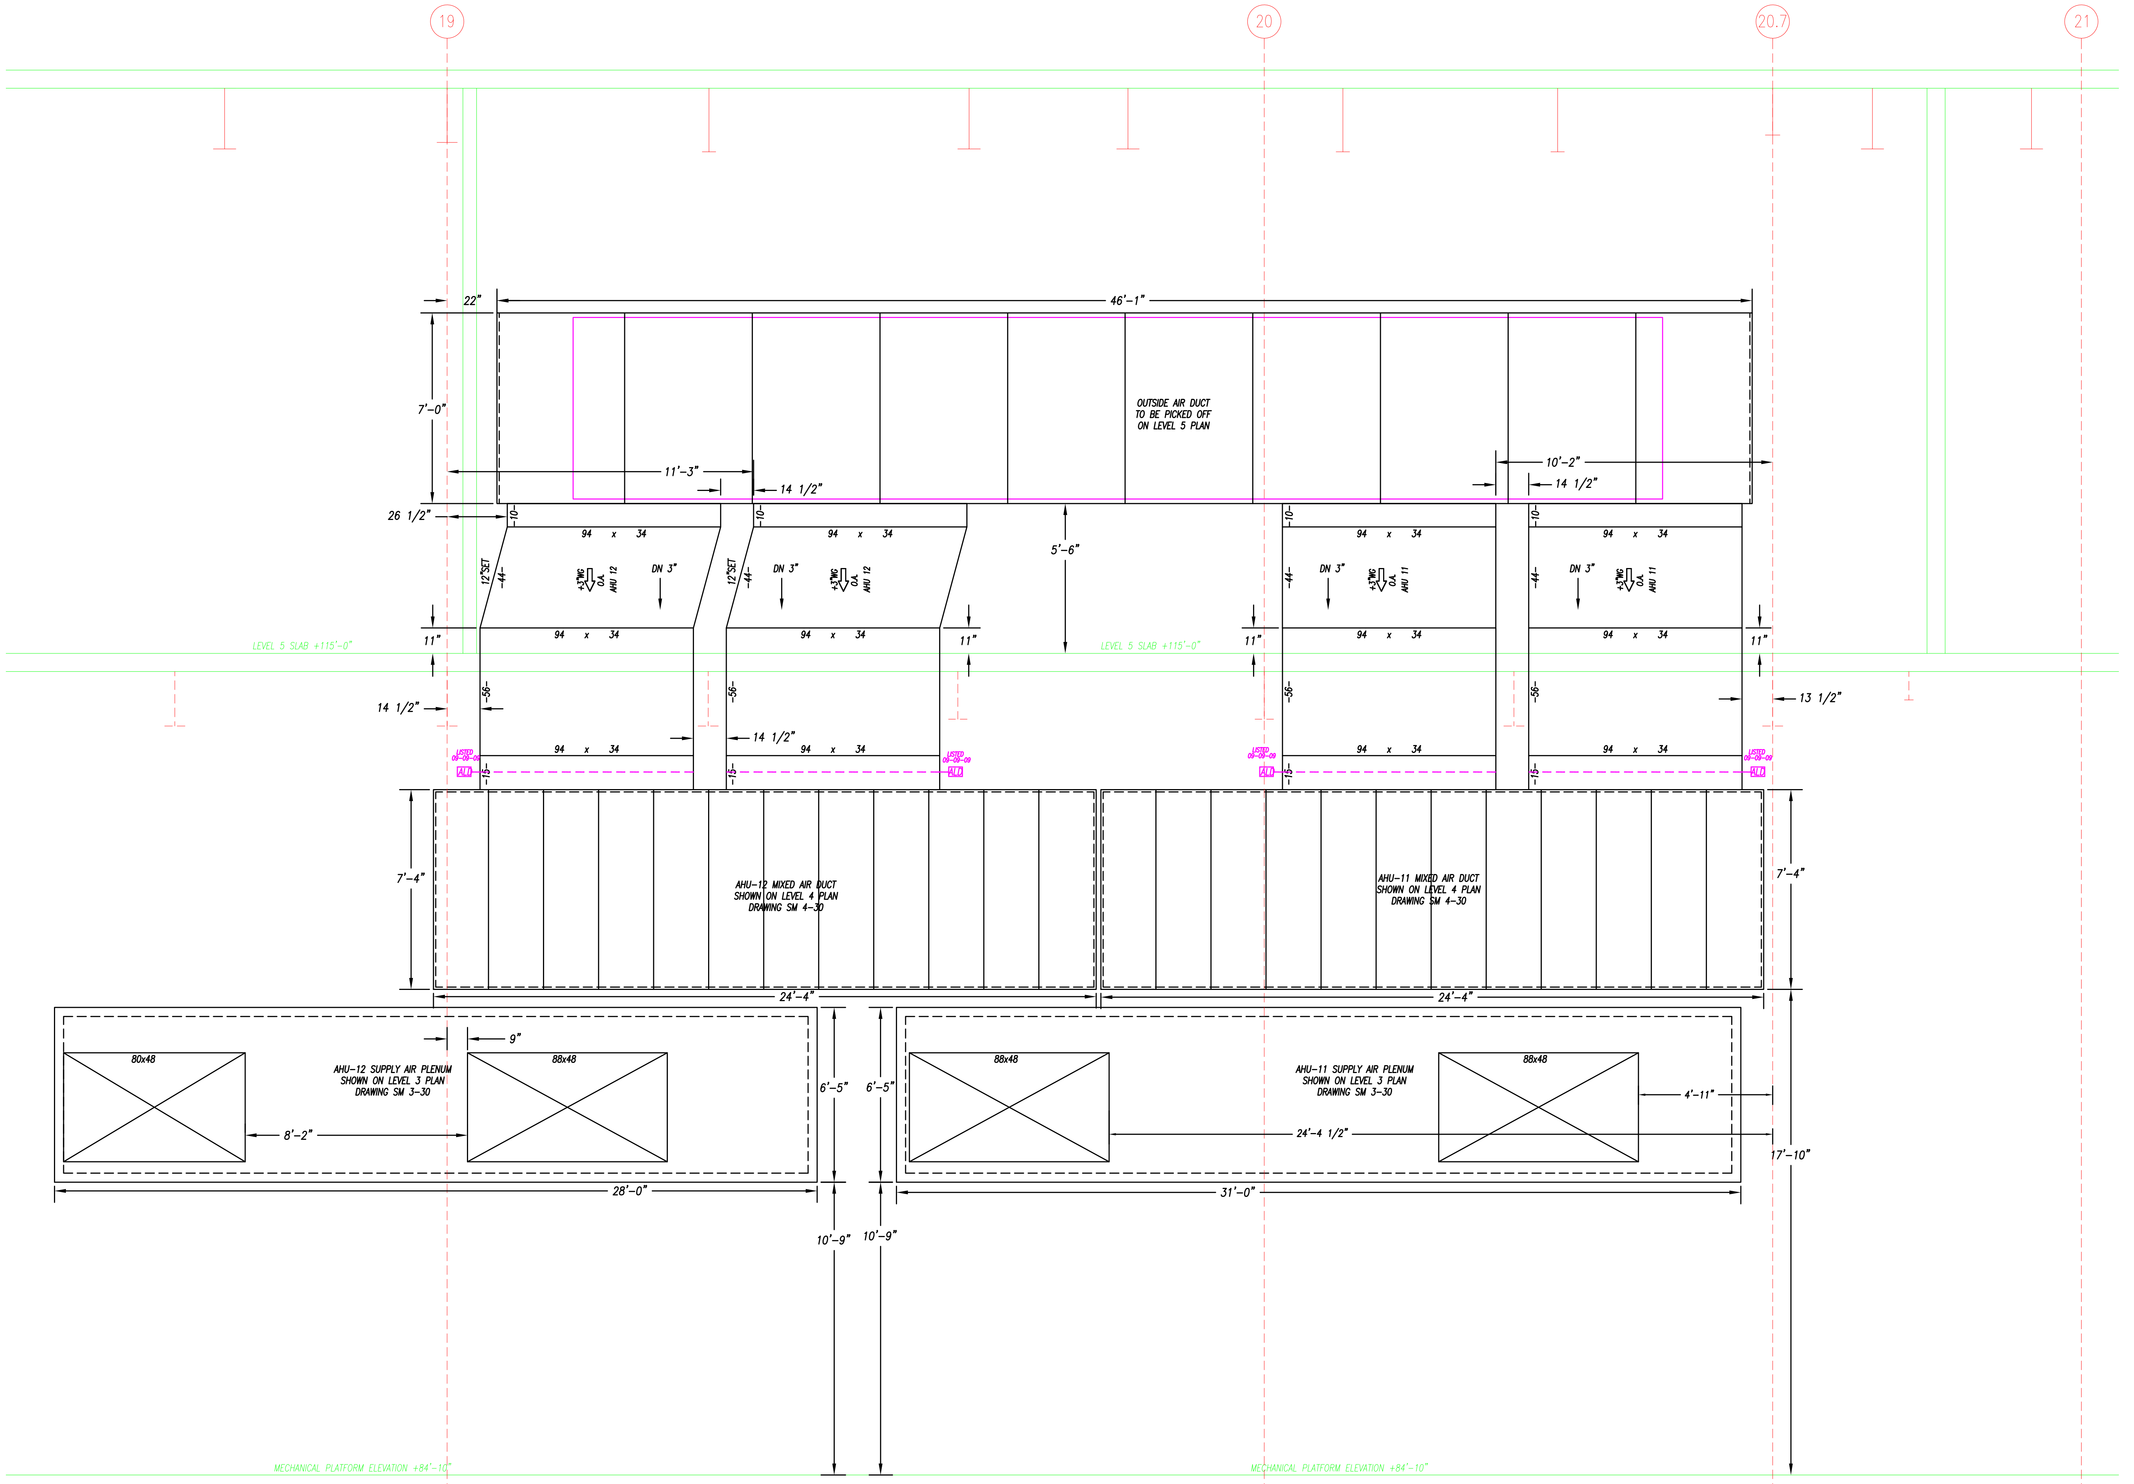

SECTION "A–A"

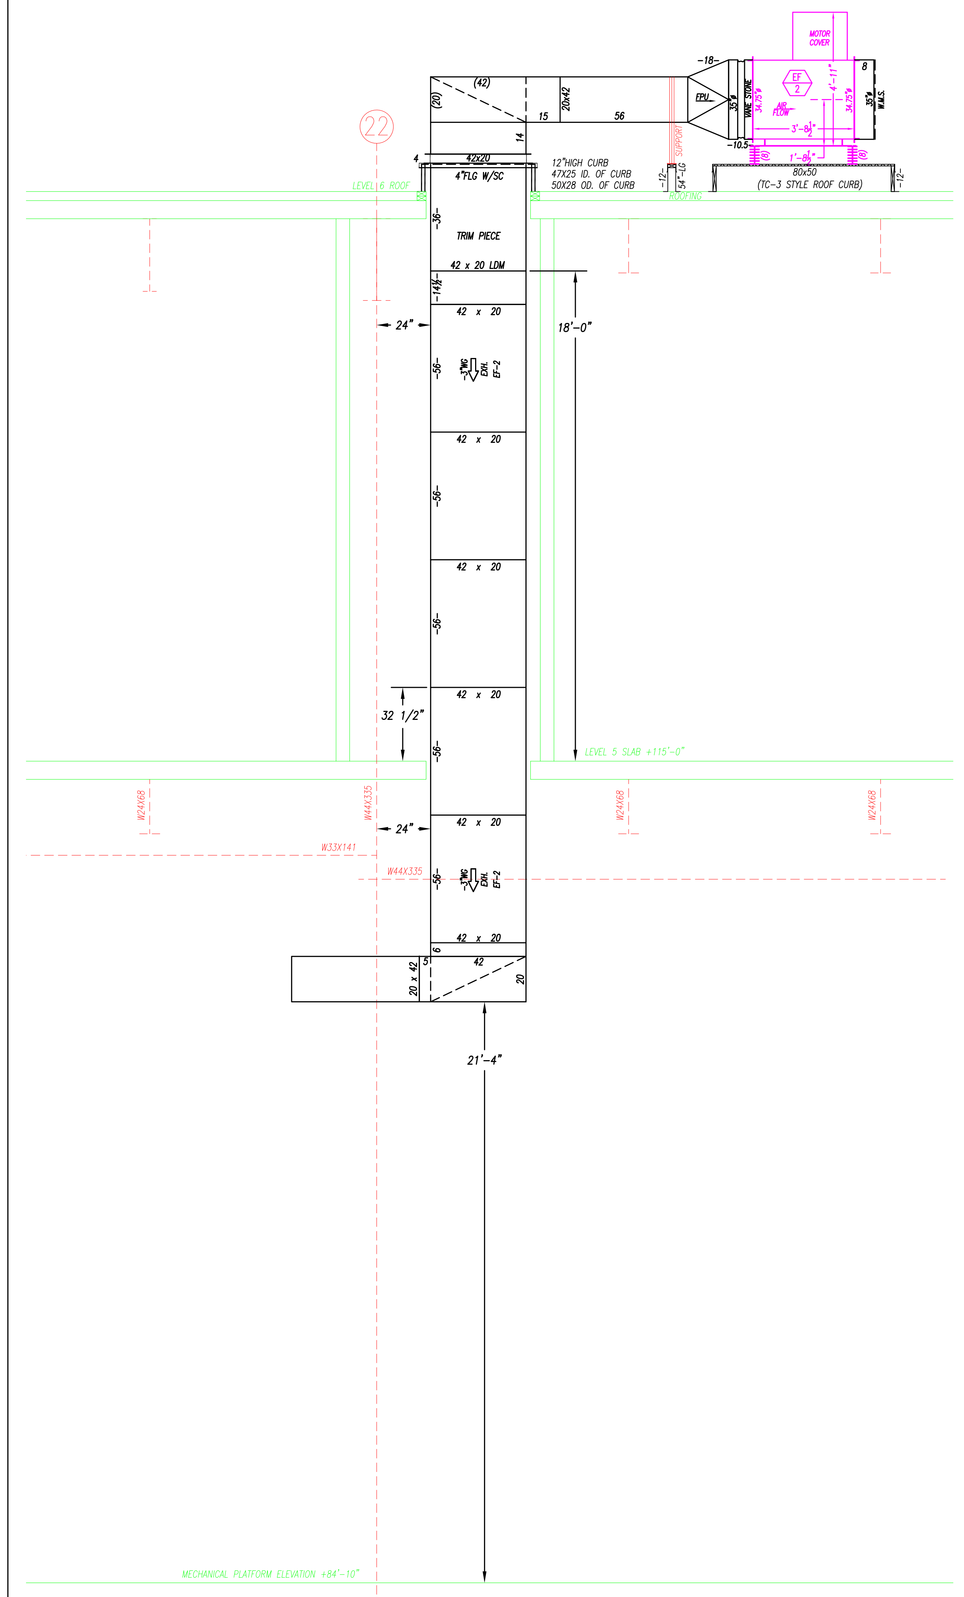

SECTION "B–B"

RECORD DRAWINGS
The Keating JV

NOTES:

1. – = ALL DUCT TO BE FABRICATED PER SMACNA CONSTRUCTION STANDARDS.
2. – <G> = AIR FLOW – GALV. – NO ACOUST. LINING
3. – <A> = AIR FLOW –1" ACOUST. LINING
4. – <S> = AIR FLOW – STAINLESS STEEL
5. – <AL> = AIR FLOW – ALUMINUM
6. – ▷ = W.G. CONSTRUCTION OF DUCT
7. – 5x 6'-0" = TOP OF DUCT ABOVE FINISHED FLOOR
   B= 0'-0" = BOTTOM OF DUCT ABOVE FINISHED FLOOR
8. – COORDINATION NOTE – ALLOW 3" ALL AROUND DUCT FOR FLANGE CONNECTIONS AND FOR EXTERNAL INSULATION WHERE REQUIRED.

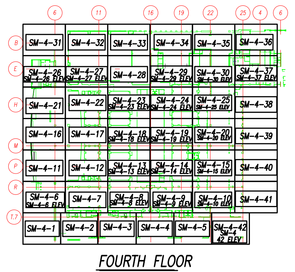

FOURTH FLOOR

REV.	DESCRIPTION	DR.	DATE
AB	AS BUILT	BLJ	01-11-11
C2	FOR CONSTRUCTION (REV ELEV BB)	BLJ	12-09-09
C	FOR CONSTRUCTION	BLJ	08-20-09
A	FOR APPROVAL	BLJ	08-08-09

Advantage CONTRACTING INC.
A Minority Owned Business Enterprise
219 W. Hortter Street • Philadelphia, PA 19119
Phone: 215-844-0191 Fax: 215-844-0192
www.advantagecontracts.com

JOB NAME: PA CONVENTION CENTER
EXPANSION AND RENOVATION

TITLE: LEVEL 4 DUCT ELEVATIONS

REF DWG-	SM 4-30	LOC. COLS.	
SCALE	3/8"=1'-0"	CH.	JOB NO. 8520
DATE	06-08-09	DR. BLJ	DWG. NO. SM 4-30 ELEV

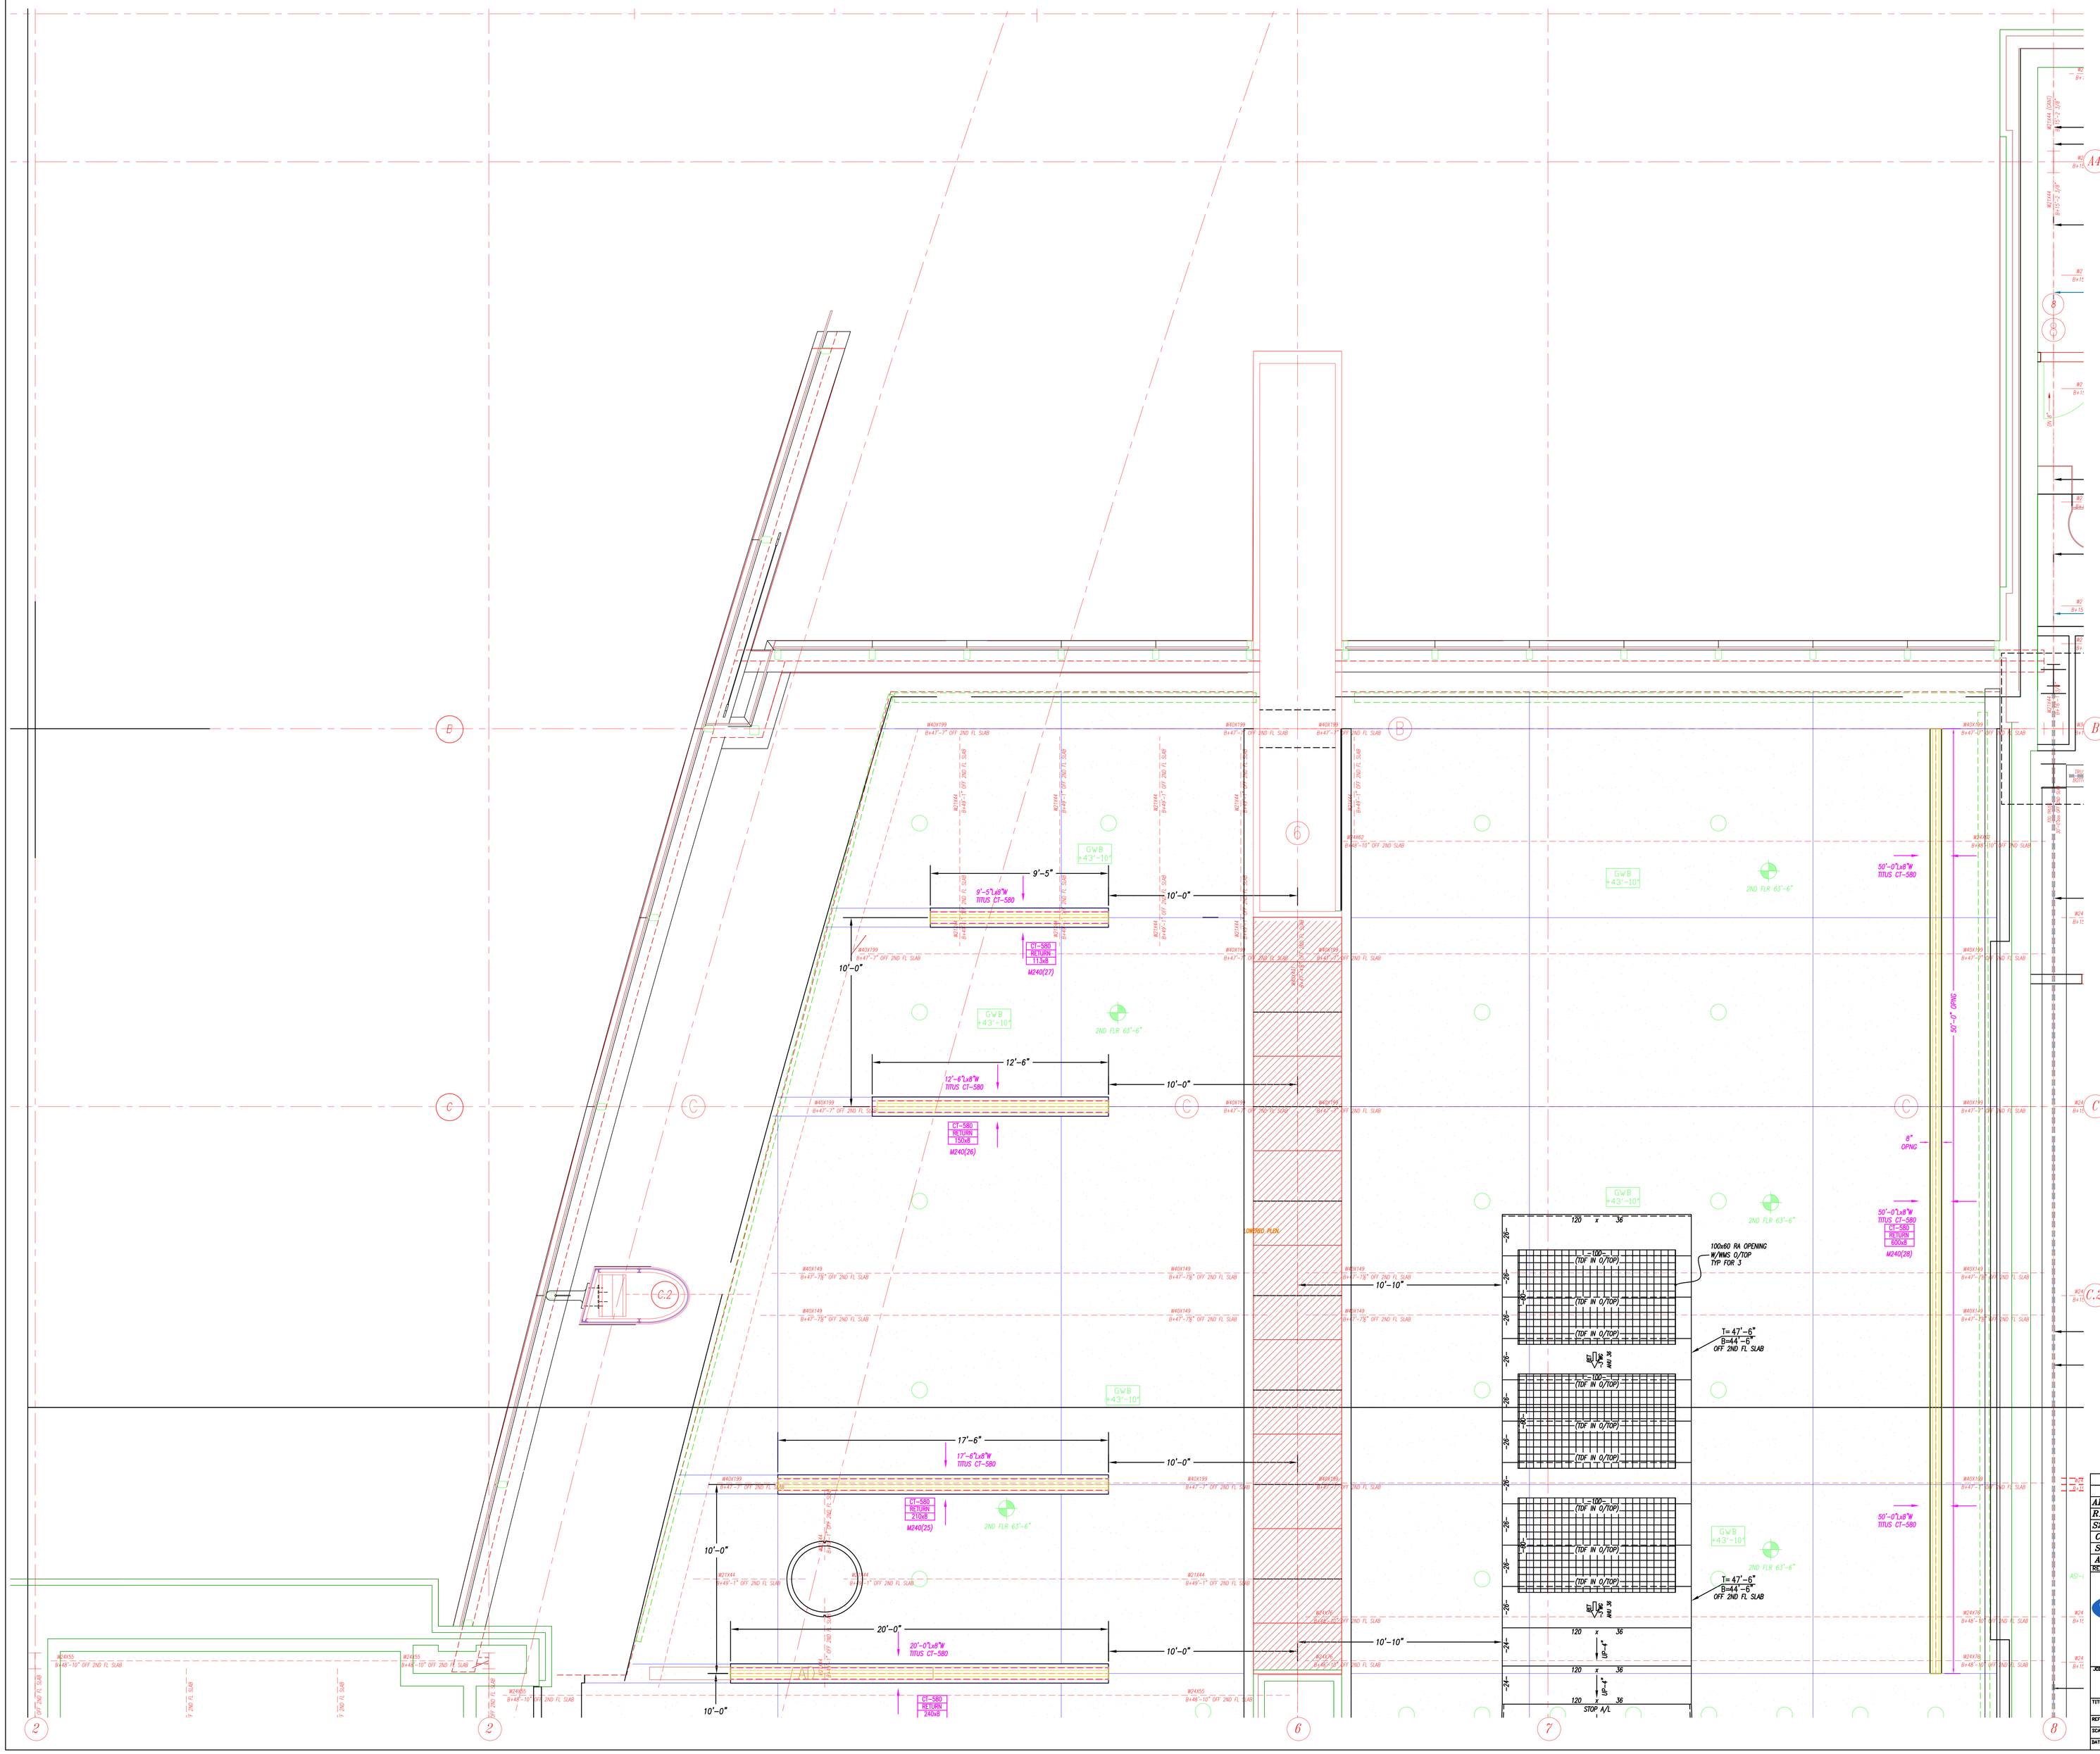

RECORD DRAWINGS
The Keating JV

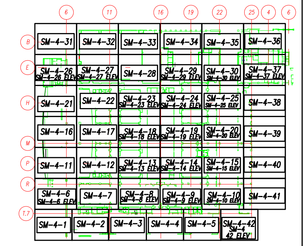

FOURTH FLOOR

NOTES:

1. – ALL DUCT TO BE FABRICATED PER SMACNA CONSTRUCTION STANDARDS.
2. – =\|\|= = AIR FLOW – GALV. – NO ACOUST. LINING
3. – =\|\|=> = AIR FLOW –1" ACOUST. LINING
4. – =\|\|= ≡ = AIR FLOW – STAINLESS STEEL
5. – =\|\|= ALM = AIR FLOW – ALUMINUM
6. – ▷ = W.G. CONSTRUCTION OF DUCT
7. – T= 0'-0" = TOP OF DUCT ABOVE FINISHED FLOOR; B= 0'-0" = BOTTOM OF DUCT ABOVE FINISHED FLOOR
8. – COORDINATION NOTE – ALLOW 2" ALL AROUND DUCT FOR FLANGE CONNECTIONS AND FOR EXTERNAL INSULATION WHERE REQUIRED.

REV	DESCRIPTION	DR.	DATE
AB	AS BUILT	EG	01-29-10
R1	REVISED FOR GRDS	EG	01-29-10
S2	RESIGN (PIPING CONFLICTS)	EG	12-17-09
C	FOR CONSTRUCTION	EG	12-15-09
S	SIGN OFF	BLJ	12-17-09
A	FOR APPROVAL	BLJ	06-08-09

Advantage CONTRACTING INC.
A Minority Owned Business Enterprise
219 W. Hortter Street • Philadelphia, PA 19119
Phone: 215-844-0191 Fax: 215-844-0192
www.advantagecontracts.com

JOB NAME: PA CONVENTION CENTER
EXPANSION AND RENOVATION

TITLE: LEVEL 4 PARTIAL DUCT PLAN

REF.DWG- M240	LOC. COLS.		
SCALE 3/8"=1'-0"	CH.	JOB NO.	8520
DATE 06-09-08	DR. BLJ	DWG. NO.	SM 4-31

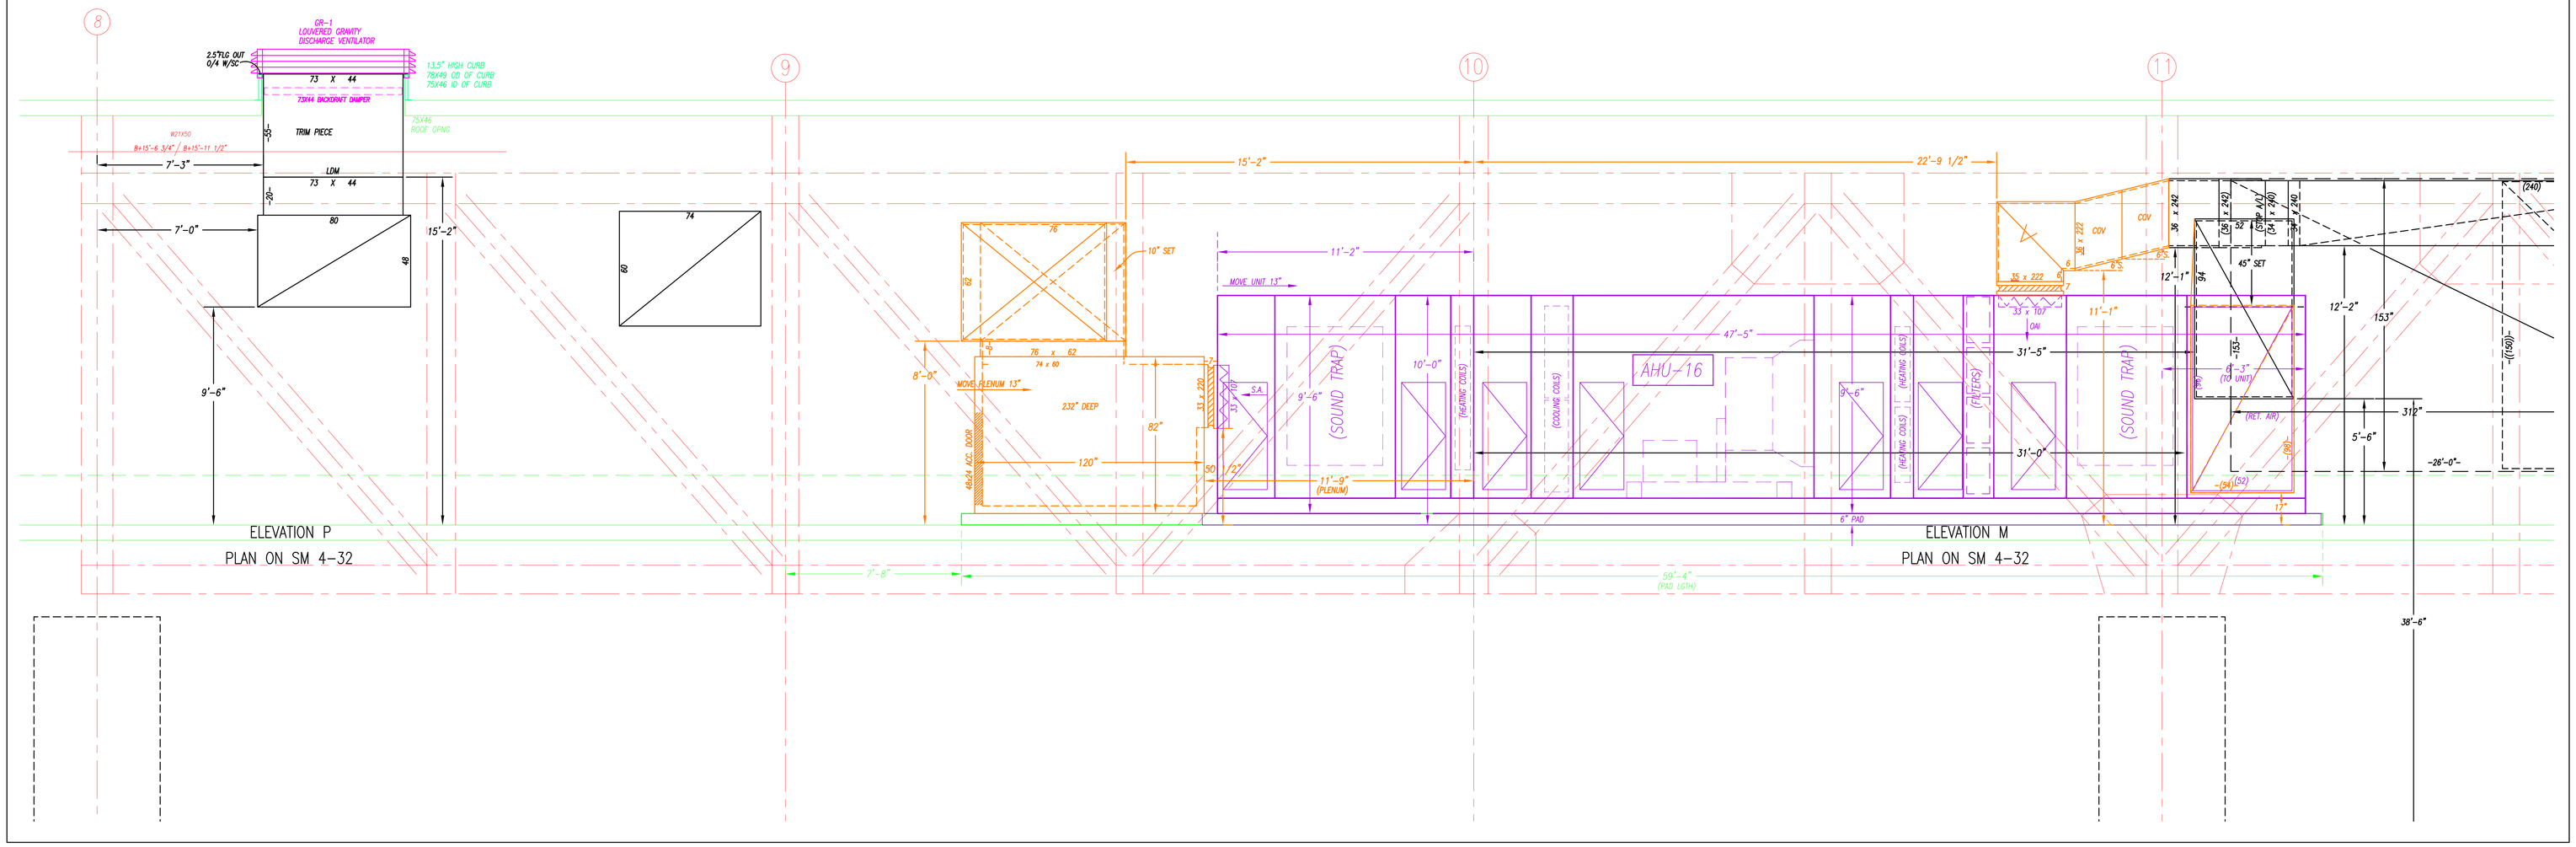

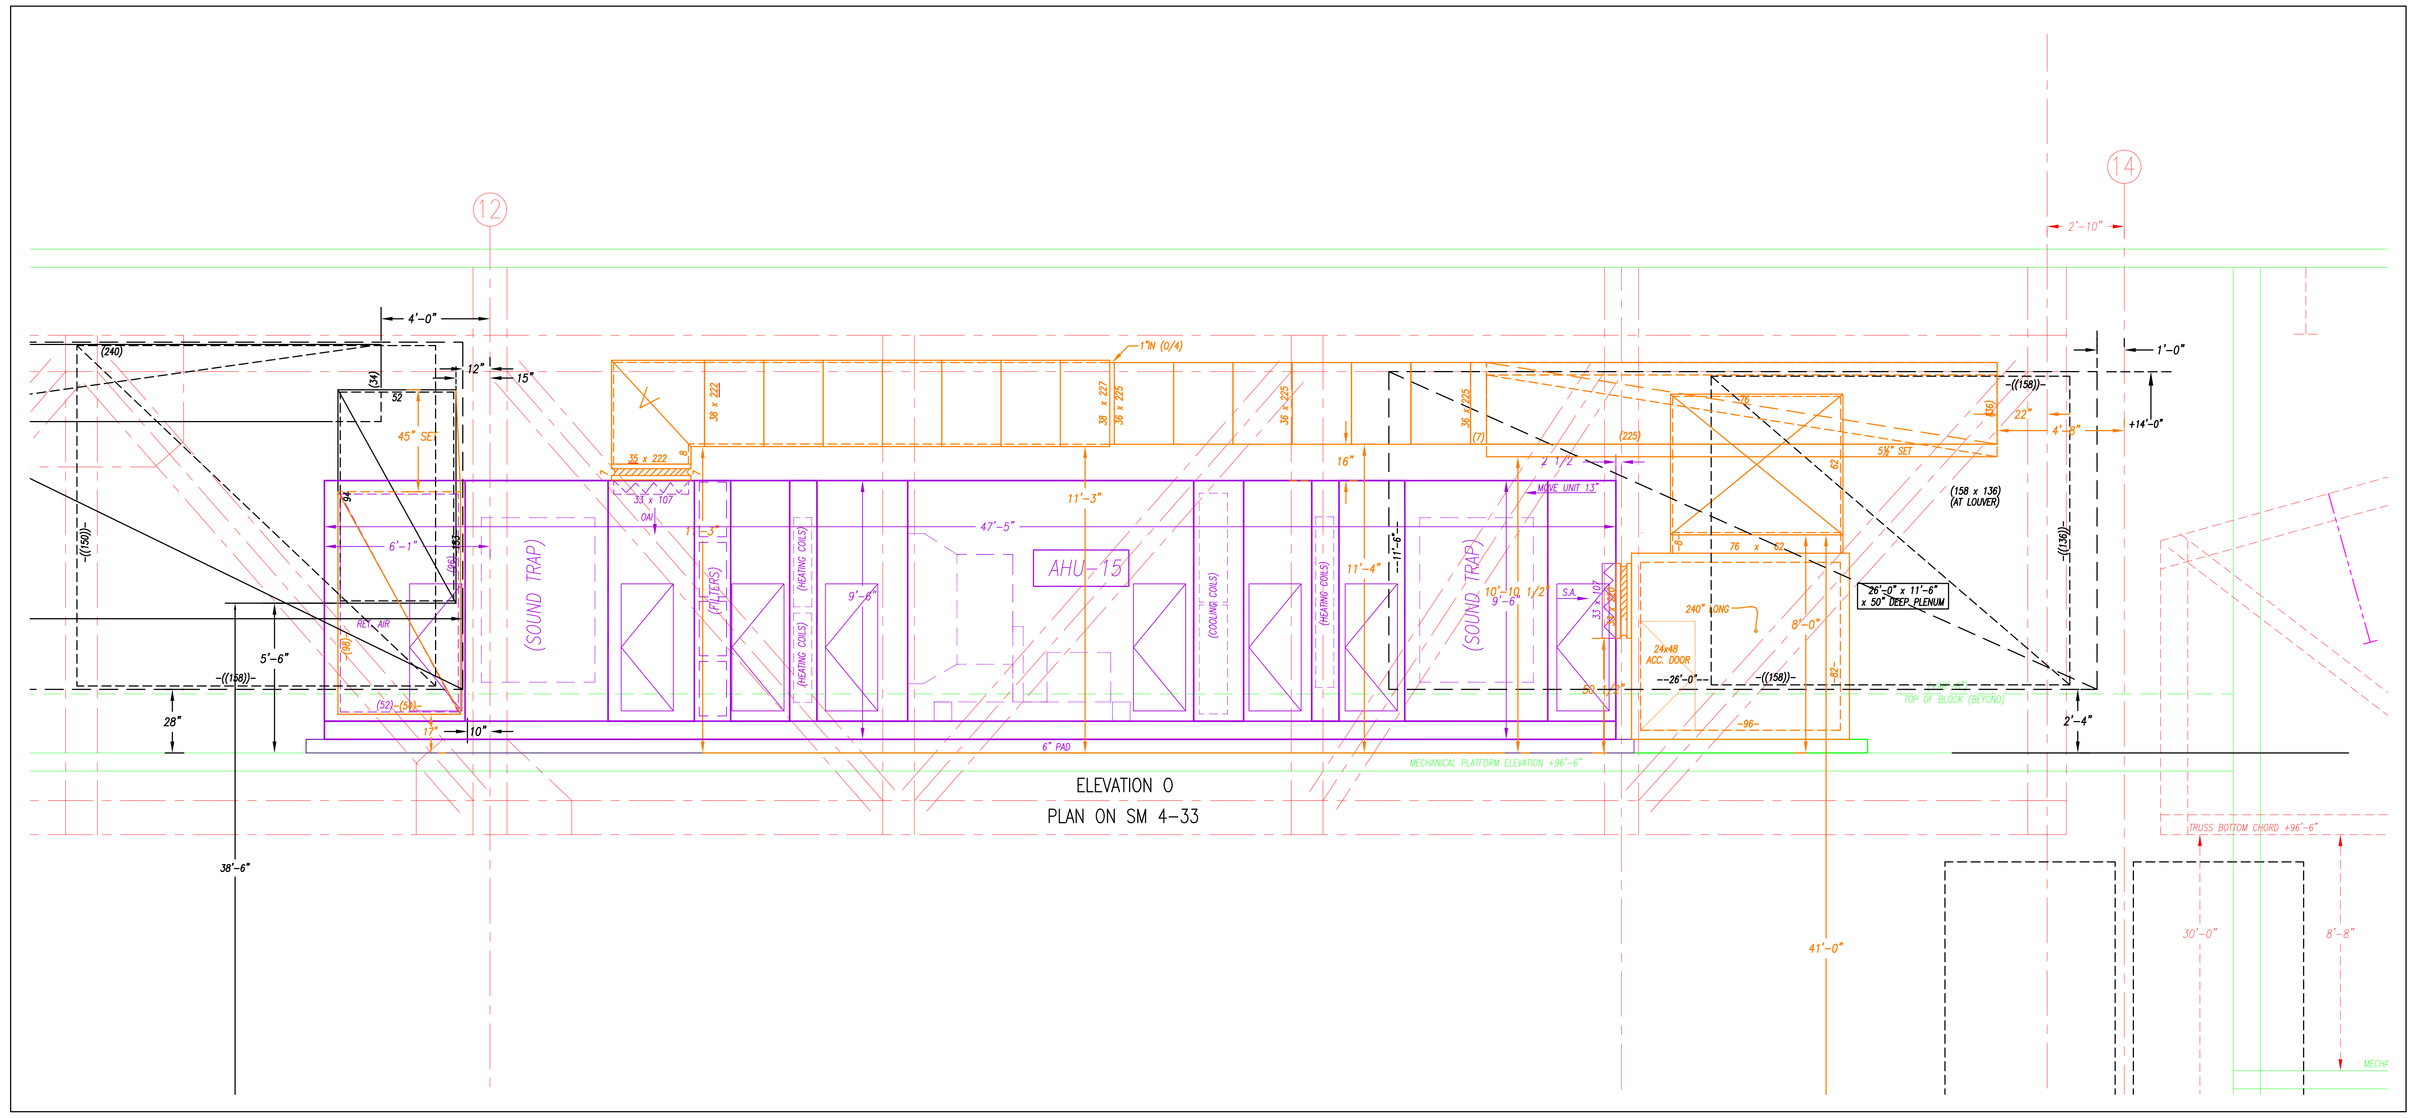

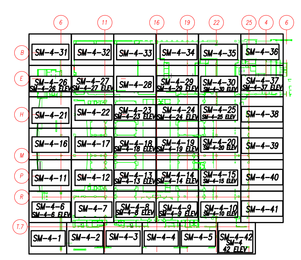

FOURTH FLOOR

RECORD DRAWINGS
The Keating JV

NOTES: FILE COPY (XX-XX-XX)

1. – ALL DUCT TO BE FABRICATED PER SMACNA CONSTRUCTION STANDARDS.
2. – <G> = AIR FLOW – GALV. – NO ACOUST. LINING
3. – <AI> = AIR FLOW – 1" ACOUST. LINING
4. – <S> = AIR FLOW – STAINLESS STEEL
5. – <A> = AIR FLOW – ALUMINUM
6. – |▷ = W.G. CONSTRUCTION OF DUCT
7. – 7'-0" = TOP OF DUCT ABOVE FINISHED FLOOR; 8'-6" = BOTTOM OF DUCT ABOVE FINISHED FLOOR
8. – COORDINATION NOTE – ALLOW 2" ALL AROUND DUCT FOR FLANGE CONNECTIONS AND FOR EXTERNAL INSULATION WHERE REQUIRED.

REV	DESCRIPTION	DR.	DATE
AB	AS BUILT	EG	01-11-11
C	FOR CONSTRUCTION	EG	10-30-09
S	SIGN OFF	BLJ	09-24-09
R1	UNIT REVISION	MSO	09-11-09
A	FOR APPROVAL	BLJ	08-08-09

Advantage CONTRACTING INC.
A Minority Owned Business Enterprise
219 W. Hortter Street • Philadelphia, PA 19119
Phone: 215-844-0191 Fax: 215-844-0192
www.advantagecontracts.com

JOB NAME
PA CONVENTION CENTER
EXPANSION AND RENOVATION

TITLE
LEVEL 4 PARTIAL DUCT PLAN

REF DWGS.- M240	LDC. COILS		
SCALE 3/8"=1'-0"	CH.	JOB NO.	8520
DATE 10-14-09	DR. BLJ	DWG. NO.	SM 4-32ELEV

RECORD DRAWINGS
The Keating JV

THIS AREA FOR CONSTRUCTION ONLY PART-1 08-10-09 DONE

FOURTH FLOOR

NOTES:
1. – ALL DUCT TO BE FABRICATED PER SMACNA CONSTRUCTION STANDARDS.
2. – ⇨ = AIR FLOW – GALV. – NO ACOUST. LINING
3. – 1"AL ⇨ = AIR FLOW – 1" ACOUST. LINING
4. – ⇨ SS = AIR FLOW – STAINLESS STEEL
5. – ⇨ ALUM = AIR FLOW – ALUMINUM
6. – ▷ = W.G. CONSTRUCTION OF DUCT
7. – 2x 0'-0" = TOP OF DUCT ABOVE FINISHED FLOOR
   B= 0'-0" = BOTTOM OF DUCT ABOVE FINISHED FLOOR
8. – COORDINATION NOTE – ALLOW 2" ALL AROUND DUCT FOR FLANGE CONNECTIONS AND FOR EXTERNAL INSULATION WHERE REQUIRED.

REV'D	DESCRIPTION	DR.	DATE
AB	AS BUILT	EG	01-29-10
R2	REVISED FOR GRDS	EG	01-29-10
C2	FOR CONSTRUCTION PART 2	EG	10-30-09
R1	REVISED FOR UNITS AND MODS	EG	09-22-09
R	UNIT REVISIONS	MSO	09-11-09
C	FOR CONSTRUCTION PART 1	BLJ	08-10-09
A	FOR APPROVAL	BLJ	06-08-09

Advantage CONTRACTING INC.
A Minority Owned Business Enterprise
219 W. Hortter Street • Philadelphia, PA 19119
Phone: 215-844-0191 Fax: 215-844-0192
www.advantagecontracts.com

JOB NAME: PA CONVENTION CENTER
EXPANSION AND RENOVATION

TITLE: LEVEL 4 PARTIAL DUCT PLAN

REF DWG: M240 M243 LOC. COLS.
SCALE: 3/8"=1'-0" DR. JOB NO. 8520
DATE: 06-08-09 DR. BLJ DWG. NO. SM 4-33

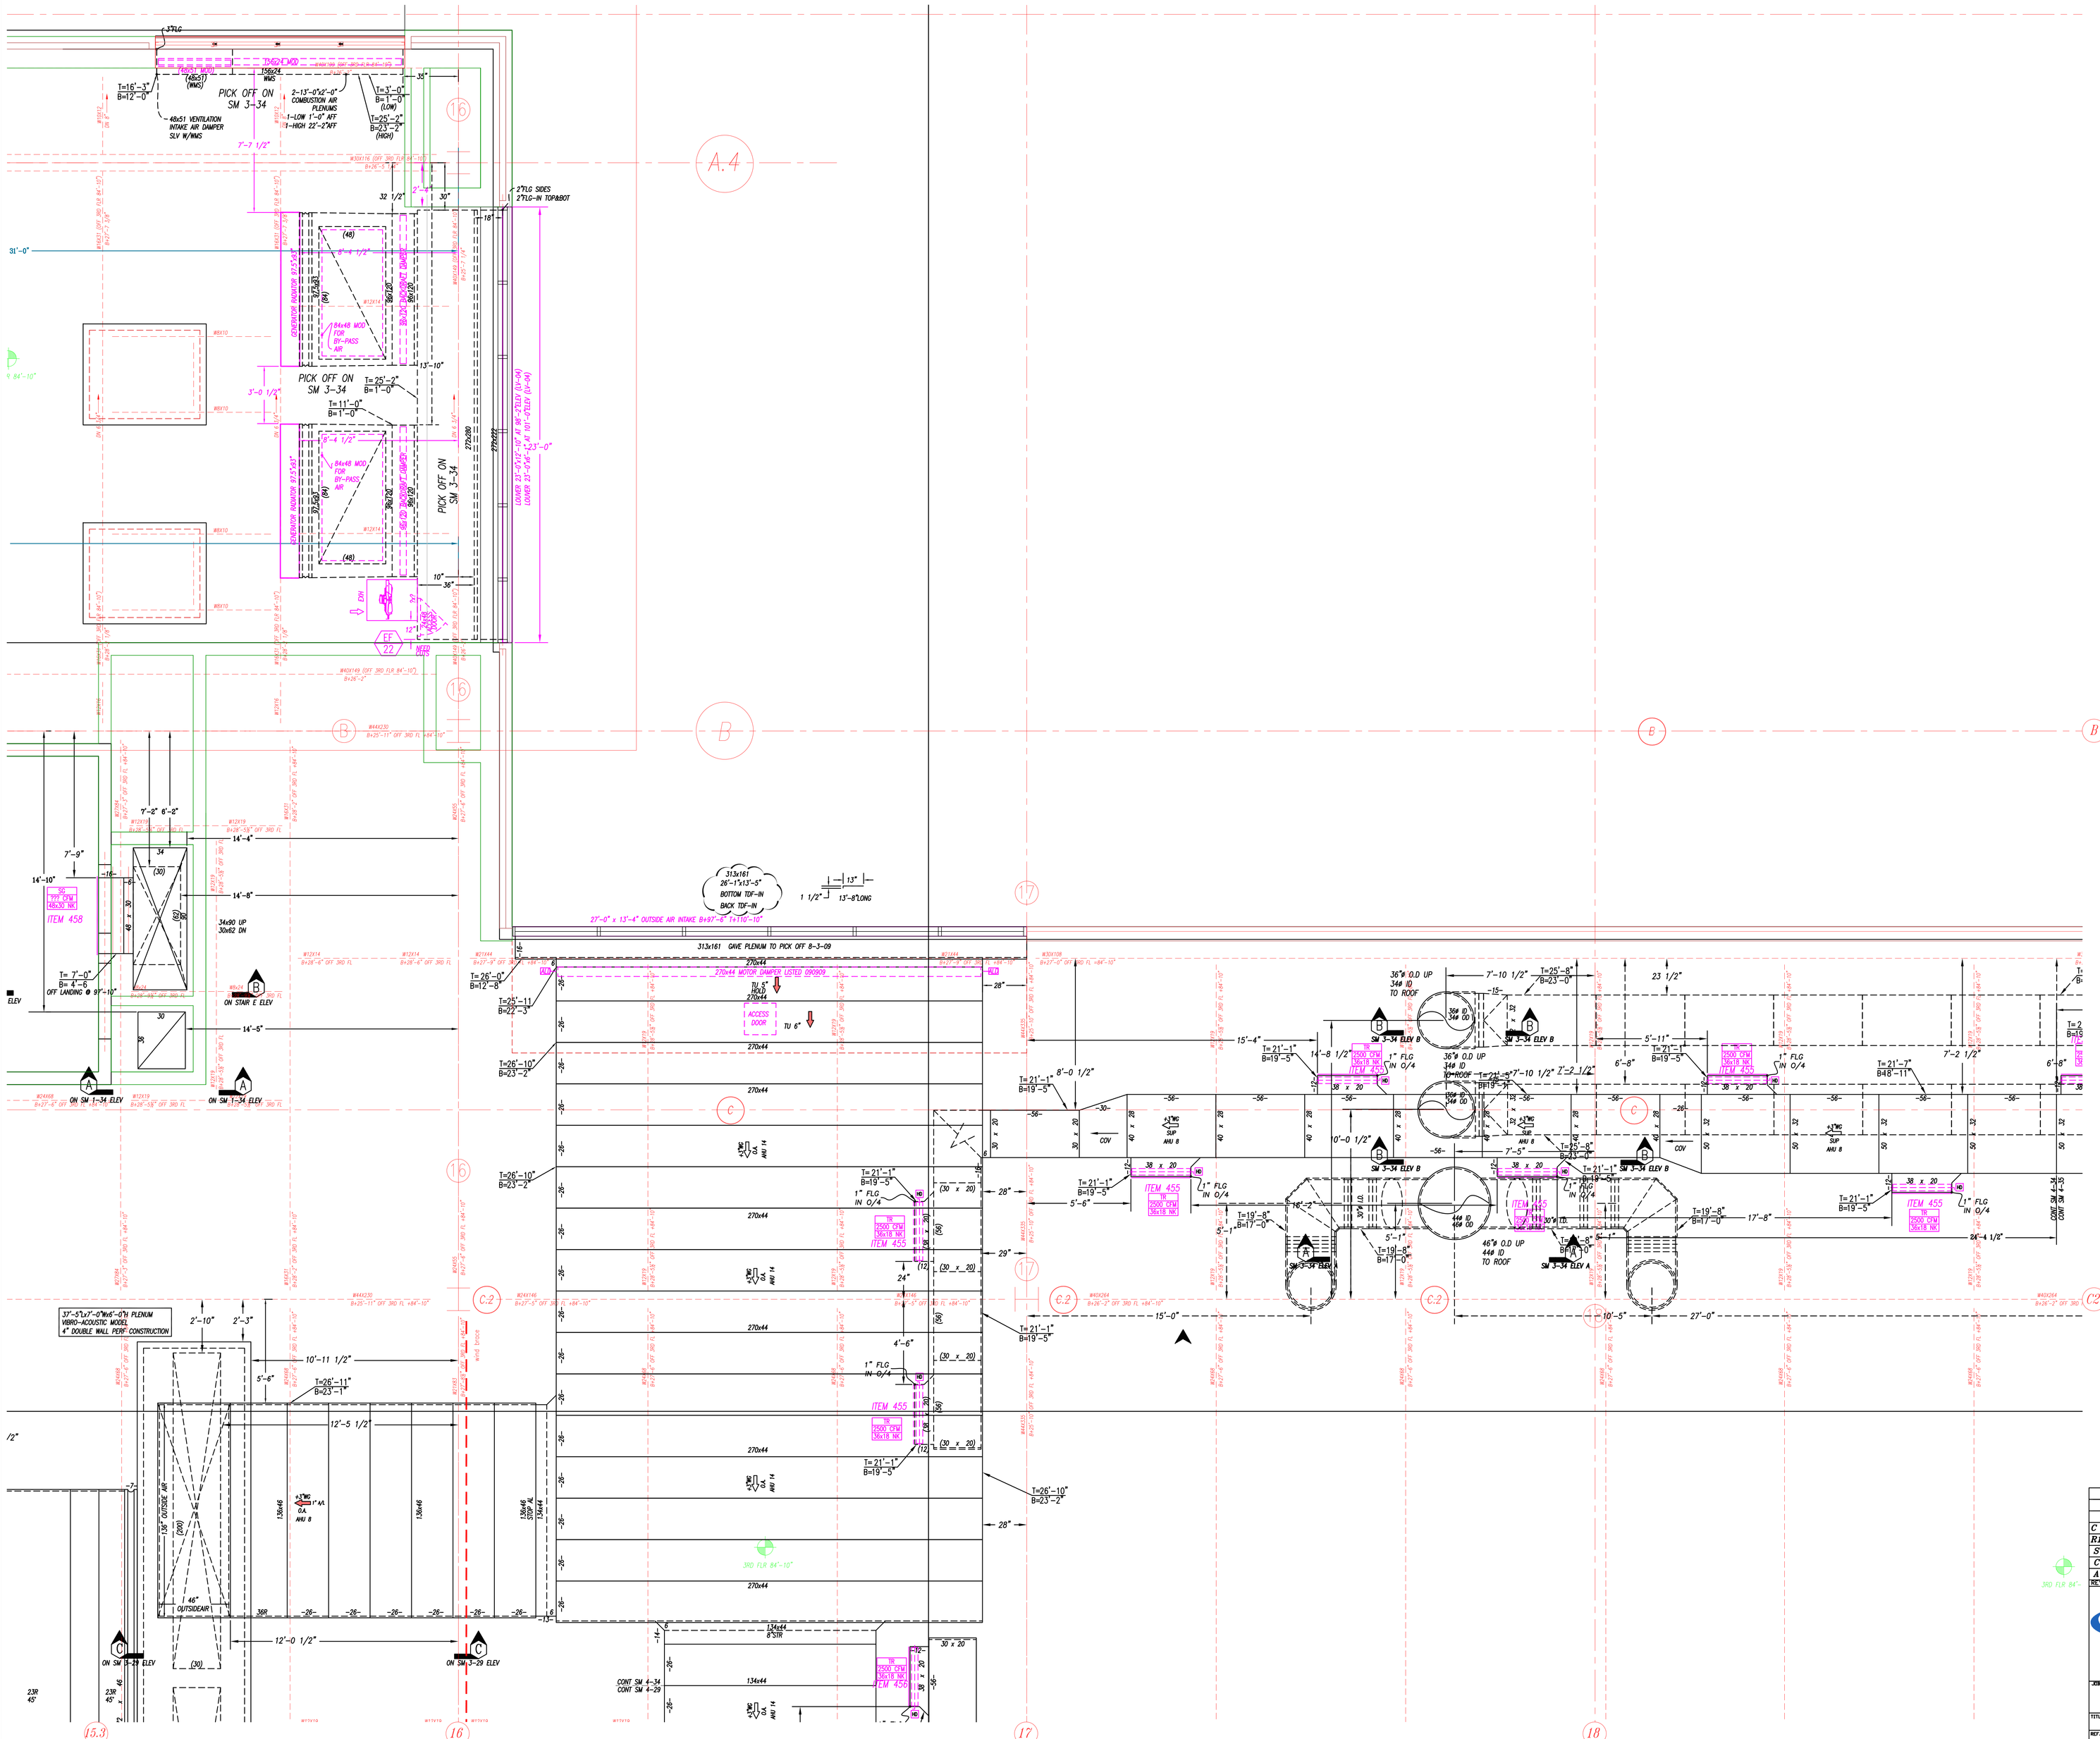

RECORD DRAWINGS
The Keating JV

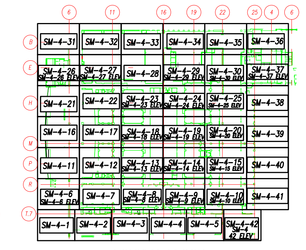

FOURTH FLOOR

NOTES:

1. – = ALL DUCT TO BE FABRICATED PER SMACNA CONSTRUCTION STANDARDS.
2. – <=> = AIR FLOW – GALV. – NO ACOUST. LINING
3. – ⊓⊓ = AIR FLOW – 1" ACOUST. LINING
4. – <=> ▦ = AIR FLOW – STAINLESS STEEL
5. – <=> Alum = AIR FLOW – ALUMINUM
6. – ▷ = W.G. CONSTRUCTION OF DUCT
7. – T= 0'-0" = TOP OF DUCT ABOVE FINISHED FLOOR; B= 0'-0" = BOTTOM OF DUCT ABOVE FINISHED FLOOR
8. – COORDINATION NOTE – ALLOW 2" ALL AROUND DUCT FOR FLANGE CONNECTIONS AND FOR EXTERNAL INSULATION WHERE REQUIRED.

REV	DESCRIPTION	DR.	DATE
C	AS BUILT	EG	01-11-11
R1	REVISED PER GRDS	EG	02-01-10
S	SIGN OFF	BLJ	10-01-09
C	FOR CONSTRUCTION	BLJ	08-30-09
A	FOR APPROVAL	BLJ	08-08-09

Advantage CONTRACTING INC.
A Minority Owned Business Enterprise
219 W. Hortter Street • Philadelphia, PA 19119
Phone: 215-844-0191 Fax: 215-844-0192
www.advantagecontracts.com

JOB NAME: PA CONVENTION CENTER
EXPANSION AND RENOVATION

TITLE: LEVEL 4 PARTIAL DUCT PLAN

REF DWG-	M-243
SCALE	3/8"=1'-0"
DATE	06-08-09
LOC. COLS.	
CH.	
DR.	BLJ
JOB NO.	8520
DWG. NO.	SM 4-34

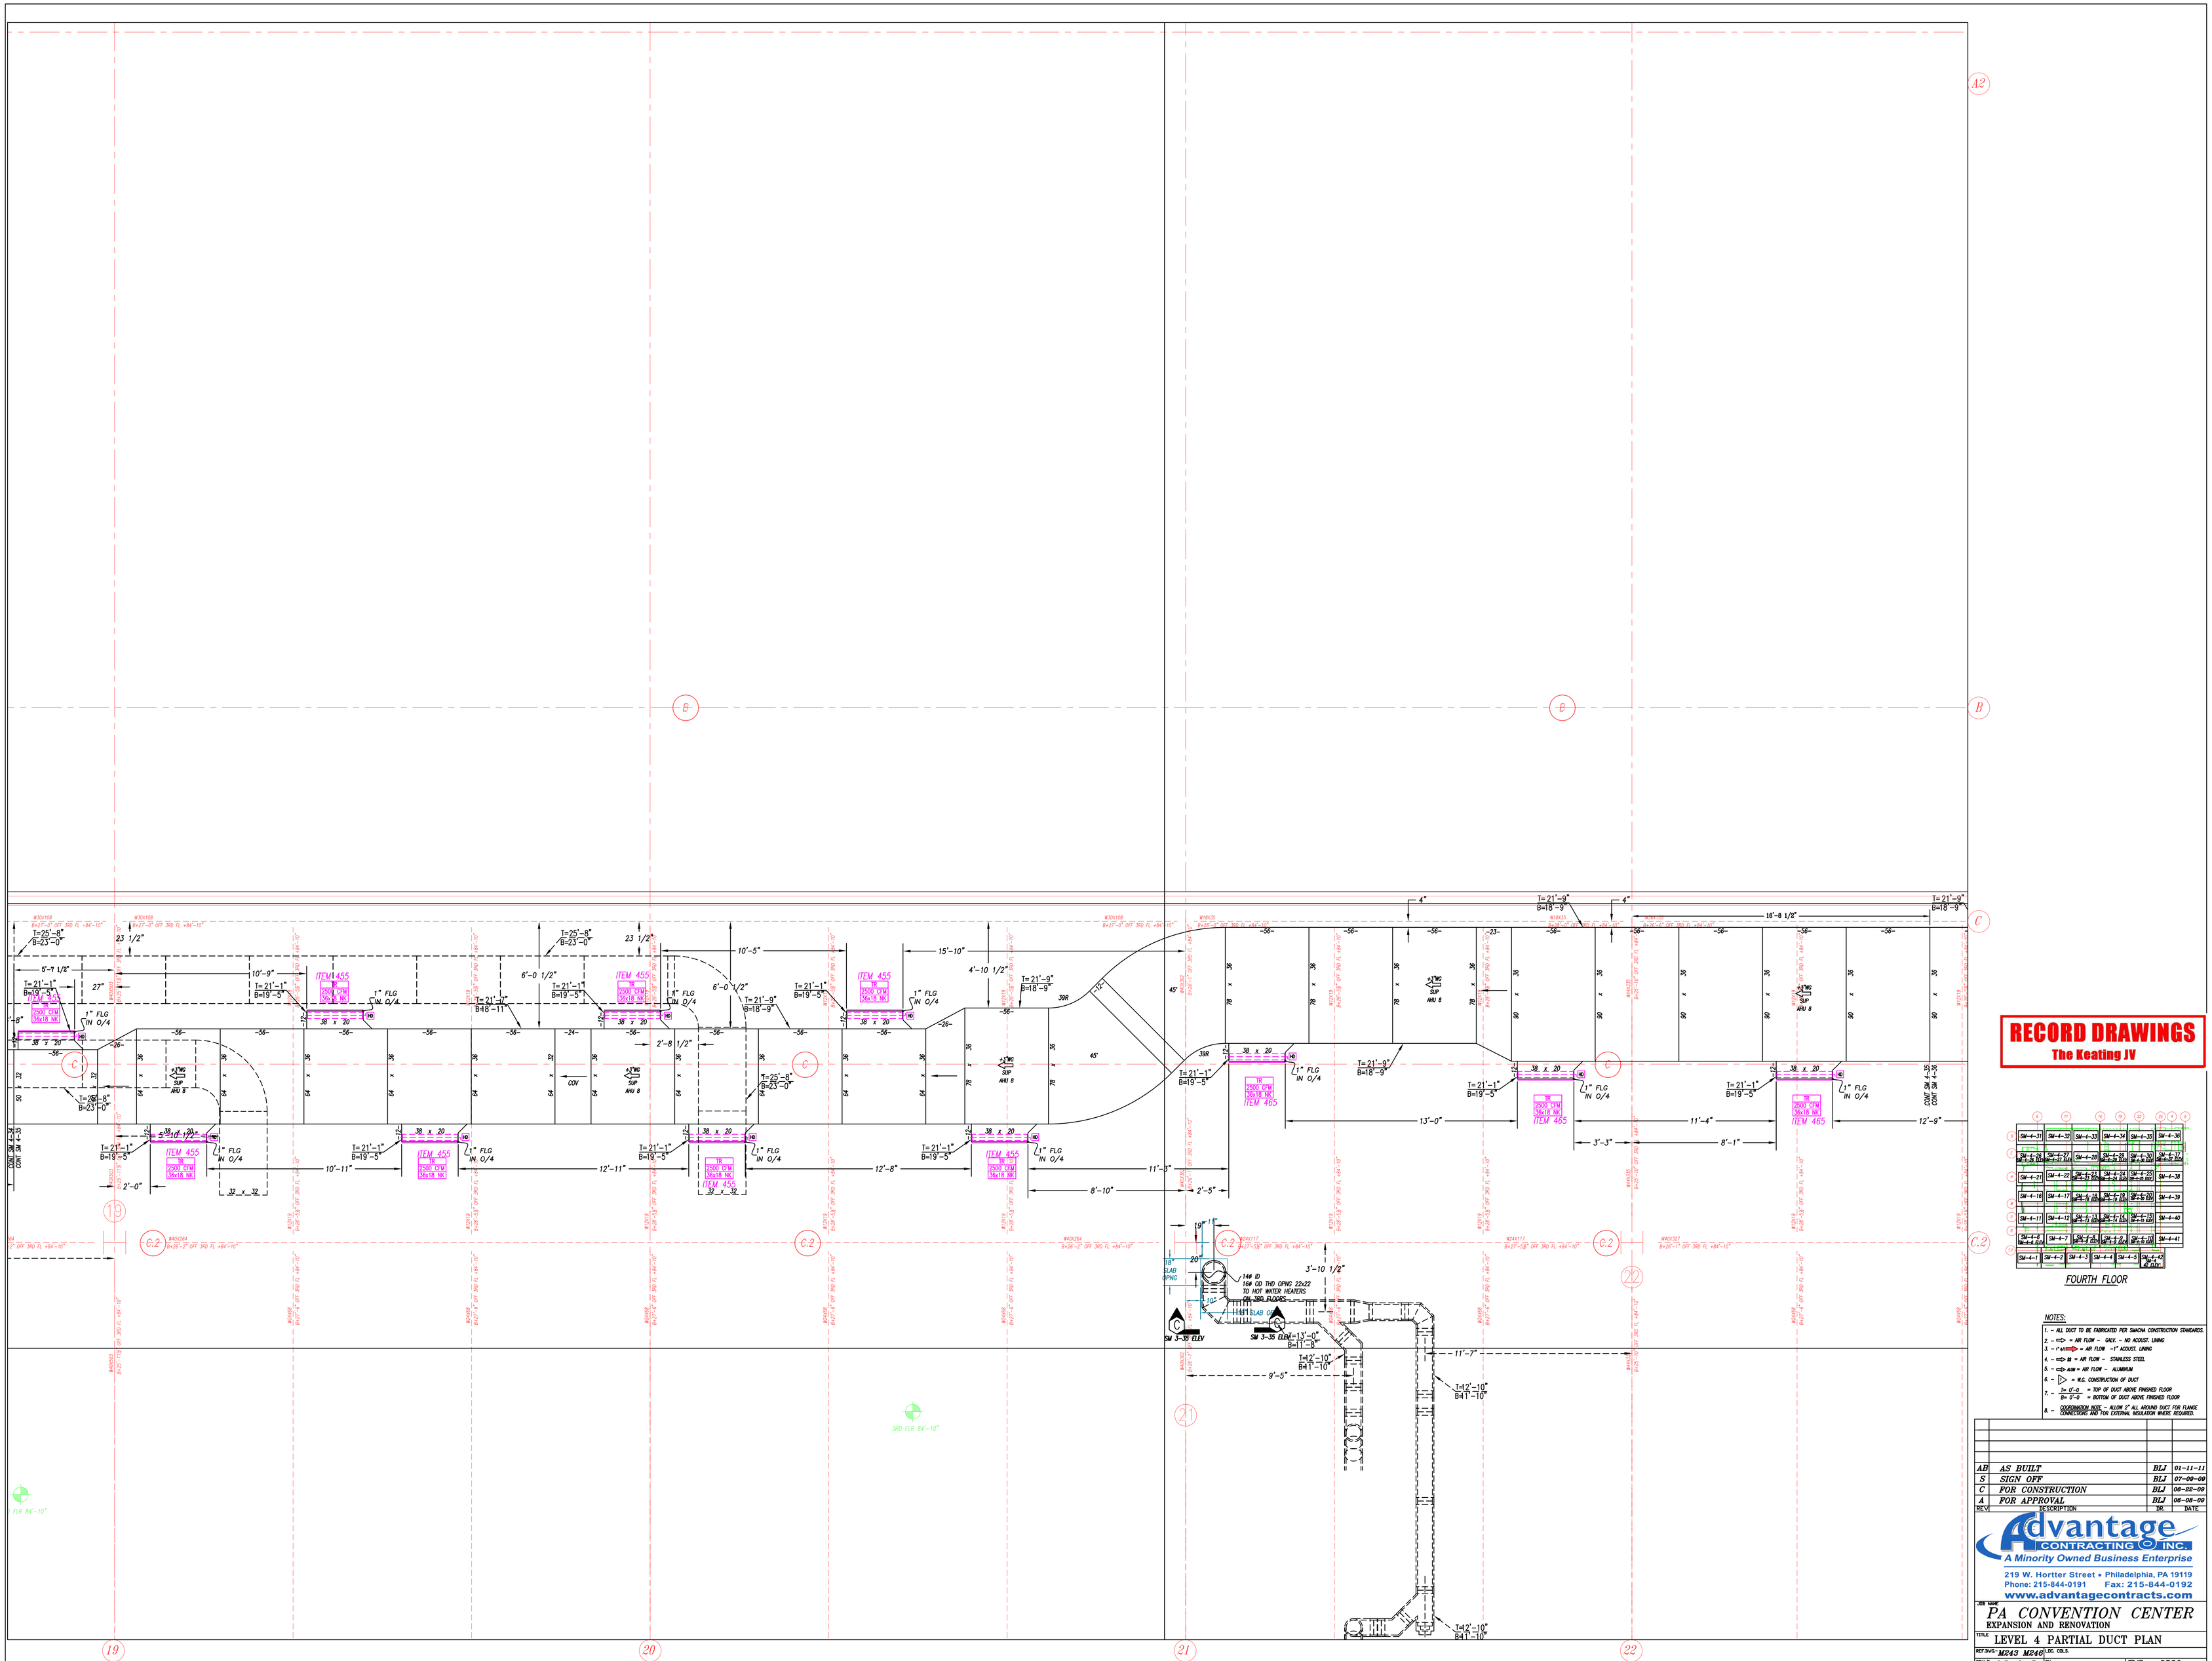

RECORD DRAWINGS
The Keating JV

FOURTH FLOOR

NOTES:

1. - ALL DUCT TO BE FABRICATED PER SMACNA CONSTRUCTION STANDARDS.
2. - <G> = AIR FLOW – GALV. – NO ACOUST. LINING
3. - <AL1"AC> = AIR FLOW – 1" ACOUST. LINING
4. - <S> = AIR FLOW – STAINLESS STEEL
5. - <AL> = AIR FLOW – ALUMINUM
6. - ▷ = W.G. CONSTRUCTION OF DUCT
7. - T= 0'-0" = TOP OF DUCT ABOVE FINISHED FLOOR
   B= 0'-0" = BOTTOM OF DUCT ABOVE FINISHED FLOOR
8. - COORDINATION NOTE – ALLOW 2" ALL AROUND DUCT FOR FLANGE CONNECTIONS AND FOR EXTERNAL INSULATION WHERE REQUIRED.

REV'D	DESCRIPTION	DR.	DATE
AB	AS BUILT	BLJ	01-11-11
S	SIGN OFF	BLJ	07-09-09
C	FOR CONSTRUCTION	BLJ	06-22-09
A	FOR APPROVAL	BLJ	06-08-09

Advantage CONTRACTING INC.
A Minority Owned Business Enterprise
219 W. Hortter Street • Philadelphia, PA 19119
Phone: 215-844-0191 Fax: 215-844-0192
www.advantagecontracts.com

JOB NAME
PA CONVENTION CENTER
EXPANSION AND RENOVATION

TITLE
LEVEL 4 PARTIAL DUCT PLAN

REF. DWGS.- M243 M246	LOC. COLS.		
SCALE 3/8"=1'-0"	CH.	JOB NO.	8520
DATE 06-08-09	DR. BLJ	DWG. NO.	SM 4-35

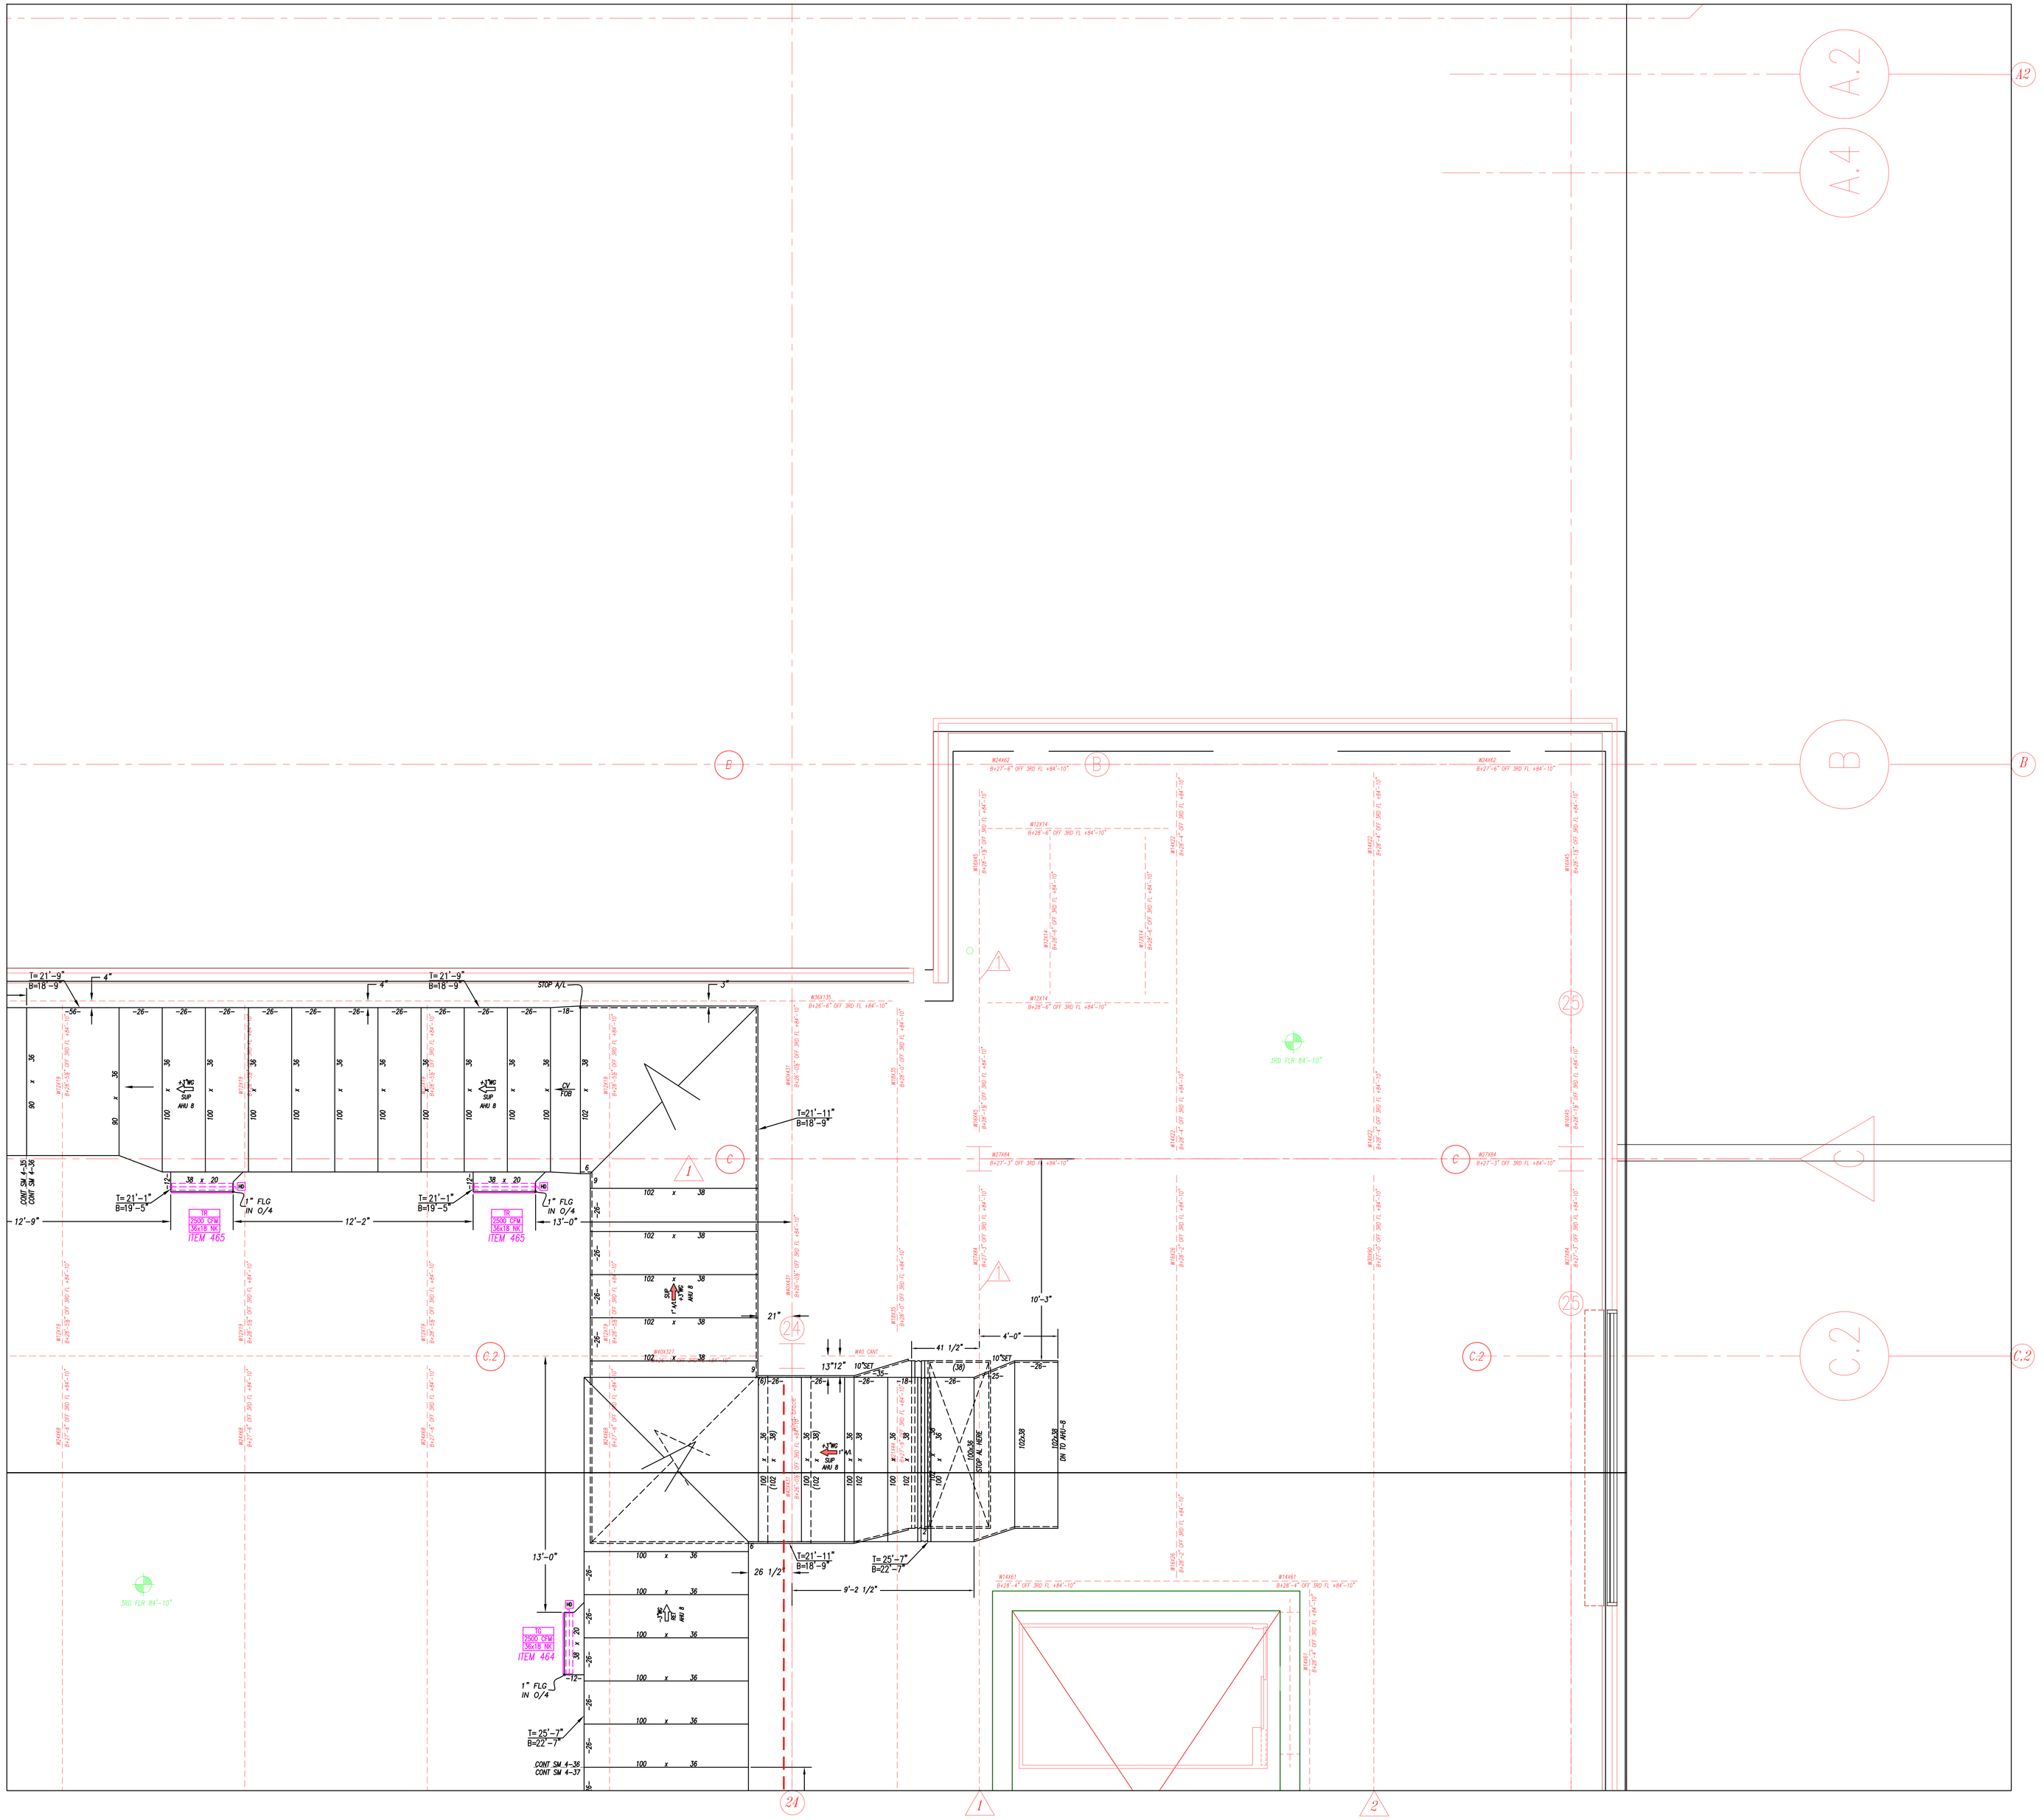
A.2
A.4
A2
B
B
C.2
C
C.2
C.2
1
2
24
25
3RD FLR 84'-10"
FOURTH FLOOR
RECORD DRAWINGS
The Keating JV
NOTES:
1. - ALL DUCT TO BE FABRICATED PER SMACNA CONSTRUCTION STANDARDS.
2. - <G> = AIR FLOW - GALV. - NO ACOUST. LINING
3. - 1" ACOUST = AIR FLOW - 1" ACOUST. LINING
4. - <SS> SS = AIR FLOW - STAINLESS STEEL
5. - <AL> ALM = AIR FLOW - ALUMINUM
6. - = W.G. CONSTRUCTION OF DUCT
7. - T= 0'-0" = TOP OF DUCT ABOVE FINISHED FLOOR
B= 0'-0" = BOTTOM OF DUCT ABOVE FINISHED FLOOR
8. - COORDINATION NOTE - ALLOW 2" ALL AROUND DUCT FOR FLANGE CONNECTIONS AND FOR EXTERNAL INSULATION WHERE REQUIRED.
AB AS BUILT EG 09-22-09
R1 REVISED FOR UNITS AND MODS EG 09-22-09
S SIGN OFF BLJ 07-09-09
C FOR CONSTRUCTION BLJ 06-22-09
A FOR APPROVAL BLJ 06-08-09
REV. DESCRIPTION DR. DATE
Advantage CONTRACTING INC.
A Minority Owned Business Enterprise
219 W. Hortter Street • Philadelphia, PA 19119
Phone: 215-844-0191 Fax: 215-844-0192
www.advantagecontracts.com
JOB NAME
PA CONVENTION CENTER
EXPANSION AND RENOVATION
TITLE
LEVEL 4 PARTIAL DUCT PLAN
REF. DWG. M246
LOC. COLS.
SCALE 3/8"=1'-0"
CH.
JOB NO. 8520
DATE 06-08-09
DR. BLJ
DWG. NO. SM 4-36

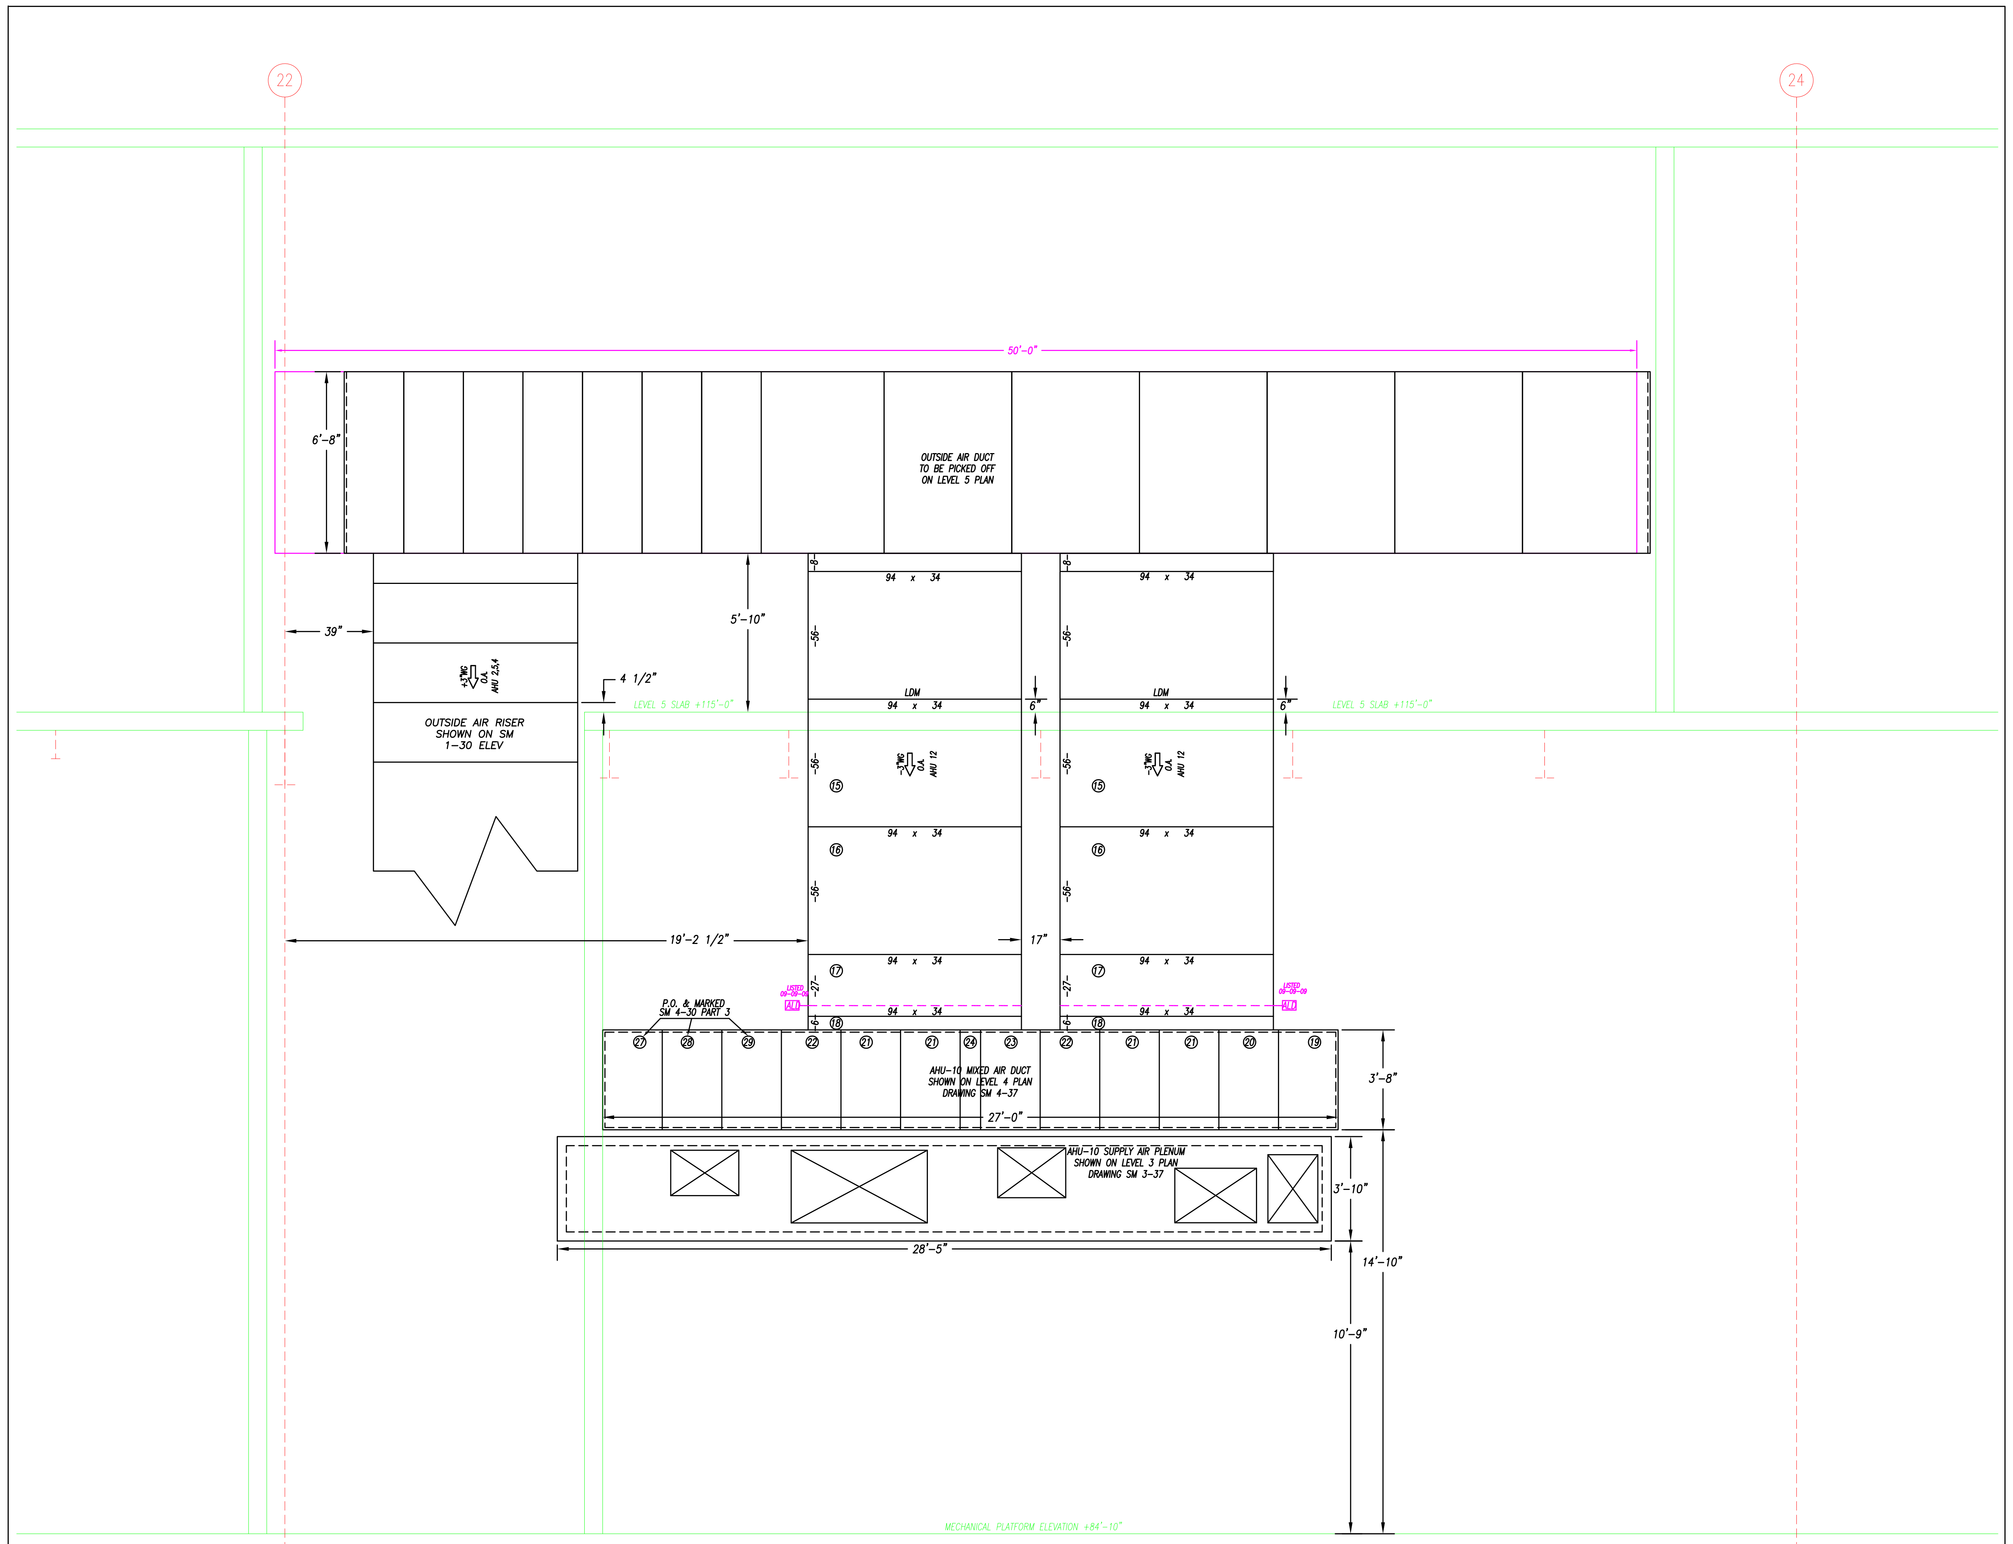

SECTION "A-A"

RECORD DRAWINGS
The Keating JV

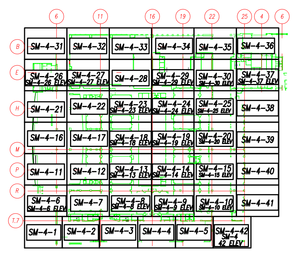

FOURTH FLOOR

NOTES:

1. - ALL DUCT TO BE FABRICATED PER SMACNA CONSTRUCTION STANDARDS.
2. - <C> = AIR FLOW - GALV. - NO ACOUST. LINING
3. - <1"ACOUST> = AIR FLOW - 1" ACOUST. LINING
4. - <S> SS = AIR FLOW - STAINLESS STEEL
5. - <S> ALUM = AIR FLOW - ALUMINUM
6. - ▷ = W.G. CONSTRUCTION OF DUCT
7. - 7'± 0"-0 = TOP OF DUCT ABOVE FINISHED FLOOR
   8'± 0"-0 = BOTTOM OF DUCT ABOVE FINISHED FLOOR
8. - COORDINATION NOTE - ALLOW 2" ALL AROUND DUCT FOR FLANGE CONNECTIONS AND FOR EXTERNAL INSULATION WHERE REQUIRED.

REV.'S	DESCRIPTION	DR.	DATE
AB	AS BUILT	BLJ	01-11-11
C	FOR CONSTRUCTION	BLJ	08-22-09
A	FOR APPROVAL	BLJ	08-08-09

Advantage CONTRACTING INC.
A Minority Owned Business Enterprise
219 W. Hortter Street • Philadelphia, PA 19119
Phone: 215-844-0191 Fax: 215-844-0192
www.advantagecontracts.com

JOB NAME: PA CONVENTION CENTER
EXPANSION AND RENOVATION

TITLE: LEVEL 4 DUCT ELEVATIONS

REF.DWG.- SM 4-37	LOC. COLS.		
SCALE 3/8"=1'-0"	CH.	JOB NO.	8520
DATE 08-08-09	DR. BLJ	DWG. NO.	SM 4-37 ELEV

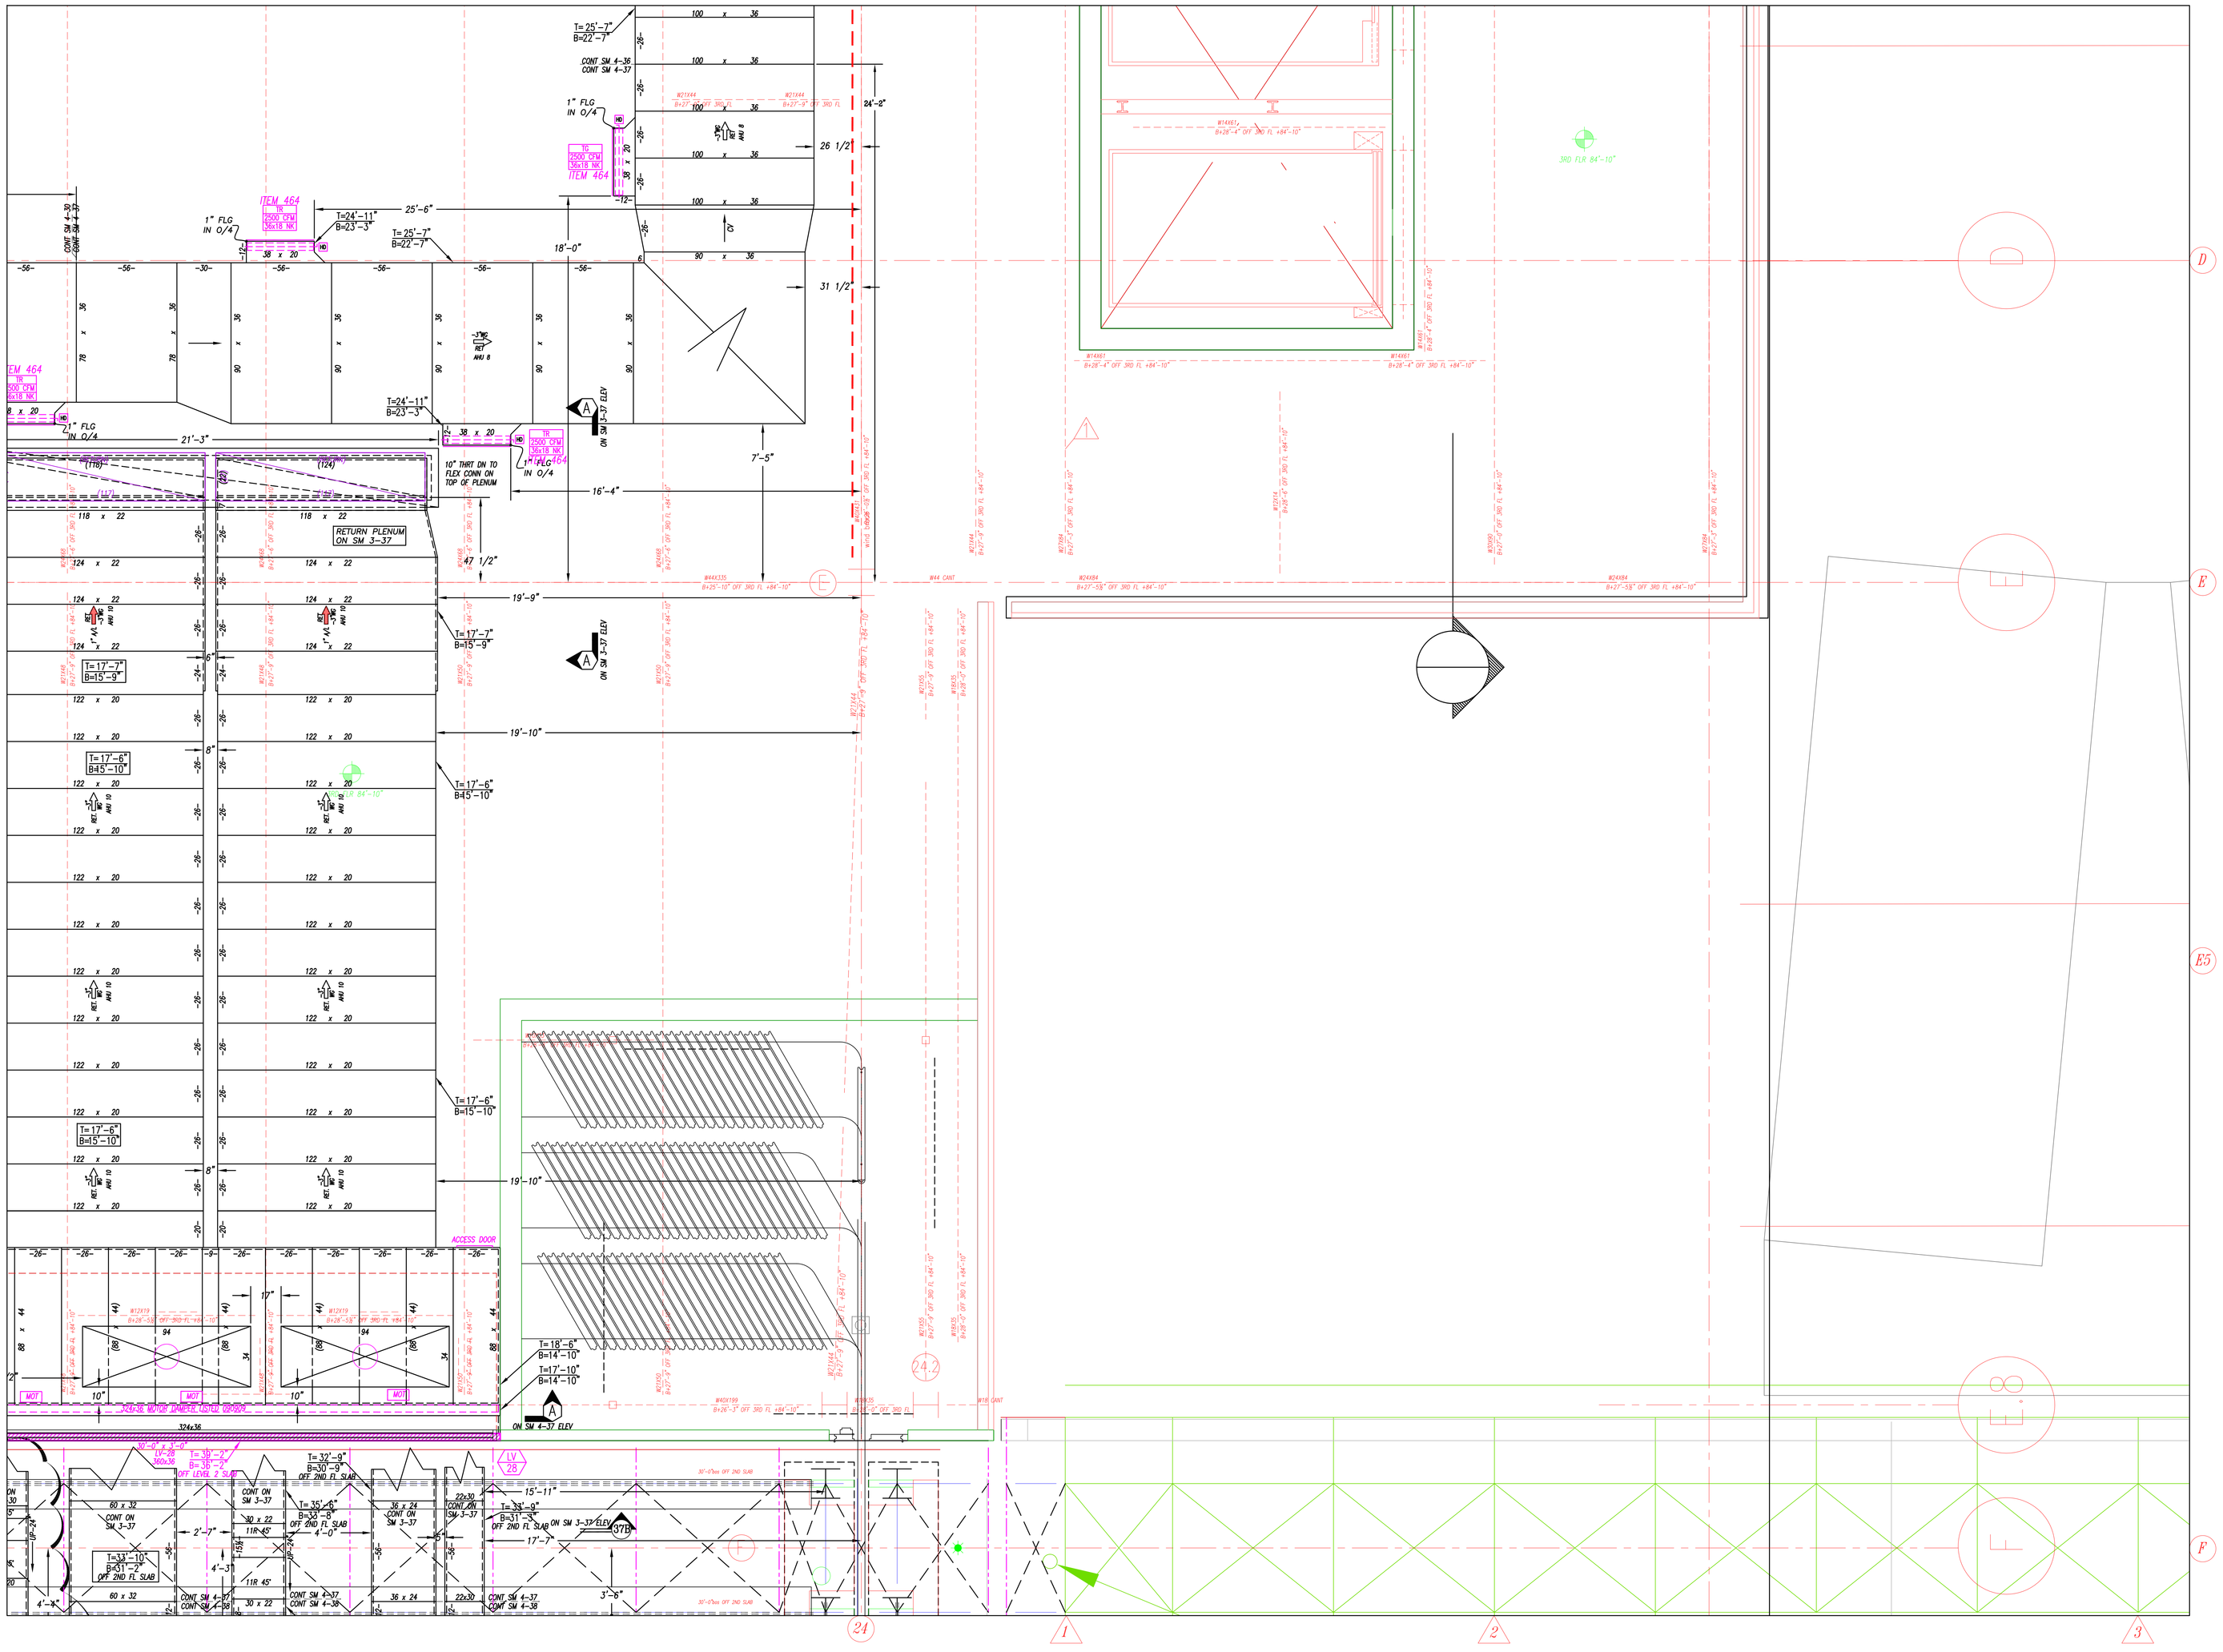

RECORD DRAWINGS
The Keating JV

NOTES:
1. ALL DUCT TO BE FABRICATED PER SMACNA CONSTRUCTION STANDARDS.
2. ⇨ = AIR FLOW – GALV. – NO ACOUST. LINING
3. ⇨ = AIR FLOW – 1" ACOUST. LINING
4. ⇨ = AIR FLOW – STAINLESS STEEL
5. ⇨ = AIR FLOW – ALUMINUM
6. ▷ = W.G. CONSTRUCTION OF DUCT
7. T= 0'-0" = TOP OF DUCT ABOVE FINISHED FLOOR; B= 0'-0" = BOTTOM OF DUCT ABOVE FINISHED FLOOR
8. COORDINATION NOTE – ALLOW 2" ALL AROUND DUCT FOR FLANGE CONNECTIONS AND FOR EXTERNAL INSULATION WHERE REQUIRED.

REV	DESCRIPTION	DR.	DATE
AB	AS BUILT	EG	09-22-09
R2	REVISED UNITS AND MODS	EG	09-22-09
R1	DETAILED PLENUM	EG	08-07-09
S	SIGN OFF	BLJ	07-09-09
C	FOR CONSTRUCTION	BLJ	06-22-09
A	FOR APPROVAL	BLJ	06-08-09

Advantage CONTRACTING INC.
A Minority Owned Business Enterprise
219 W. Hortter Street • Philadelphia, PA 19119
Phone: 215-844-0191 Fax: 215-844-0192
www.advantagecontracts.com

JOB NAME: PA CONVENTION CENTER
EXPANSION AND RENOVATION

TITLE: LEVEL 4 PARTIAL DUCT PLAN

REF DWG: M246	LDC COLS.		
SCALE: 3/8"=1'-0"	CH.	JOB NO.	8520
DATE: 06-08-09	DR. BLJ	DWG. NO.	SM 4-37

DECK TYPE "D1"

(EX) 2-TRUSS T-3

APPROXIMATE LOCATION OF ROOF DRAINS.

(EX) TRUSS T-2

(EX) 7 64DL

64DLH116

64DLH115

64DLH114

RECORD DRAWINGS
The Keating JV

FOURTH FLOOR

NOTES:

1. – ALL DUCT TO BE FABRICATED PER SMACNA CONSTRUCTION STANDARDS.
2. – <=> = AIR FLOW – GALV. – NO ACOUST. LINING
3. – r'x# = AIR FLOW –1" ACOUST. LINING
4. – <=> SS = AIR FLOW – STAINLESS STEEL
5. – <=> ALUM = AIR FLOW – ALUMINUM
6. – ▷ = W.G. CONSTRUCTION OF DUCT
7. – T= 0'-0" = TOP OF DUCT ABOVE FINISHED FLOOR
   B= 0'-0" = BOTTOM OF DUCT ABOVE FINISHED FLOOR
8. – COORDINATION NOTE – ALLOW 3" ALL AROUND DUCT FOR FLANGE CONNECTIONS AND FOR EXTERNAL INSULATION WHERE REQUIRED.

REV	DESCRIPTION	DR.	DATE
AB	AS BUILT	BLJ	09-16-09
R1	REVISED LENGTHS	BLJ	09-16-09
C	FOR CONSTRUCTION	BLJ	09-15-09
A	FOR APPROVAL	BLJ	05-19-09

Advantage CONTRACTING INC.
A Minority Owned Business Enterprise
219 W. Hortter Street • Philadelphia, PA 19119
Phone: 215-844-0191 Fax: 215-844-0192
www.advantagecontracts.com

JOB NAME: PA CONVENTION CENTER
EXPANSION AND RENOVATION

TITLE: LEVEL 4 PARTIAL DUCT PLAN

REF.DWG: M-246,247	LOC. COLS.		
SCALE: 3/8"=1'-0"	CH.	JOB NO.	8520
DATE: 05-19-09	DR. BLJ	DWG. NO.	SM 4-38

(EX) 64DLH16

(EX) 64DLH15

(EX) 64DLH14

(EX) (7) 64DL

(EX) 2-TRUSS T-3

18'-0"

52"ø

EXPOSED

SADDLE COL **=5"
DIFF FINISH AT +29'-9"

T= 35'-2"
R=80'-10"
OFF 2ND FL SLAB

ITEM 463
(2) 8
1350 CFM
40'X/30'X

25"

RCLU

48"ø

T= 35'-0"
R= 31'-0"
OFF 2ND FL SLAB

PER RFI 00385

30'-0"ø⌀ OFF 2ND SLAB

16'-3"

6'-4 1/2"

SADDLE COL **=7"
DIFF FINISH AT +29'-9"

ITEM 466
(2) 8
1350 CFM
80'X/30'X

43 1/2"

44 1/2"

DECK TYPE "D1"

24

1

2

3

RECORD DRAWINGS
The Keating JV

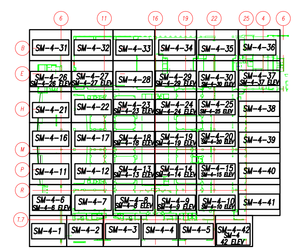

FOURTH FLOOR

NOTES:

1. - ALL DUCT TO BE FABRICATED PER SMACNA CONSTRUCTION STANDARDS.
2. - =▭= = AIR FLOW - GALV. - NO ACOUST. LINING
3. - =▭= = AIR FLOW - 1" ACOUST. LINING
4. - =▭= SS = AIR FLOW - STAINLESS STEEL
5. - =▭= ALUM = AIR FLOW - ALUMINUM
6. - ▷ = W.G. CONSTRUCTION OF DUCT
7. - 1'-0" = TOP OF DUCT ABOVE FINISHED FLOOR; 2'-0" = BOTTOM OF DUCT ABOVE FINISHED FLOOR
8. - COORDINATION NOTE - ALLOW 2" ALL AROUND DUCT FOR FLANGE CONNECTIONS AND FOR EXTERNAL INSULATION WHERE REQUIRED.

REV'D	DESCRIPTION	BY	DATE
AB	AS BUILT	BLJ	01-11-11
R1	REVISED LENGTHS	BLJ	09-18-09
C	FOR CONSTRUCTION	BLJ	09-15-09
A	FOR APPROVAL	BLJ	05-19-09

Advantage CONTRACTING INC
A Minority Owned Business Enterprise
219 W. Hortter Street • Philadelphia, PA 19119
Phone: 215-844-0191 Fax: 215-844-0192
www.advantagecontracts.com

JOB NAME: PA CONVENTION CENTER
EXPANSION AND RENOVATION

TITLE: LEVEL 4 PARTIAL DUCT PLAN

REF.DWG.- M247	LOC. COLS.		
SCALE 3/8"=1'-0"	CH.	JOB NO.	8520
DATE 05-19-09	BR.	DWG NO.	SM 4-39

SLAB TYPE "S7"

RECORD DRAWINGS
The Keating JV

FOURTH FLOOR

NOTES:

1. - ALL DUCT TO BE FABRICATED PER SMACNA CONSTRUCTION STANDARDS.
2. - <=> = AIR FLOW = GALV. - NO ACOUST. LINING
3. - <=> = AIR FLOW = 1" ACOUST. LINING
4. - <=> IB = AIR FLOW = STAINLESS STEEL
5. - <=> ALUM = AIR FLOW = ALUMINUM
6. - [▷] = W.G. CONSTRUCTION OF DUCT
7. - Tx 0'-0 = TOP OF DUCT ABOVE FINISHED FLOOR; Bx 0'-0 = BOTTOM OF DUCT ABOVE FINISHED FLOOR
8. - COORDINATION NOTE - ALLOW 2" ALL AROUND DUCT FOR FLANGE CONNECTIONS AND FOR EXTERNAL INSULATION WHERE REQUIRED.

REV.	DESCRIPTION	DR.	DATE
AB	AS BUILT	EG	01-11-11
R1	REVISED FOR GRDS	EG	01-29-10
C	FOR CONSTRUCTION	EG	11-04-09
S	SIGN-OFF	BLJ	07-16-09
A	FOR APPROVAL	BLJ	05-19-09

Advantage CONTRACTING INC.
A Minority Owned Business Enterprise
219 W. Hortter Street • Philadelphia, PA 19119
Phone: 215-844-0191 Fax: 215-844-0192
www.advantagecontracts.com

JOB NAME: PA CONVENTION CENTER
EXPANSION AND RENOVATION

TITLE: LEVEL 4 PARTIAL DUCT PLAN

REF. DWG.- M-245	LOC. COLS. AS NOTED		
SCALE 3/8"=1'-0"	CH.	JOB NO. 8520	
DATE XX-XX-XX	DR. BLJ	DWG. NO. SM 4-4	

DECK TYPE "D1"

T= 35'-0"
B=31'-0
OFF 2ND FL SLAB

B=31'-0"
OFF 2ND FL SLAB

43 1/2"

44 1/2"

3750 CFM
RECK/30"ø

48"ø

8 RCLU

44"ø

42"ø

PER
RFI
00385

42'-6"
2ND FLR

EXPOSED

~10'-0"~

T=34'-10"
B=31'-2"
OFF 2ND FL SLAB

16'-3"

18'-0"

68DLH18

CD-8
3750 CFM
RECK/30"ø
ITEM 468

22"

SADDLE COL **=9"
DIFF FINISH AT +29'-9"

T=34'-10"
B=31'-3"
OFF 2ND FL SLAB

T= 34'-9"
B=31'-3"
OFF 2ND FL SLAB

30'-0"on OFF 2ND SLAB

(EX) TRUSS T-2

(EX) 64DLH16

(EX) 64DLH15

(EX) 64DLH14

(EX) 1-1/2" TYPE BA GALV. METAL ROOF DECK

(EX) (7) 64DL

M

P

24

1

2

3

RECORD DRAWINGS
The Keating JV

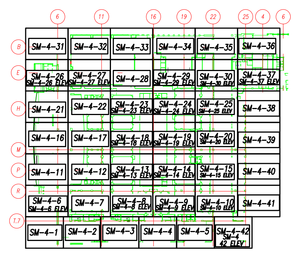

FOURTH FLOOR

NOTES:

1. – ALL DUCT TO BE FABRICATED PER SMACNA CONSTRUCTION STANDARDS.
2. – <=> = AIR FLOW – GALV. – NO ACOUST. LINING
3. – r'x'<=> = AIR FLOW –1" ACOUST. LINING
4. – <=> SS = AIR FLOW – STAINLESS STEEL
5. – <=> ALUM = AIR FLOW – ALUMINUM
6. – ▷ = W.G. CONSTRUCTION OF DUCT
7. – T= 0'-0" = TOP OF DUCT ABOVE FINISHED FLOOR
   B= 0'-0" = BOTTOM OF DUCT ABOVE FINISHED FLOOR
8. – COORDINATION NOTE – ALLOW 3" ALL AROUND DUCT FOR FLANGE CONNECTIONS AND FOR EXTERNAL INSULATION WHERE REQUIRED.

REV	DESCRIPTION	DR.	DATE
AB	AS BUILT	EG	09-18-09
R1	REVISED LENGTHS	EG	09-16-09
C	FOR CONSTRUCTION	EG	09-15-09
A	FOR APPROVAL	EG	05-19-09

Advantage CONTRACTING INC.
A Minority Owned Business Enterprise
219 W. Hortter Street • Philadelphia, PA 19119
Phone: 215-844-0191 Fax: 215-844-0192
www.advantagecontracts.com

JOB NAME
PA CONVENTION CENTER
EXPANSION AND RENOVATION

TITLE
LEVEL 4 PARTIAL DUCT PLAN

REF.DWG.- M247	LOC. COLS.		
SCALE 3/8"=1'-0"	CH.	JOB NO.	8520
DATE 05-19-09	DR.	DWG. NO.	SM 4-40

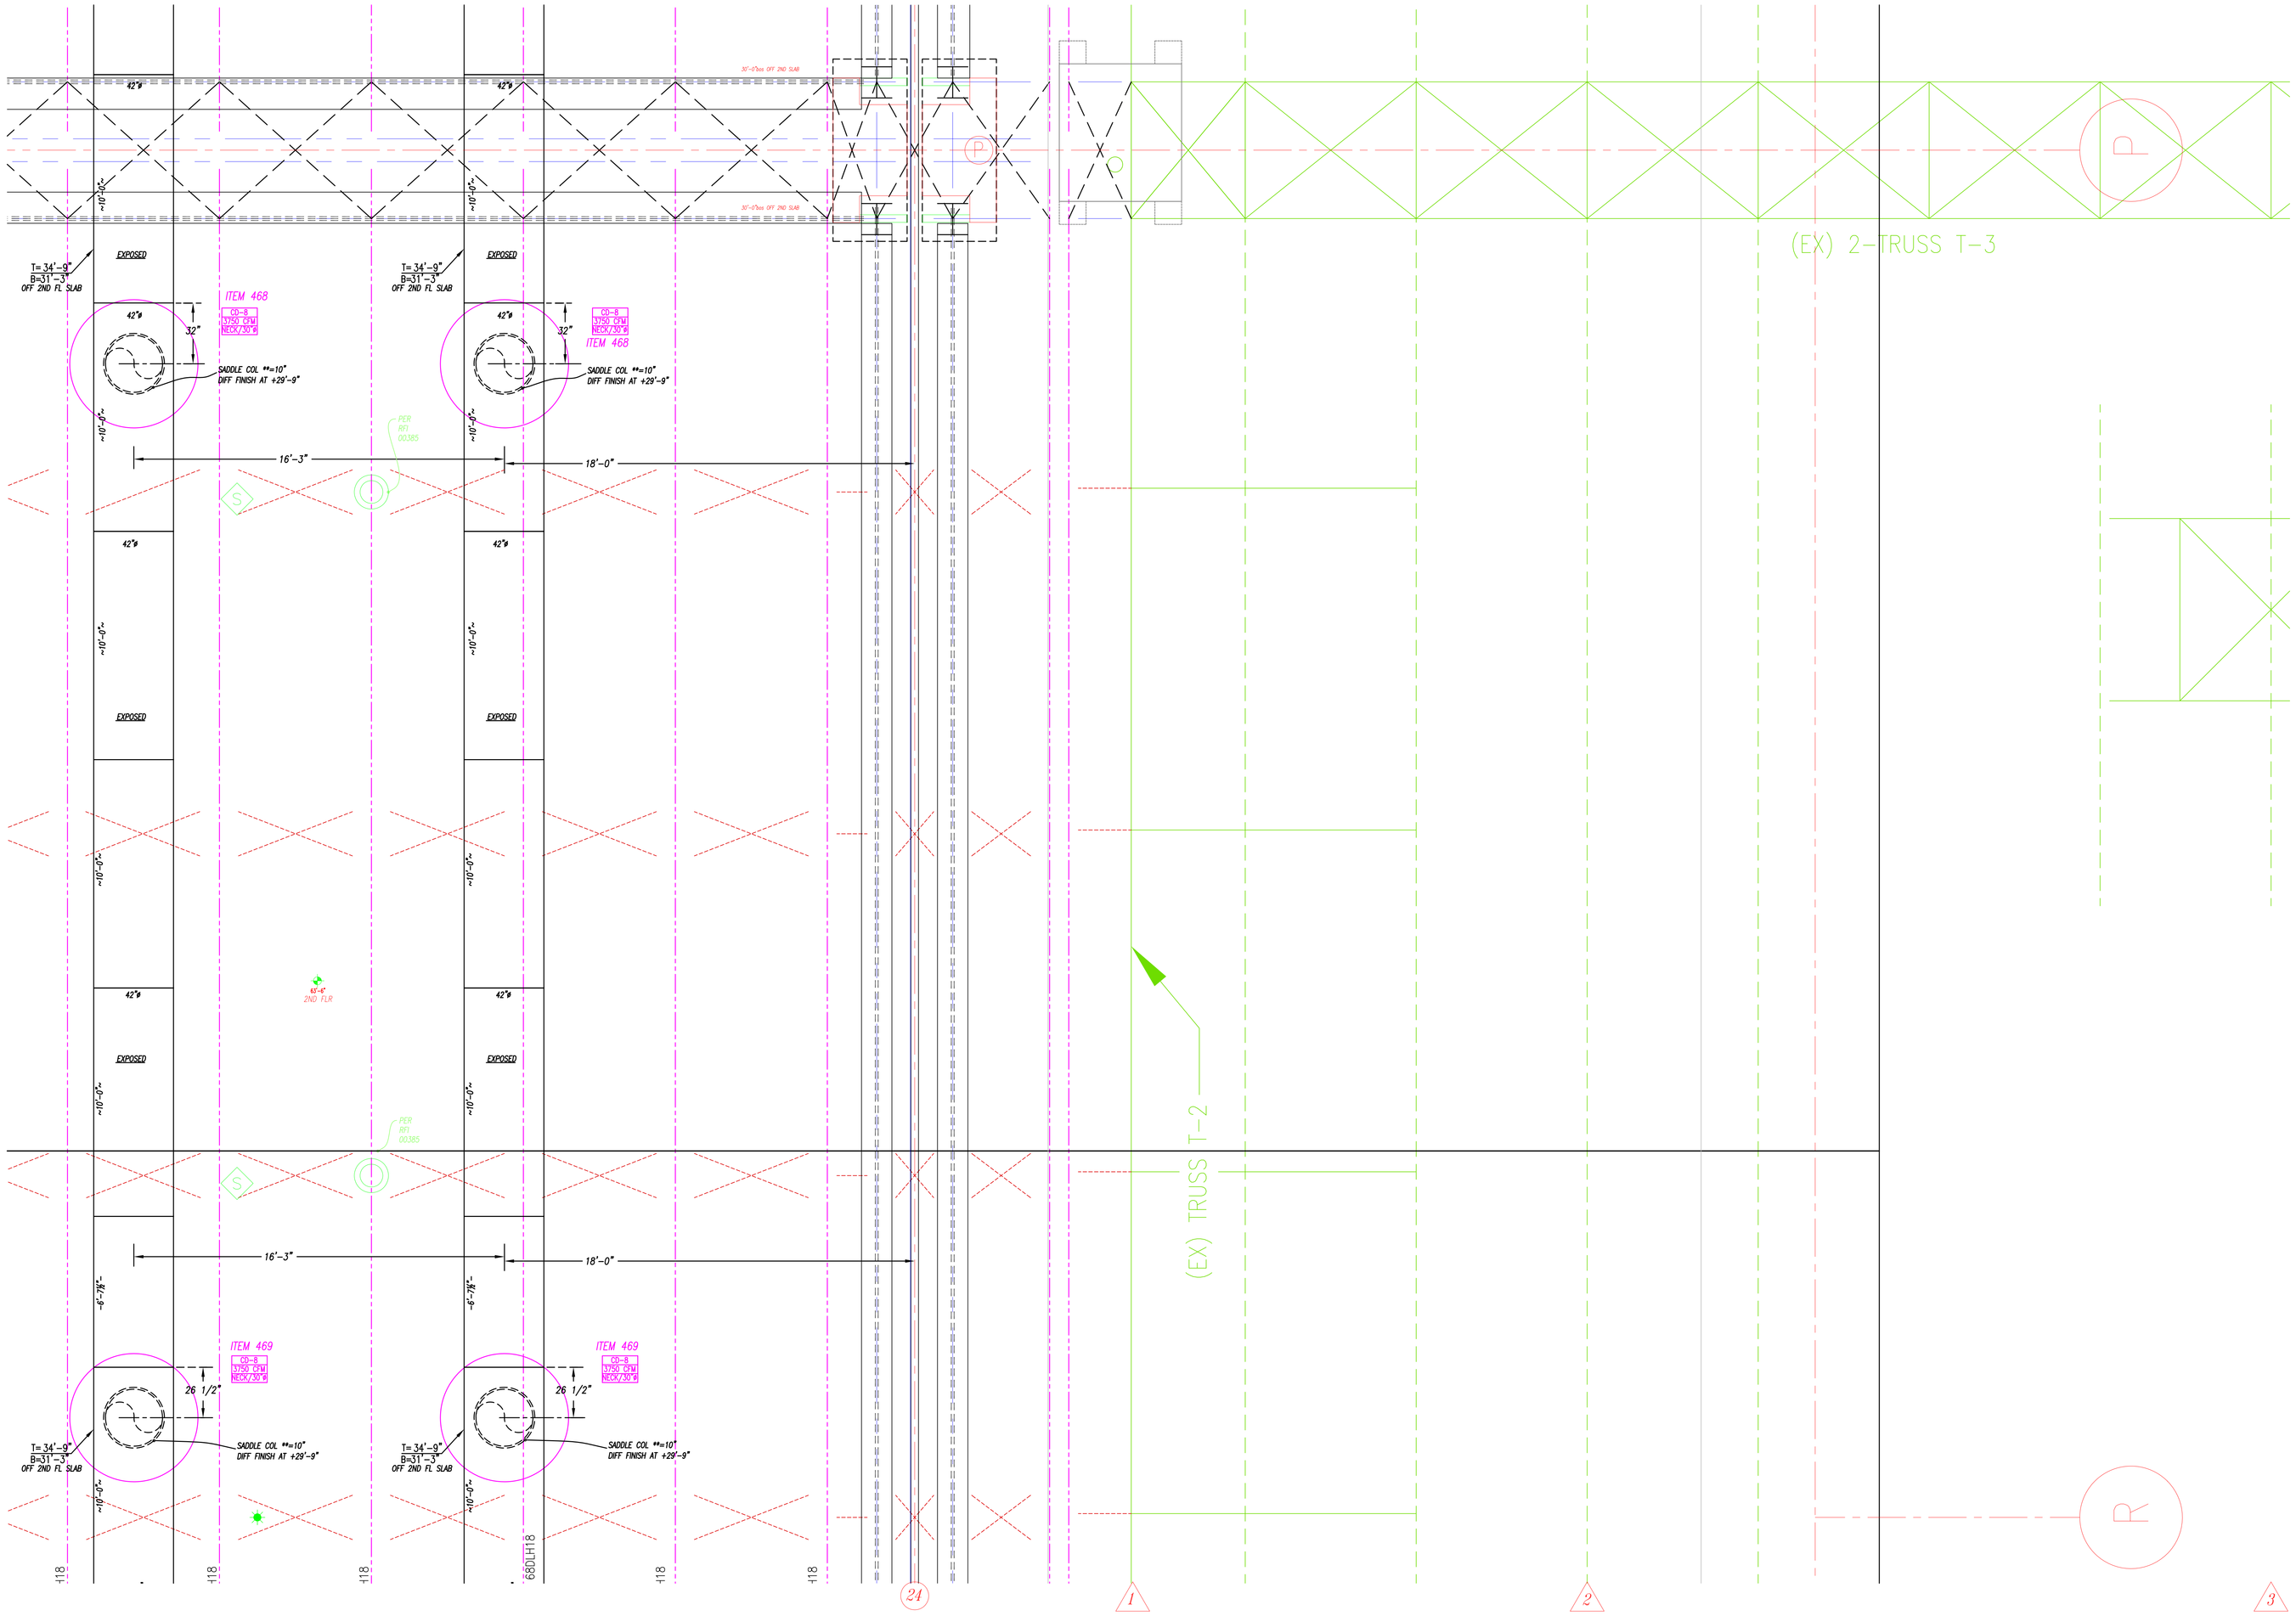

RECORD DRAWINGS
The Keating JV

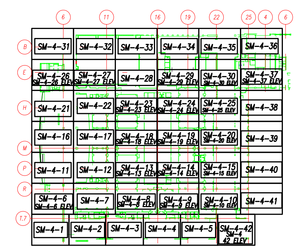

FOURTH FLOOR

NOTES:

1. – ALL DUCT TO BE FABRICATED PER SMACNA CONSTRUCTION STANDARDS.
2. – =◁▷= AIR FLOW – GALV. – NO ACOUST. LINING
3. – =◁▷= AIR FLOW – 1" ACOUST. LINING
4. – =◁▷ SS= AIR FLOW – STAINLESS STEEL
5. – =◁▷ ALUM= AIR FLOW – ALUMINUM
6. – ▷ = W.G. CONSTRUCTION OF DUCT
7. – $\frac{T=\ 0'-0"}{B=\ 0'-0"}$ = TOP OF DUCT ABOVE FINISHED FLOOR / = BOTTOM OF DUCT ABOVE FINISHED FLOOR
8. – COORDINATION NOTE – ALLOW 2" ALL AROUND DUCT FOR FLANGE CONNECTIONS AND FOR EXTERNAL INSULATION WHERE REQUIRED.

REV'D	DESCRIPTION	BY	DATE
AB	AS BUILT	EG	01-11-11
R1	REVISED LENGTHS	EG	09-18-09
C	FOR CONSTRUCTION	EG	09-15-09
A	FOR APPROVAL	EG	05-19-09

Advantage CONTRACTING INC
A Minority Owned Business Enterprise
219 W. Hortter Street • Philadelphia, PA 19119
Phone: 215-844-0191 Fax: 215-844-0192
www.advantagecontracts.com

JOB NAME
PA CONVENTION CENTER
EXPANSION AND RENOVATION

TITLE
LEVEL 4 PARTIAL DUCT PLAN

REF.DWG.- M248	LOC. COLS.		
SCALE 3/8"=1'-0"	CH.	JOB NO.	8520
DATE 05-19-09	BY. EG	DWG. NO.	SM 4-41

68DLH18

42"ø

8 RCLU

38"ø

EXPOSED

T=34'-7"
B=31'-5"
OFF 2ND FL SLAB

~10'-0"~

PER RFI 00385

DECK TYPE "D1"

16'-3"

18'-0"

61'-6"
2ND FLR

SADDLE COL **=12"
DIFF FINISH AT +29'-9"

CO-8
1750 CFM
RISE/30"Ø
ITEM 469

28"

15'-9 1/2"

(EX) 64DLH16

(EX) 64DLH15

(EX) 64DLH14

(EX) (7) 6

R

(EX) 2-TRUSS T-3

8'-8"

8'-6 1/2"

(EX) 20x24

(EX) 18x24

(46)

(214)

212"

18'-1"
CLR OPNG

60X214
GOOSENECK

4'-3 1/2"

40

ON SM 1-41 ELEV

4'-2"

4'-1"
CLR OPNG

24

21

1

2

3

RECORD DRAWINGS
The Keating JV

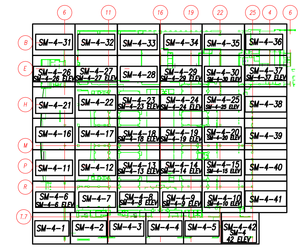

FOURTH FLOOR

NOTES:

1. – ALL DUCT TO BE FABRICATED PER SMACNA CONSTRUCTION STANDARDS.
2. – <G> = AIR FLOW – GALV. – NO ACOUST. LINING
3. – <ALUM> = AIR FLOW – 1" ACOUST. LINING
4. – <S> SS = AIR FLOW – STAINLESS STEEL
5. – <A> ALUM = AIR FLOW – ALUMINUM
6. – [▷] = W.G. CONSTRUCTION OF DUCT
7. – Tx 0'-0" = TOP OF DUCT ABOVE FINISHED FLOOR
   Bx 0'-0" = BOTTOM OF DUCT ABOVE FINISHED FLOOR
8. – COORDINATION NOTE – ALLOW 2" ALL AROUND DUCT FOR FLANGE CONNECTIONS AND FOR EXTERNAL INSULATION WHERE REQUIRED.

REV.	DESCRIPTION	BY	DATE
AB	AS BUILT	EG	01-11-11
R1	REVISED LENGTHS	EG	09-18-09
C	FOR CONSTRUCTION	EG	09-14-09
A	FOR APPROVAL	EG	05-19-09

Advantage CONTRACTING INC.
A Minority Owned Business Enterprise
219 W. Hortter Street • Philadelphia, PA 19119
Phone: 215-844-0191 Fax: 215-844-0192
www.advantagecontracts.com

JOB NAME: PA CONVENTION CENTER
EXPANSION AND RENOVATION

TITLE: LEVEL 4 PARTIAL DUCT PLAN

REF. DWG: M-848
LOC. COLS.
SCALE: 3/8"=1'-0"
CH.
JOB NO. 8520
DATE: XX-XX-XX
BY: EG
DWG. NO. SM 4-42

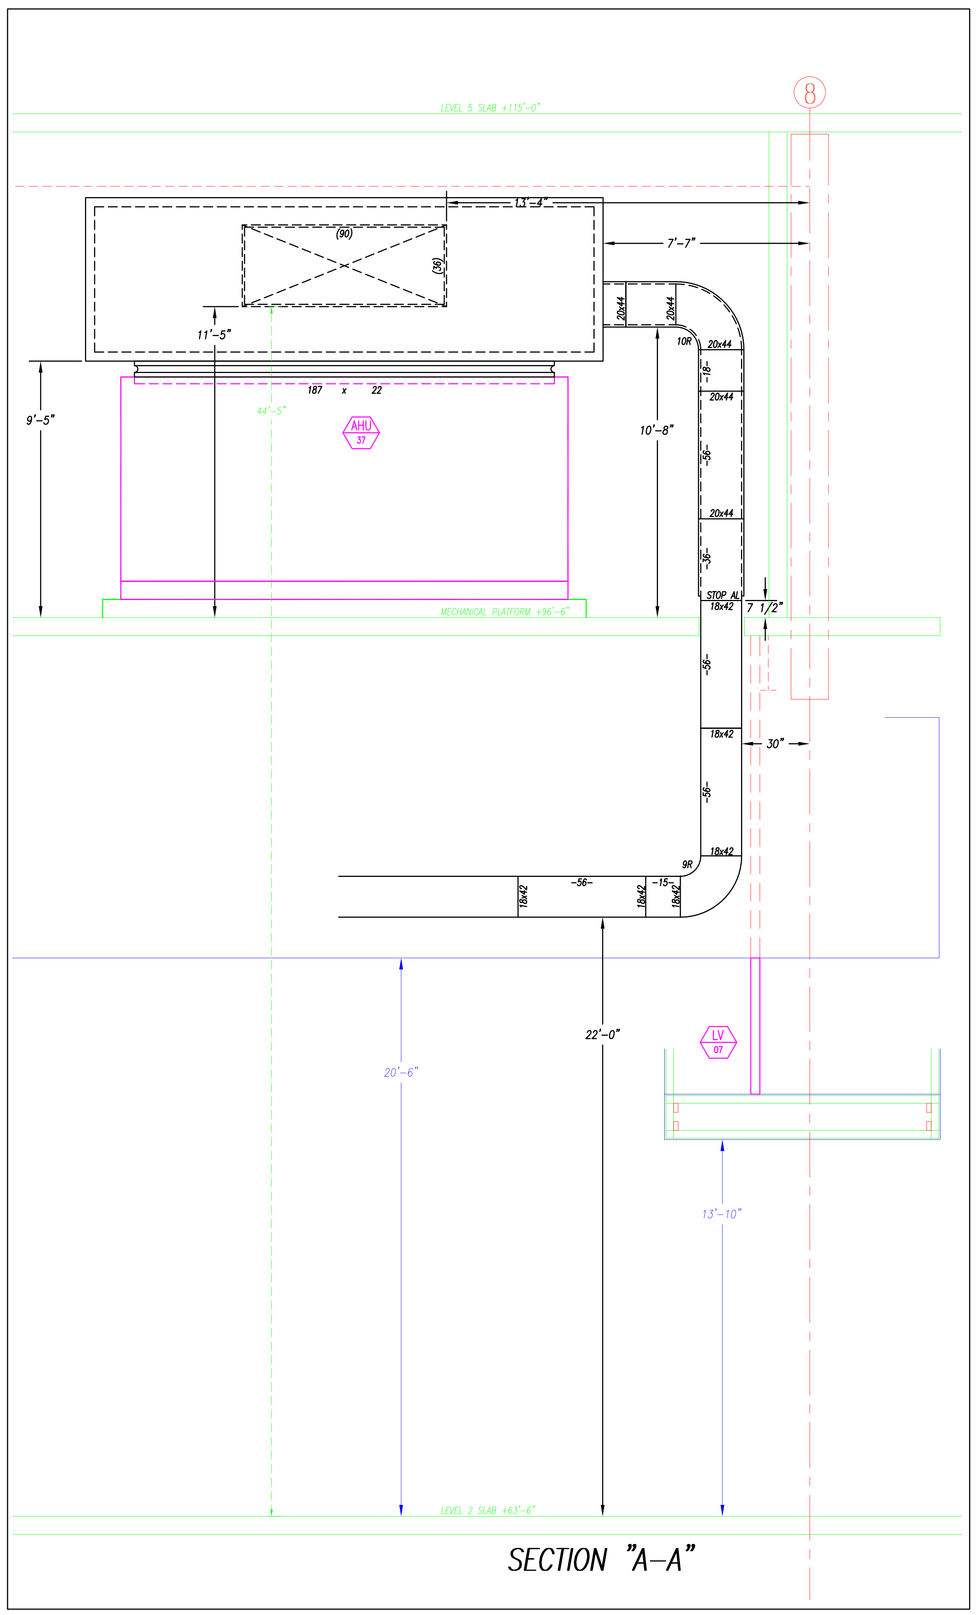

SECTION "A-A"

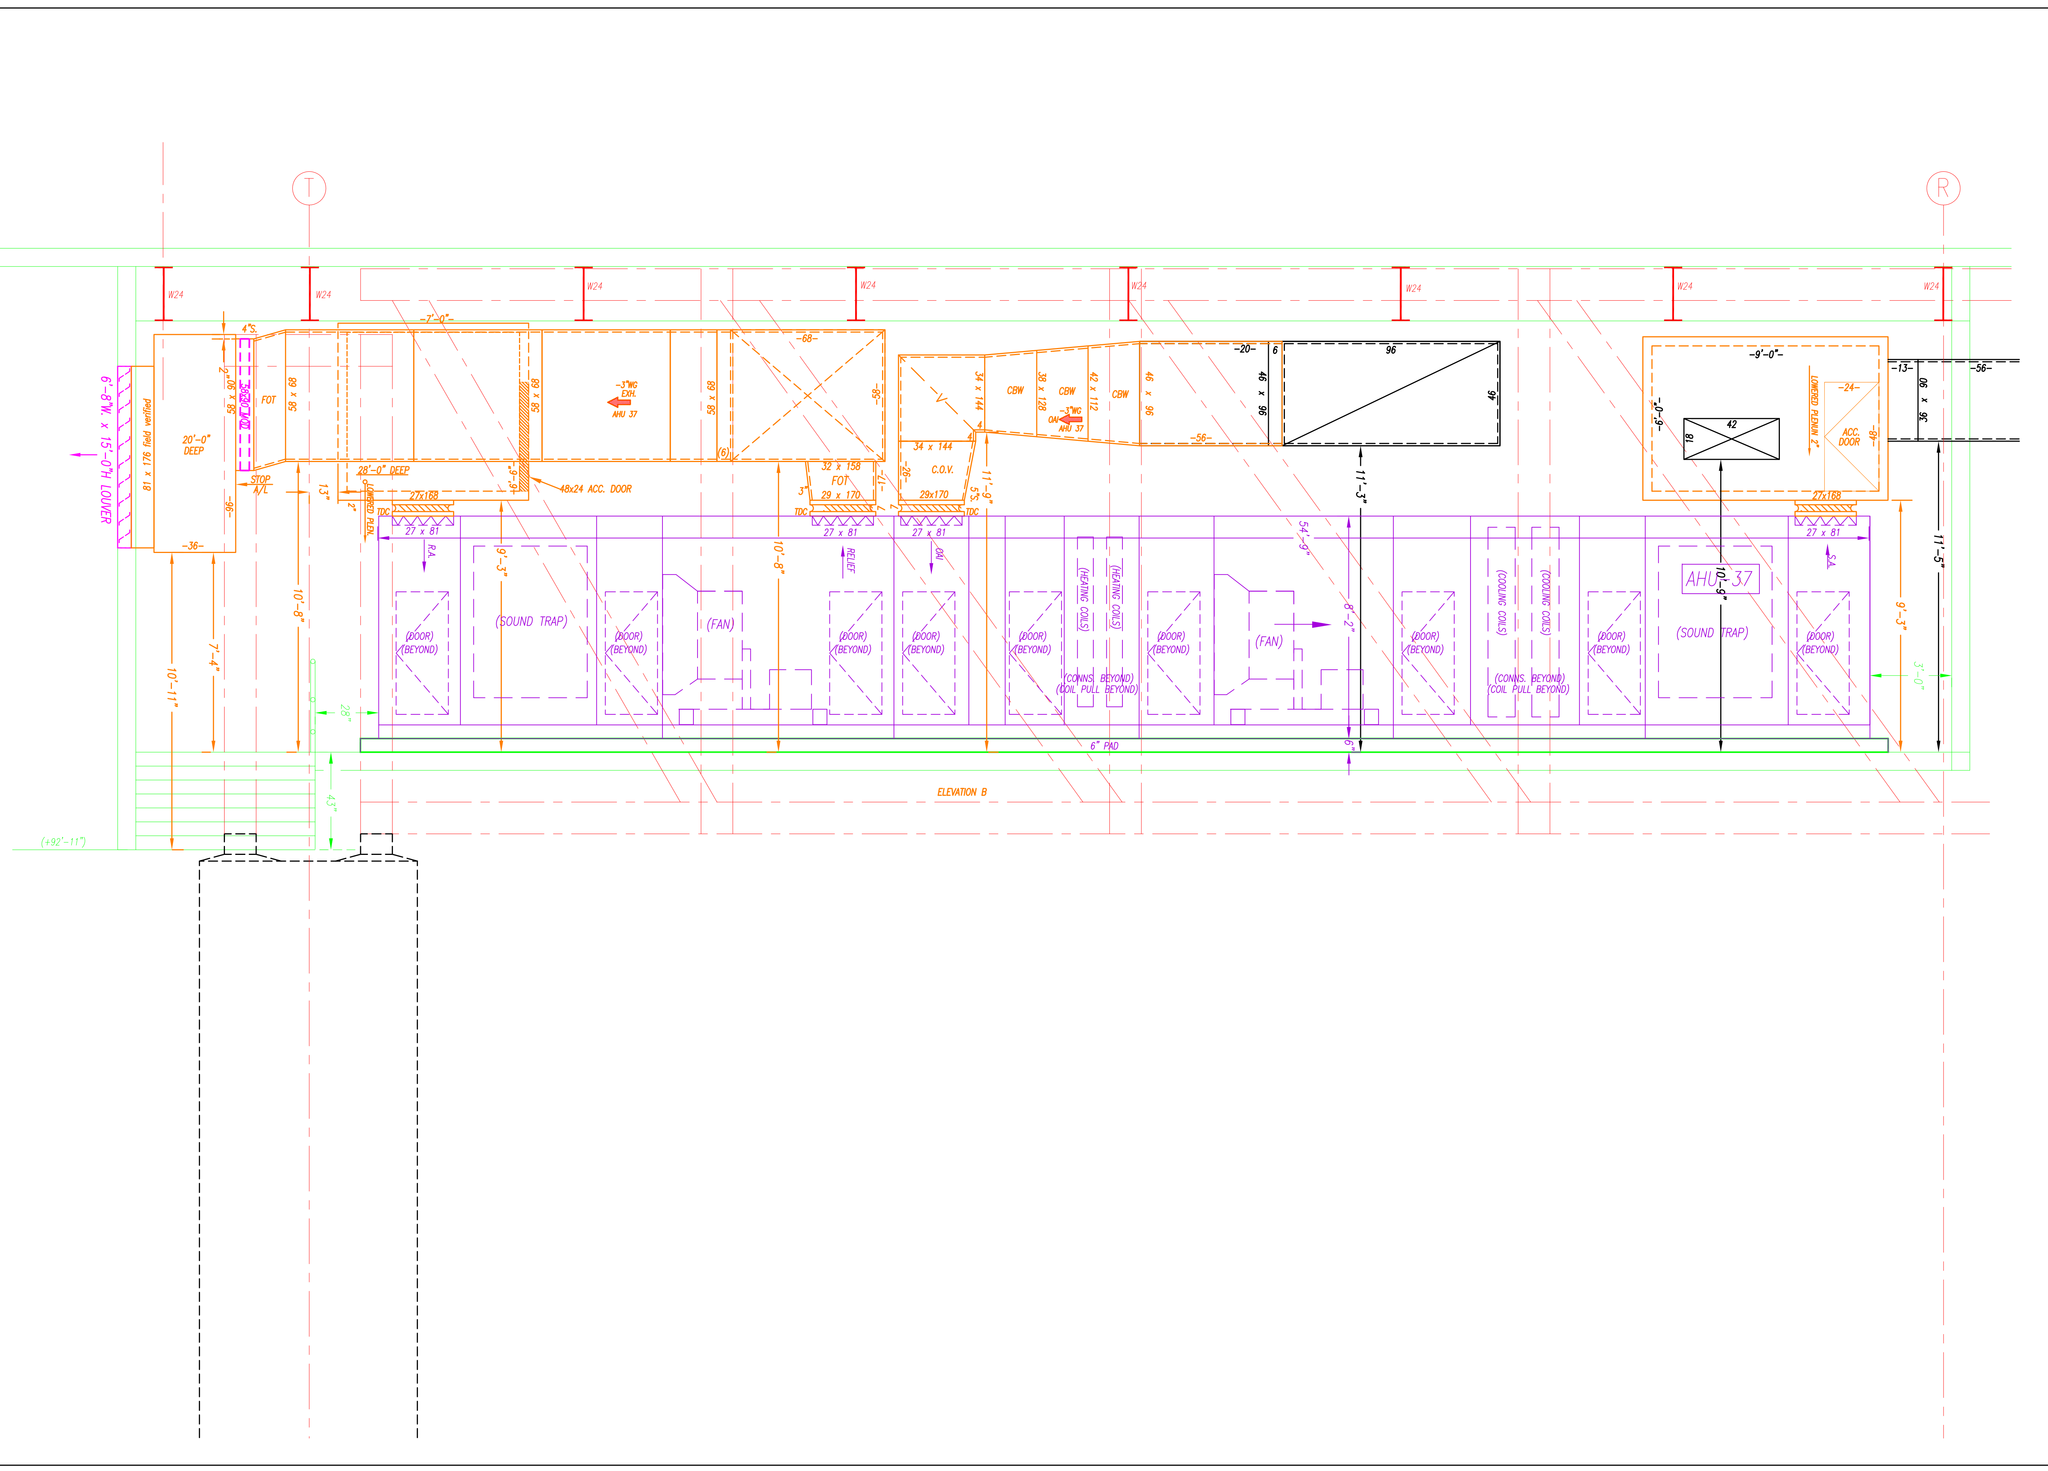

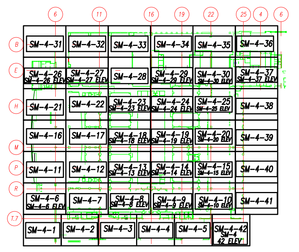

FOURTH FLOOR

RECORD DRAWINGS
The Keating JV

NOTES:
1. - ALL DUCT TO BE FABRICATED PER SMACNA CONSTRUCTION STANDARDS.
2. - <=> = AIR FLOW - GALV. - NO ACOUST. LINING
3. - <=> = AIR FLOW -1" ACOUST. LINING
4. - <=> SS = AIR FLOW - STAINLESS STEEL
5. - <=> ALUM = AIR FLOW - ALUMINUM
6. - ▷ = W.G. CONSTRUCTION OF DUCT
7. - 1x 0'-0 = TOP OF DUCT ABOVE FINISHED FLOOR; Bx 0'-0 = BOTTOM OF DUCT ABOVE FINISHED FLOOR
8. - COORDINATION NOTE - ALLOW 2" ALL AROUND DUCT FOR FLANGE CONNECTIONS AND TOR EXTERNAL INSULATION WHERE REQUIRED.

REV.	DESCRIPTION	DR.	DATE
AB	AS BUILT	EG	01-11-11
C	FOR CONSTRUCTION	EG	12-15-09
R1	UNIT REVISION	MSO	09-16-09
A	FOR APPROVAL	BLJ	05-16-09

Advantage CONTRACTING INC.
A Minority Owned Business Enterprise
219 W. Hortter Street • Philadelphia, PA 19119
Phone: 215-844-0191 Fax: 215-844-0192
www.advantagecontracts.com

JOB NAME: PA CONVENTION CENTER
EXPANSION AND RENOVATION

TITLE: LEVEL 4 DUCT ELEVATIONS

REF DWG-	SM 4-6	LOC. COLS.	
SCALE	3/8"=1'-0"	CK.	JOB NO. 8520
DATE	05-16-09	DR. BLJ	DWG. NO. SM 4-6 ELEV

CHANGE COLLAR LOCATIONS PER ASI-64 02-12-10

(SOUND TRAP)

AHU-37

TOP 18'-8" A.F.F.

FOURTH FLOOR

RECORD DRAWINGS
The Keating JV

NOTES:

1. – ALL DUCT TO BE FABRICATED PER SMACNA CONSTRUCTION STANDARDS.
2. – <=> = AIR FLOW – GALV. – NO ACOUST. LINING
3. – r'#1=> = AIR FLOW –1" ACOUST. LINING
4. – <=> ## = AIR FLOW – STAINLESS STEEL
5. – <=> ### = AIR FLOW – ALUMINUM
6. – ▷ = W.G. CONSTRUCTION OF DUCT
7. – T= 0'-0 = TOP OF DUCT ABOVE FINISHED FLOOR; B= 0'-0 = BOTTOM OF DUCT ABOVE FINISHED FLOOR
8. – COORDINATION NOTE – ALLOW 1" ALL AROUND DUCT FOR FLANGE CONNECTIONS AND FOR EXTERNAL INSULATION WHERE REQUIRED.

REV	DESCRIPTION	DR.	DATE
AB	AS BUILT	EG	01-11-11
R3	REVISED PER ASI-64	EG	02-12-10
R2	REVISED FOR GRDS	EG	01-29-10
C	FOR CONSTRUCTION	EG	12-16-09
R1	UNIT REVISION	MSO	09-16-09
A	FOR APPROVAL	BLJ	05-16-09

Advantage CONTRACTING INC.
A Minority Owned Business Enterprise
219 W. Hortter Street • Philadelphia, PA 19119
Phone: 215-844-0191 Fax: 215-844-0192
www.advantagecontracts.com

JOB NAME: PA CONVENTION CENTER
EXPANSION AND RENOVATION

TITLE: LEVEL 4 PARTIAL DUCT PLAN

REF. DWG.: M-242	LOC. COLS.		
SCALE: 3/8"=1'-0"	DR.	JOB NO.	8520
DATE: 05-16-09	DR. BLJ	DWG. NO.	SM 4-6

CONT SM 4-12
CONT SM 4-7

EXPOSED

T= 45'-1"
B=41'-7"
OFF 2ND FL SLAB

T=44'-11"
B=41'-9"
OFF 2ND FL SLAB

T= 37'-1"
B=31'-3"
OFF 2ND FL SLAB

SADDLE COL **=134"
36# =6= & =128=
DIFF FINISH AT +29'-9"

CO-9
7500 CFM
16DX72E
ITEM 447

SADDLE COL **=136"
36# =6= & =130=
DIFF FINISH AT +29'-9"

CO-9
7500 CFM
16DX72E
ITEM 447

T= 48'-0"
B=44'-4

T= 46'-6"
B=42'-0"

W16x15
X-BRACING TO
TOPCHORD(25k)

ASI-88 SHOWS THIS ROW LIGHTS
MOVING OVER 36" 18'-0"
OFF COLUMN LINE B

OPENING IN 5TH FLR ABOVE DELETED
PER ASI #36 DATED 6-25-09

STOP A/L

HD

AHU 15

AHU 37

AHU-33

AHU-30

OUTSIDE AIR

FOURTH FLOOR

CONT SM 4-7
CONT SM 4-8

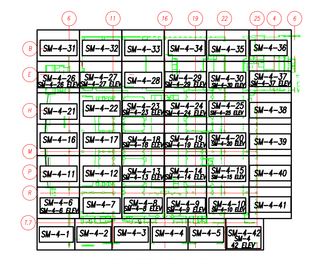

NOTES:

1. = ALL DUCT TO BE FABRICATED PER SMACNA CONSTRUCTION STANDARDS.
2. =CD= = AIR FLOW = DUCT, = NO ACOUST. LINING
3. = r1x1(25)= = AIR FLOW = 1" ACOUST. LINING
4. =CD= #8 = AIR FLOW = STAINLESS STEEL
5. =CD= ALUM = AIR FLOW = ALUMINUM
6. = ▷ = W.G. CONSTRUCTION OF DUCT
7. = Tx'-0" = TOP OF DUCT ABOVE FINISHED FLOOR
Bx'-0" = BOTTOM OF DUCT ABOVE FINISHED FLOOR
8. = COORDINATION NOTE = ALLOW 2" ALL AROUND DUCT FOR FLANGE CONNECTIONS AND FOR EXTERNAL INSULATION WHERE REQUIRED.

REV.	DESCRIPTION	DR.	DATE
AB	AS BUILT	EG	01-11-11
R1	REVISED FOR GRDS	EG	01-29-10
C	FOR CONSTRUCTION	EG	11-04-09
S	SIGN OFF	EG	09-18-09
A	FOR APPROVAL	BLJ	08-19-09

RECORD DRAWINGS
The Keating JV

Advantage CONTRACTING INC.
A Minority Owned Business Enterprise
219 W. Hortter Street • Philadelphia, PA 19119
Phone: 215-844-0191 Fax: 215-844-0192
www.advantagecontracts.com

JOB NAME
PA CONVENTION CENTER
EXPANSION AND RENOVATION

TITLE LEVEL 4 PARTIAL DUCT PLAN

REF. DWG.	M 242	LOC. COLS.	
SCALE	3/8"=1'-0"	CH.	JOB NO. 8520
DATE	XX-XX-XX	DR. BLJ	DWG. NO. SM 4-7

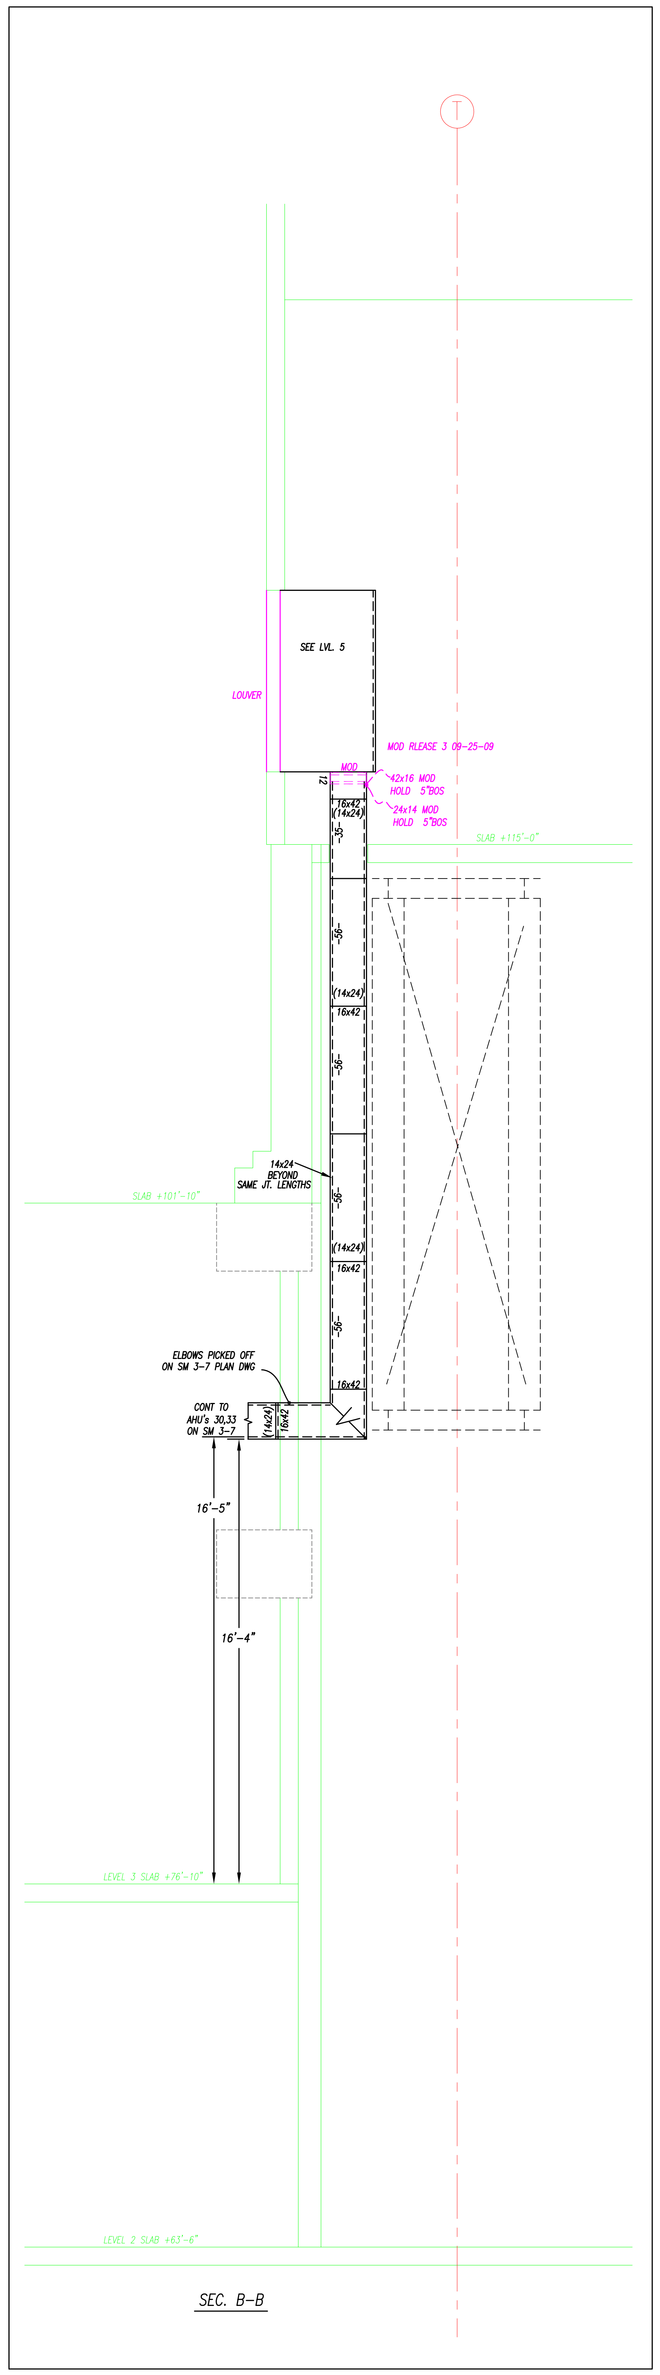

SEC. B-B

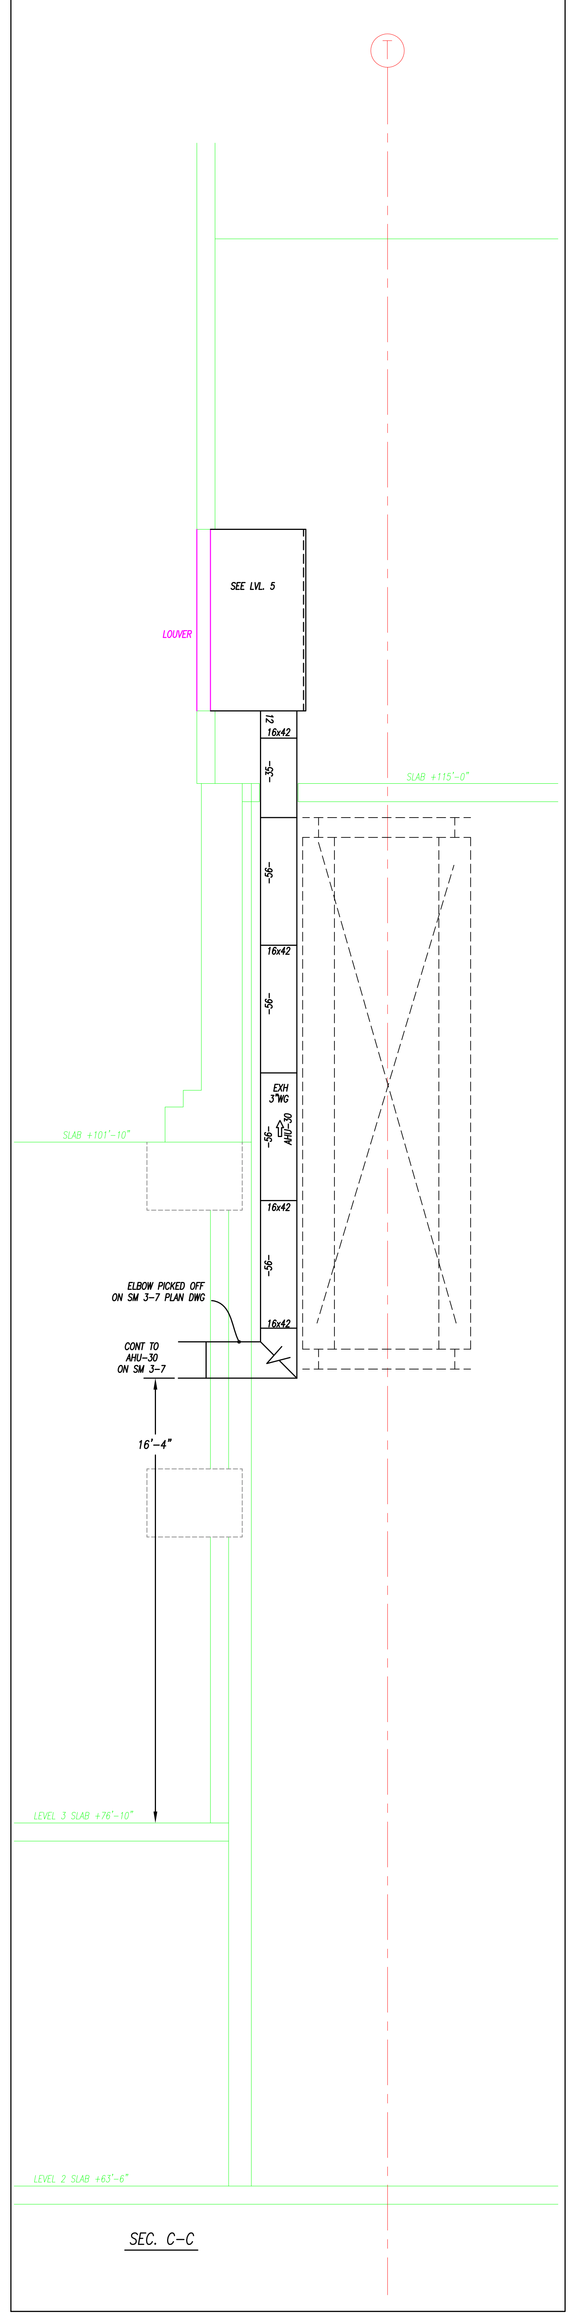

SEC. C-C

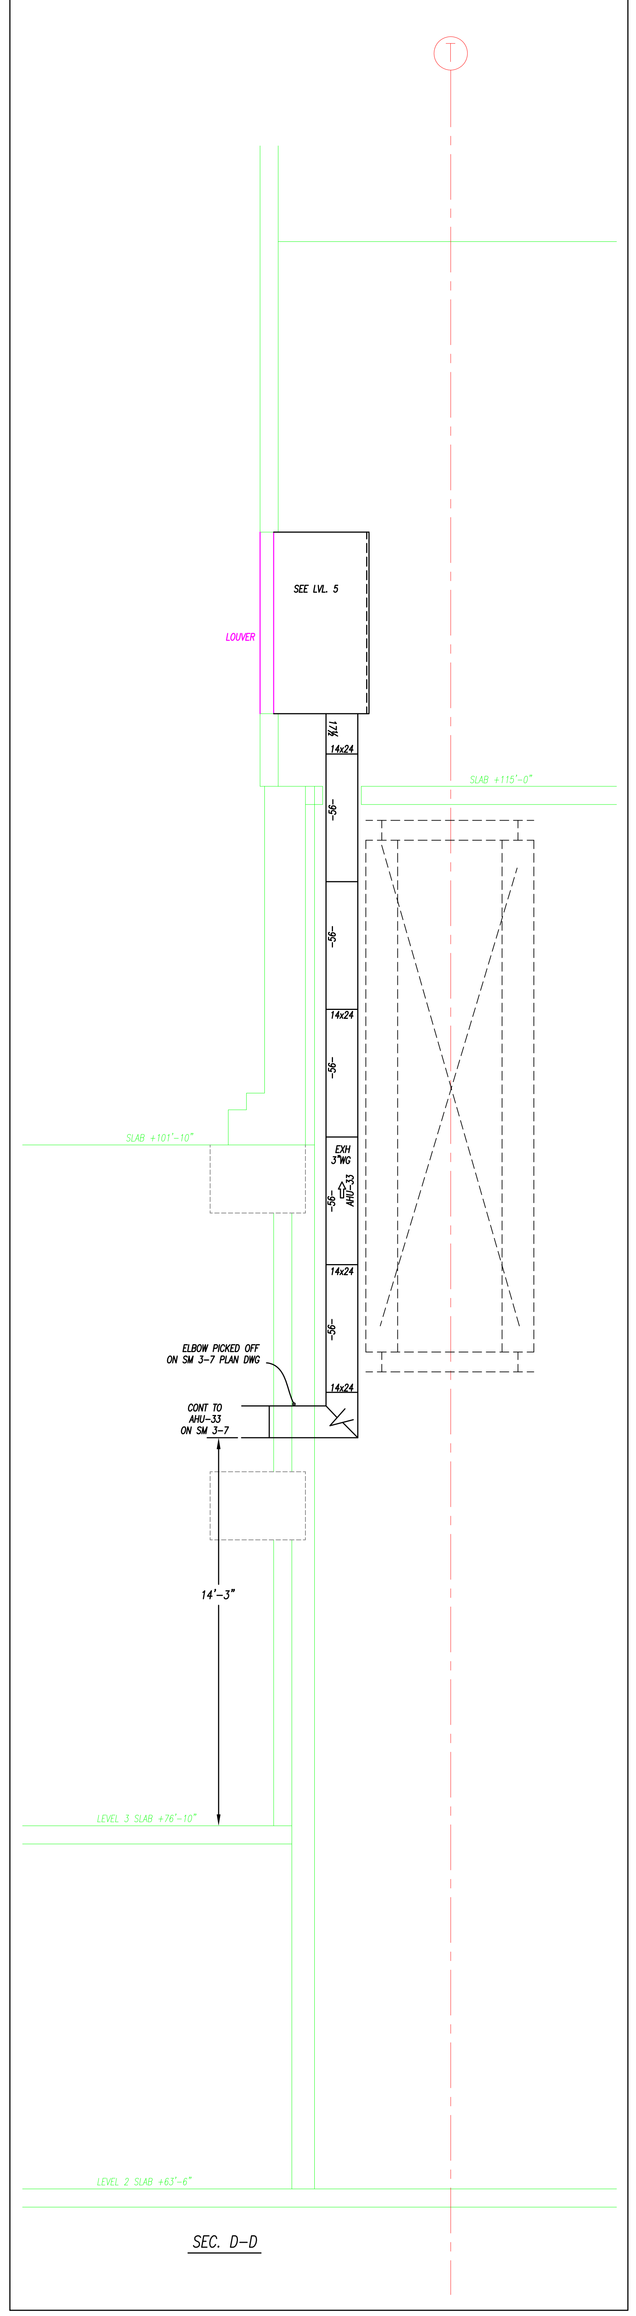

SEC. D-D

RECORD DRAWINGS
The Keating JV

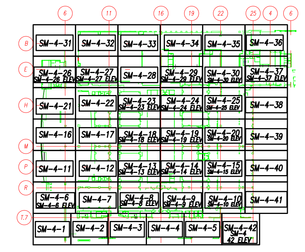

FOURTH FLOOR

NOTES:

1. - ALL DUCT TO BE FABRICATED PER SMACNA CONSTRUCTION STANDARDS.
2. - <=> = AIR FLOW - GALV. - NO ACOUST. LINING
3. - 1"<=> = AIR FLOW -1" ACOUST. LINING
4. - <=> SS = AIR FLOW - STAINLESS STEEL
5. - <=> ALUM = AIR FLOW - ALUMINUM
6. - |▷ = W.G. CONSTRUCTION OF DUCT
7. - Te 0'-0 = TOP OF DUCT ABOVE FINISHED FLOOR
   Be 0'-0 = BOTTOM OF DUCT ABOVE FINISHED FLOOR
8. - COORDINATION NOTE - ALLOW 3" ALL AROUND DUCT FOR FLANGE CONNECTIONS AND FOR EXTERNAL INSULATION WHERE REQUIRED.

REV.	DESCRIPTION	DR.	DATE
AB	AS BUILT	EG	01-11-11
C	FOR CONSTRUCTION	EG	11-04-09
A	FOR APPROVAL	BLJ	05-19-09

Advantage CONTRACTING INC.
A Minority Owned Business Enterprise
219 W. Hortter Street • Philadelphia, PA 19119
Phone: 215-844-0191 Fax: 215-844-0192
www.advantagecontracts.com

JOB NAME: PA CONVENTION CENTER
EXPANSION AND RENOVATION

TITLE: LEVEL 4 DUCT ELEVATIONS

REF. DWGS:	SM 4-7	LOC. COILS:	
SCALE:	3/8"=1'-0"	CH.	JOB NO. 8520
DATE:	05-19-09	DR. BLJ	DWG. NO. SM 4-7 ELEV

CONT SM 4-13
CONT SM 4-8

EXPOSED

~10'-0"~

5'-0"

7'-7"

4'-6 1/2"

T= 45'-1"
B=41'-7"
OFF 2ND FL SLAB

CD-9
7500 CFM
HEXX/36"K
ITEM 447

CD-2
7500 CFM
HEXX/36"K
ITEM 460

SADDLE COL **=134"
36# ~6~ & ~128~
DIFF FINISH AT +29'-9"

W18x76
X-BRACING IN
TOPCHORD(CSA)

(36'0)

42"ø

38"ø

T=44'-11"
B=41'-9"
OFF 2ND FL SLAB

11'-5"

CONT SM 4-7
CONT SM 4-8

~6'-0"~

(~6'-0"~)

38"ø

(70'ø)

70'ø

W36X116
B=47'-10" OFF 2ND SLAB

EXPOSED

1¼Ø
EF 11.12

12'-2 1/2"

T= 37'-1"
B=31'-3"
OFF 2ND FL SLAB

42'-6"
2ND FLR

SA
SUP
AHU 15

T=44'-11"
B=41'-9"
OFF 2ND FL SLAB

5'-0"

7'-7"

SADDLE COL **=136"
36# ~6~ & ~130~
DIFF FINISH AT +29'-9"

W18x76
X-BRACING
ITEM 447(TOPCHORD(CSA)

(36'0)

2'-11"

38"ø

HD.

-56-

44 x 94

EXPOSED

SA
AHU 37

13'-2"

20'-10"

CONT SM 4-7
CONT SM 4-8

T= 48'-0"
B=44'-4"

94 x 44

HOLD THIS AREA FOR
HOLE VERIFICATION

6'-1"

UP-9"

96 x 84

OA
70'-8"

5TH FLR OPNG
PER ASI 38
(OA FOR AHU-37)

90 x 50

T= 46'-7"
B=42'-5"

ON SM 4-6 ELEV

6'-3"

3'-3 1/2"

3'-11"

EXH
UP-10"
TX-4

78

22"

6"

190

OUTSIDE AIR
AHU-30

12'-2 1/2"
T= 22'-2"
B=19'-8"

(30)

B4-104
B=22'-6"

B4-81
B=22'-6"

B4-82
B=22'-6"

B4-82
B=21'-0"

B4-83
B=22'-6"

B4-83
B=22'-6"

B4-01
B=22'-6"

B4-01
B=22'-6"

B4-21
B=22'-0"

B4-21
B=22'-0"

B4-145
B=21'-10"

W27x84
B=35'-3" FORM LEVEL 3 SLAB

W27x84
B=35'-3" OFF LEVEL 3

LEVEL 3 SLAB

2x30
36'-7 1/2" OFF LEVEL 3 SLAB

2x28
36'-8" OFF LEVEL 3 SLAB

32'-8"

DN

UP

25'-0 1/2"

20'-6 1/2"

FAN LOCATIONS BY JOIST MANUFACTURER: RFI#122 AND RESPONSE TO CONTRACT 1 RFI#326 WITH ATTATCHED SKETCHES

FAN MOTOR THIS SIDE

60x60 UP TO EF-11 ON ROOF

EF 11

A
ON SM 4-8 ELEV

A
ON SM 4-8

68DLH19

TDF IN
O/TOP

TDF IN
O/SIDE

108 x 48

60

68

EXPOSED

T= 36'-2"
B=32'-2"
OFF 2ND FL SLAB

T= 36'-0"
B=32'-4"
OFF 2ND FL SLAB

W8x24

CBV

15'-10"

44 x 94

FAN MOTOR THIS SIDE

60x60 UP TO EF-12 ON ROOF

EF 12

T= 37'-1"
B=31'-3"
OFF 2ND FL SLAB

T= 36'-2"
B=32'-2"
OFF 2ND FL SLAB

22'-6"

41'-6"

W30X116
B=48'-4" OFF 2ND SLAB

W24X62
B=48'-10" OFF 2ND SLAB

W24X68
B=48'-10" OFF 2ND SLAB

W16X26
B=49'-6" OFF 2ND SLAB

W12X16
B=49'-10" OFF 2ND SLAB

W30X116
B=48'-4" OFF 2ND SLAB

W36X116
B=47'-10" OFF 2ND SLAB

W36X116
B=47'-2" OFF 2ND SLAB

W24X55
B=48'-10" OFF 2ND SLAB

W21X44
B=49'-1" OFF 2ND SLAB

W33X118
B=49'-4" OFF 2ND SLAB

W33X118
B=49'-10" OFF 2ND SLAB

W30X99
B=49'-4" OFF 2ND SLAB

W24X55
B=48'-10" OFF 2ND SLAB

W24X68
B=48'-10" OFF 2ND SLAB





















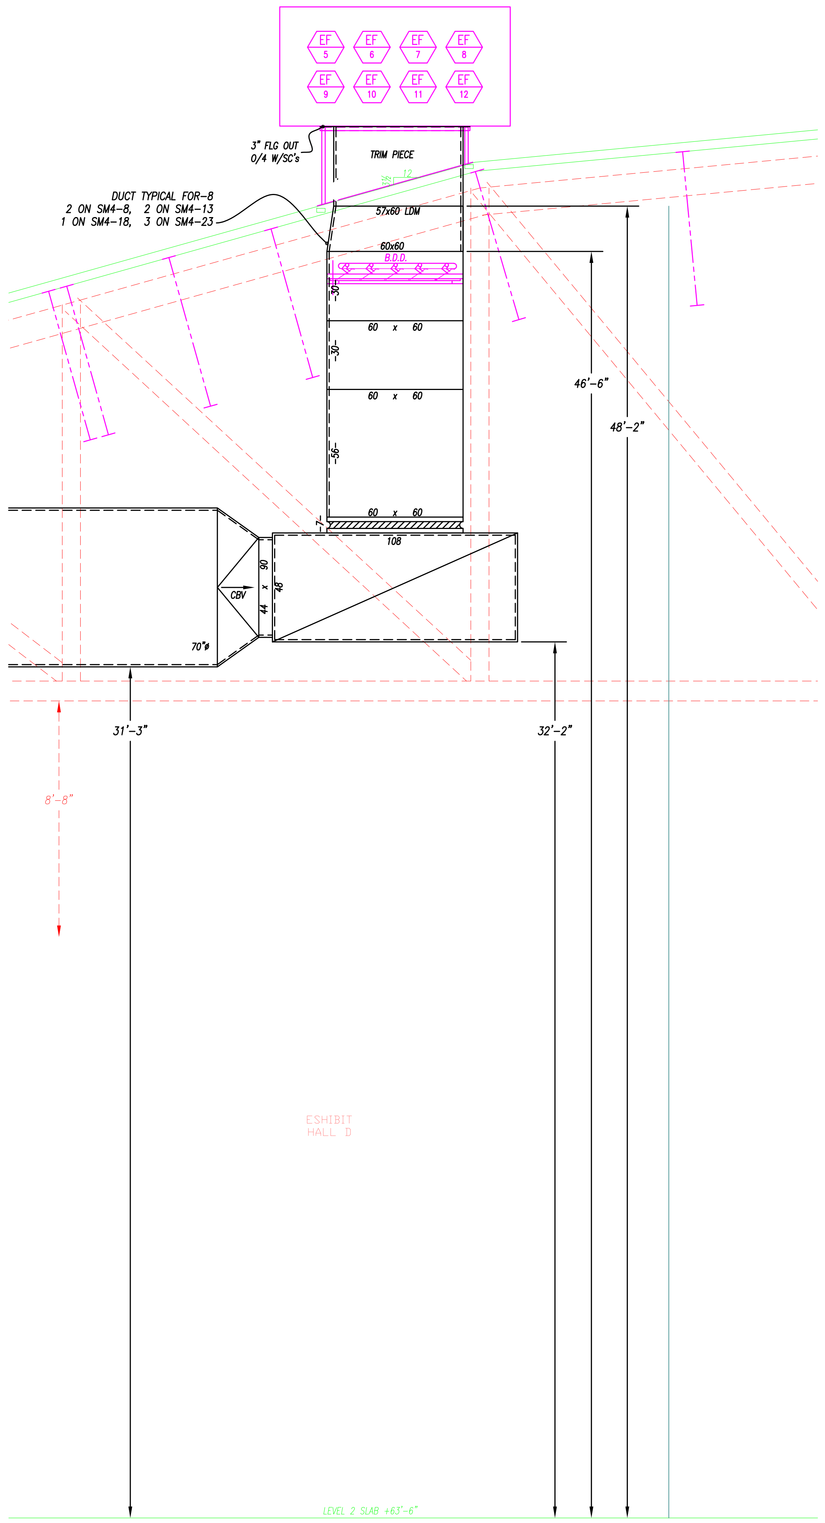

SECTION "A-A"

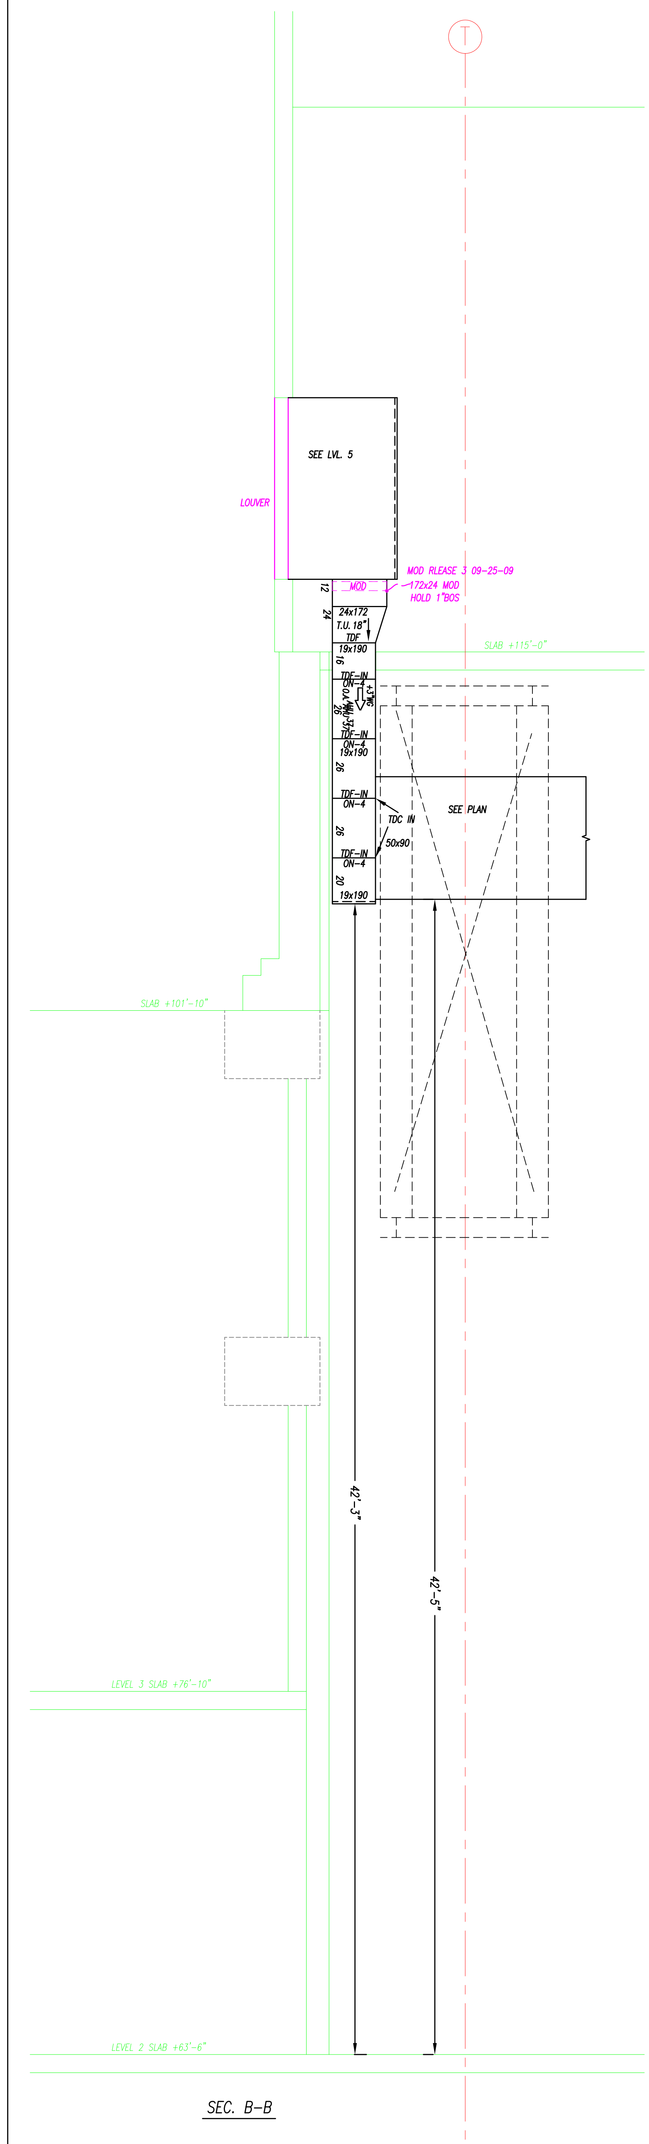

SEC. B-B

RECORD DRAWINGS
The Keating JV

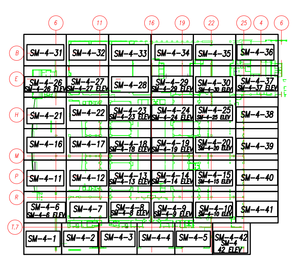

FOURTH FLOOR

NOTES:

1. - ALL DUCT TO BE FABRICATED PER SMACNA CONSTRUCTION STANDARDS.
2. - <=> = AIR FLOW - GALV. - NO ACOUST. LINING
3. - <=> = AIR FLOW - 1" ACOUST. LINING
4. - <=> SS = AIR FLOW - STAINLESS STEEL
5. - <=> ALUM = AIR FLOW - ALUMINUM
6. - ▷ = W.G. CONSTRUCTION OF DUCT
7. - 7'-0"+ = TOP OF DUCT ABOVE FINISHED FLOOR; 9'-0" = BOTTOM OF DUCT ABOVE FINISHED FLOOR
8. - COORDINATION NOTE - ALLOW 2" ALL AROUND DUCT FOR FLANGE CONNECTIONS AND FOR EXTERNAL INSULATION WHERE REQUIRED.

REV.	DESCRIPTION	BY	DATE
AB	AS BUILT	EG	01-11-11
C	FOR CONSTRUCTION	EG	11-04-09
A	FOR APPROVAL	BLJ	05-19-09

Advantage CONTRACTING INC.
A Minority Owned Business Enterprise
219 W. Hortter Street • Philadelphia, PA 19119
Phone: 215-844-0191 Fax: 215-844-0192
www.advantagecontracts.com

JOB NAME: PA CONVENTION CENTER
EXPANSION AND RENOVATION

TITLE: LEVEL 4 DUCT ELEVATIONS

REF. DWG.-	SM 4-8	LOC. COLS.	AS NOTED
SCALE	3/8"=1'-0"	CH.	JOB NO. 8520
DATE	XX-XX-XX	DR. BLJ	DWG. NO. SM 4-8 ELEV

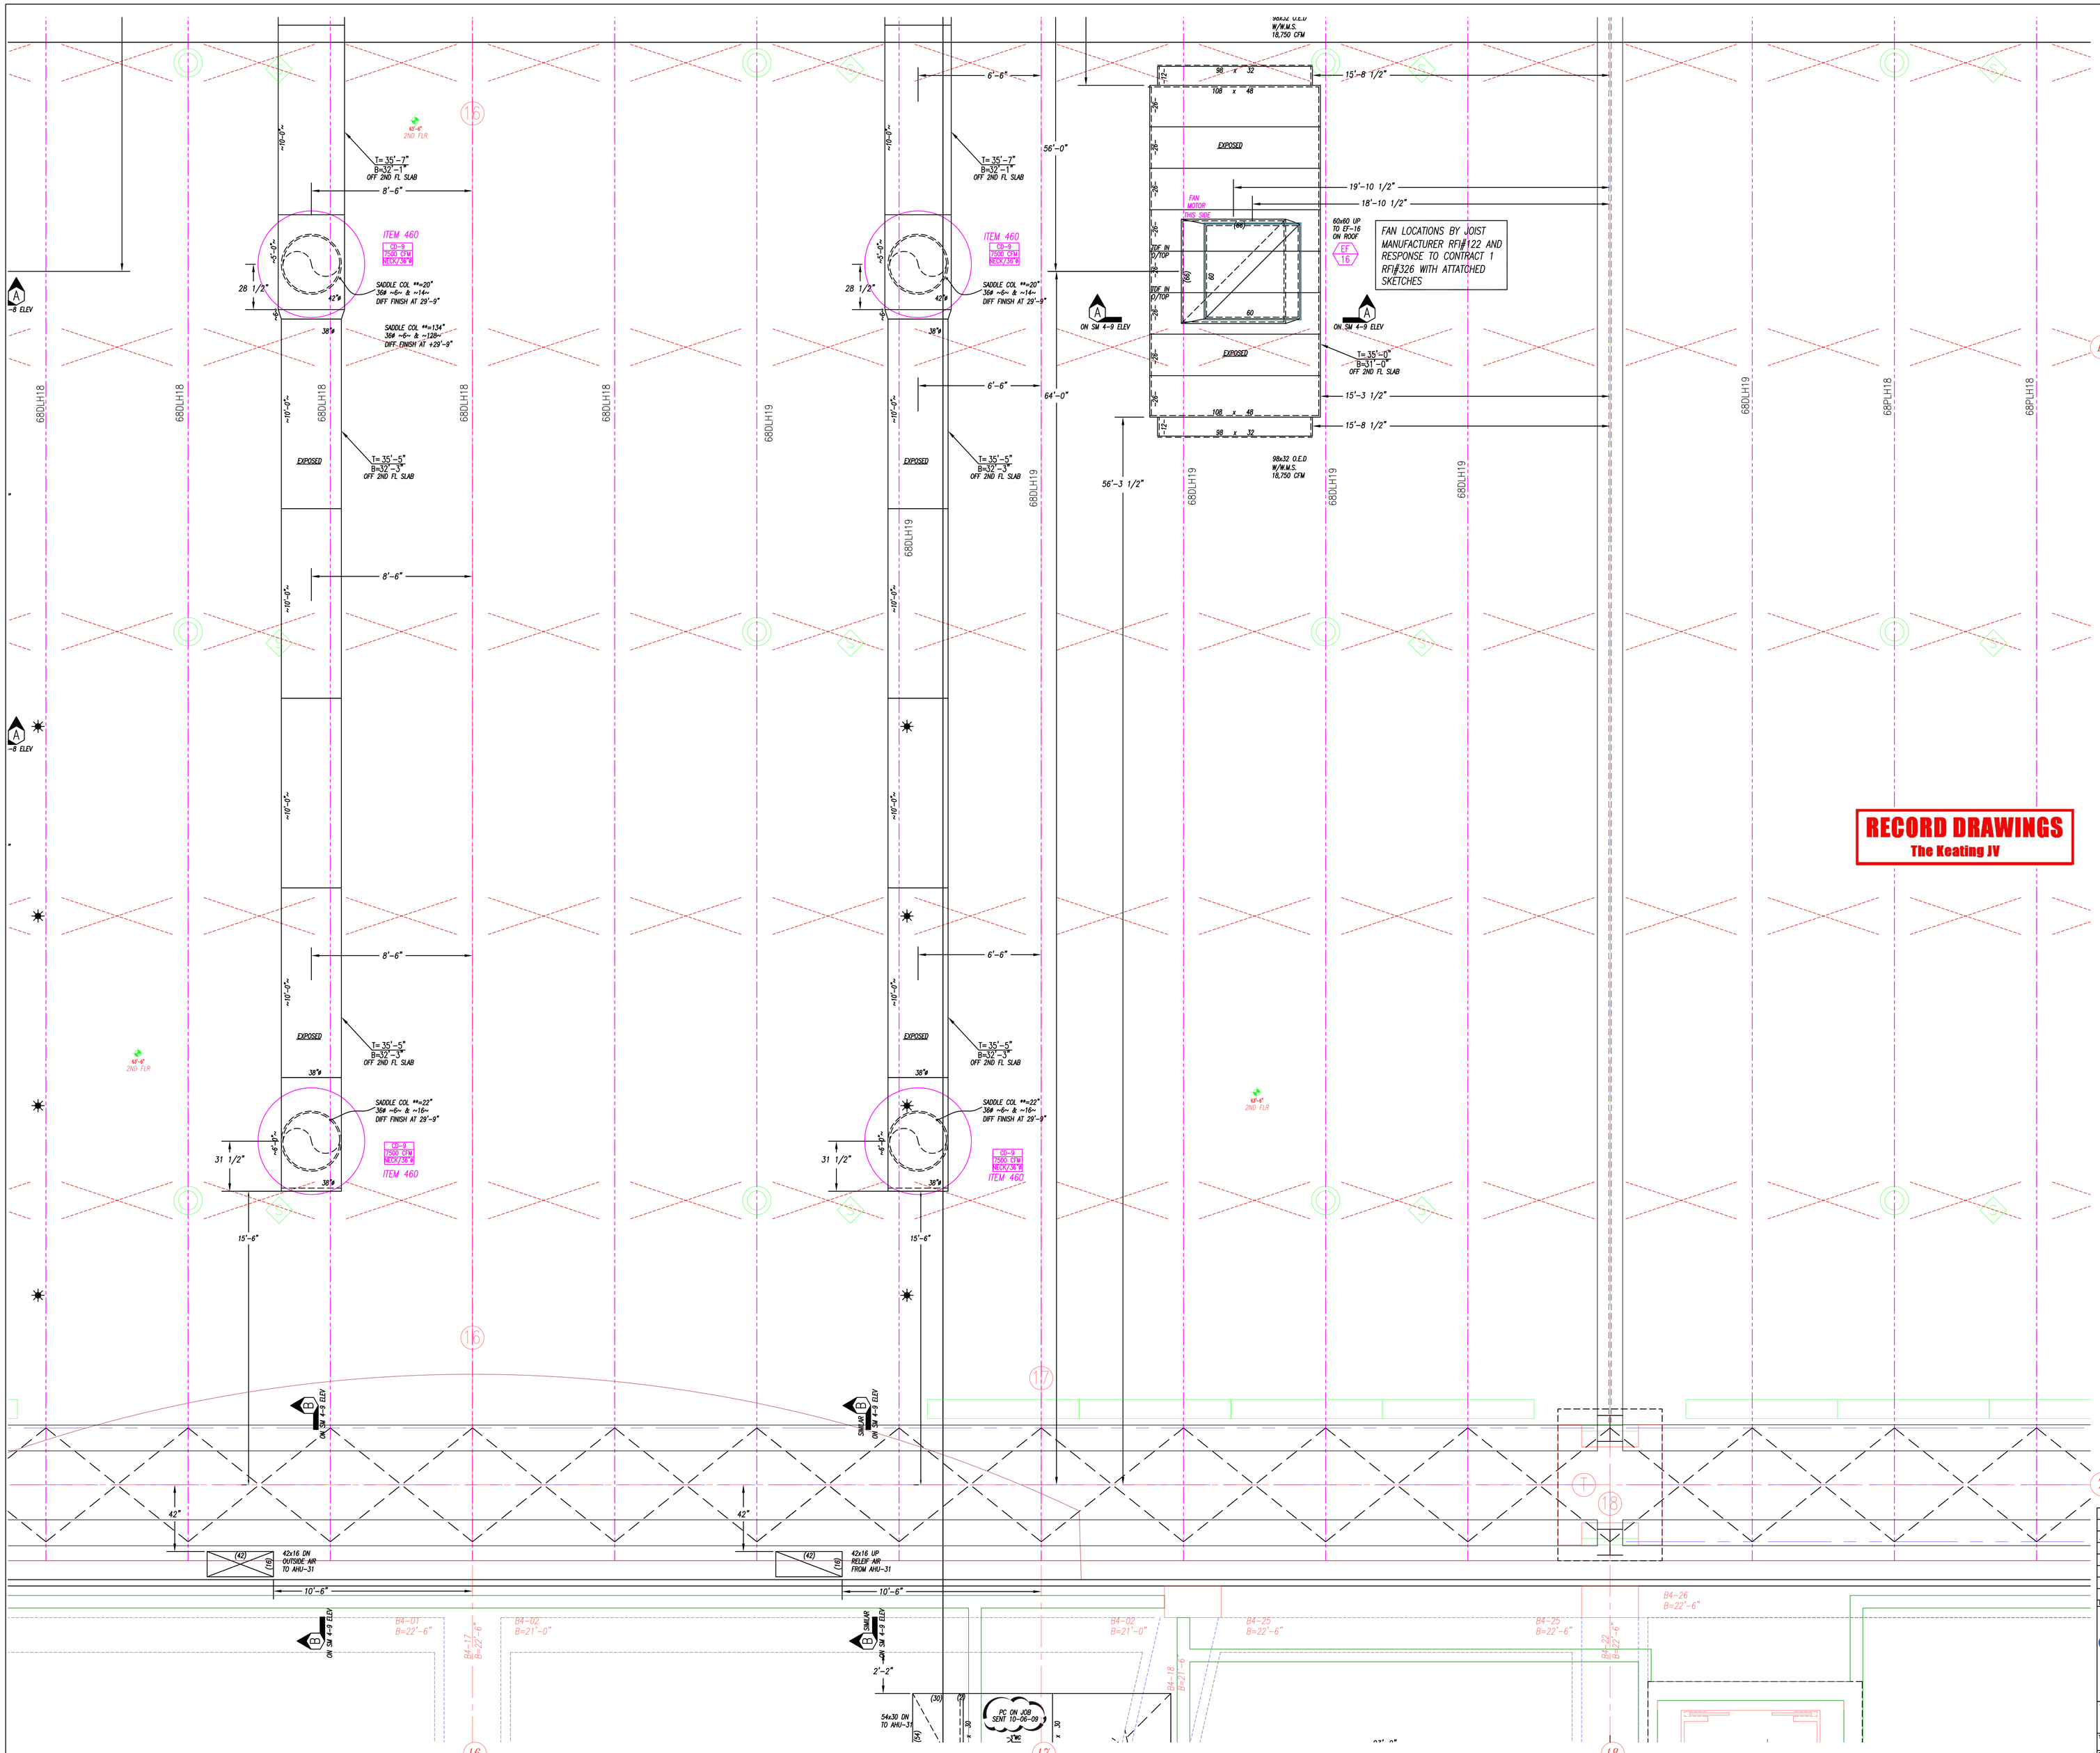

RECORD DRAWINGS
The Keating JV

NOTES:
1. – ALL DUCT TO BE FABRICATED PER SMACNA CONSTRUCTION STANDARDS.
2. – <G> = AIR FLOW – GALV. – NO ACOUST. LINING
3. – <R> = AIR FLOW – 1" ACOUST. LINING
4. – <S> = AIR FLOW – STAINLESS STEEL
5. – <A> = AIR FLOW – ALUMINUM
6. – ▷ = W.G. CONSTRUCTION OF DUCT
7. – T= 0'-0" = TOP OF DUCT ABOVE FINISHED FLOOR; B= 0'-0" = BOTTOM OF DUCT ABOVE FINISHED FLOOR
8. – COORDINATION NOTE – ALLOW 2" ALL AROUND DUCT FOR FLANGE CONNECTIONS AND FOR EXTERNAL INSULATION WHERE REQUIRED.

REV.	DESCRIPTION	DR.	DATE
AB	AS BUILT	EG	01-11-11
R2	REVISED FOR GRDS	EG	01-29-10
R1	REVISED LENGTHS	EG	09-18-09
C	FOR CONSTRUCTION	EG	09-14-09
S	SIGN OFF	EG	09-09-09
A	FOR APPROVAL	BLJ	05-12-09

Advantage CONTRACTING INC.
A Minority Owned Business Enterprise
219 W. Hortter Street • Philadelphia, PA 19119
Phone: 215-844-0191 Fax: 215-844-0192
www.advantagecontracts.com

JOB NAME: PA CONVENTION CENTER EXPANSION AND RENOVATION
TITLE: LEVEL 4 PARTIAL DUCT PLAN

REF DWG-	M-245	LOC. COLS.	AS NOTED
SCALE	3/8"=1'-0"	DR.	JOB NO. 8520
DATE	XX-XX-XX	DR. BLJ	DWG NO. SM 4-9

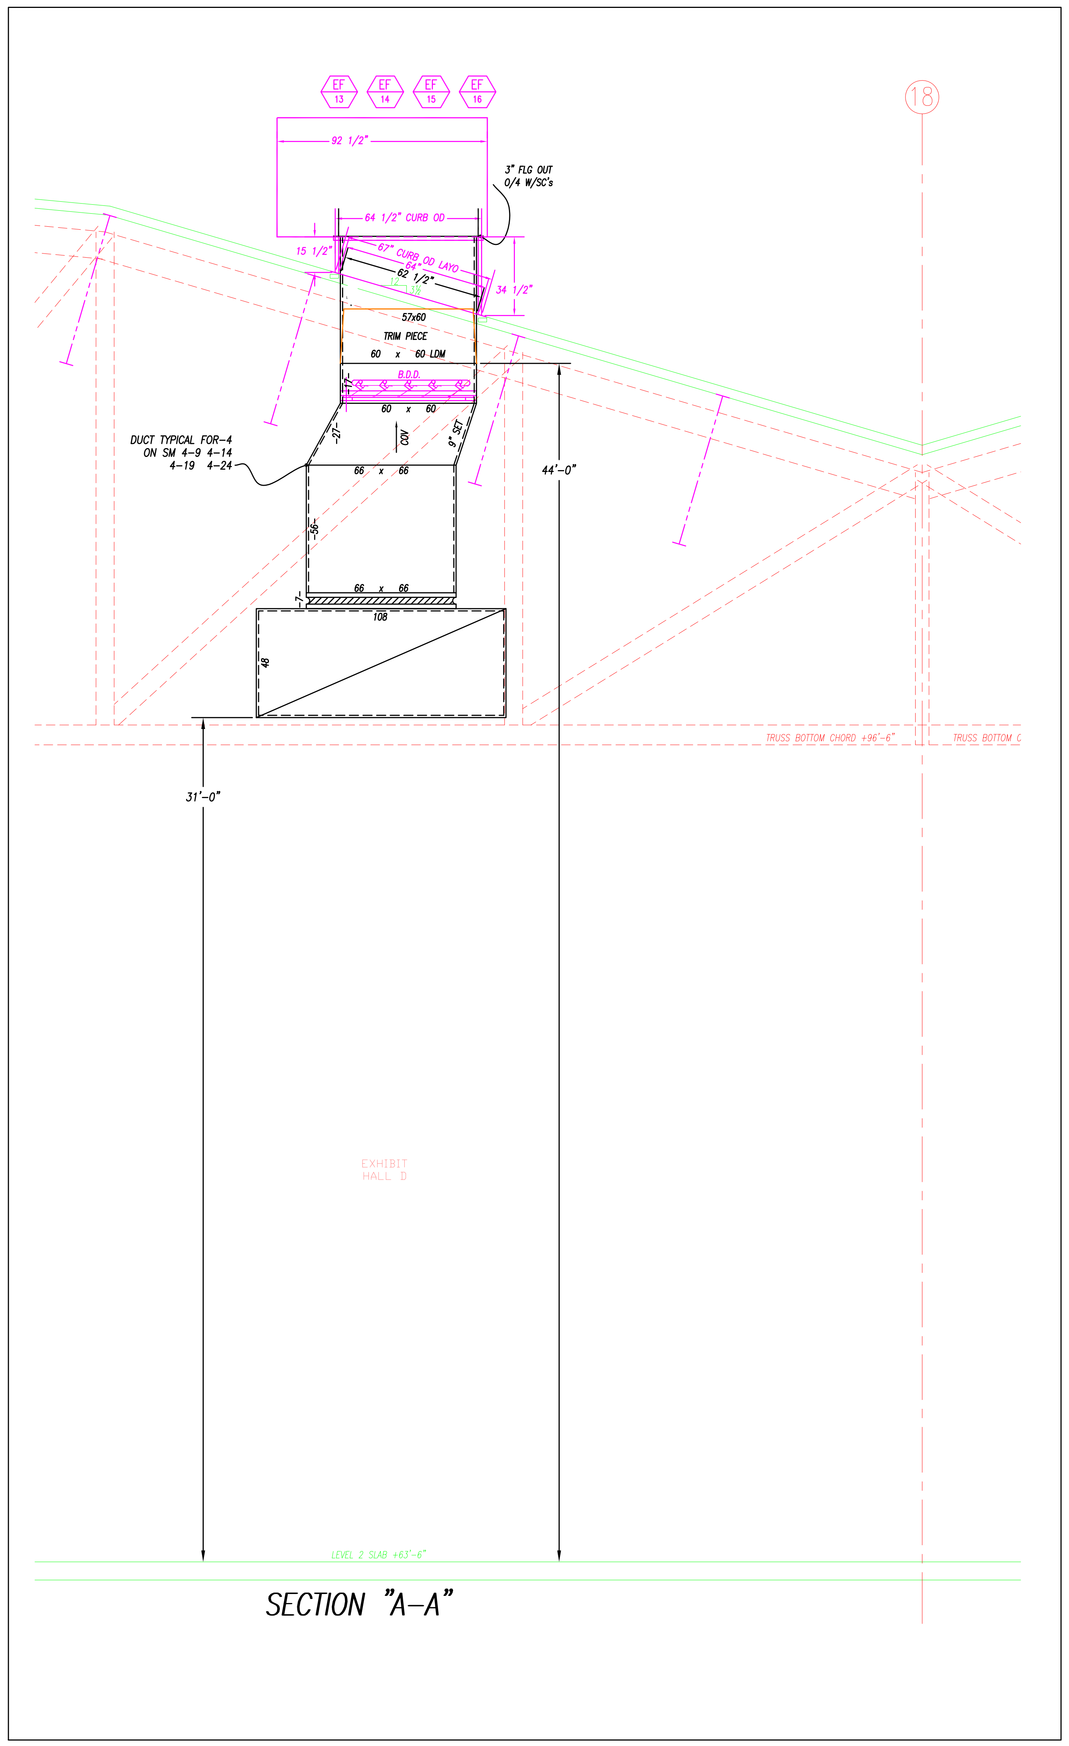

SECTION "A-A"

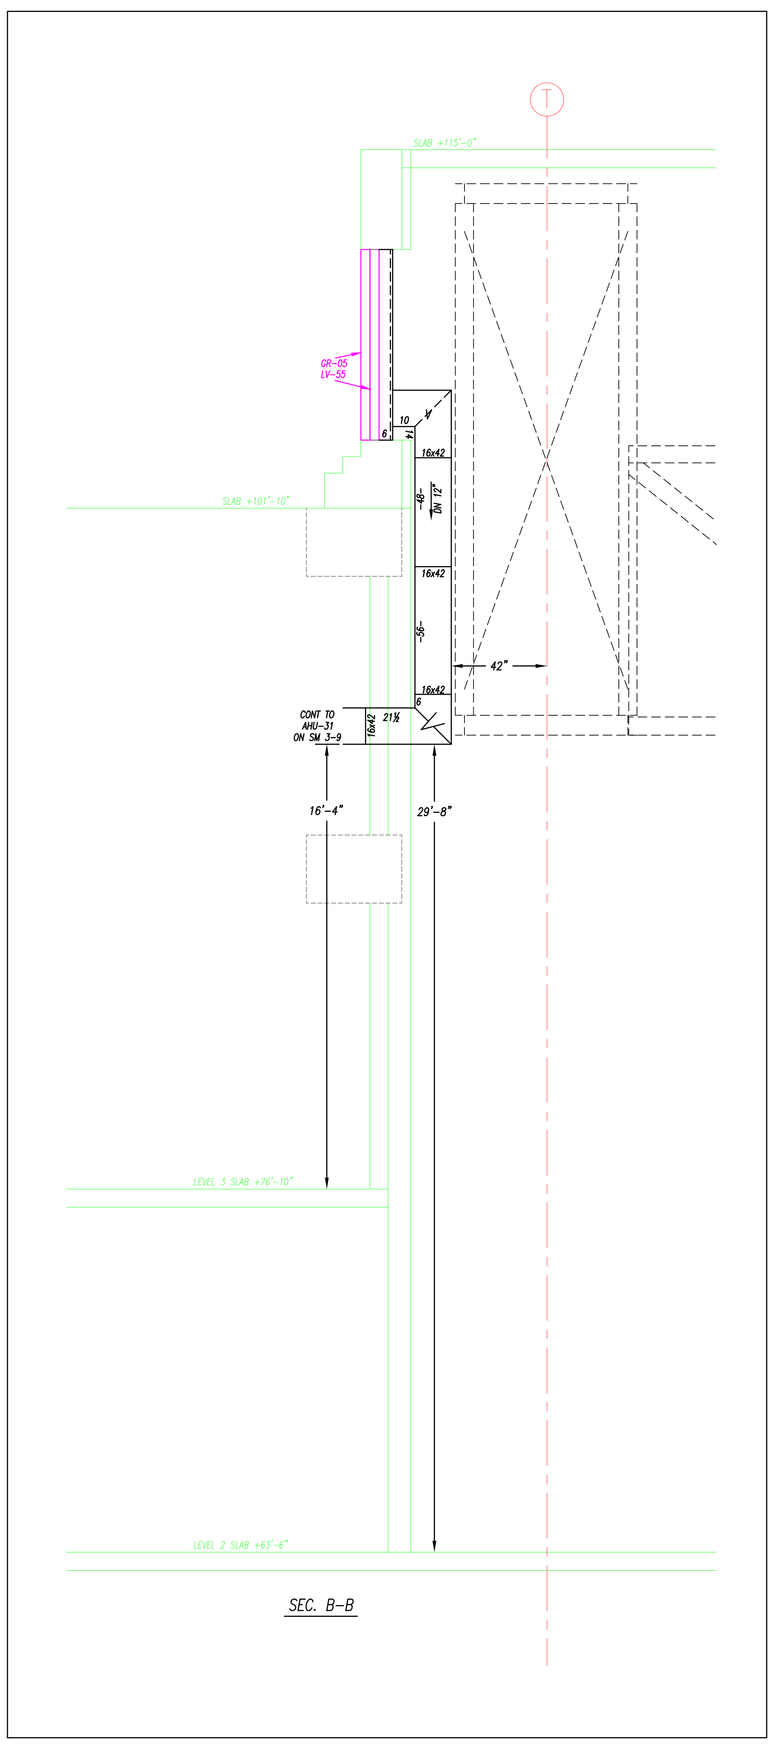

SEC. B-B

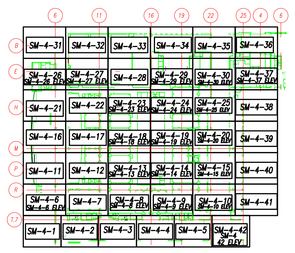

FOURTH FLOOR

RECORD DRAWINGS
The Keating JV

NOTES:

1. - ALL DUCT TO BE FABRICATED PER SMACNA CONSTRUCTION STANDARDS.
2. - <G> = AIR FLOW - GALV. - NO ACOUST. LINING
3. - <FLEX> = AIR FLOW - 1" ACOUST. LINING
4. - <S> SS = AIR FLOW - STAINLESS STEEL
5. - <A> ALUM = AIR FLOW - ALUMINUM
6. - ▷ = W.G. CONSTRUCTION OF DUCT
7. - T= 0'-0 = TOP OF DUCT ABOVE FINISHED FLOOR
   B= 0'-0 = BOTTOM OF DUCT ABOVE FINISHED FLOOR
8. - COORDINATION NOTE - ALLOW 2" ALL AROUND DUCT FOR FLANGE CONNECTIONS AND FOR EXTERNAL INSULATION WHERE REQUIRED.

REV	DESCRIPTION	DR.	DATE
AB	AS BUILT	BLJ	01-11-11
C	FOR CONSTRUCTION	BLJ	09-14-09
A	FOR APPROVAL	BLJ	05-19-09

Advantage CONTRACTING INC.
A Minority Owned Business Enterprise
219 W. Hortter Street • Philadelphia, PA 19119
Phone: 215-844-0191 Fax: 215-844-0192
www.advantagecontracts.com

JOB NAME: PA CONVENTION CENTER
EXPANSION AND RENOVATION

TITLE: LEVEL 4 DUCT ELEVATIONS

REF.DWG.- SM 4-9	LOC. COLS. AS NOTED		
SCALE 3/8"=1'-0"	CH.	JOB NO.	8520
DATE XX-XX-XX	DR. BLJ	DWG. NO.	SM 4-9 ELEV

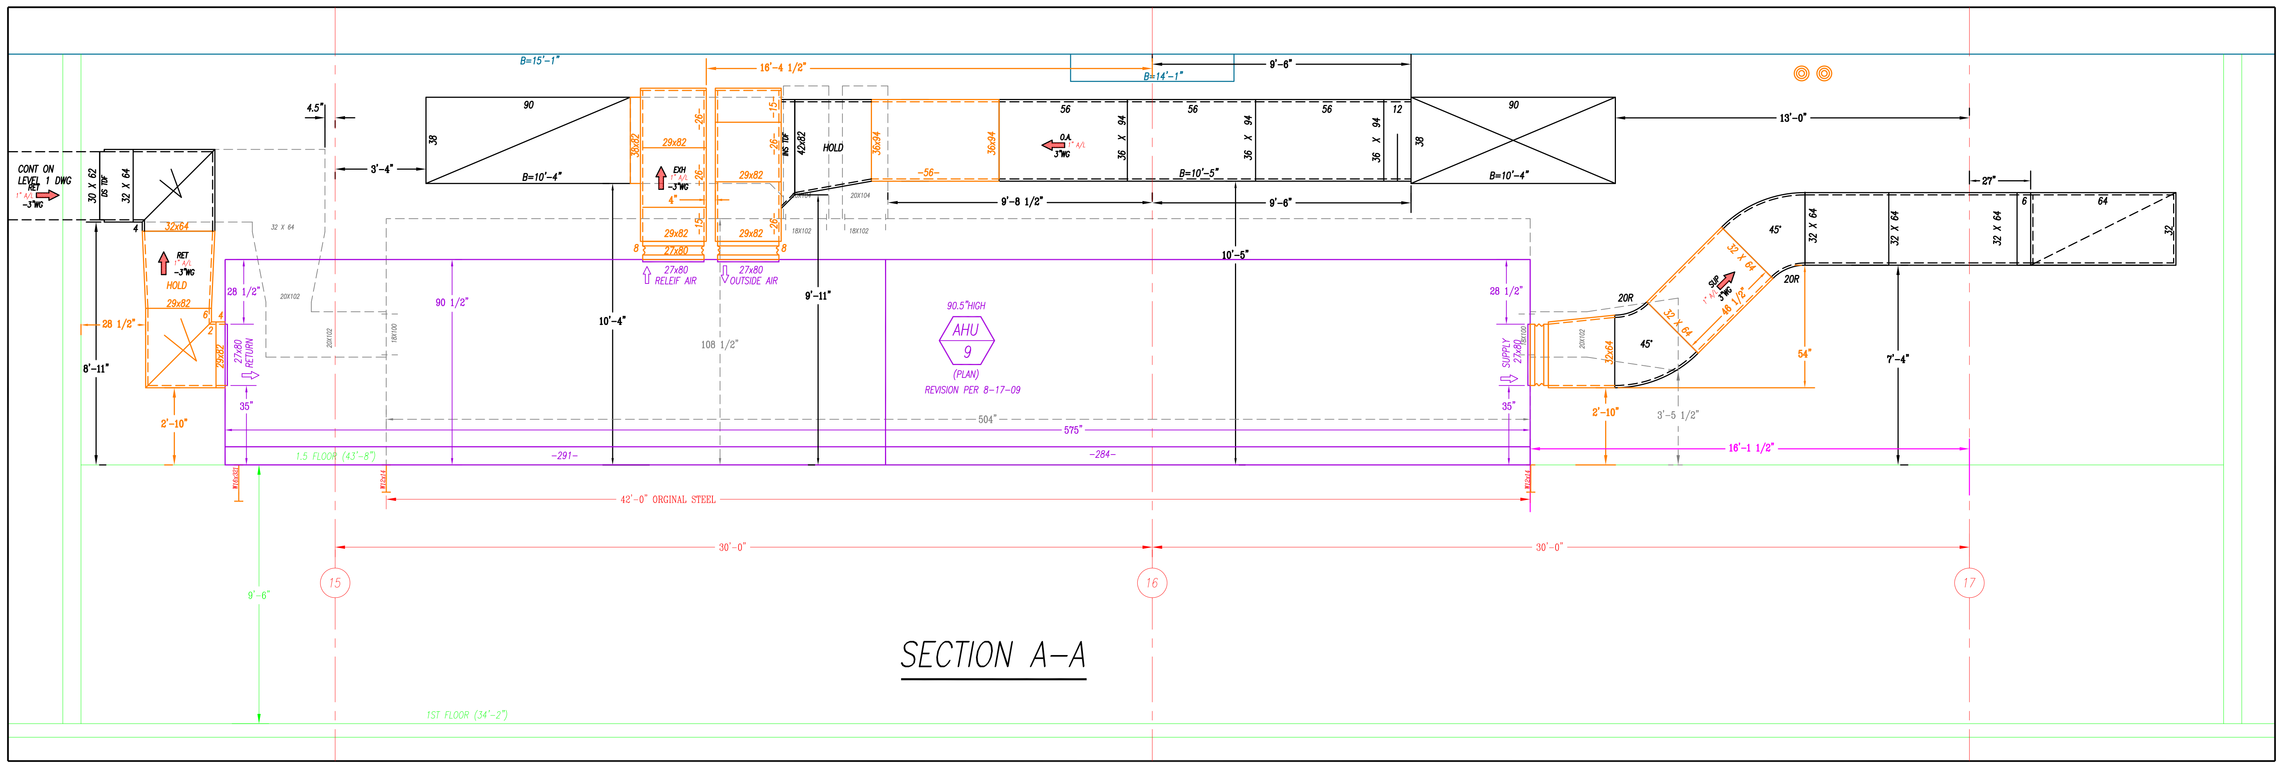

SECTION A-A

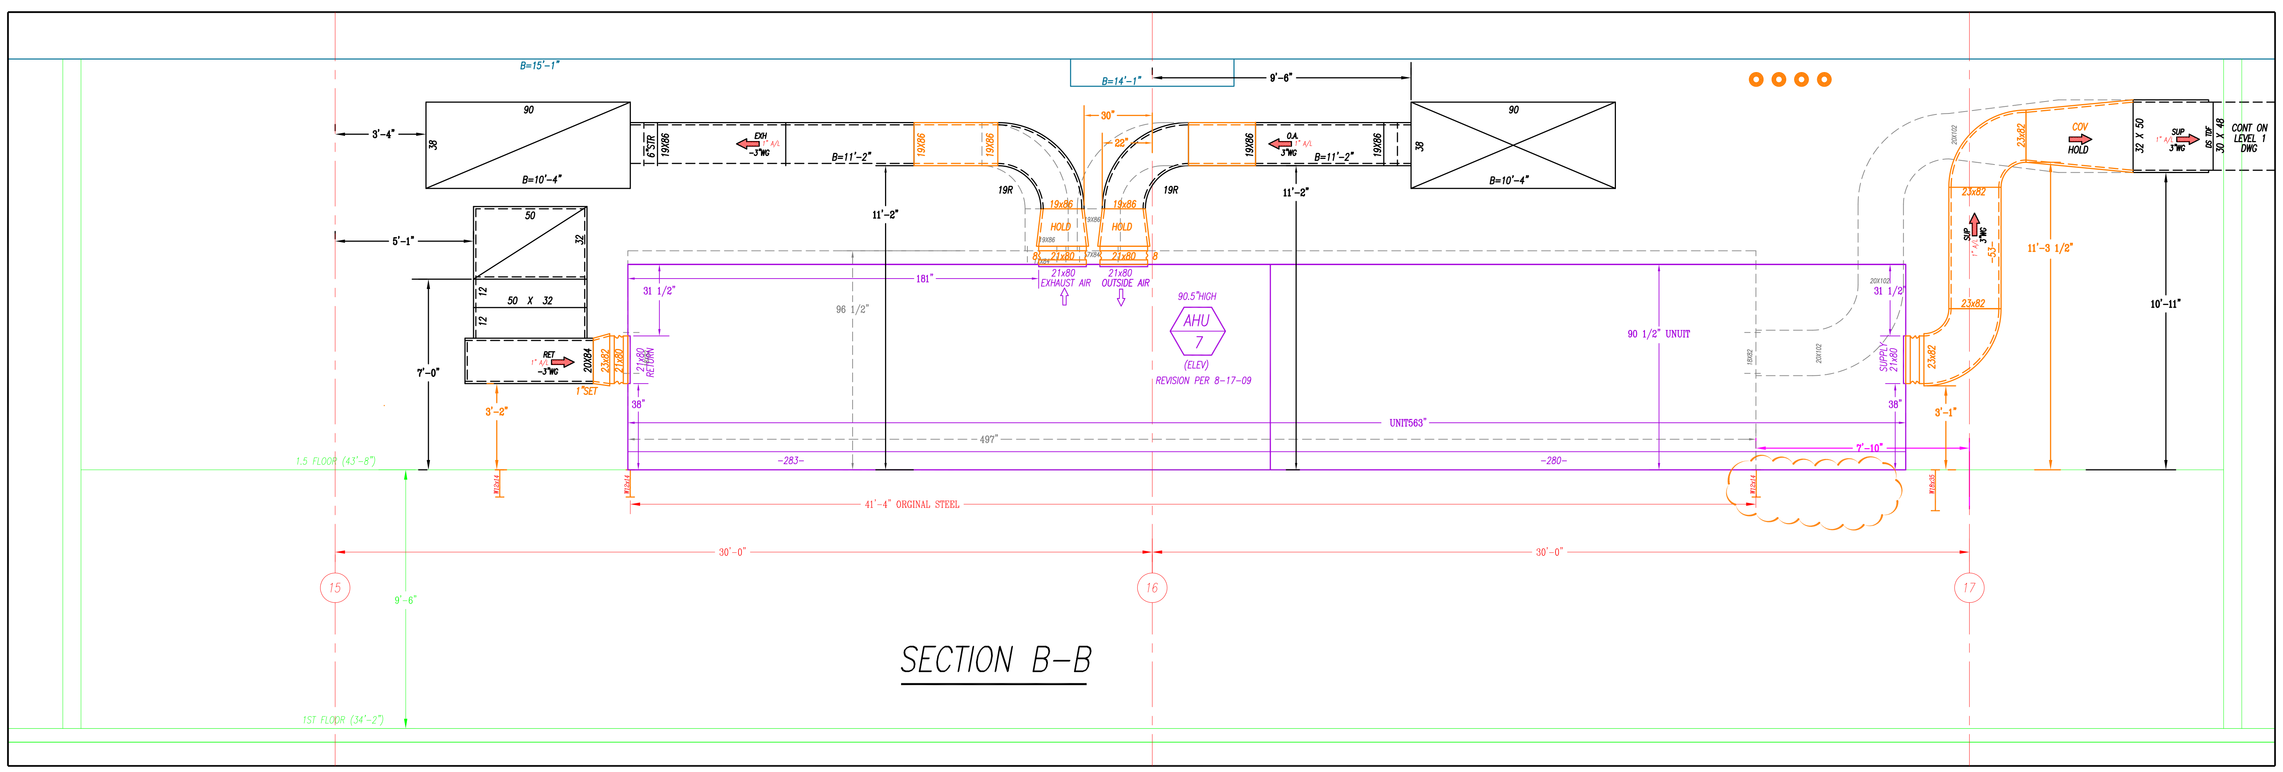

SECTION B-B

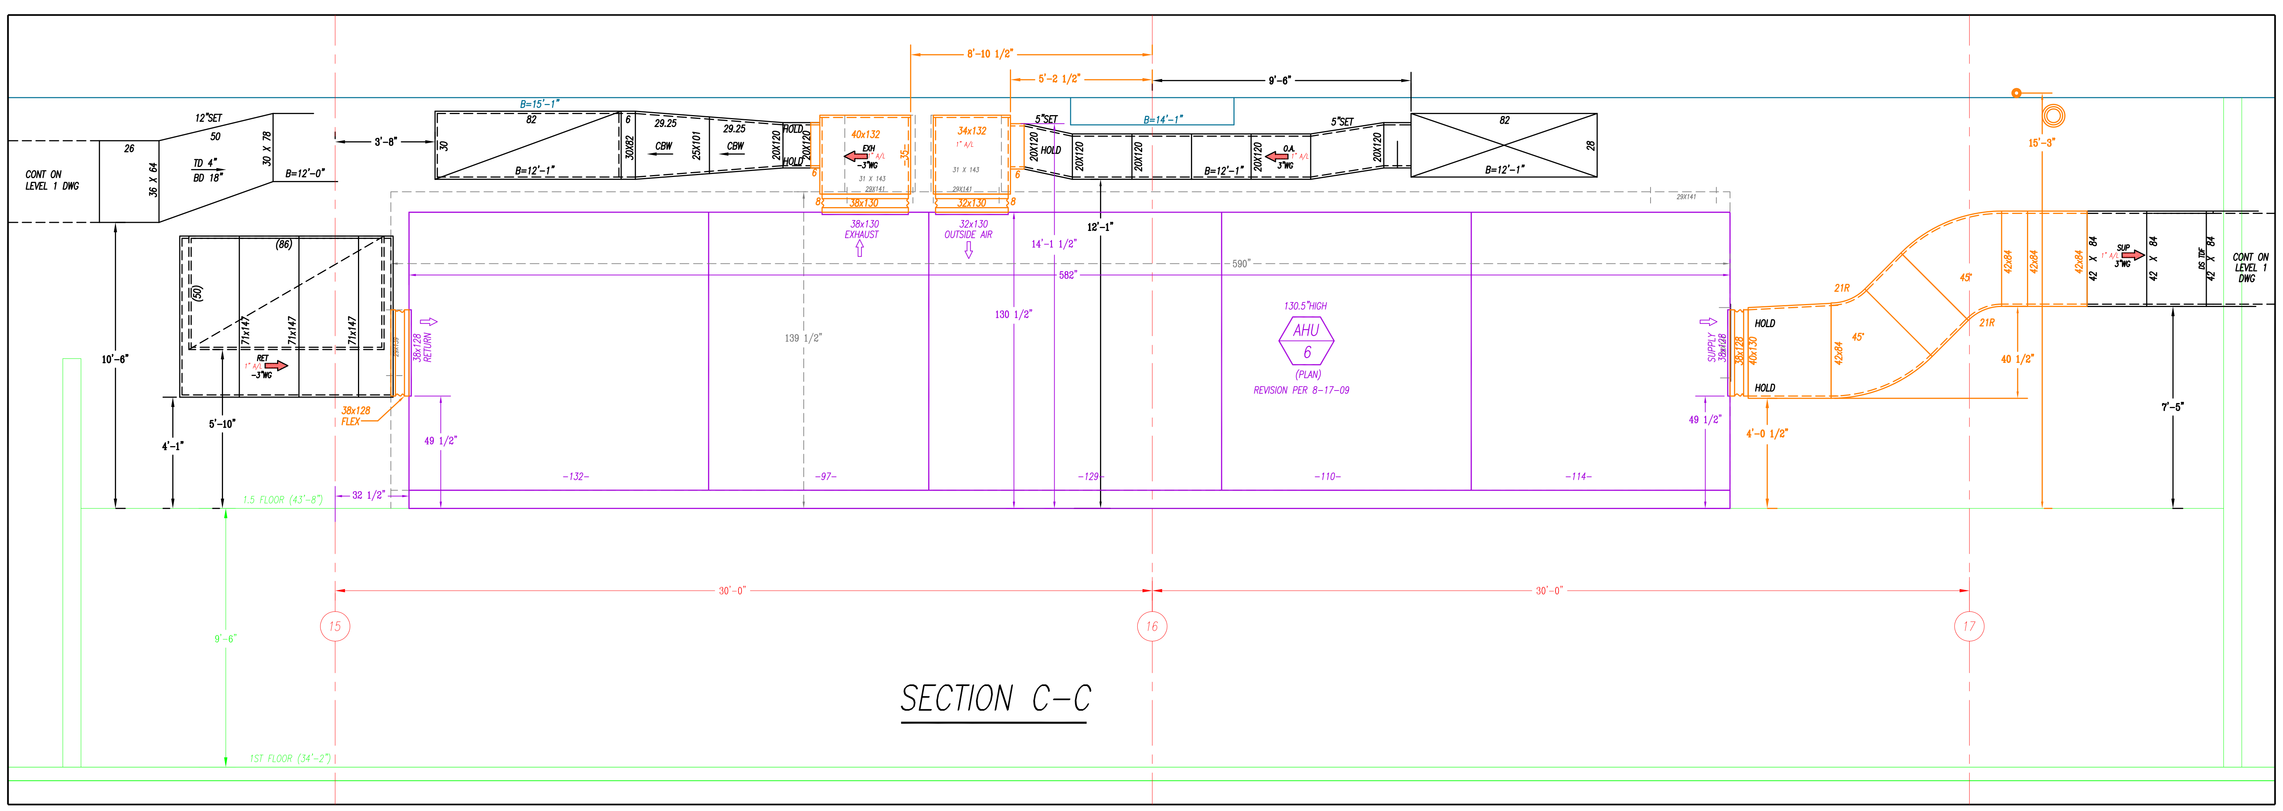

SECTION C-C

RECORD DRAWINGS
The Keating JV

NOTES:

1. – ALL DUCT TO BE FABRICATED PER SMACNA CONSTRUCTION STANDARDS.
2. – ⊏⊐ = AIR FLOW – GALV. – NO ACOUST. LINING
3. – ⊏A⊐ = AIR FLOW –1" ACOUST. LINING
4. – ⊏SS⊐ = AIR FLOW – STAINLESS STEEL
5. – ⊏AL⊐ = AIR FLOW – ALUMINUM
6. – ▷ = W.G. CONSTRUCTION OF DUCT
7. – 1x 0'-0" = TOP OF DUCT ABOVE FINISHED FLOOR; 3x 0'-0" = BOTTOM OF DUCT ABOVE FINISHED FLOOR
8. – COORDINATION NOTE – ALLOW 2" ALL AROUND DUCT FOR FLANGE CONNECTIONS AND FOR EXTERNAL INSULATION WHERE REQUIRED.

NO.	DESCRIPTION	BY	DATE
AB	AS BUILT	EG	08-27-09
R1	REVISED FOR UNIT CHANGES	EG	08-27-09
C	FOR CONSTRUCTION	MVO	04-07-09
A	FOR APPROVAL	MVO	03-11-09

Advantage CONTRACTING INC.
A Minority Owned Business Enterprise
219 W. Hortter Street • Philadelphia, PA 19119
Phone: 215-844-0191 Fax: 215-844-0192
www.advantagecontracts.com

JOB NAME: PA CONVENTION CENTER
EXPANSION AND RENOVATION

TITLE: SECTIONS FROM AHU'S 6, 7 & 9

REF.DWG.-
LOC. COLS.
SCALE 3/8"=1'-0" CH.
JOB NO. 8520
DATE 02-04-09 DR. M. ONORATO
DWG. NO. SM-1.5 SECT A

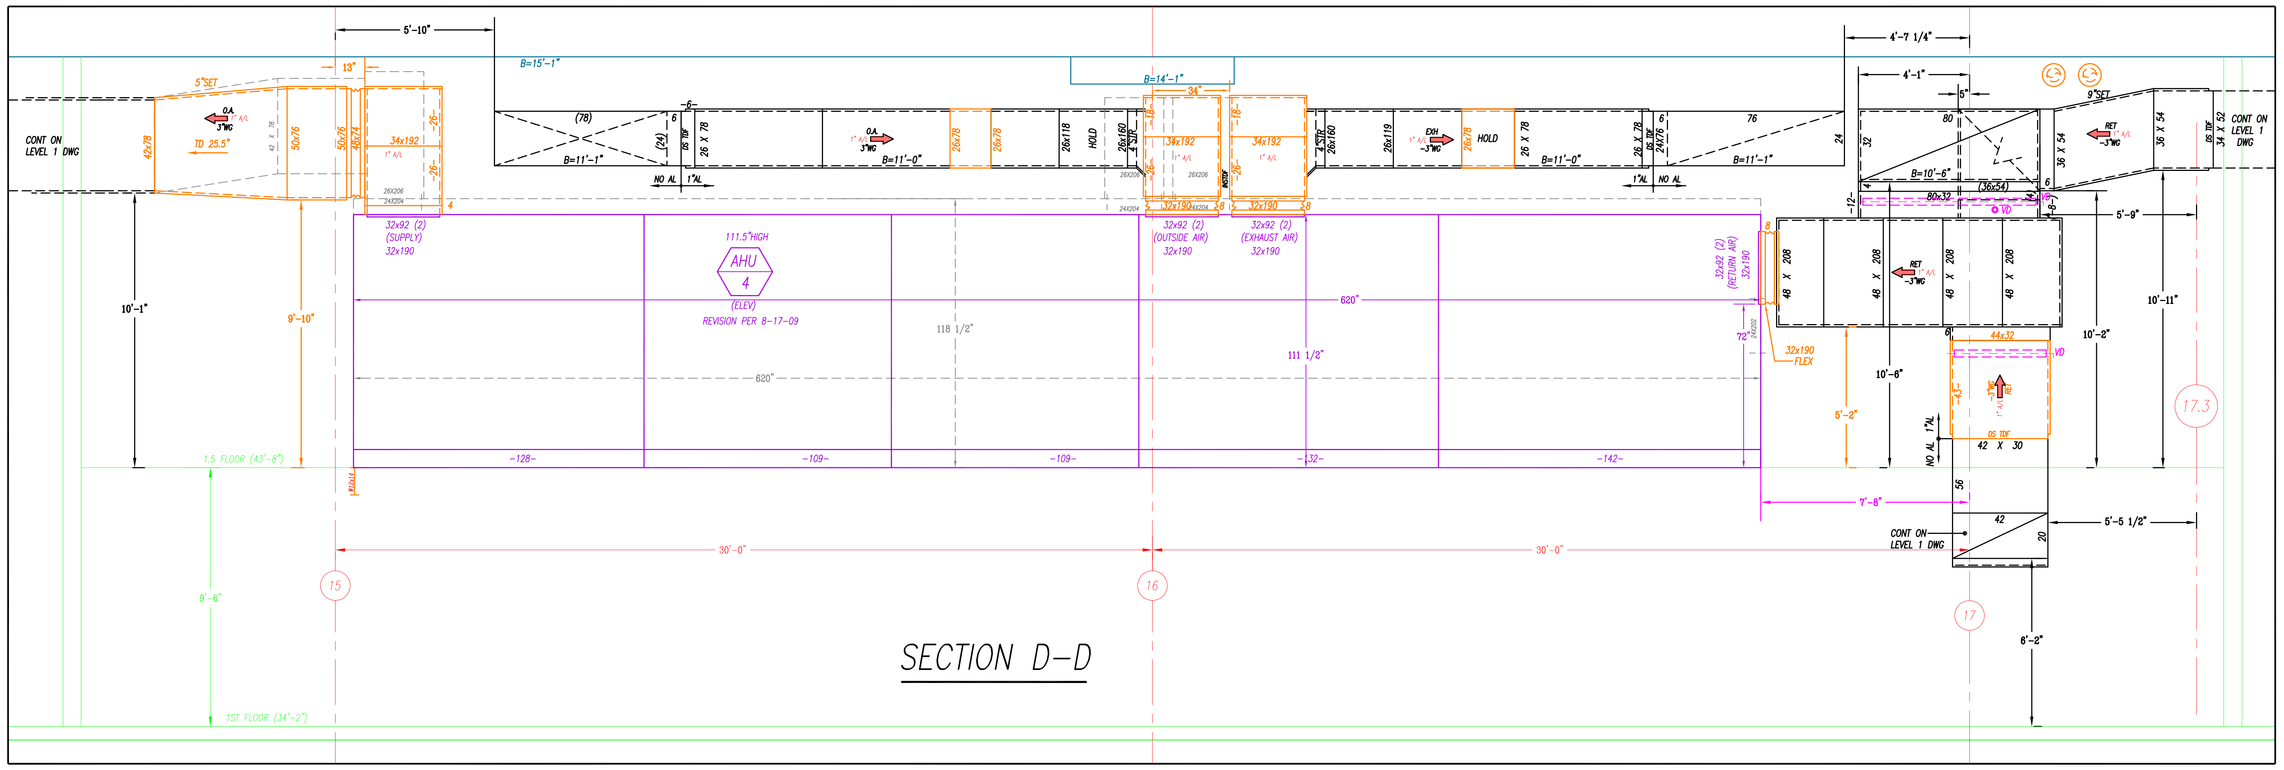

SECTION D–D

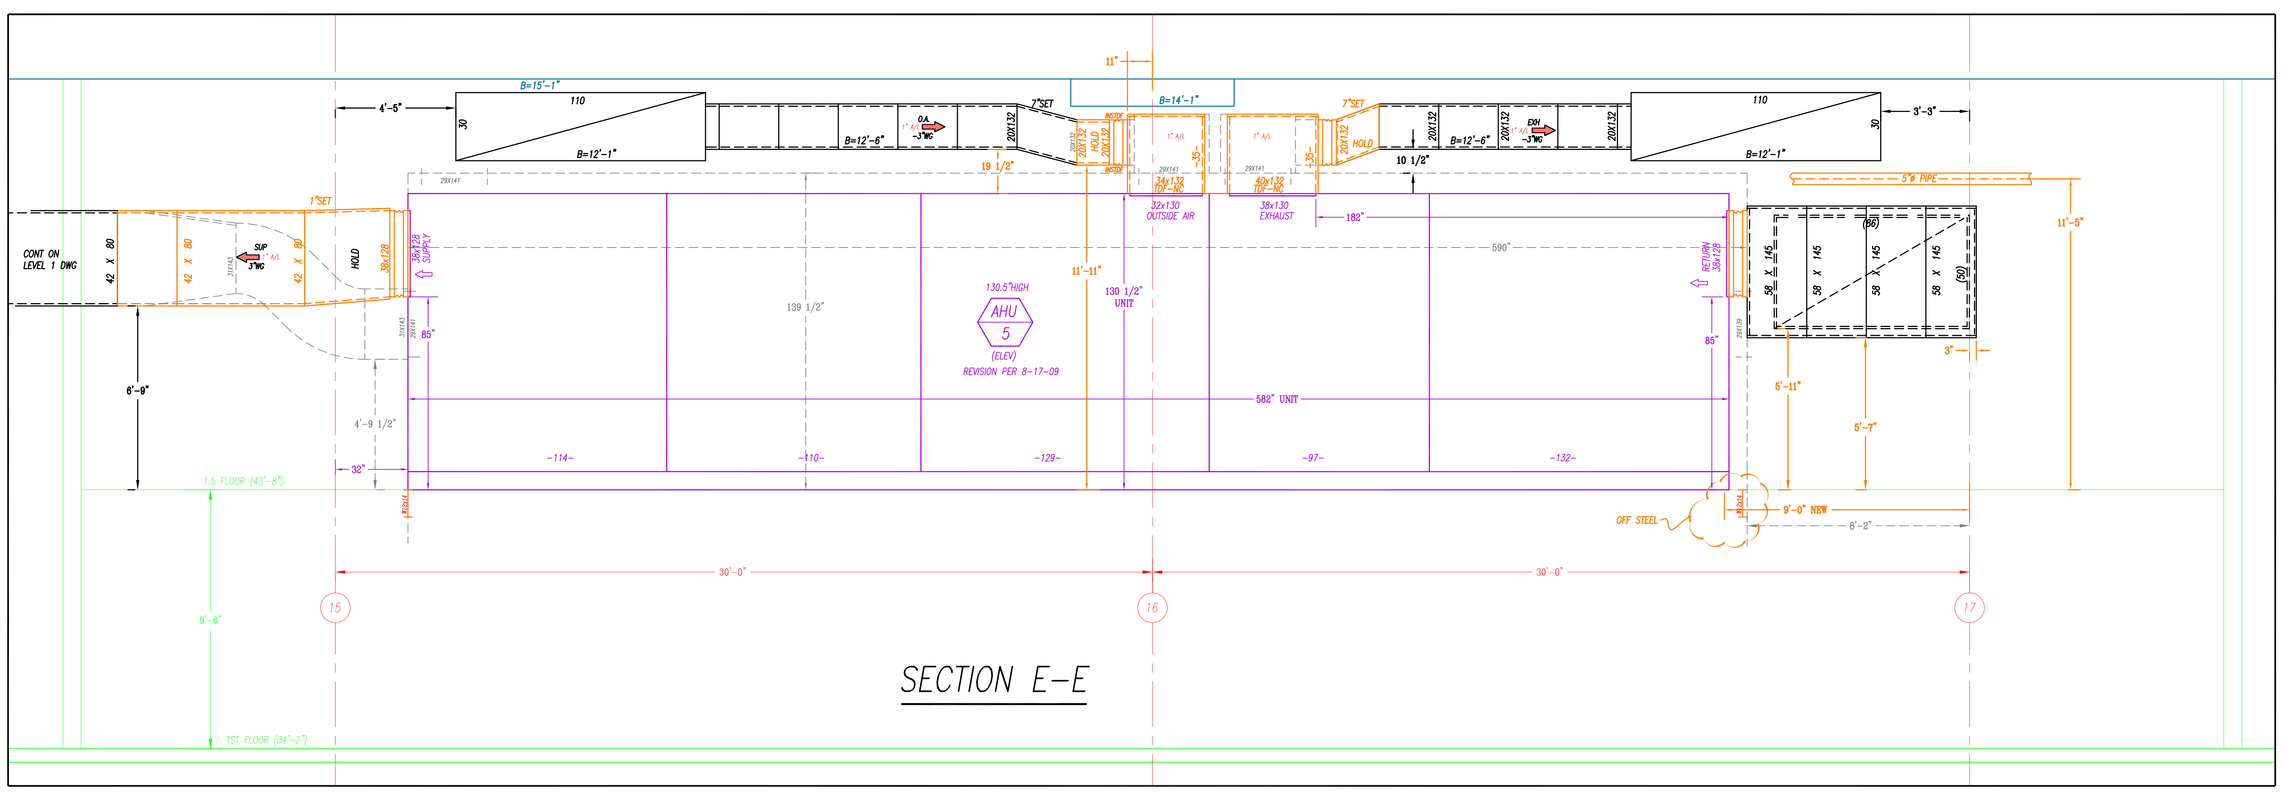

SECTION E–E

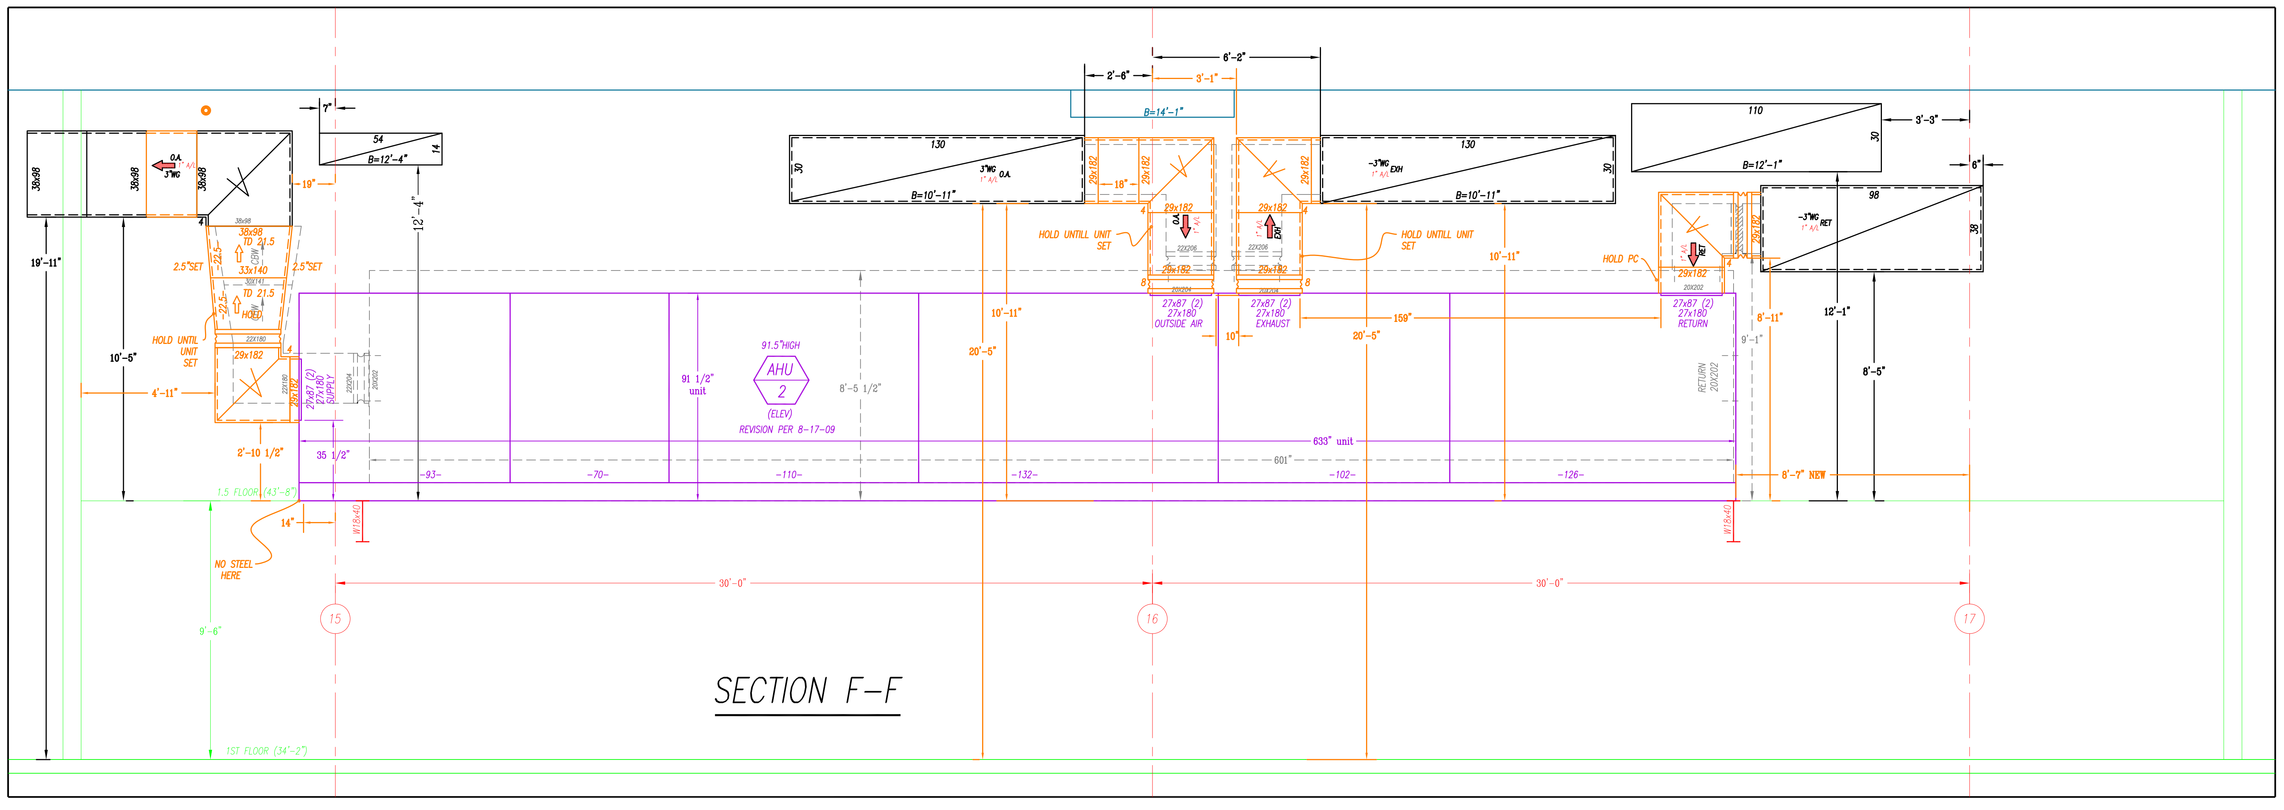

SECTION F–F

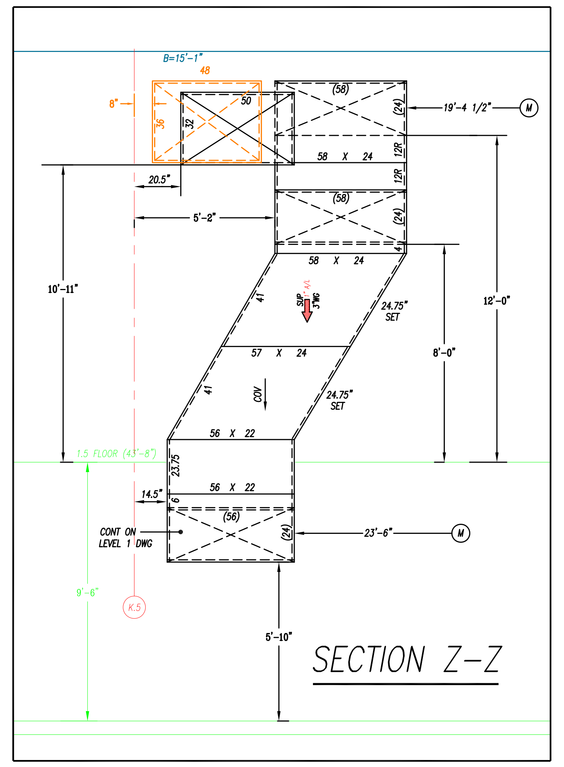

SECTION Z–Z

RECORD DRAWINGS
The Keating JV

NOTES:

1. – ALL DUCT TO BE FABRICATED PER SMACNA CONSTRUCTION STANDARDS.
2. – ⇐⇒ = AIR FLOW – GALV. – NO ACOUST. LINING
3. – ⇐⇒ = AIR FLOW –1" ACOUST. LINING
4. – ⇐⇒ = AIR FLOW – STAINLESS STEEL
5. – ⇐⇒ = AIR FLOW – ALUMINUM
6. – ▷ = W.G. CONSTRUCTION OF DUCT.
7. – 1x 0'-0" = TOP OF DUCT ABOVE FINISHED FLOOR; B= 0'-0" = BOTTOM OF DUCT ABOVE FINISHED FLOOR
8. – COORDINATION NOTE – ALLOW 2" ALL AROUND DUCT FOR FLANGE CONNECTIONS AND FOR EXTERNAL INSULATION WHERE REQUIRED.

REV.	DESCRIPTION	DR.	DATE
AB	AS BUILT	EG	01-11-11
R1	REVISED FOR UNIT CHANGES	EG	08-07-09
C	FOR CONSTRUCTION	MVO	04-07-09
A	FOR APPROVAL	MVO	03-11-09

Advantage CONTRACTING INC.
A Minority Owned Business Enterprise
219 W. Hortter Street • Philadelphia, PA 19119
Phone: 215-844-0191 Fax: 215-844-0192
www.advantagecontracts.com

JOB NAME: PA CONVENTION CENTER EXPANSION AND RENOVATION

TITLE: SECTIONS FROM AHU'S 2, 4 & 5

KEY DWG:	LOC. COLS.
SCALE: 3/8"=1'-0"	DA.
DATE: 02-04-09	DR. M. ONORATO
JOB NO.	8520
DWG. NO.	SM-1.5 SECT B

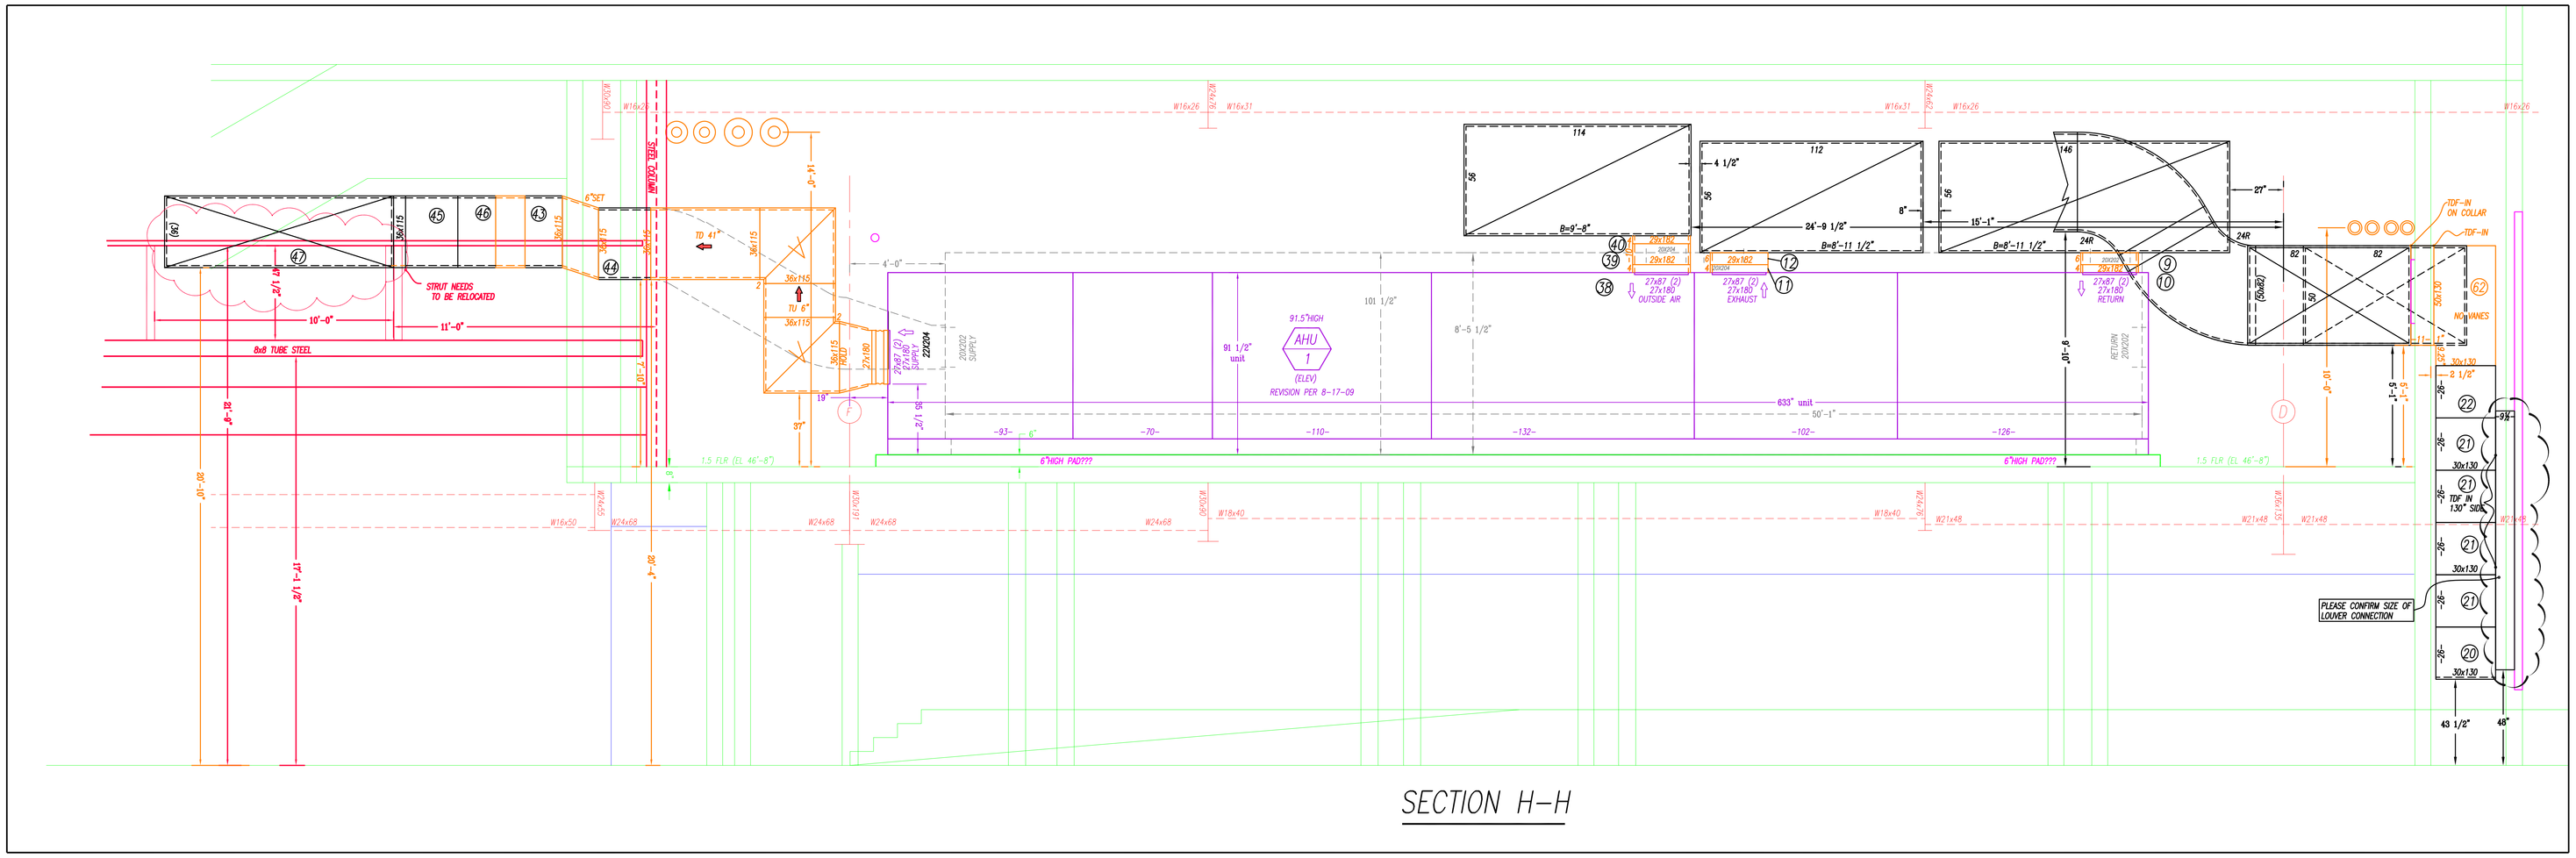

SECTION H–H

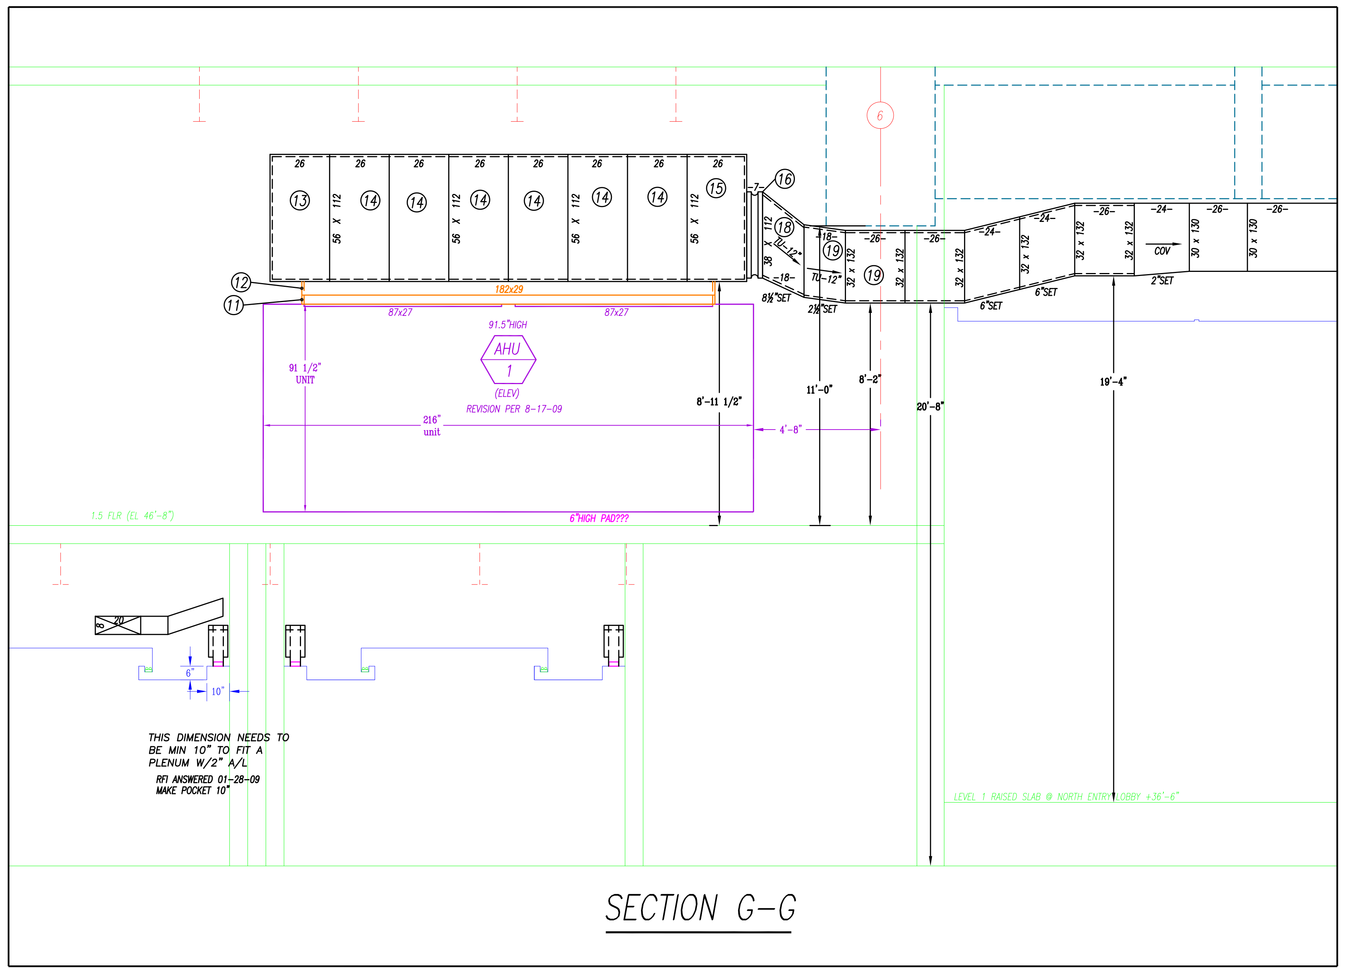

SECTION G–G

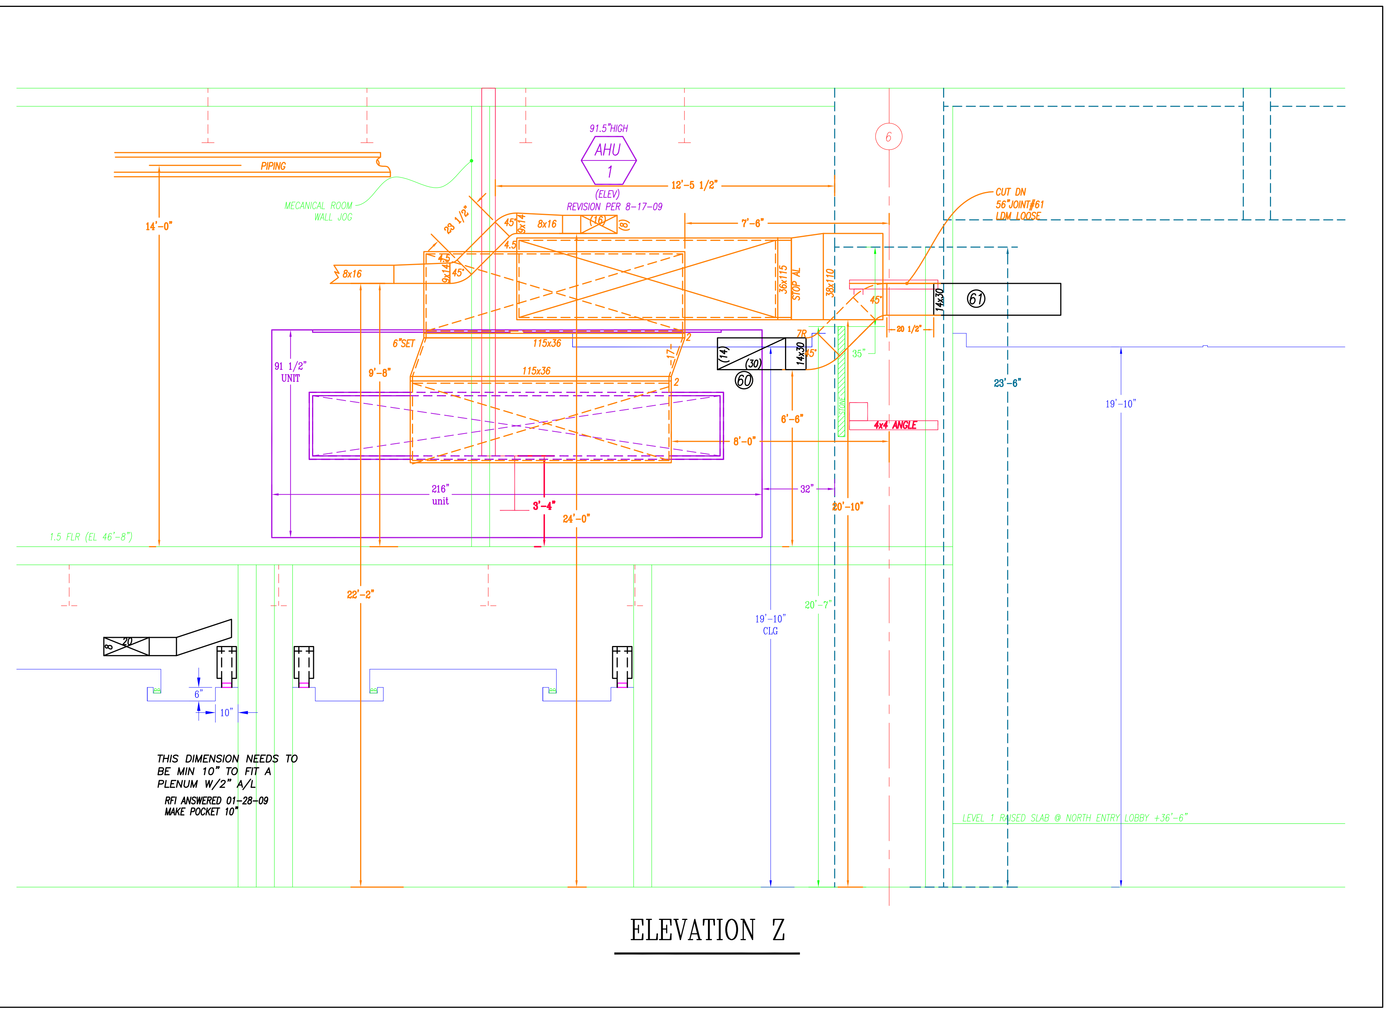

ELEVATION Z

RECORD DRAWINGS
The Keating JV

NOTES:

1. – ALL DUCT TO BE FABRICATED PER SMACNA CONSTRUCTION STANDARDS.
2. – ⇨ = AIR FLOW – GALV. – NO ACOUST. LINING
3. – ⇨ = AIR FLOW –1" ACOUST. LINING
4. – ⇨ = AIR FLOW – STAINLESS STEEL
5. – ⇨ = AIR FLOW – ALUMINUM
6. – ▷ = W.G. CONSTRUCTION OF DUCT
7. – 7= 0'-0 = TOP OF DUCT ABOVE FINISHED FLOOR; 9= 0'-0 = BOTTOM OF DUCT ABOVE FINISHED FLOOR
8. – COORDINATION NOTE – ALLOW 2" ALL AROUND DUCT FOR FLANGE CONNECTIONS AND FOR EXTERNAL INSULATION WHERE REQUIRED.

REV'd	DESCRIPTION	DR.	DATE
AB	AS BUILT	EG	01-11-11
R3	REVISED FOR WALL AND STEEL	EG	04-19-10
R2	REVISED FOR WALL OPNG	EG	01-28-10
C	FOR CONSTRUCTION	EG	10-19-09
R1	REVISED UNITS	BLJ	08-28-09
A	FOR APPROVAL	BLJ	03-11-09

Advantage CONTRACTING INC.
A Minority Owned Business Enterprise
219 W. Hortter Street • Philadelphia, PA 19119
Phone: 215-844-0191 Fax: 215-844-0192
www.advantagecontracts.com

JOB NAME: PA CONVENTION CENTER
EXPANSION AND RENOVATION

TITLE: SECTIONS FROM AHU'S 1

REF.DWG-	SM 1.5-26	LOC. COLS.	
SCALE	3/8"=1'-0"	CH.	JOB NO. 8520
DATE	02-04-09	DR. B. JONES	DWG. NO. SM-1.5 SECT C

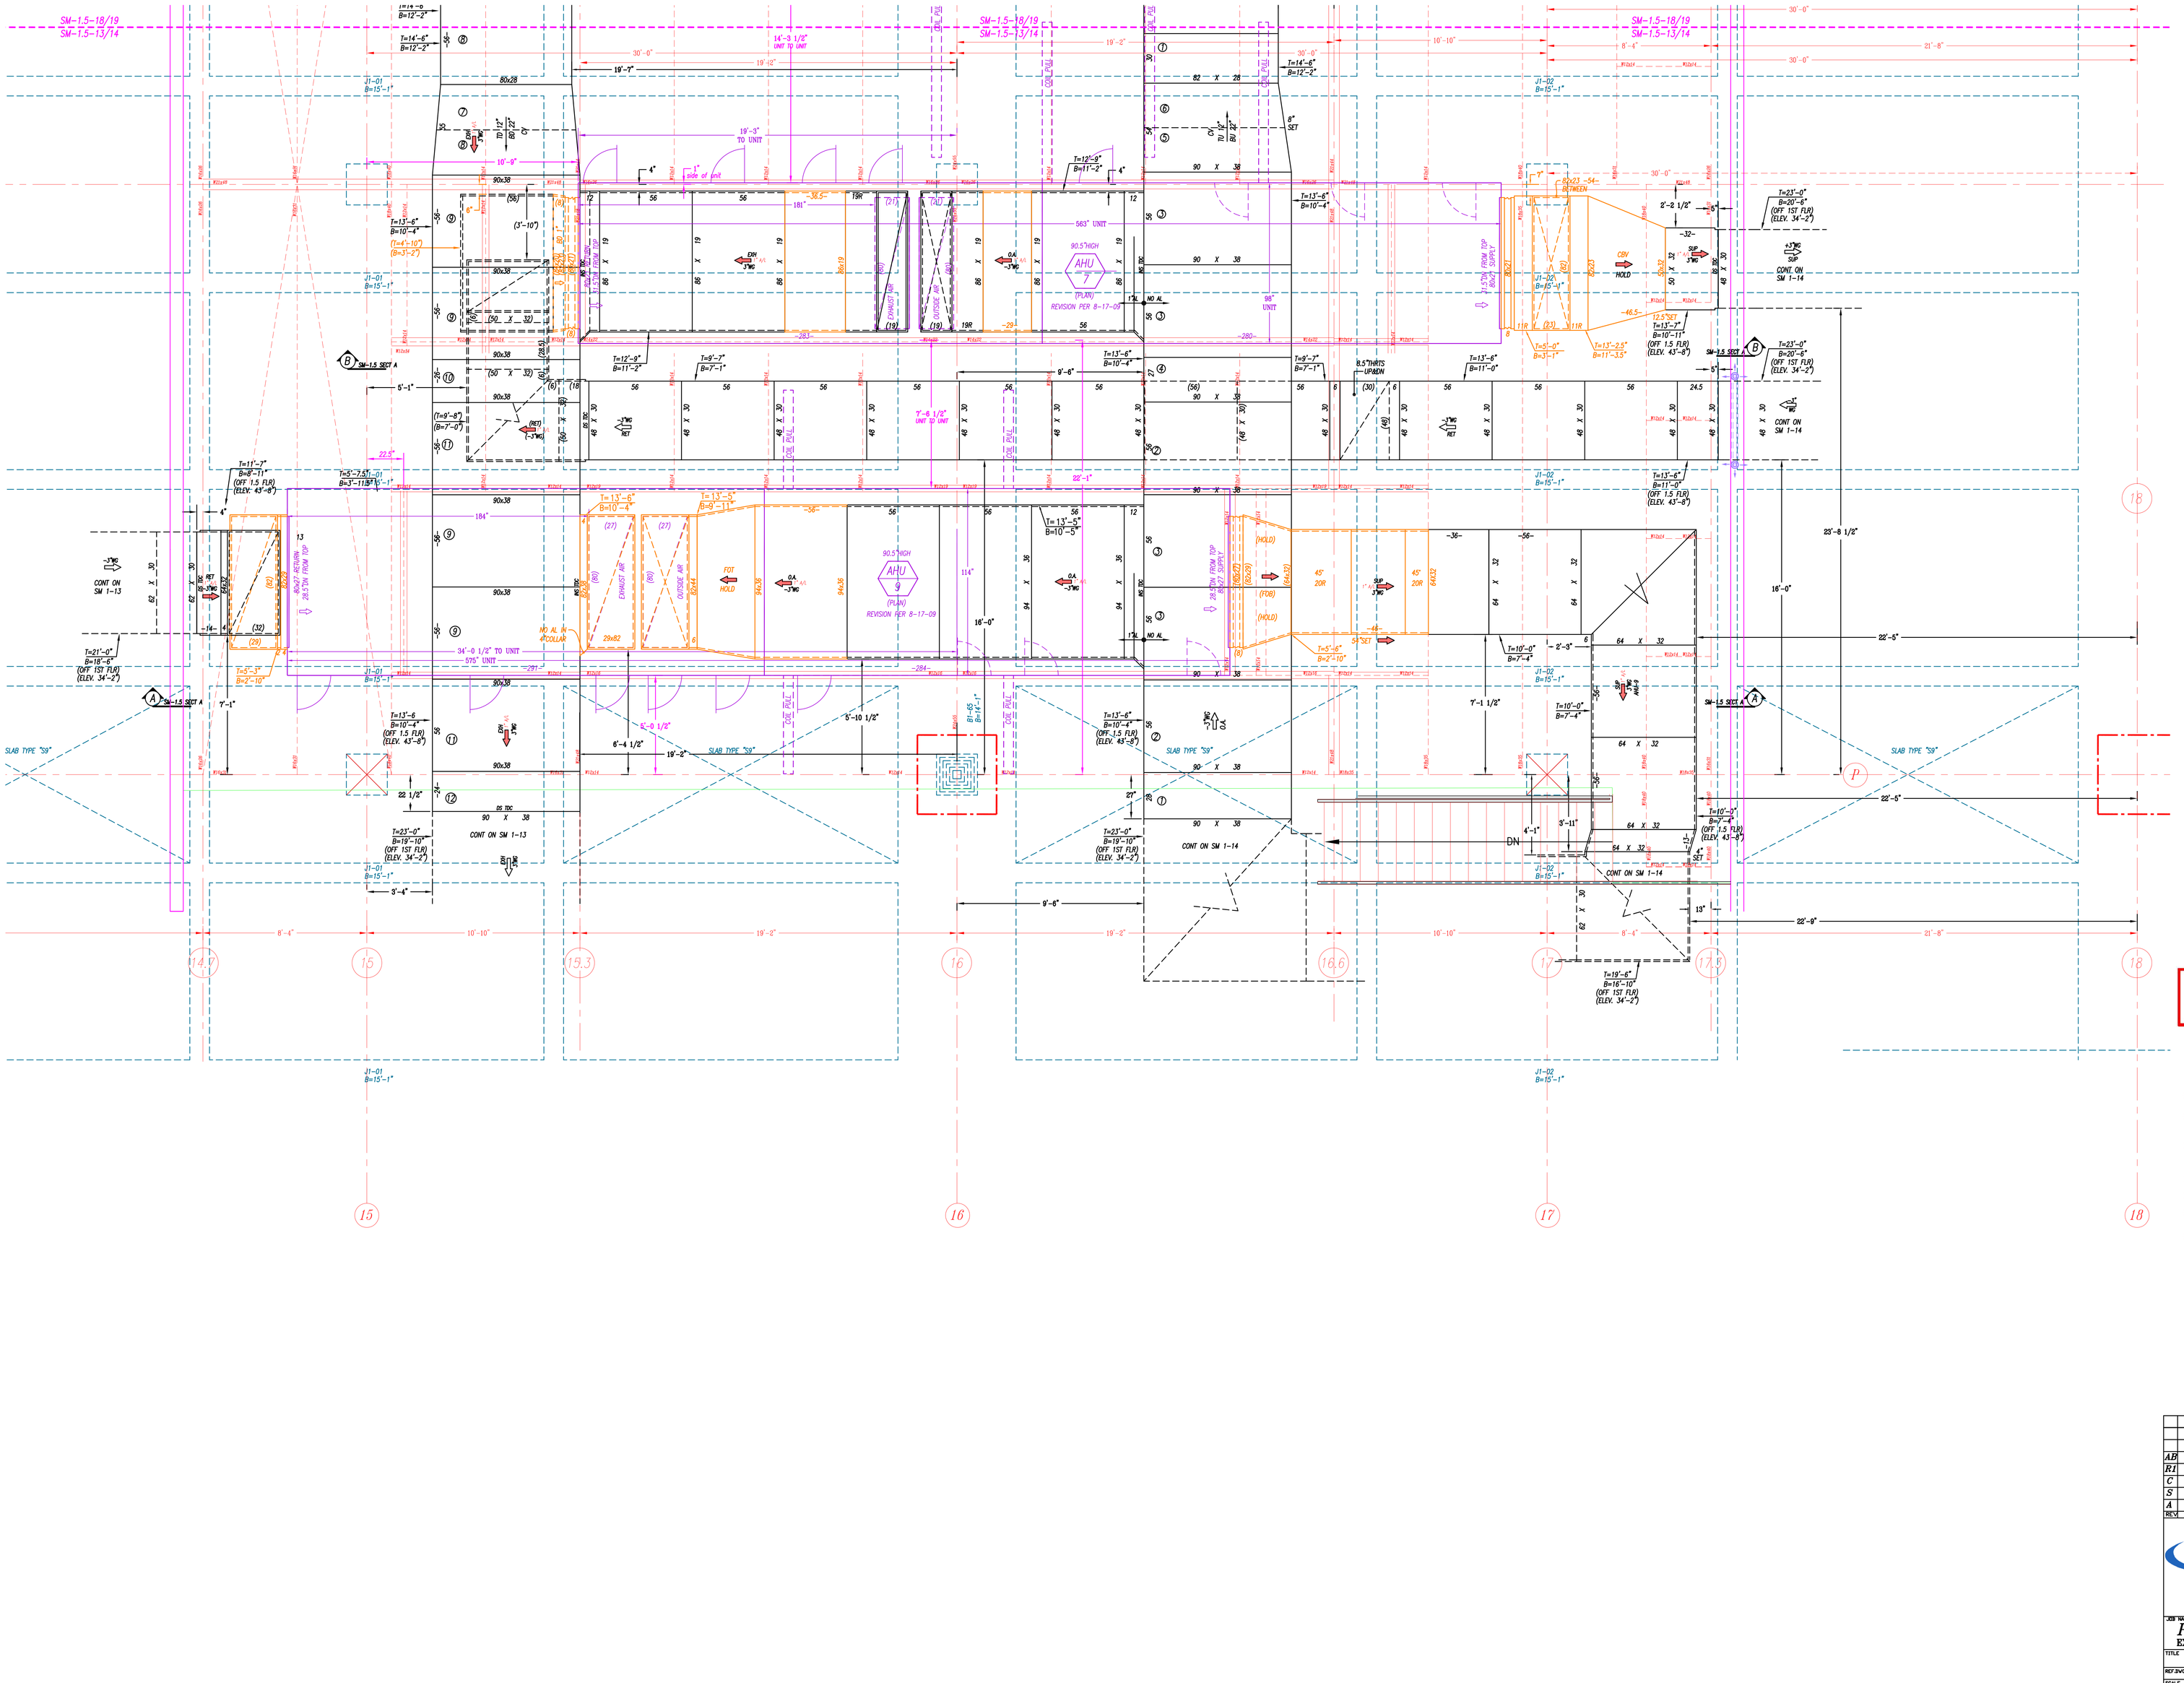

RECORD DRAWINGS
The Keating JV

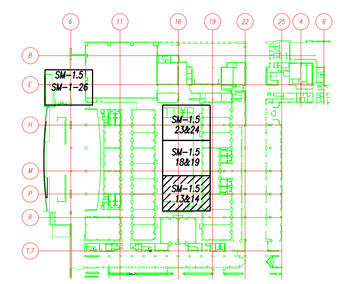

1.5 FLOOR

NOTES:

1. – ALL DUCT TO BE FABRICATED PER SMACNA CONSTRUCTION STANDARDS.
2. – ⇐▭⇒ = AIR FLOW – GALV. – NO ACOUST. LINING
3. – ⇐▭⇒ = AIR FLOW – 1" ACOUST. LINING
4. – ⇐▭⇒ RR = AIR FLOW – STAINLESS STEEL
5. – ⇐▭⇒ ALUM = AIR FLOW – ALUMINUM
6. – ▷ = W.G. CONSTRUCTION OF DUCT
7. – Tx 0'-0" = TOP OF DUCT ABOVE FINISHED FLOOR; Bx 0'-0" = BOTTOM OF DUCT ABOVE FINISHED FLOOR
8. – COORDINATION NOTE – ALLOW 2" ALL AROUND DUCT FOR FLANGE CONNECTIONS AND FOR EXTERNAL INSULATION WHERE REQUIRED.

REV.	DESCRIPTION	DR.	DATE
AB	AS BUILT	EG	01-11-11
R1	REVISED FOR NEW UNIT CUTS	EG	08-20-09
C	FOR CONSTRUCTION	MVO	04-07-09
S	SIGN OFF	MVO	04-02-09
A	FOR APPROVAL	MVO	03-11-09

Advantage CONTRACTING INC.
A Minority Owned Business Enterprise
219 W. Hortter Street • Philadelphia, PA 19119
Phone: 215-844-0191 Fax: 215-844-0192
www.advantagecontracts.com

JOB NAME
PA CONVENTION CENTER
EXPANSION AND RENOVATION

TITLE
1.5 FLOOR PARTIAL PLAN

REF.DWG.- M219	LOC. COLS.		
SCALE 3/8"=1'-0"	CH.	JOB NO.	8520
DATE 02-04-09	DR. M. ONORATO	DWG. NO.	SM 1.5-13&14

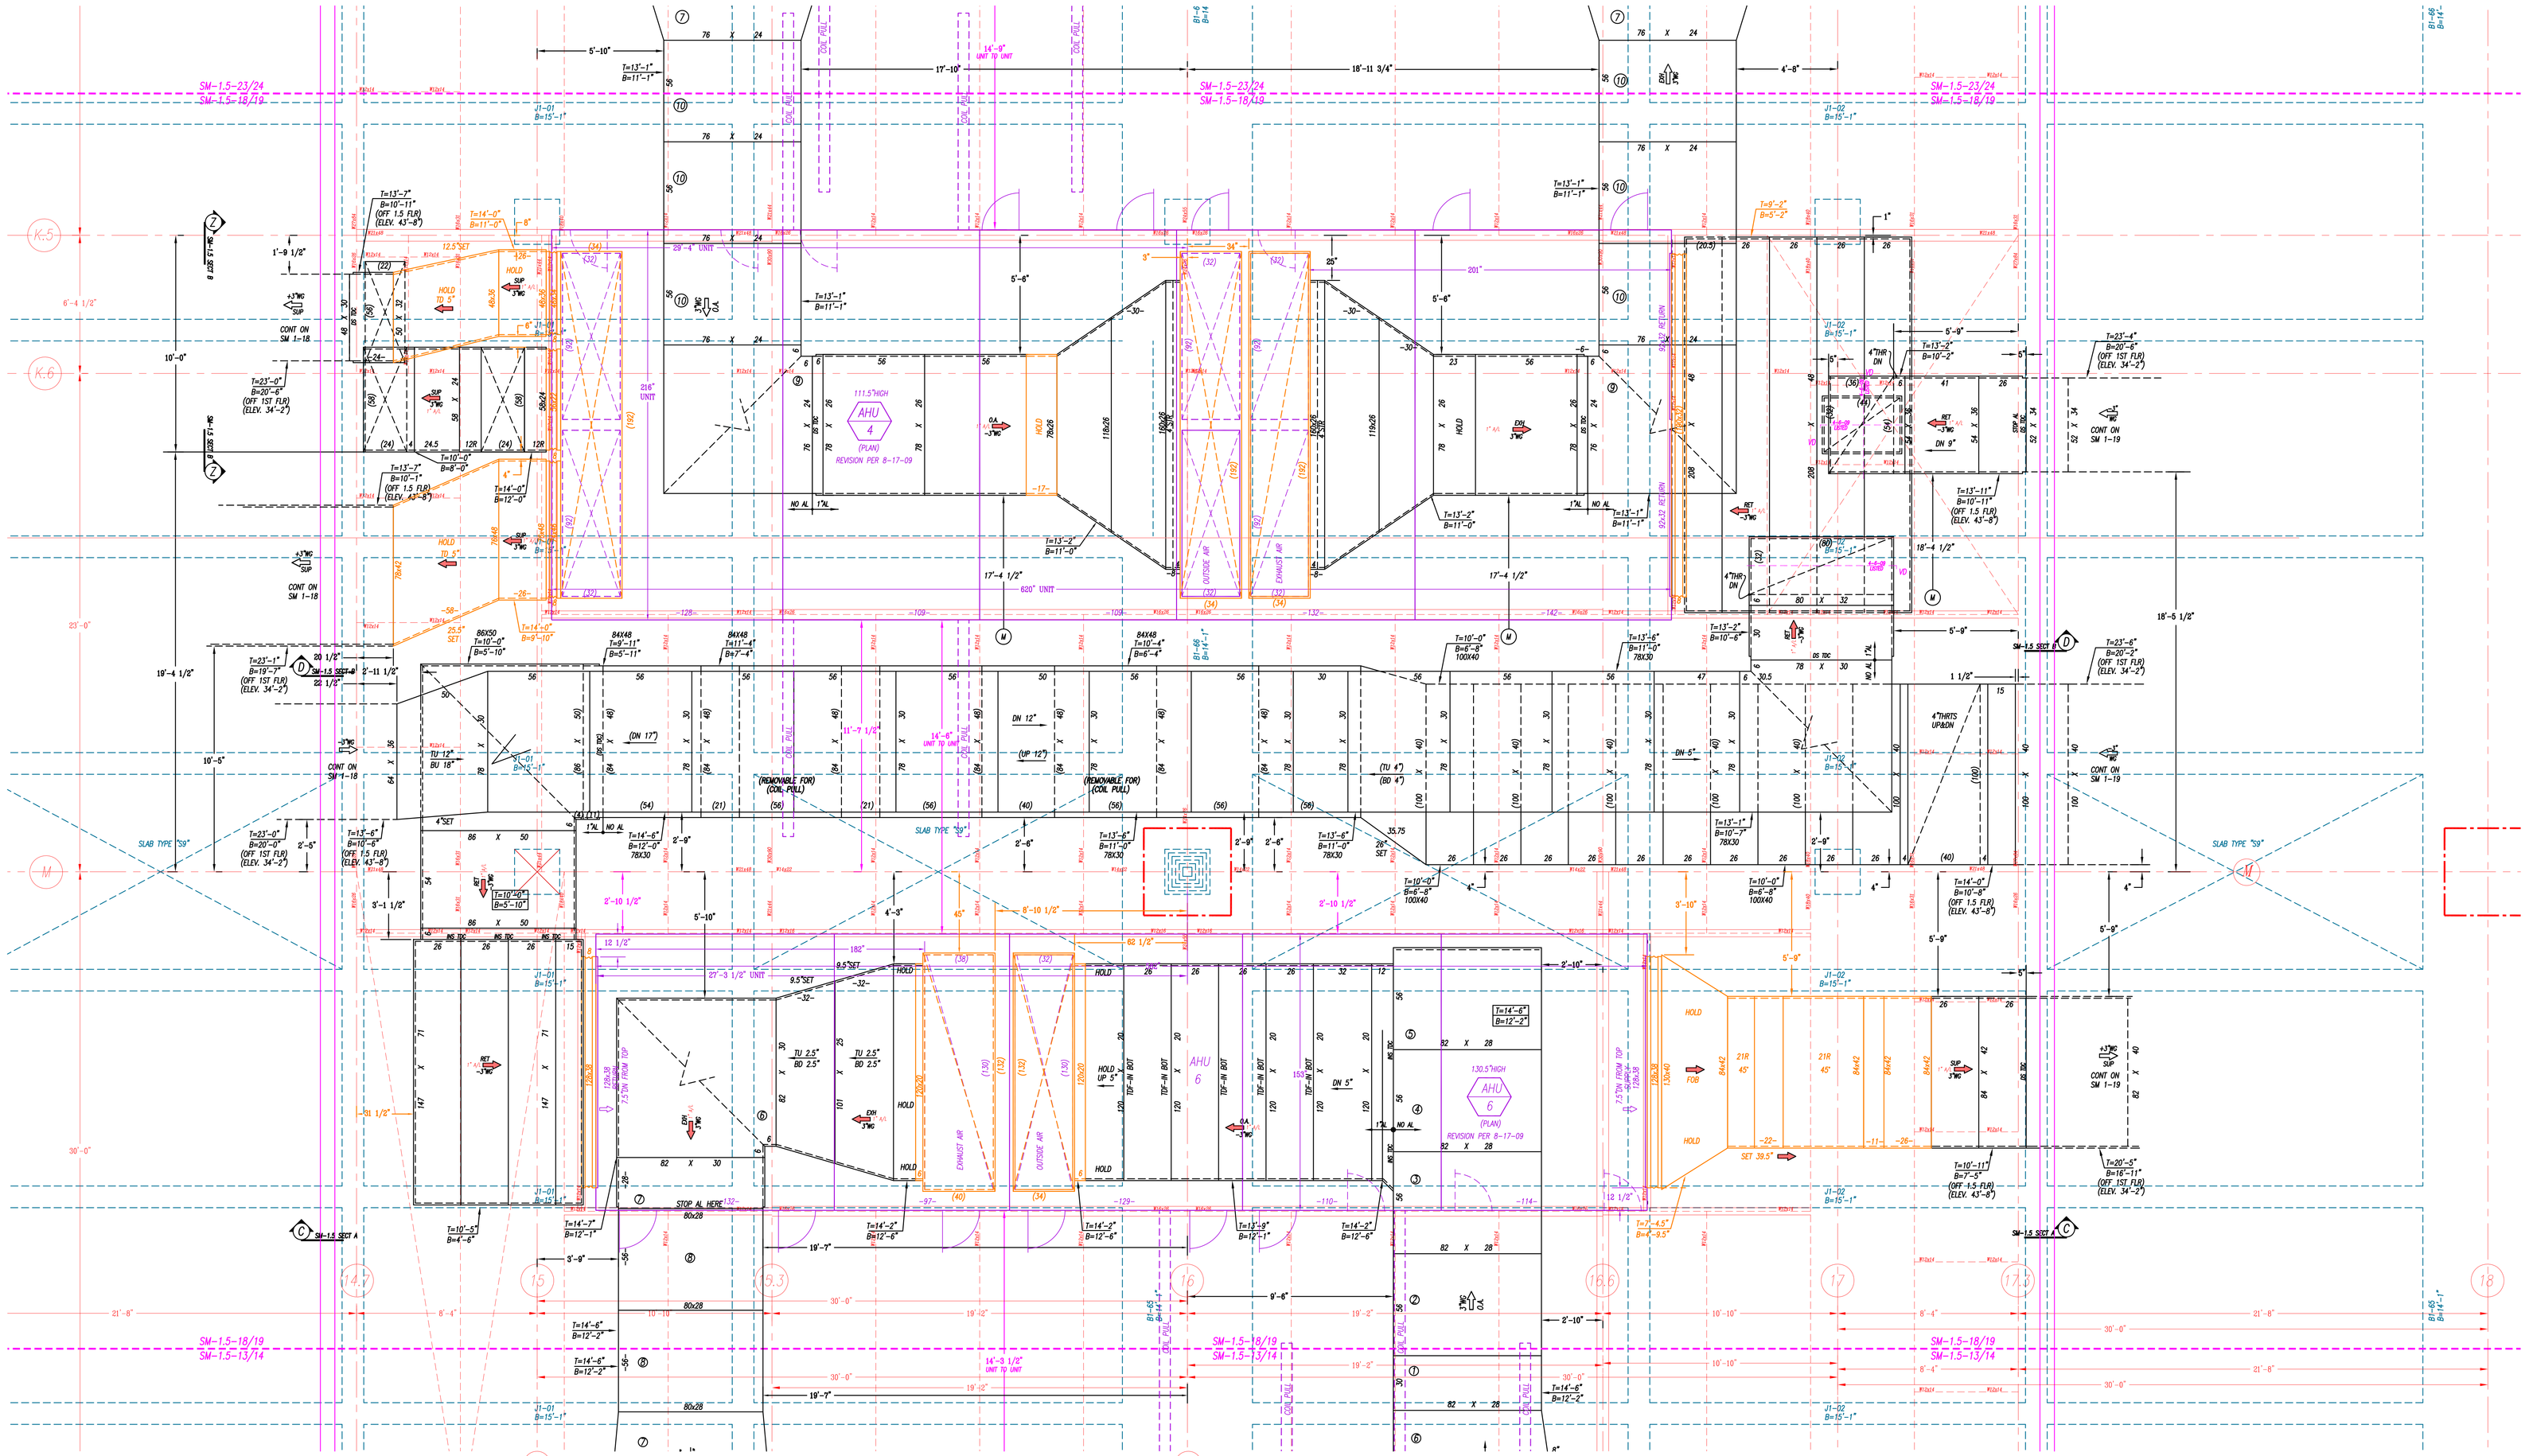

RECORD DRAWINGS
The Keating JV

NOTES:

1. = ALL DUCT TO BE FABRICATED PER SMACNA CONSTRUCTION STANDARDS.
2. = ⇨ = AIR FLOW – GALV. – NO ACOUST. LINING
3. = ⇨ = AIR FLOW –1" ACOUST. LINING
4. = ⇨ SS = AIR FLOW – STAINLESS STEEL
5. = ⇨ ALUM = AIR FLOW – ALUMINUM
6. = ▷ = W.G. CONSTRUCTION OF DUCT
7. = T= 0'-0 = TOP OF DUCT ABOVE FINISHED FLOOR
   B= 0'-0 = BOTTOM OF DUCT ABOVE FINISHED FLOOR
8. = COORDINATION NOTE – ALLOW 2" ALL AROUND DUCT FOR FLANGE CONNECTIONS AND FOR EXTERNAL INSULATION WHERE REQUIRED.

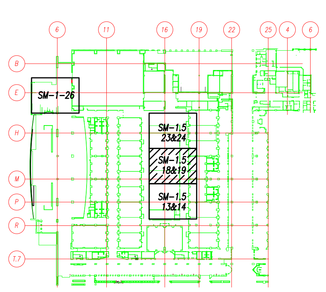

1.5 FLOOR

REV.	DESCRIPTION	BY.	DATE
AB	AS BUILT	MVO	01-11-11
R1	REVISED FOR NEW UNIT CUTS	MVO	08-28-09
C	FOR CONSTRUCTION	MVO	04-07-09
S	SIGN-OFF	MVO	04-02-09
A	FOR APPROVAL	MVO	03-11-09

Advantage CONTRACTING INC.
A Minority Owned Business Enterprise
219 W. Hortter Street • Philadelphia, PA 19119
Phone: 215-844-0191 Fax: 215-844-0192
www.advantagecontracts.com

JOB NAME
PA CONVENTION CENTER
EXPANSION AND RENOVATION

TITLE
1.5 FLOOR PARTIAL PLAN

REF. DWG.- M219	LOC. COILS:		
SCALE 3/8"=1'-0"	CH.	JOB NO.	8520
DATE 02-04-09	DR. M. ONORATO	DWG. NO.	SM 1.5-18&19

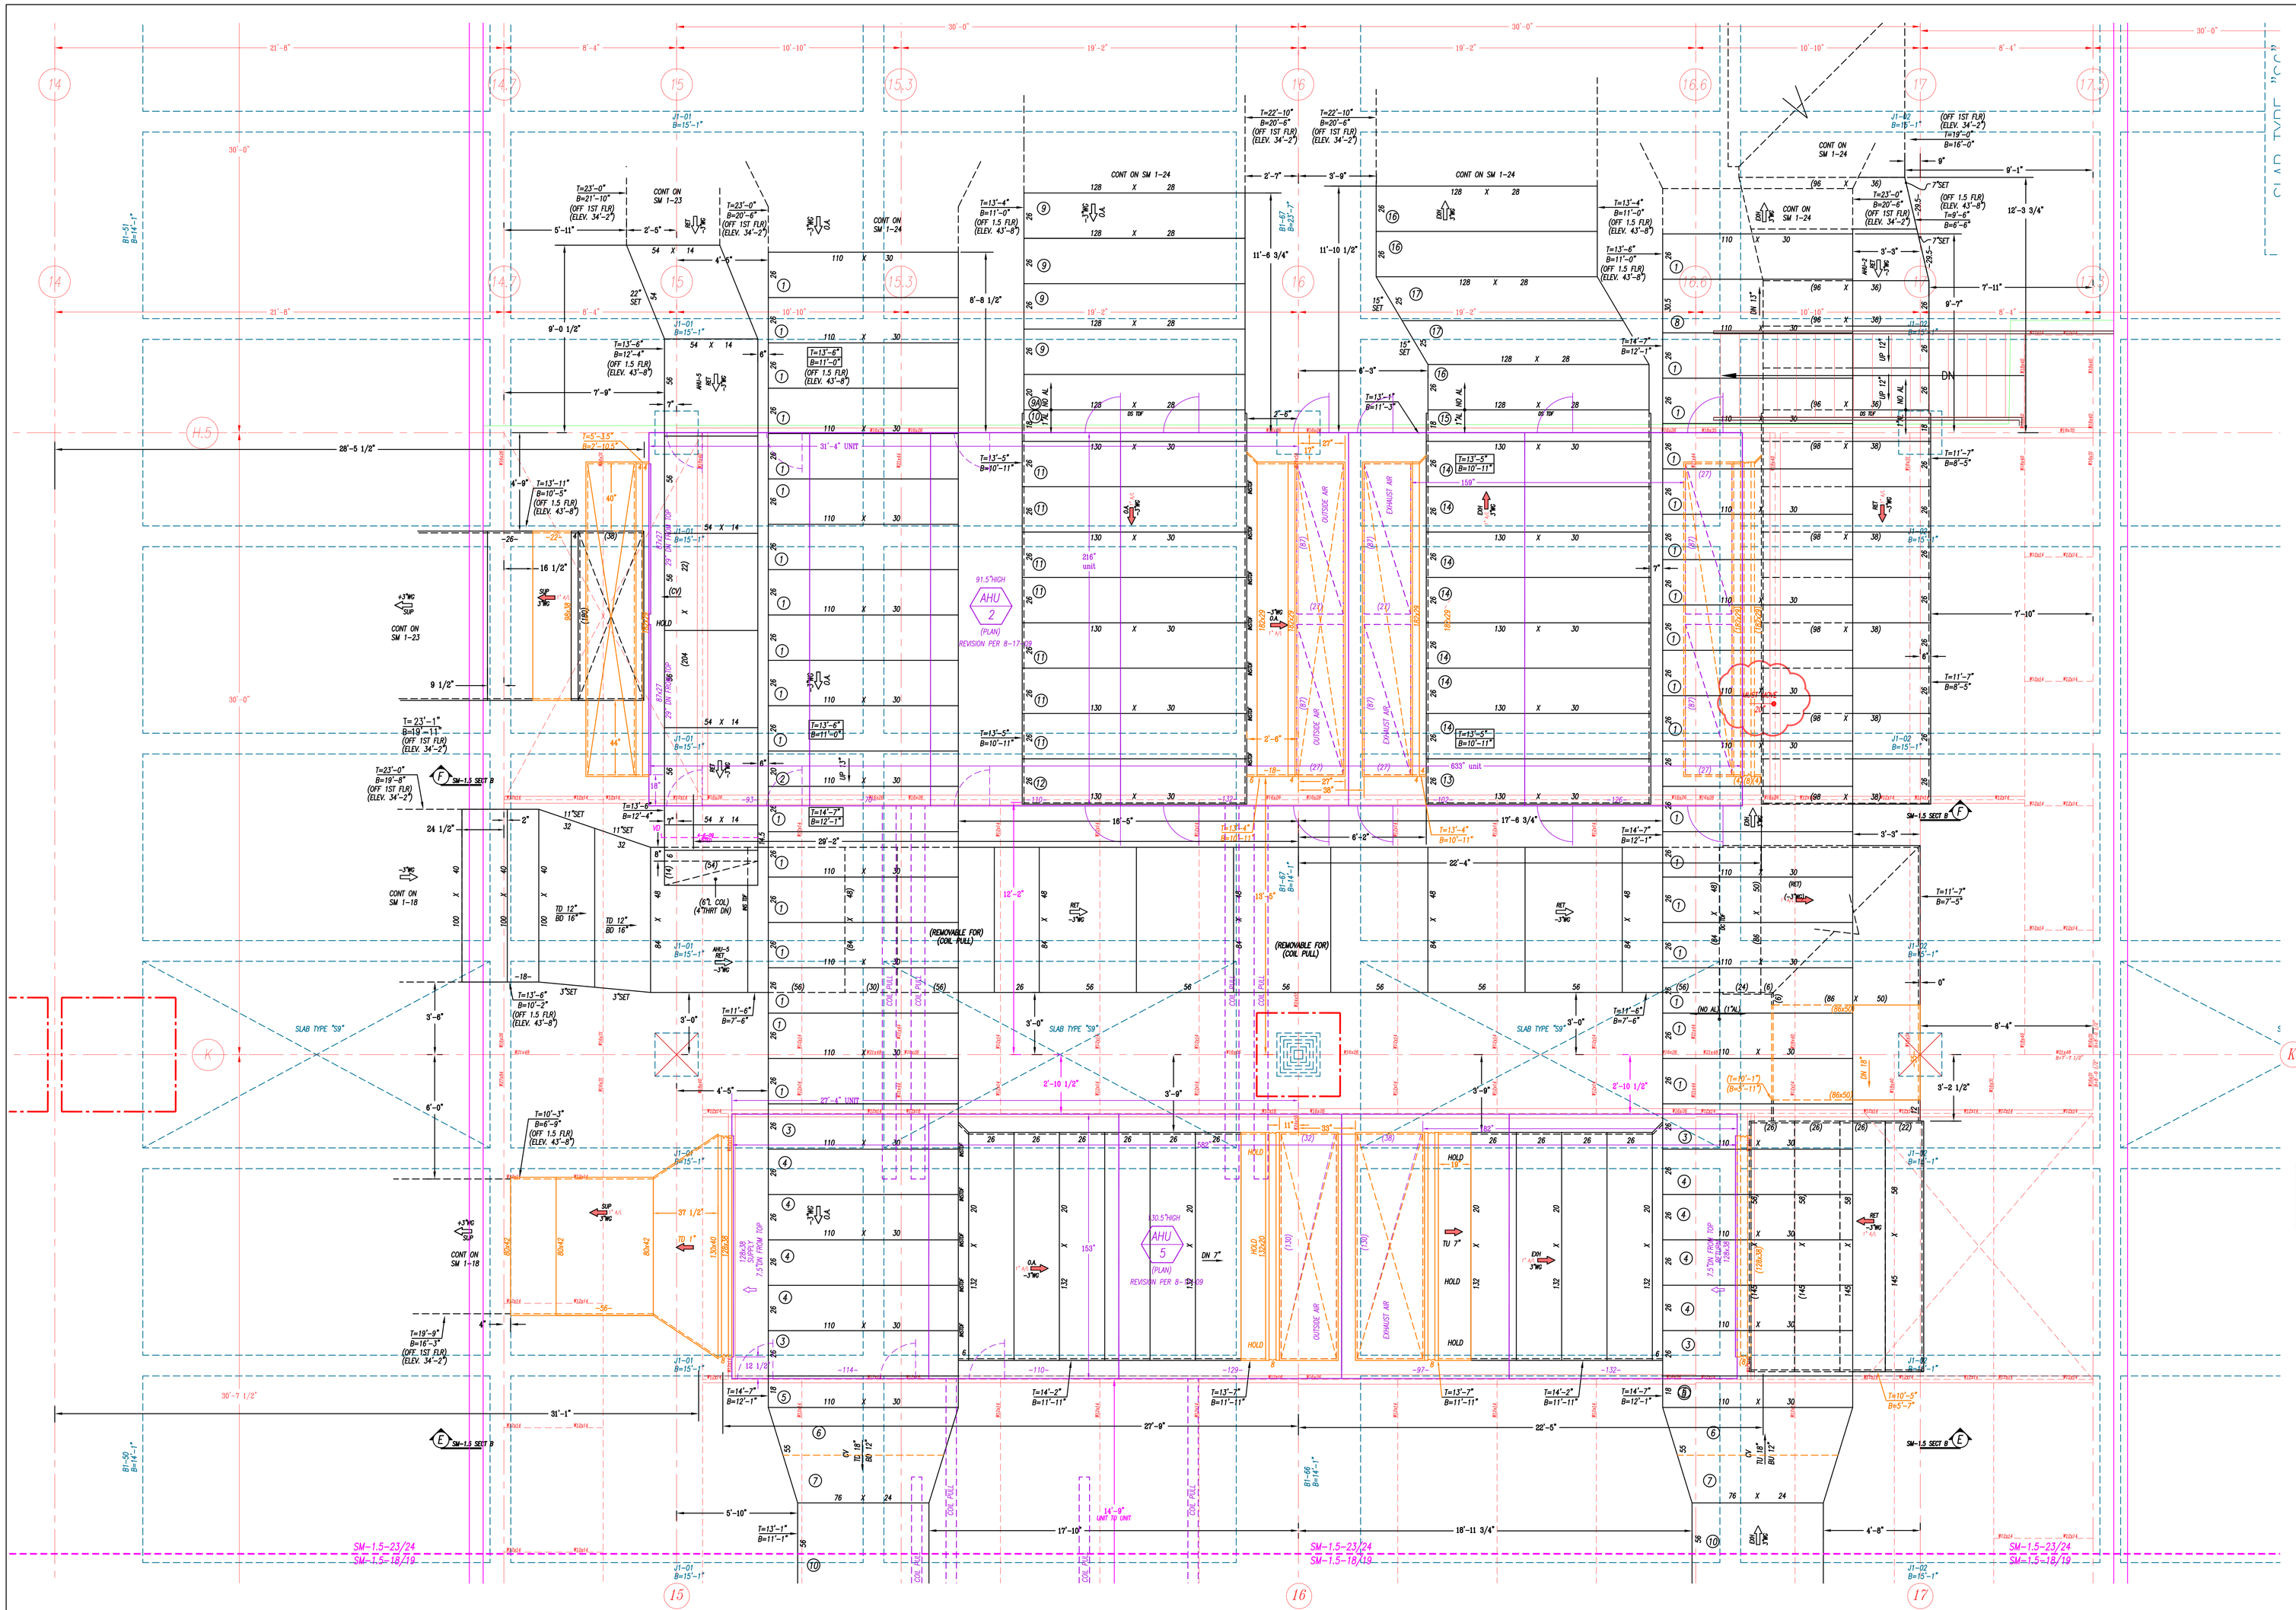

RECORD DRAWINGS
The Keating JV

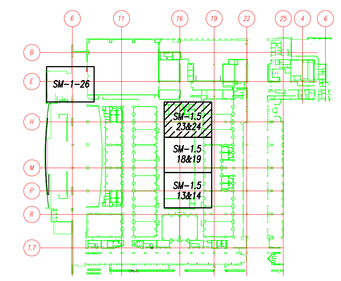

1.5 FLOOR

NOTES:

1. – ALL DUCT TO BE FABRICATED PER SMACNA CONSTRUCTION STANDARDS.
2. – ⟨=C=⟩ = AIR FLOW – GALV. – NO ACOUST. LINING
3. – ⟨=C=⟩ = AIR FLOW –1" ACOUST. LINING
4. – ⟨=C=⟩ SS = AIR FLOW – STAINLESS STEEL
5. – ⟨=C=⟩ ALUM = AIR FLOW – ALUMINUM
6. – ▷ = W.G. CONSTRUCTION OF DUCT
7. – T= 0'-0 = TOP OF DUCT ABOVE FINISHED FLOOR
   B= 0'-0 = BOTTOM OF DUCT ABOVE FINISHED FLOOR
8. – COORDINATION NOTE – ALLOW 2" ALL AROUND DUCT FOR FLANGE CONNECTIONS AND FOR EXTERNAL INSULATION WHERE REQUIRED.

REV.	DESCRIPTION	DR.	DATE
AB	AS BUILT	EG	08-27-09
R1	REVISED FOR UNITS	EG	08-27-09
C	FOR CONSTRUCTION	BLJ	04-07-09
S	SIGN OFF	BLJ	04-02-09
A	FOR APPROVAL	BLJ	02-18-09

Advantage CONTRACTING INC.
A Minority Owned Business Enterprise
219 W. Hortter Street • Philadelphia, PA 19119
Phone: 215-844-0191 Fax: 215-844-0192
www.advantagecontracts.com

JOB NAME: PA CONVENTION CENTER
EXPANSION AND RENOVATION

TITLE: 1.5 FLOOR PARTIAL PLAN

REF. DWGS.	M219	LOC. COLS.	
SCALE	3/8"=1'-0"	CH.	JOB NO. 8520
DATE	02-04-09	DR. M. ONORATO	DWG. NO. SM 1.5-23&24

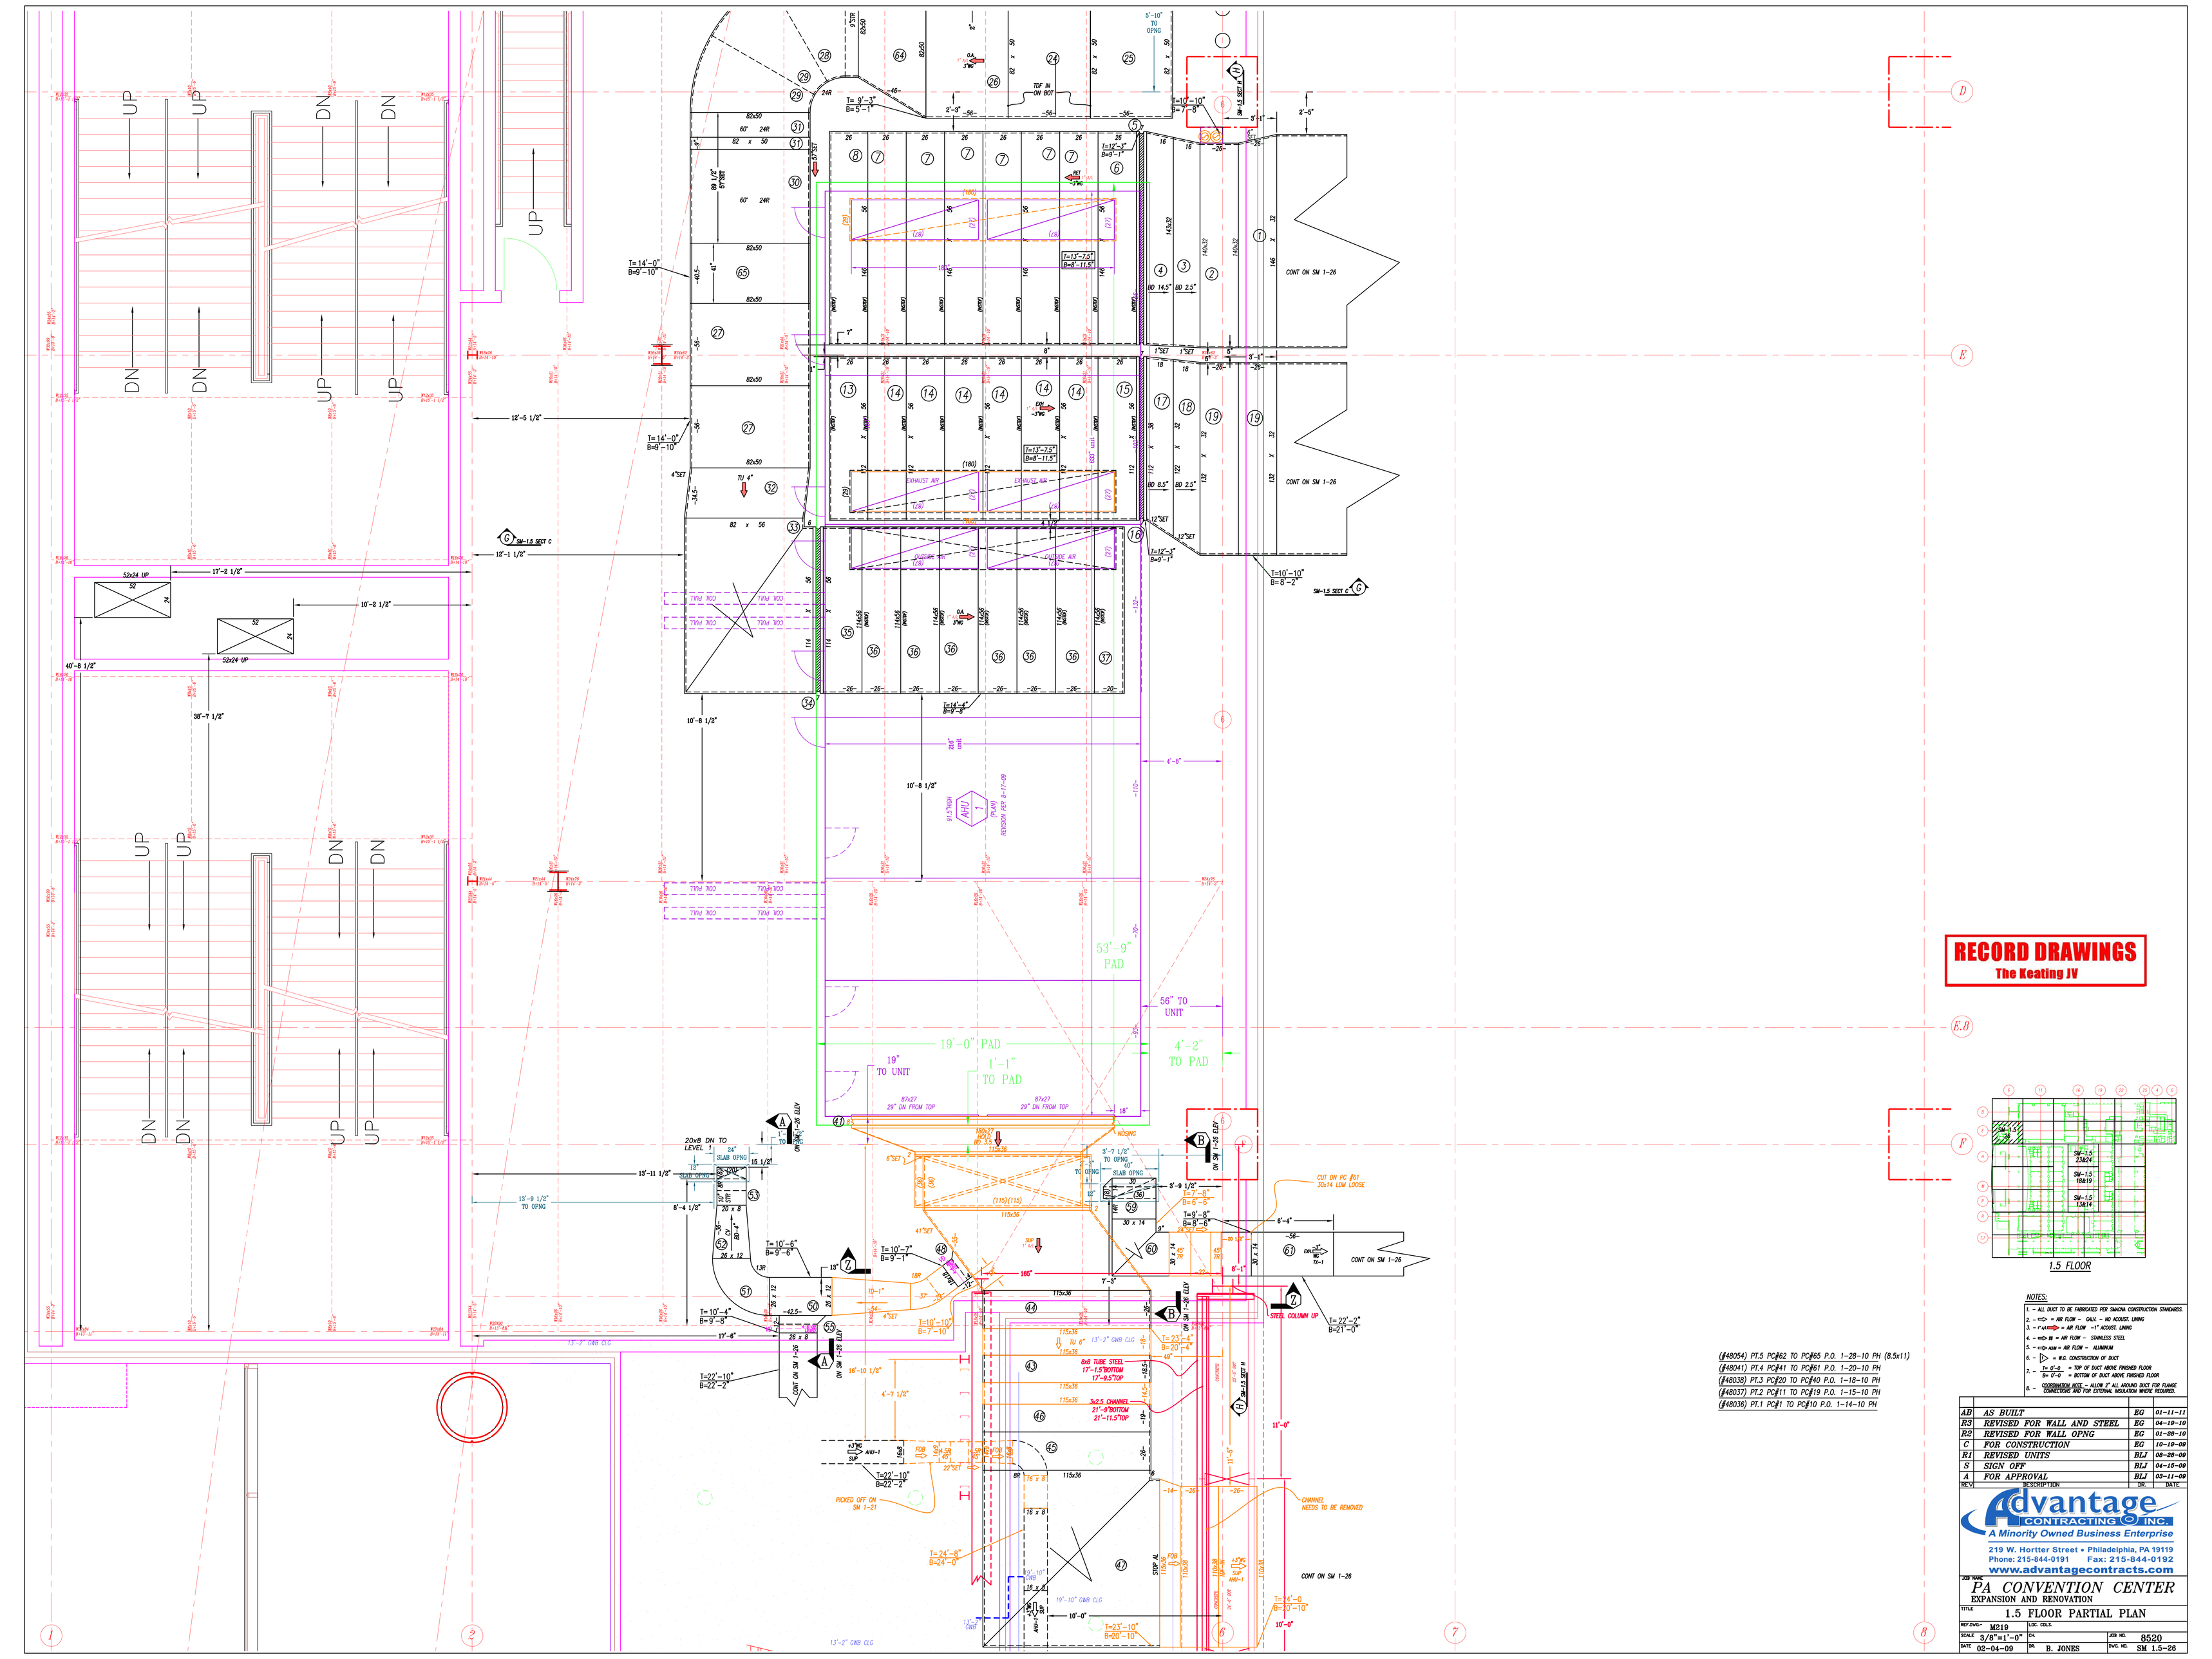

RECORD DRAWINGS
The Keating JV

(#48054) PT.5 PG#62 TO PG#65 P.O. 1-28-10 PH (8.5x11)
(#48041) PT.4 PG#41 TO PG#61 P.O. 1-20-10 PH
(#48038) PT.3 PG#20 TO PG#40 P.O. 1-18-10 PH
(#48037) PT.2 PG#11 TO PG#19 P.O. 1-15-10 PH
(#48036) PT.1 PG#1 TO PG#10 P.O. 1-14-10 PH

1.5 FLOOR

NOTES:
1. = ALL DUCT TO BE FABRICATED PER SMACNA CONSTRUCTION STANDARDS.
2. = ⇨ = AIR FLOW - GALV. - NO ACOUST. LINING
3. = ⇨ = AIR FLOW - 1" ACOUST. LINING
4. = ⇨ = AIR FLOW - STAINLESS STEEL
5. = ⇨ = AIR FLOW - ALUMINUM
6. = ▷ = W.G. CONSTRUCTION OF DUCT
7. = T= 0'-0" = TOP OF DUCT ABOVE FINISHED FLOOR; B= 0'-0" = BOTTOM OF DUCT ABOVE FINISHED FLOOR
8. = COORDINATION NOTE - ALLOW 2" ALL AROUND DUCT FOR FLANGE CONNECTIONS AND FOR EXTERNAL INSULATION WHERE REQUIRED.

REV.#	DESCRIPTION	DR.	DATE
AB	AS BUILT	EG	01-11-11
R3	REVISED FOR WALL AND STEEL	EG	04-19-10
R2	REVISED FOR WALL OPNG	EG	01-28-10
C	FOR CONSTRUCTION	EG	10-19-09
R1	REVISED UNITS	BLJ	08-28-09
S	SIGN OFF	BLJ	04-15-09
A	FOR APPROVAL	BLJ	03-11-09

Advantage CONTRACTING INC.
A Minority Owned Business Enterprise
219 W. Hortter Street • Philadelphia, PA 19119
Phone: 215-844-0191 Fax: 215-844-0192
www.advantagecontracts.com

JOB NAME: PA CONVENTION CENTER
EXPANSION AND RENOVATION

TITLE: 1.5 FLOOR PARTIAL PLAN

REF.DWG#- M219	LOC. COLS.		
SCALE 3/8"=1'-0"	CH.	JOB NO.	8520
DATE 02-04-09	DR. B. JONES	DWG. NO.	SM 1.5-26









































RECORD DRAWINGS
The Keating JV

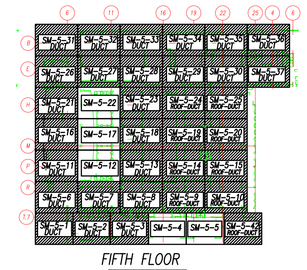

FIFTH FLOOR

NOTES:

1. – ALL DUCT TO BE FABRICATED PER SMACNA CONSTRUCTION STANDARDS.
2. – <G> = AIR FLOW – GALV. – NO ACOUST. LINING
3. – <AL#1.5> = AIR FLOW –1" ACOUST. LINING
4. – <S> SS = AIR FLOW – STAINLESS STEEL
5. – <AL> ALUM = AIR FLOW – ALUMINUM
6. – ▷ = W.G. CONSTRUCTION OF DUCT
7. – 7= 0'-0 = TOP OF DUCT ABOVE FINISHED FLOOR
   B= 0'-0 = BOTTOM OF DUCT ABOVE FINISHED FLOOR
8. – COORDINATION NOTE – ALLOW 2" ALL AROUND DUCT FOR FLANGE CONNECTIONS AND FOR EXTERNAL INSULATION WHERE REQUIRED.

REV.	DESCRIPTION	DR.	DATE
AB	AS BUILT	EG	01-11-11
R1	REVISED FOR GRDS	EG	02-02-10
C	FOR CONSTRUCTION	EG	12-18-09
S	SIGN OFF	EG	11-19-09
A	FOR APPROVAL	BLJ	07-06-09

Advantage CONTRACTING INC.
A Minority Owned Business Enterprise
219 W. Hortter Street • Philadelphia, PA 19119
Phone: 215-844-0191 Fax: 215-844-0192
www.advantagecontracts.com

JOB NAME
PA CONVENTION CENTER
EXPANSION AND RENOVATION

TITLE
LEVEL 5 PARTIAL DUCT PLAN

REF.DWG.- M252	LOC. COLS.		
SCALE 3/8"=1'-0"	CH.	JOB NO.	8520
DATE 07-06-09	DR. BLJ	DWG. NO.	SM 5-1

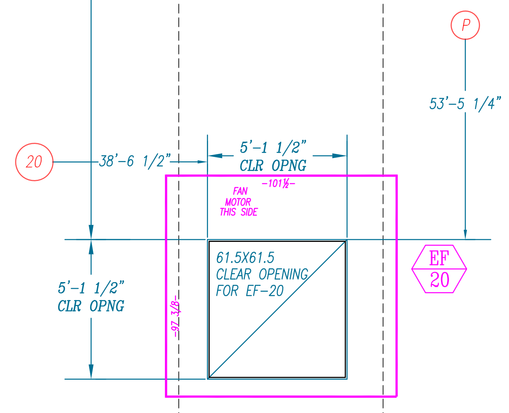

FAN LOCATIONS BY JOIST MANUFACTURER RFI#122 AND RESPONSE TO CONTRACT 1 RFI#326 WITH ATTATCHED SKETCHES

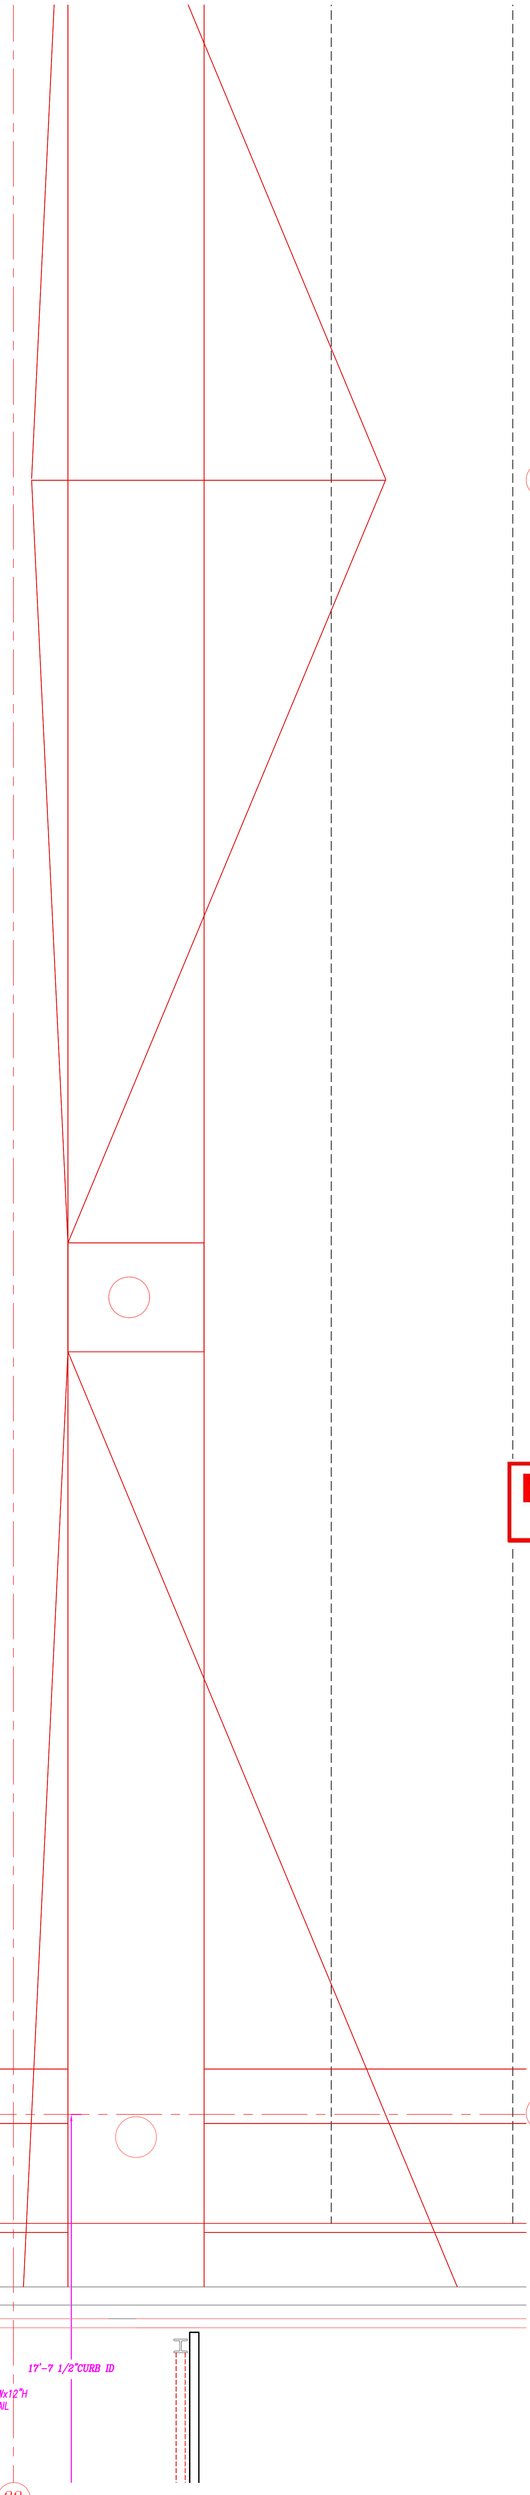

RECORD DRAWINGS
The Keating JV